






	0211	
	BARBER	
	a get	
	CR 1	
<b></b> :	or Appointed II/o	

Officer Appointed U/s 21(4A)

Draft Revised Development Plan of Mira Bhayandar



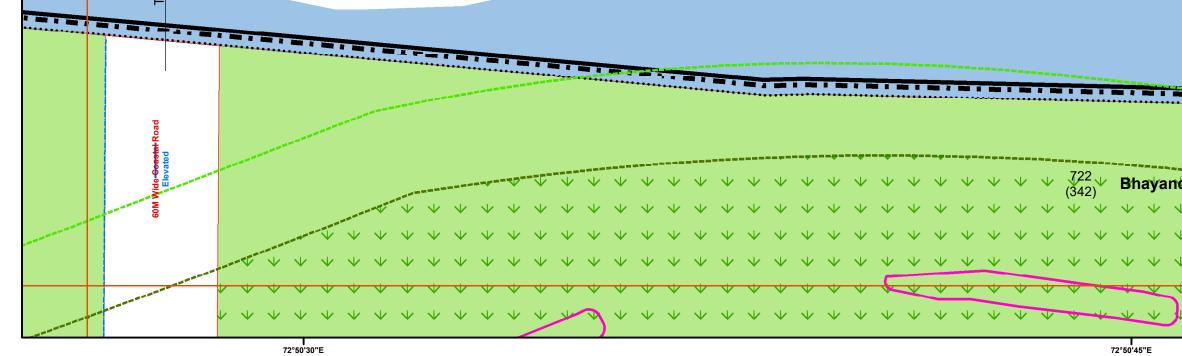

19°19'30"N I

72°51	'0"E

Vasai Creek	
and ar $\vee$	RTA
769 	


#### DRAFT REVISED DEVELOPMENT PLAN Mira Bhayandar Municipal Corporation (Published U/s.28(4) of M.R.&T.P. Act 1966)







Officer Appointed U/s 21(4A) Draft Revised Development Plan of Mira Bhayandar

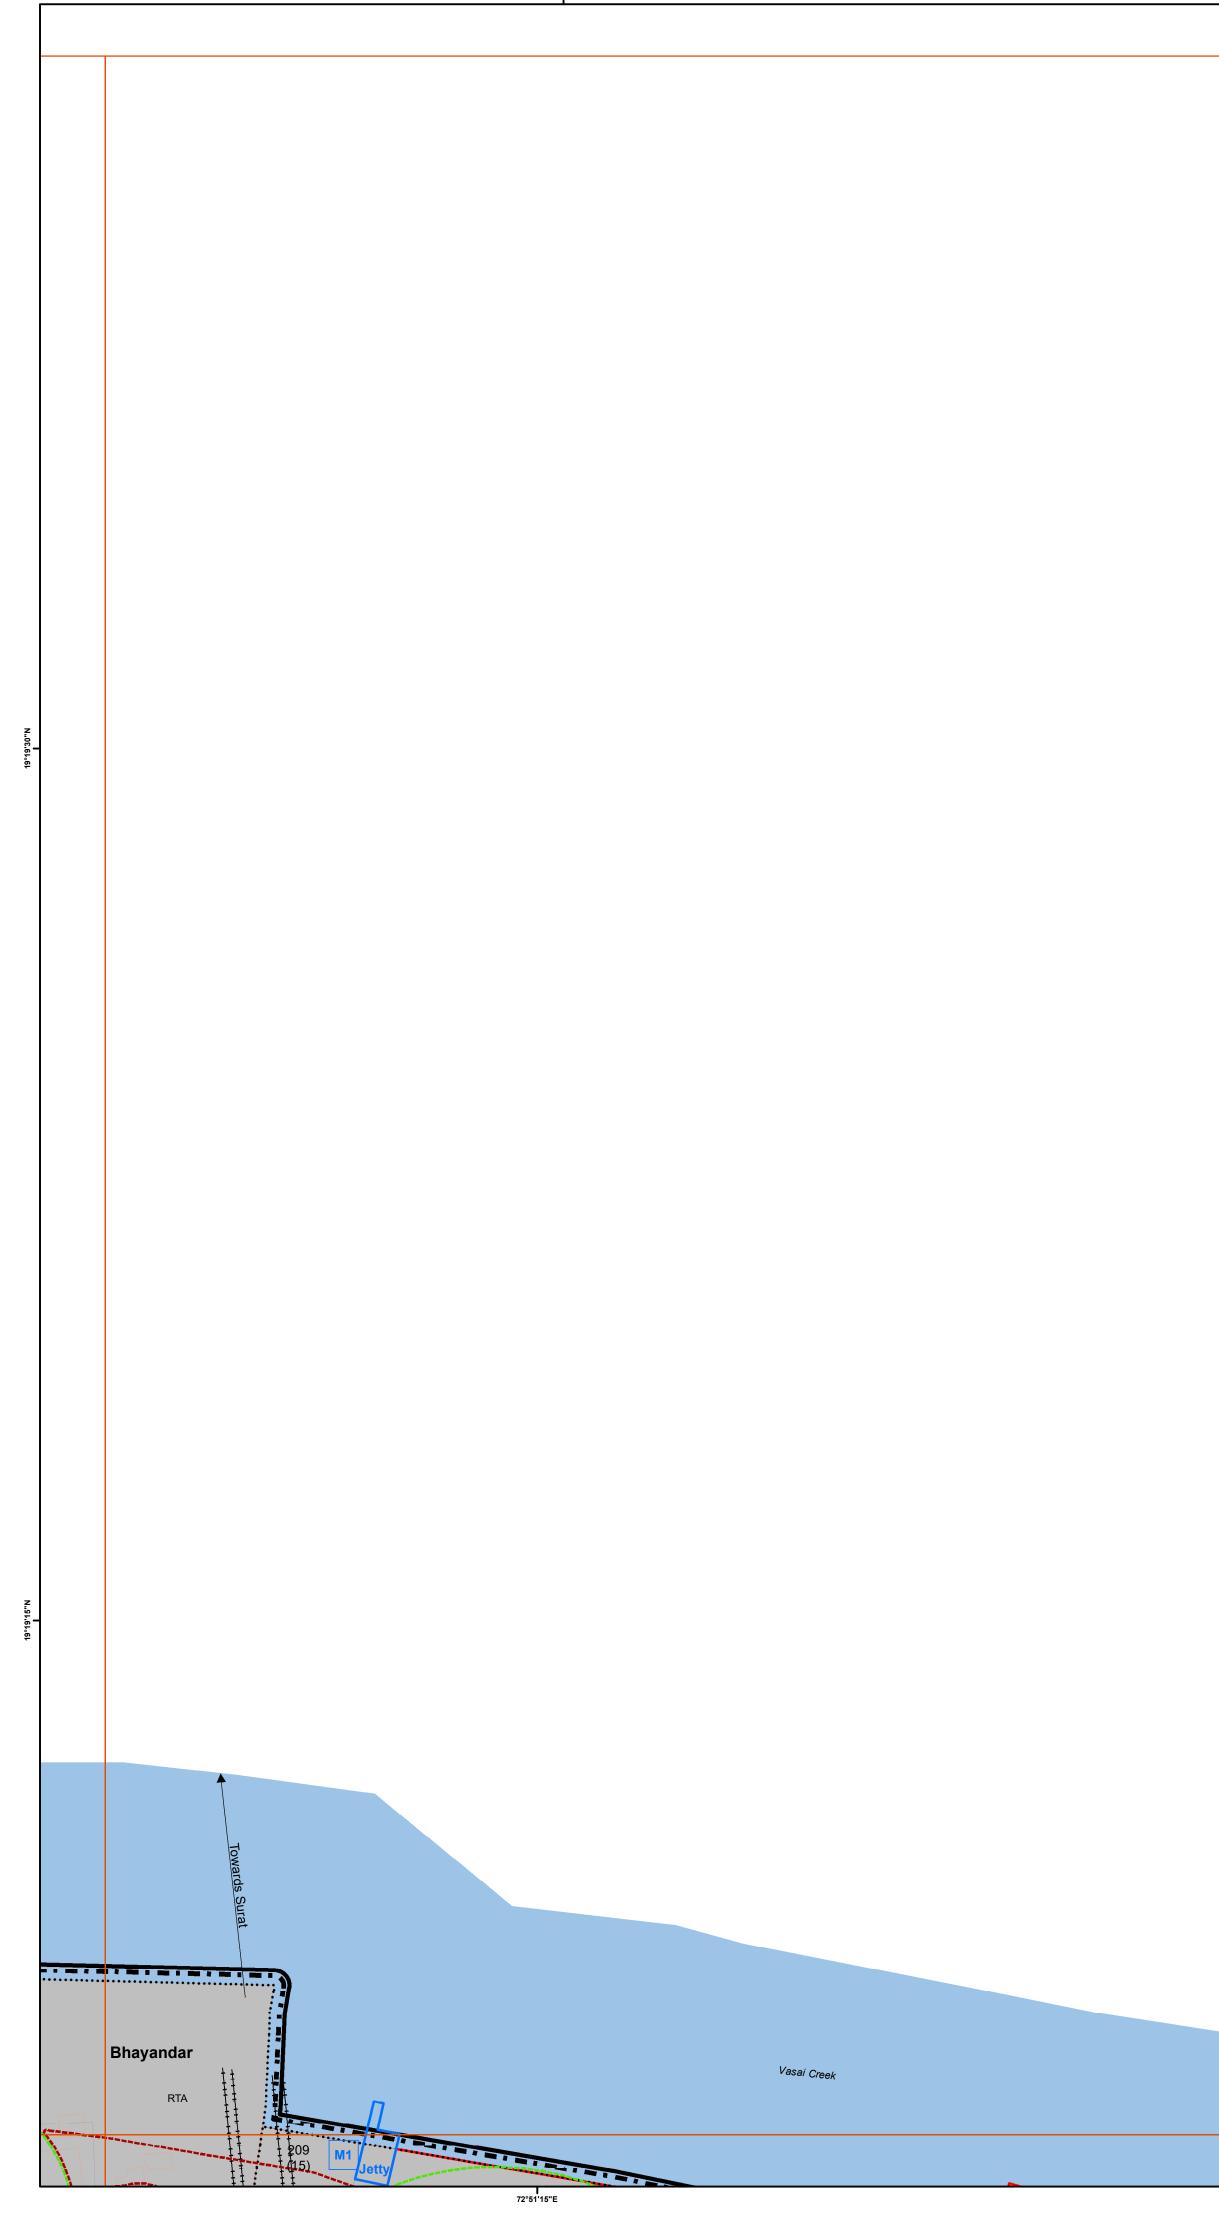



A REAL
⊈ → Draf



Officer Appointed U/s 21(4A)

Draft Revised Development Plan of Mira Bhayandar

19°19'0"N I

72°49'15"E

72°49'30"E

↓ (112) ↓ Esh Prasad Agar

V262

(113)

Ratnagar 🗸

#### DRAFT REVISED DEVELOPMENT PLAN Mira Bhayandar Municipal Corporation (Published U/s.28(4) of M.R.&T.P. Act 1966)



0.05 1:2,000


And Ha D

ठाणे भ


600+1	
Kilat	
Officer Appointed U/	

/s 21(4A)


// Draft Revised Development Plan of Mira Bhayandar

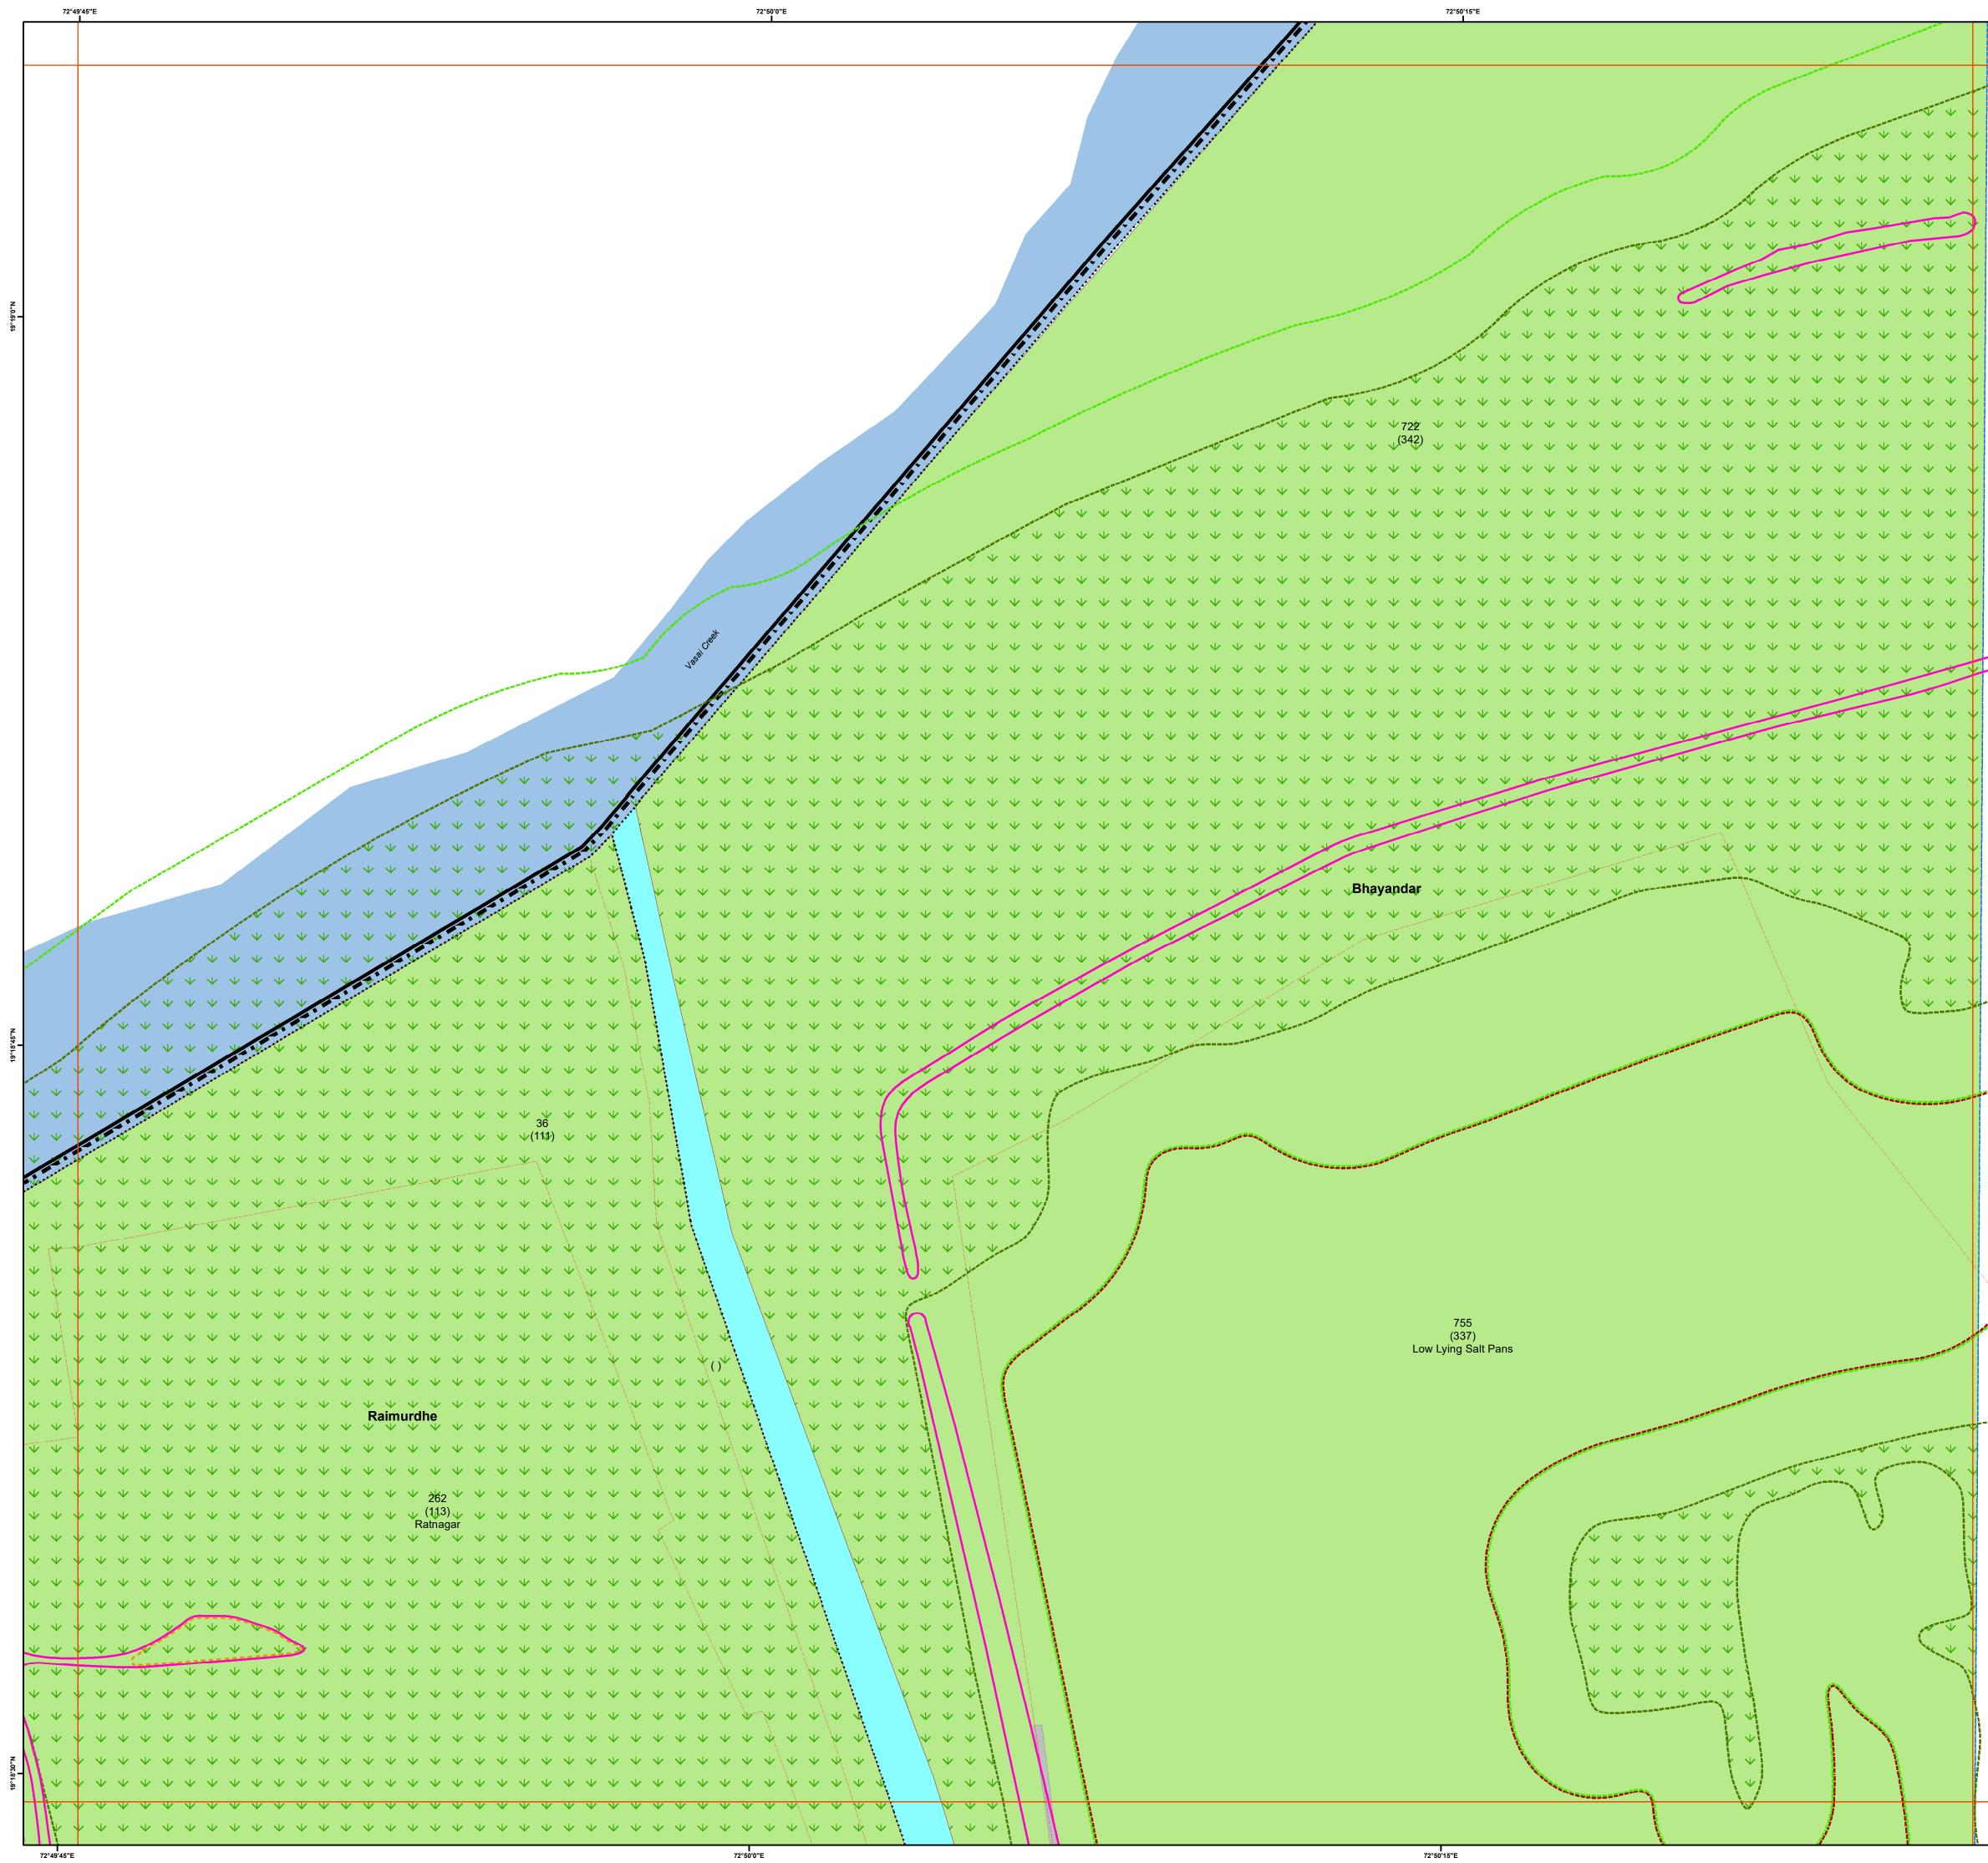




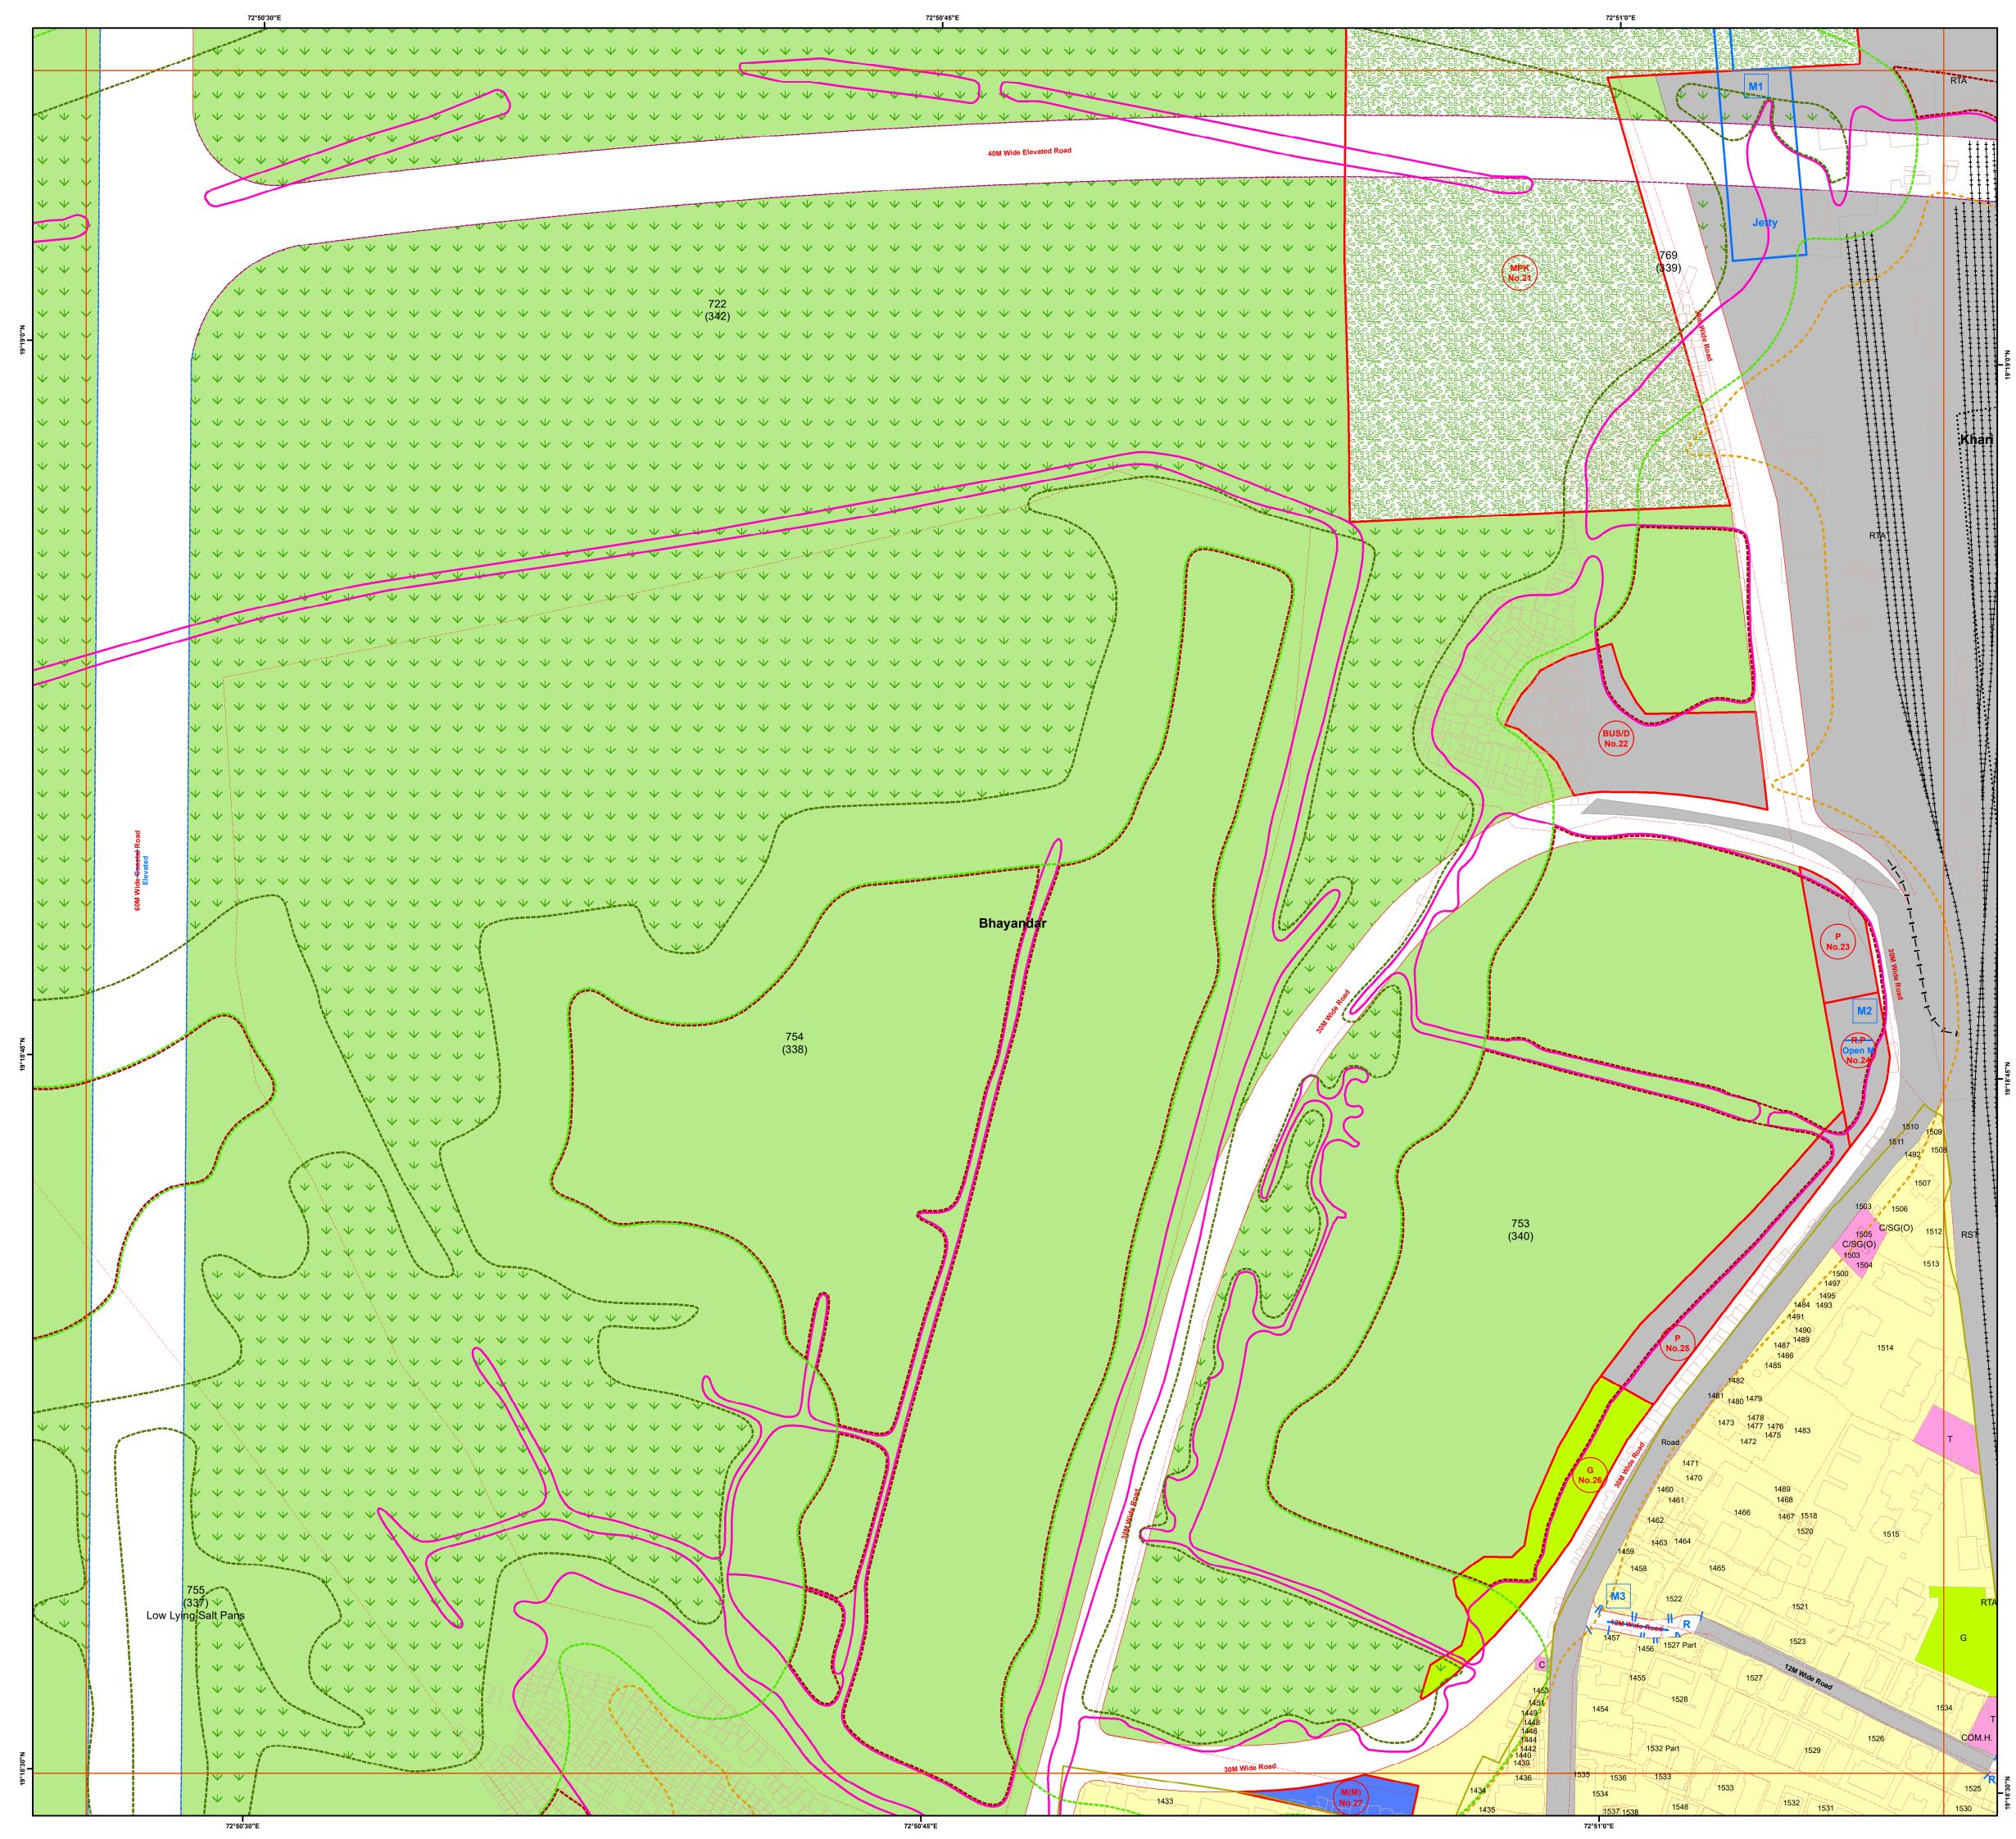



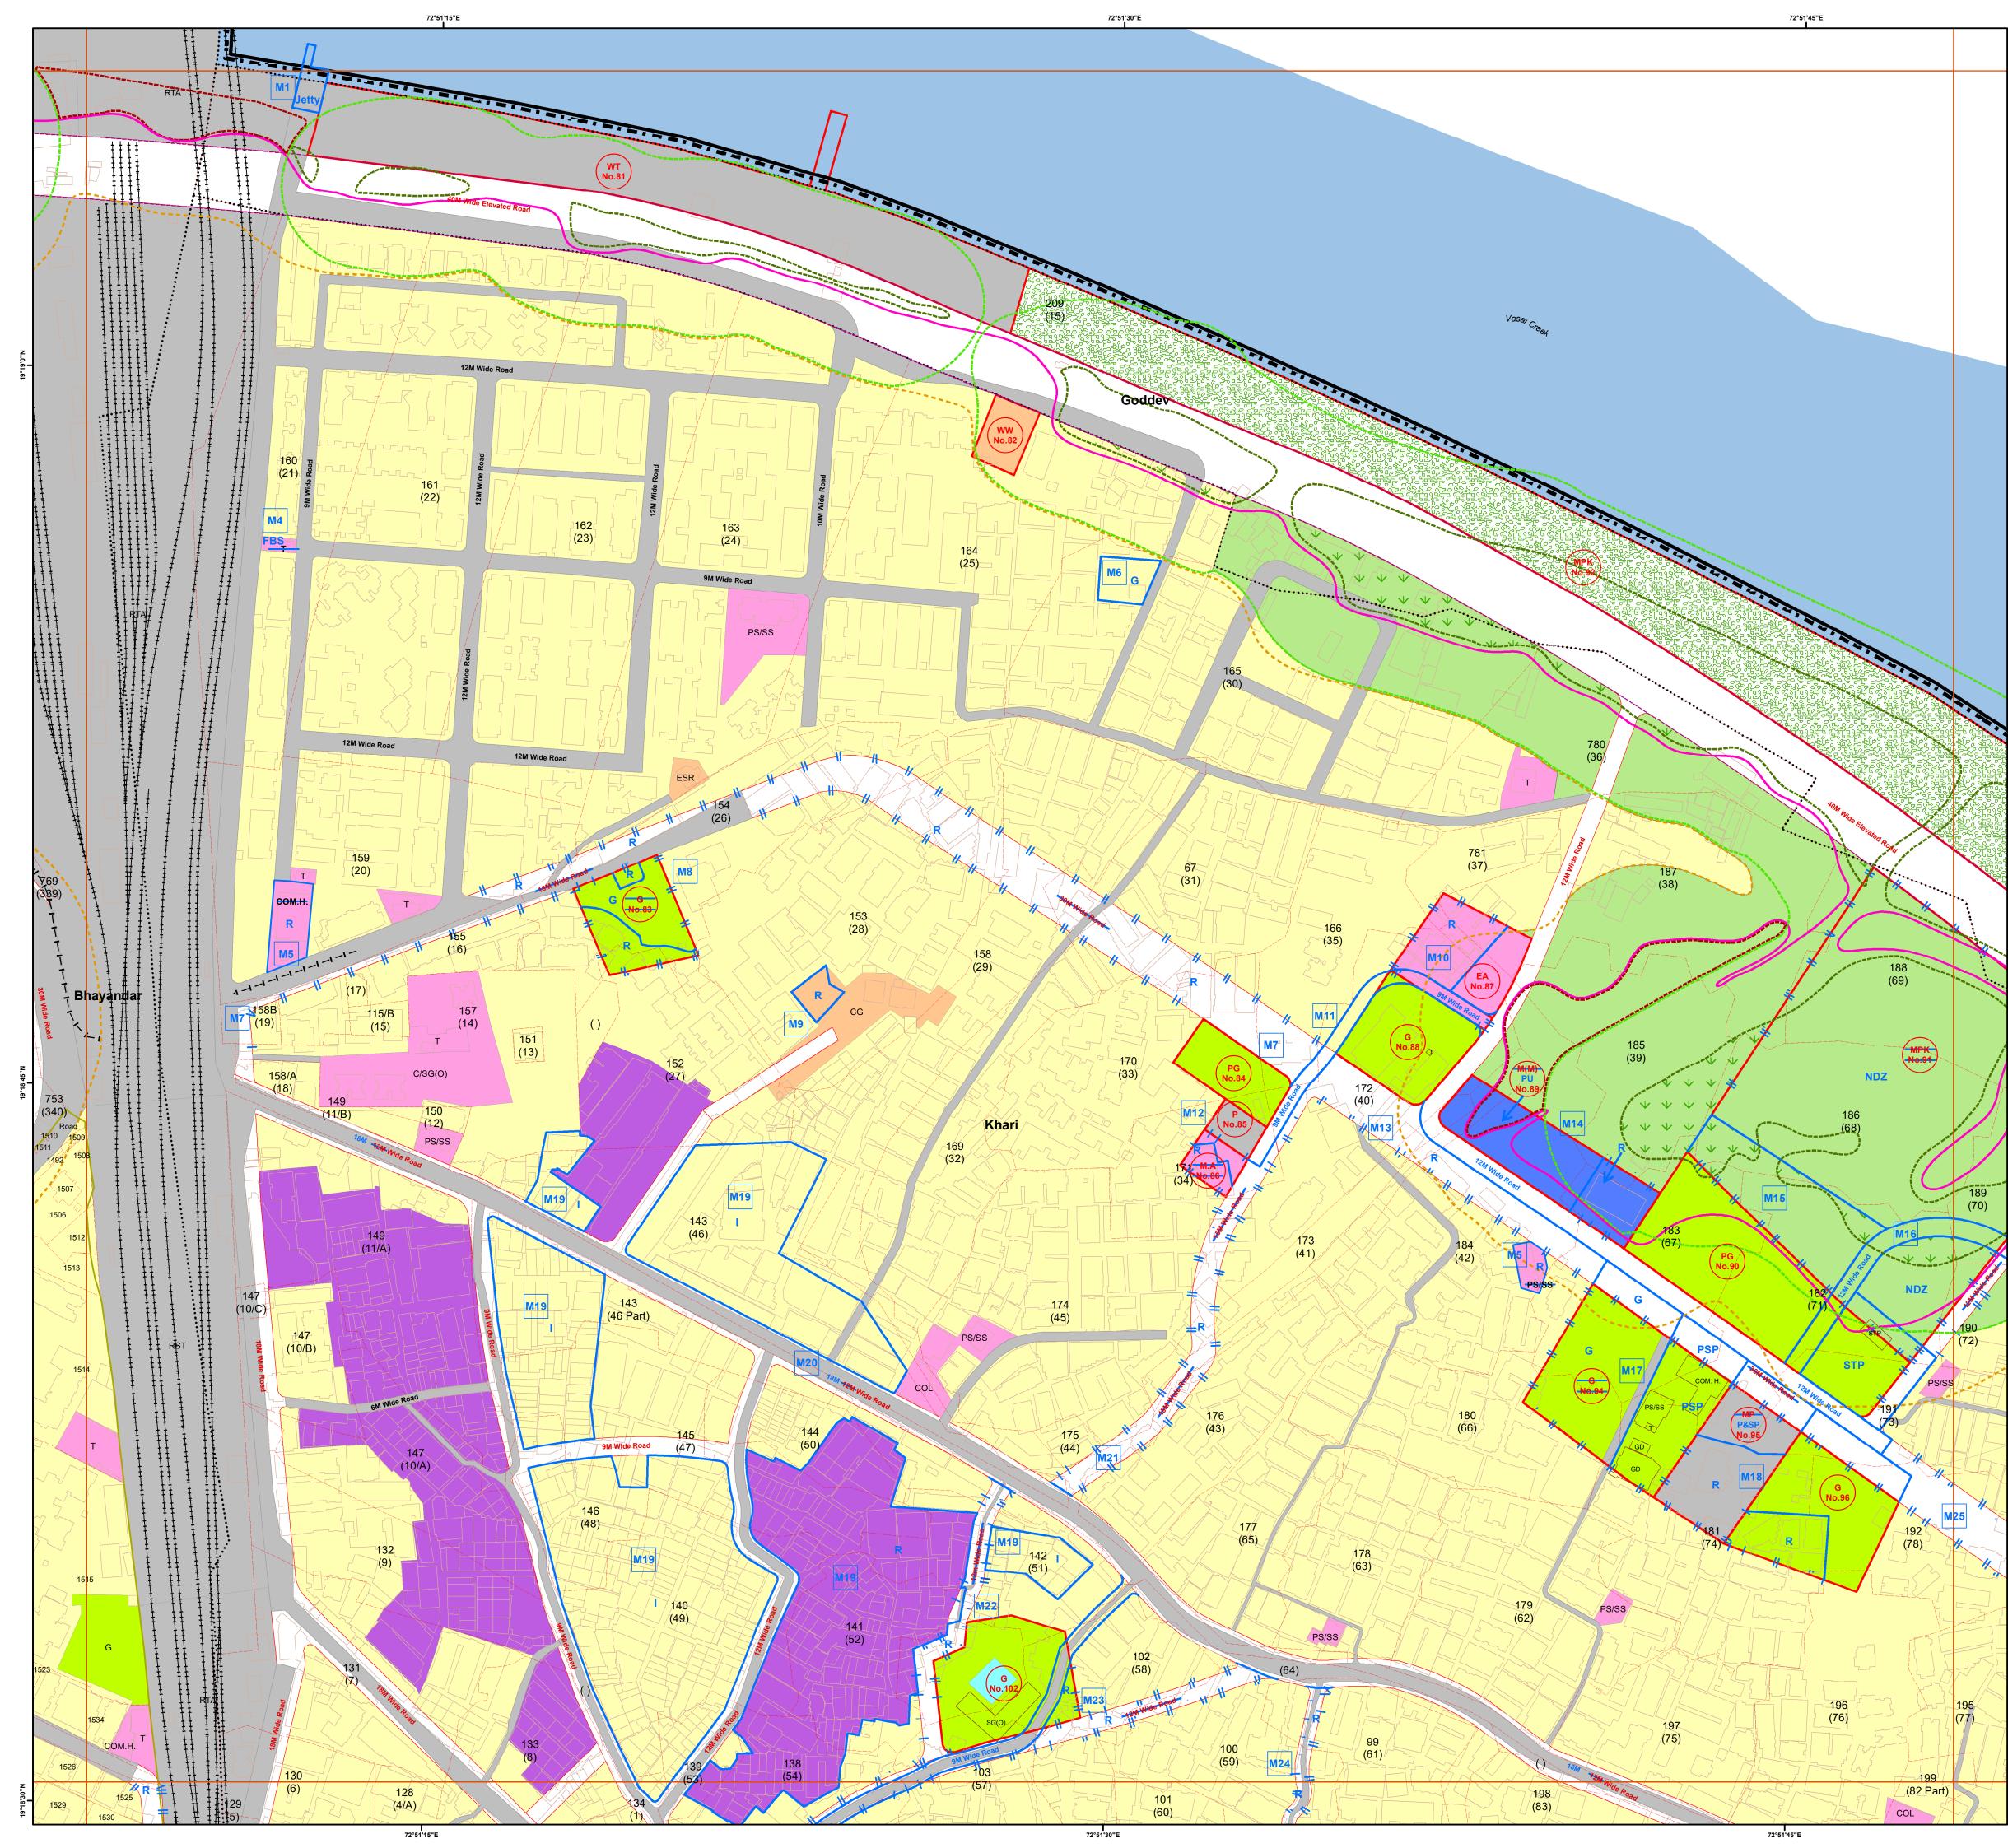

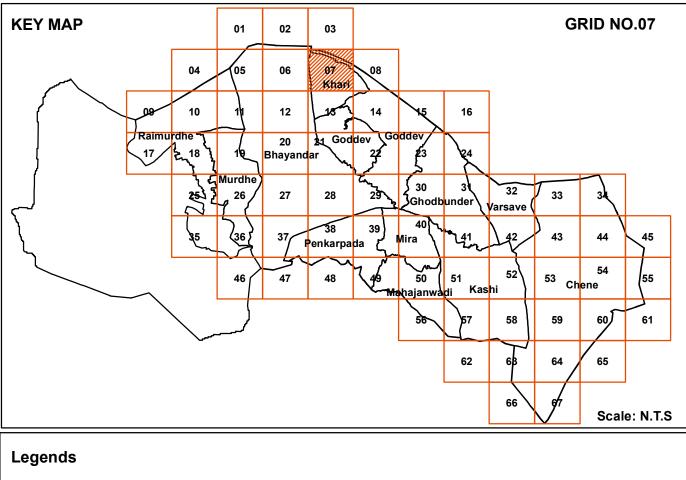



						66	J.	Scale: N.T.S
Lege	ends							
Road		Religi	ous	Rese	rvations			
NH	National Highway	т	Temple	(HFD No.)	Housing for Dish	oused	SC No.	Shopping Center
EW	Expressway	м	Mosque	EWSX	Housing for			
	Major City Road	1	ldgah		Economically We Section (EWS)/LI	aker G	(M(M) No.	Municipal Market
Rail	Broad Gauge	с	Church	URS No.	URS Purpose		(FM No.	Fish Market
良	Metro Station	GD	Gurudwara	PAP	Project Affected F	Person	HM No.	Hawkers Market
	Metroline	SY	Synagogue	No.	Women Hostel/			Public Utilities
Bridg		ASH	Ashram	No.	Child Care Cente	r	(PU No.	Fublic Ounties
$\asymp$	Over Bridge		ational Garden		Tribal Hostel		SH No.	Slaughter House
-1-1-1	Subway	PG	Play Ground	G No.	Garden		STP No.	Sewage Treatment Plar
$\equiv$	Road Bridge across Rail	SPC	Sports Centre	PG No.	Playground		ww	Water Works
•••	Flyover Proposed Flyover	Public	Utlities				No.	Burial/Cremation Ground
	Elevated Coastal Road	SPS	Sewage Pumping Station	PK No.	Park		BG/CG/ CM No.	Cemetery
	Elevated Proposed Road	STP	SewageTreatment Plant	MPR No.	Mangrove Park		BUS STO/ BD No	Bus Stand/Depot
 Water	Bodies	ESR/GSR	Elevated & Ground Storage Reservoir	EXC No.	Exhibition Center		BUST	Bus Terminal & Parking
River	River	CG/BG/CM	Crematorium/Burial Ground/	No.				bus reminar ar arking
Lake	Lake	ESS	Cemetery Electric Sub-Station	SPOT	Picnic Spot			Truck Terminal
Ponds	Ponds	BP	Bio Gas Plant	INS.F No.	Institute for Fishe	ries	MP/P No.	Multipurpose Parking/ Parking
Nalla	Nalla	Trans	portation		Educational Ama	nitu		Ū
	Covered Nalla	BUS	Bus Stand/Terminus	E.A. No.	Educational Ame			ISBT Terminus
Resid	ential	RST	Railway Station	(SSA No.	School for Specia Abled	ally	WT No.	Water Terminal
	Residential Area	RTA	Railway Track Area	M.A. No.	Medical Amenity		Trans	Transport Hub
R-R	Restricted - Residential	PAS/PAA	Parking Space/Area				Hub	
R-R1	Restricted - Residential 1	JT	Jetty	(H(M) No.	Municipal Hospita	al	DF No.	Development of Fort
		No De	evelopment Zone	M.OFF No.	Municipal Office		Ext. No.	Extension
SC WM	Shopping Centre/Mall		No Development Zone	MP	Municipal Purpos	•	Т	Onen Theetre
Indus	Market (Daily & Weekly)		National Park(SCNP) Forest Zone(SGNP)	No.	Municipal Fulpos		No.	Open Theatre
Indus	Industrial Area		Mangrove	GOD(M) No.	Municipal Godow	'n	Øpen M No.	Open Market
Educa	ation	2500030150 250003555	Mangrove Buffer	LIB No.	Library		P&SP No.	Parking and Swimming Pool
PS/SS	Primary & Secondary School		Intertidal		Town Hall & Dran	na		vation Status
COL	College	<b>F a a b</b>	<del>CRZ II</del> Sensitive Zone		Theatre	na		Developed
Health	n Services	ECO-S	SGNP Boundary	AUDI No.	Auditorium			·
н	Hospital		Eco-Sensitive Zone Boundary	PL&AQ No.	Planetarium & Ac	warium		Not Developed
UHC	Urban Health Centre	Powe				laanan	Modifi	cation
	al /State Govt Property Quarter	-	Transmission Tower	COM.H No.	Community Hall		Μ	Proposed Modification
C/SG(Q)	Office		Power Transmission Line	(FBS No.	Fire Brigade Stat	ion		l la co
	ay Property		daries		Administrative Bu	uildina	CZMP	
RP	Railway Property	÷=-i	DP Boundary Municipal Corporation Boundar	SG(O) No.	For Govt.office			CRZ_II
	c & Semi-Public	<u> </u>		GOV.P No.	Government Purp	oose		High Tide Line
Audi/D	Auditorium/Drama Theatre	······	Village Boundary	NS No.	Night Shelter			Intertidal
СОМ.Н	Community Hall		Gaothan Boundary		Night Sheller			Mangrove Buffer
SWC	Social Welfare Centre		CTS Area Boundary	OAH No.	Old Age Home		<b>Y Y Y</b>	Mangroves
OAH	Old Age Home	Code	Congested Boundary	PA No.	Public Amenity		$\mathcal{M}$	Mangroves
FS	Fire Station	Cadas						
P.Stn/P.Ch Herita	Police Station/Chowky		Cadastre/CTS	(SDC No.	Skill Developmen	it Center		
Fort	Fort		ng Footprint	PCO No.	Police Commission	oner Offic	е	
	, or		Building Footprint					

#### Notes

1. The Base Map, ELU and Draft PLU prepared by superimposition of data collected from various Government / Semi Government / Departments / Stakeholders and physical features depicted from Drone / Satellite Imagery; hence, the discrepancies may occur.

2. Proposed Land-use Shall prevail irrespective of property number / boundary shown on map which shall be subject to confirmation from Land Record or competent Authority.

3. The structure on the map does not confirm authorization unless verified and rectified by Planning Authority. 4.SGNP, CRZ, Mangroves with their buffers shown on the plan shall be as per the relevant status. In case of any modifications to such status in future, such boundary and buffer shall automatically stand modified as per the latest notification. 5. The alignment of Metro, Coastal Elevated Road marked on plan are indicative & automatically stand modified by the notification issued by Government from time to time. 6.The alignment of nallah / river / creek is indicative and as per the feature extracted from Drone Imagery and data collected.

7. The boundaries of all the designated sites, Government property are shown as per the image captured by superimposition on cadastral map. This may be subject to change as per the actual acquisition in future. 8.This plan is to be read with UDCPR-2022 and Draft DP Report.

P.Existing road shall have status of the road according to width of road even though not shown in development plan. 10.R-R(Restricted-Residential) Residential Zone subject to handing over area to corporation as per permission/Government orders.

11.R-R1 (Restricted- Residential1) All provision of Residential Zone in UDCPR-2020 will be applicable for this zone subject to 10% of area under Development should be kept for Amenity Space as per direction of Municipal Commissioner with prior permission from Eco-Sensitive Zone Commitee.


12.If the location of Metro Carshed and Metro Line is shifted by MMRDA or Elevated Road is shifted in future, the land eased by such shifting shall stands included in adjoining Zone shown on Development Plan.

Scale				North	N	
0	0.05	0.1	0.2 kn	n	WEE	
		1:2,000			s	
31101 2	मुल्यनिधार्म		$\bigcirc 24$			





Officer Appointed U/s 21(4A) Draft Revised Development Plan of Mira Bhayandar

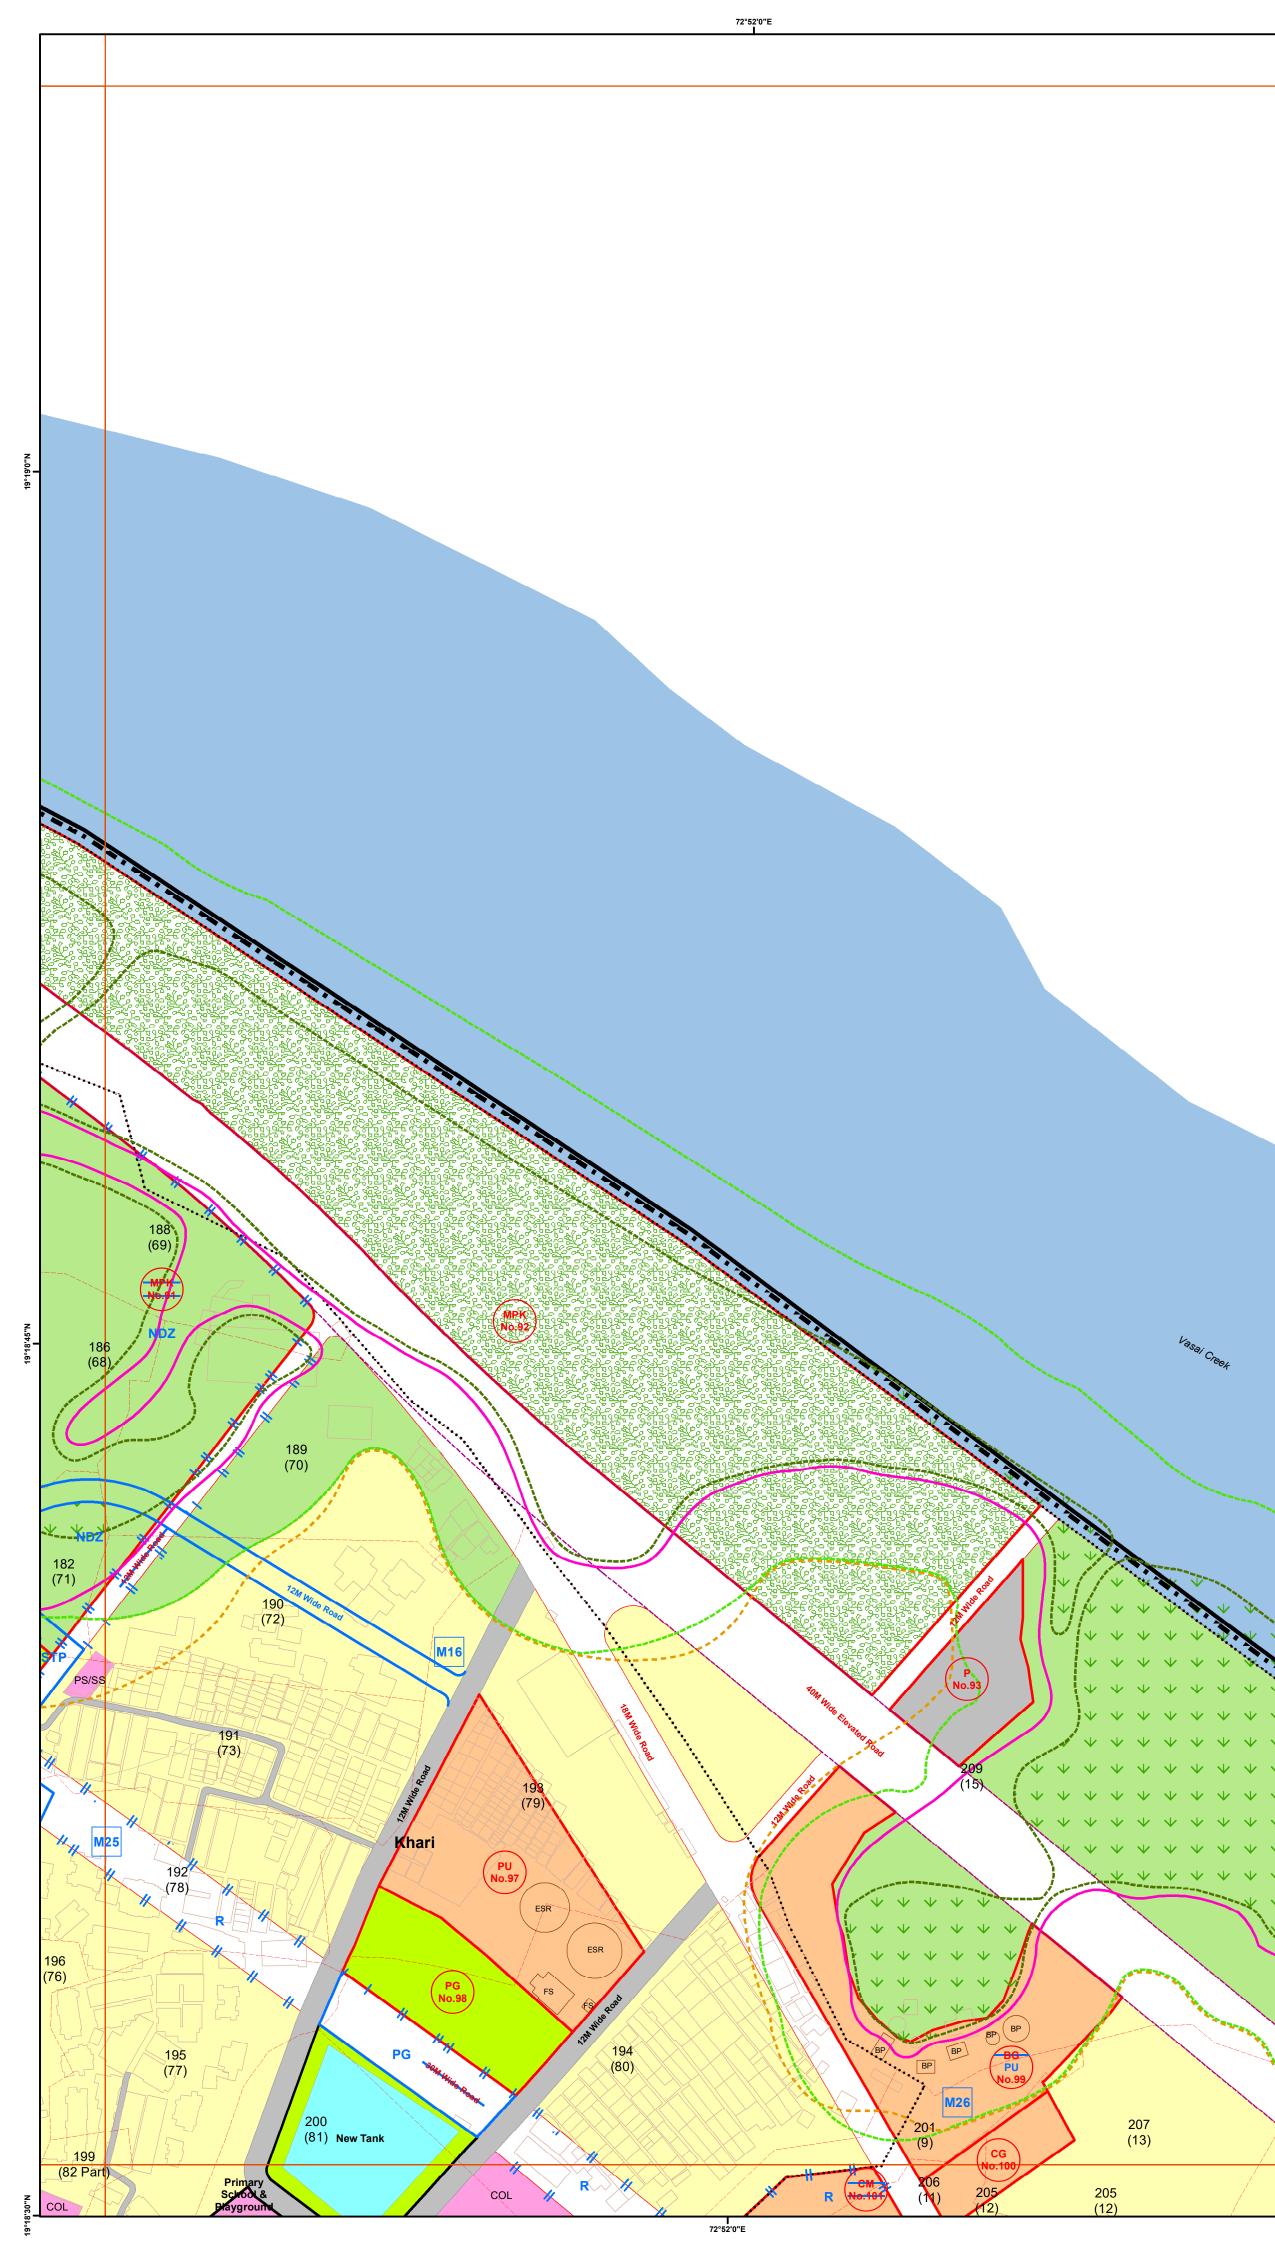








 $\nabla \nabla \nabla$ 

208

(14)

72°52'15"E

## DRAFT REVISED DEVELOPMENT PLAN Mira Bhayandar Municipal Corporation (Published U/s.28(4) of M.R.&T.P. Act 1966)

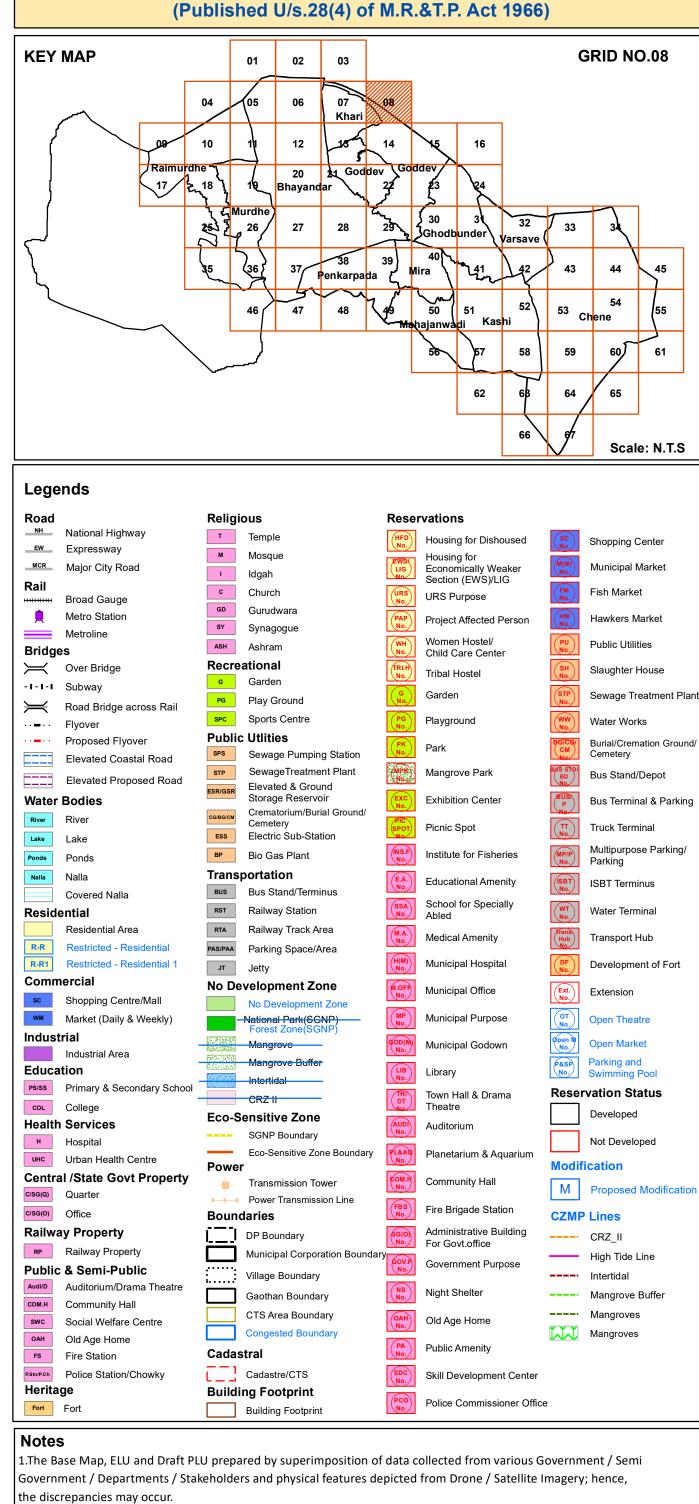

2. Proposed Land-use Shall prevail irrespective of property number / boundary shown on map which shall be subject to confirmation from Land Record or competent Authority.

3.The structure on the map does not confirm authorization unless verified and rectified by Planning Authority. 4.SGNP, CRZ, Mangroves with their buffers shown on the plan shall be as per the relevant status. In case of any modifications to such status in future, such boundary and buffer shall automatically stand modified as per the latest notification. 5. The alignment of Metro, <del>Coastal</del> Elevated Road marked on plan are indicative & automatically stand modified by the notification issued by Government from time to time. 6. The alignment of nallah / river / creek is indicative and as per the feature extracted from Drone Imagery and data collected.

7. The boundaries of all the designated sites, Government property are shown as per the image captured by superimposition on cadastral map. This may be subject to change as per the actual acquisition in future. 8.This plan is to be read with UDCPR-2022 and Draft DP Report.

9.Existing road shall have status of the road according to width of road even though not shown in development plan. 10.R-R(Restricted-Residential) Residential Zone subject to handing over area to corporation as per permission/Government orders.

11.R-R1 (Restricted- Residential1) All provision of Residential Zone in UDCPR-2020 will be applicable for this zone subject to 10% of area under Development should be kept for Amenity Space as per direction of Municipal Commissioner with prior permission from Eco-Sensitive Zone Commitee.

12.If the location of Metro Carshed and Metro Line is shifted by MMRDA or Elevated Road is shifted in future, the land eased by such shifting shall stands included in adjoining Zone shown on Development Plan.


Scale				North N
0	0.05	0.1	0.2 km	WEE
		1:2,000		S
3100	मुल्यनिधर्मन्त		OPt	




72°52'30"E



Officer Appointed U/s 21(4A) Draft Revised Development Plan of Mira Bhayandar

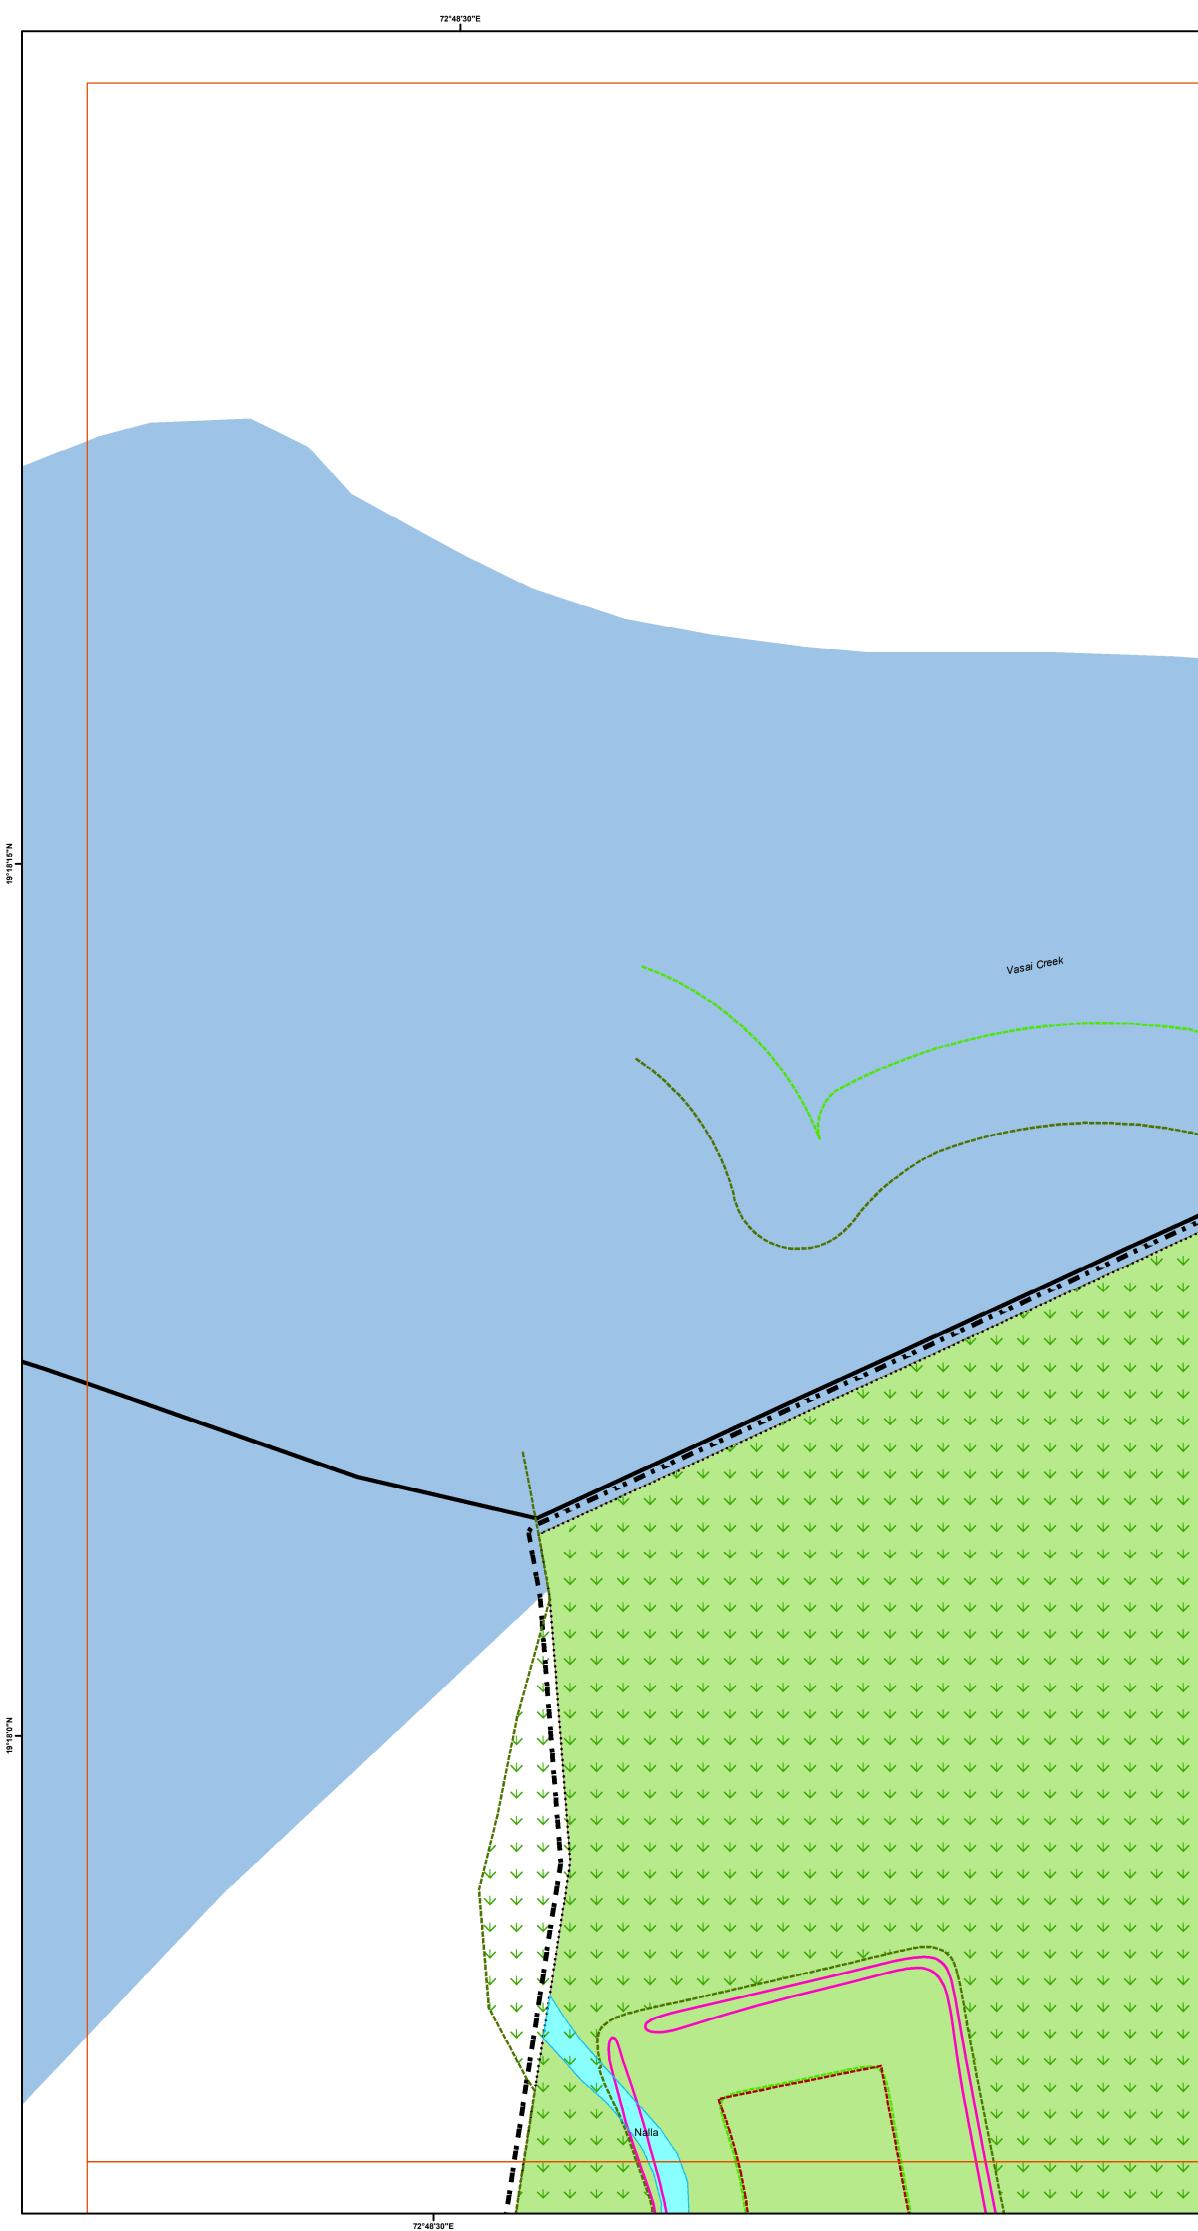

	A LA

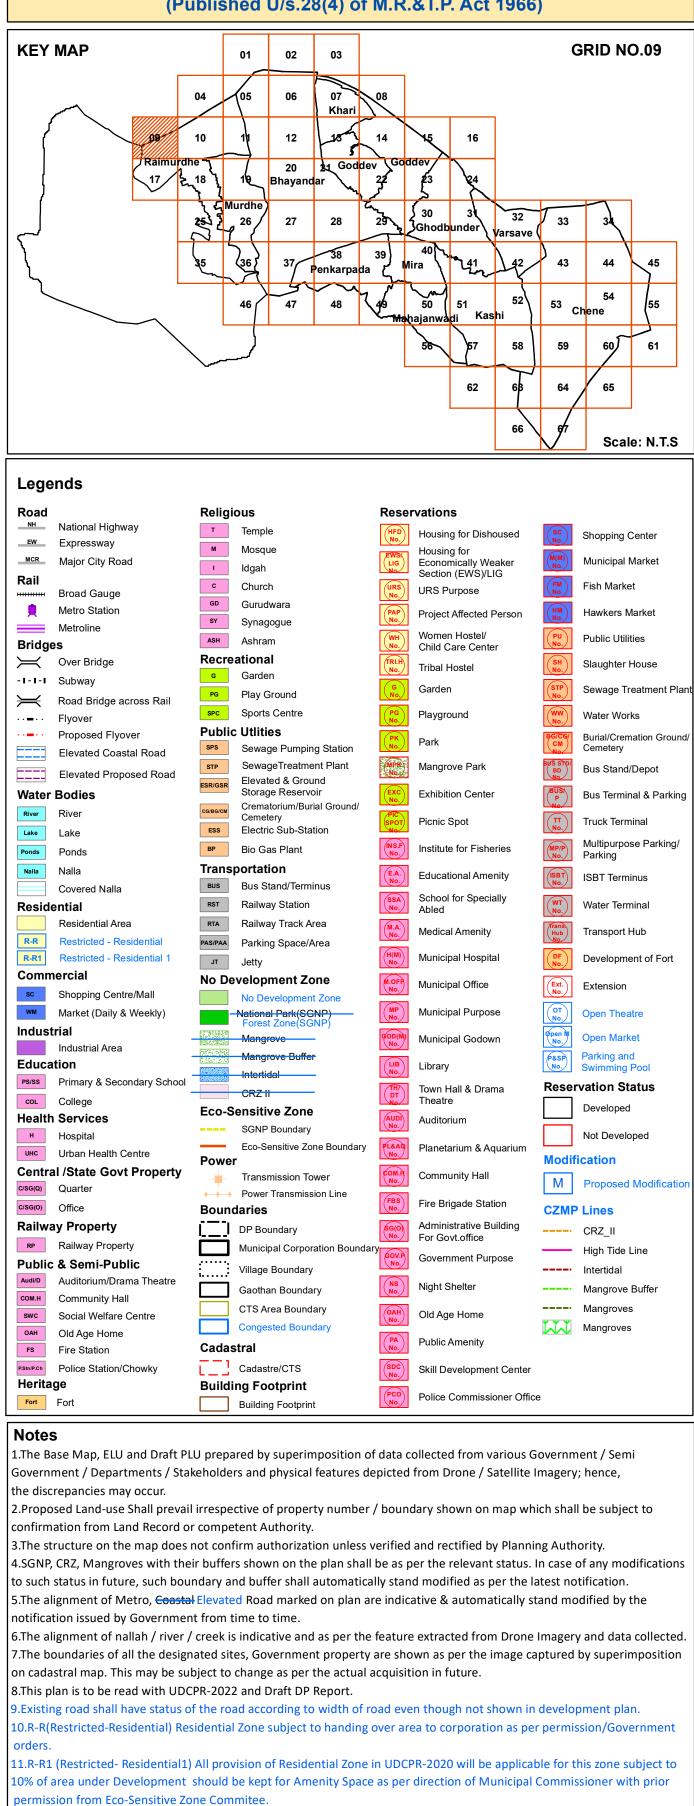


12.If the location of Metro Carshed and Metro Line is shifted by MMRDA or Elevated Road is shifted in future, the land released by such shifting shall stands included in adjoining Zone shown on Development Plan.

Scale				North N
0	0.05	0.1	0.2 km	WEE
		1:2,000		S
311	मुल्यनिधारुव		REt.	



Draft Revised Development Plan of Mira Bhayandar

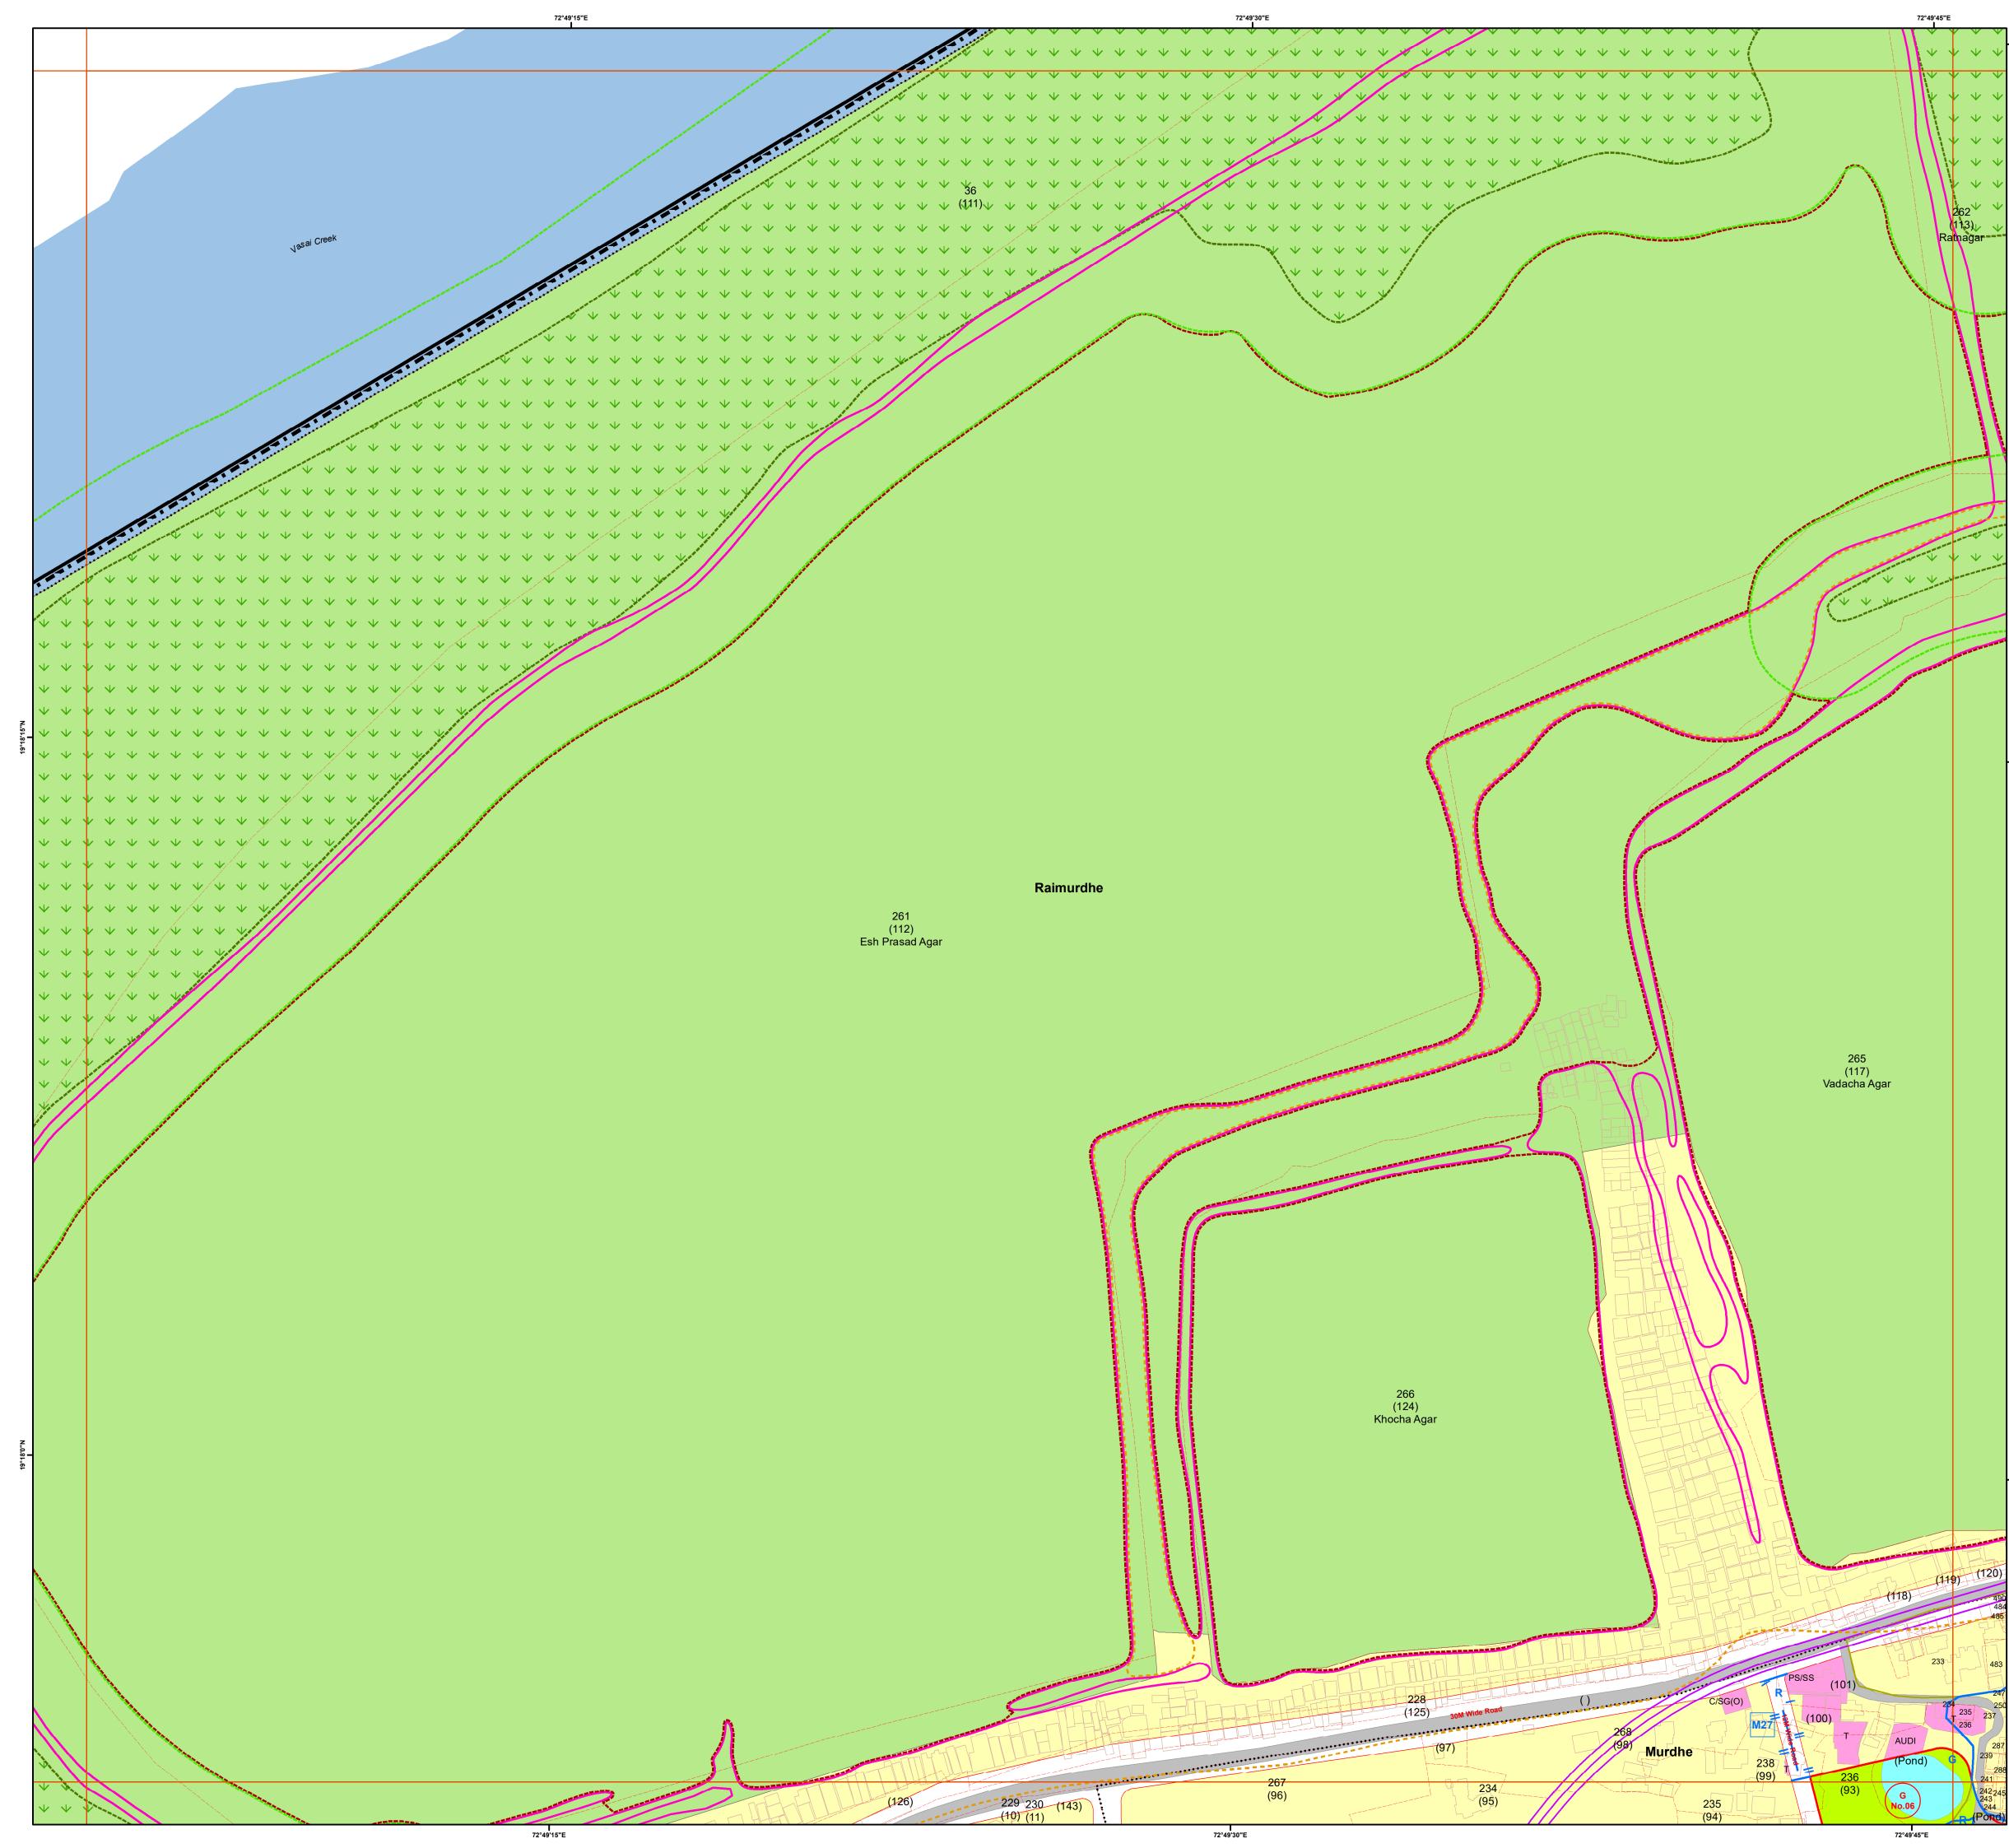

(Pu	iblished U/s.28(4) o	of M.R.&T.P. Act 1966	<b>;</b> )
KEY MAP	01 02 03		GRID NO.10
Г	AL AT AT AT		
	04 05 06 07 Khari	08	
		14 15 16	
Raimurdh 17	18 19 19 Bhayandar	dev Goddev 24 23 24	
	25 26 27 28	29 30 3 32	33 34
$\sim$	253 2 26 27 28	39 40 Varsave	
	35 36 37 Penkarpa		43 44 45
	46 47 48	49 50 51 52 Mahajanwadi Kashi	54 53 <sub>Ch</sub> ene (55
		56 57 58	59 60 61
· · · · · · · · · · · · · · · · · · ·			
		62 68	64 65
		66	Scale: N.T.S
Legends Road	Religious	Reservations	
NH National Highway     Ew Expressway	Temple	Housing for Dishoused	Shopping Center
MCR Major City Road	Mosque	Housing for Economically Weaker Section (EWS)/LIG	Municipal Market
Rail Broad Gauge	Church	URS Purpose	FM Fish Market
Metro Station Metroline	sy Synagogue	Project Affected Person	HM Hawkers Market
Bridges — Over Bridge	Ashram Recreational	WH No. Women Hostel/ Child Care Center	Public Utilities       SH       Slaughter House
-I-I-I Subway	Garden	Garden	Sewage Treatment Pla
Road Bridge across Rail	spc Sports Centre	Playground	WWW Water Works
Proposed Flyover     Elevated Coastal Road	Public Utities           SPS         Sewage Pumping Station	PK Park	Burial/Cremation Grour Cemetery
Elevated Proposed Road	STP         SewageTreatment Plant           Esr/gsr         Elevated & Ground	Mangrove Park	BUS Stand/Depot
Water Bodies River River	CCUBBICM CCUBBICM Crematorium/Burial Ground/ Cemetery		Bus Terminal & Parkin
Lake Lake	Electric Sub-Station BP Bio Gas Plant	Picnic Spot	Truck Terminal Multipurpose Parking/
Ponds Ponds Nalla	Transportation	Educational Amenity	Multipurpose Parking/ Parking ISBT Terminus
Covered Nalla Residential	BUS Bus Stand/Terminus RST Railway Station	School for Specially Abled	WT Water Terminal
Residential Area Restricted - Residential	RTA         Railway Track Area           PAS/PAA         Parking Space/Area	Medical Amenity	Transport Hub
<b>R-R1</b> Restricted - Residential 1	JT Jetty	(HM) No. Municipal Hospital	Development of Fort
Shopping Centre/Mall	No Development Zone No Development Zone	MoFF Municipal Office	Ext. Extension
Market (Daily & Weekly)	- National Park(SCNP) Forest Zone(SGNP)	MP No. Municipal Purpose	OT No. Open Theatre
Industrial Area Education	Mangrove Buffer	Municipal Godown	Open Market Parking and Swimming Pool
Ps/ss Primary & Secondary School	- Intertidal - CRZ II	Town Hall & Drama	Reservation Status
College Health Services	Eco-Sensitive Zone	Auditorium	Developed
н Hospital Urban Health Centre	SGNP Boundary     Eco-Sensitive Zone Bounda		Not Developed
Central /State Govt Property	<b>Power</b> Transmission Tower	Community Hall	M Proposed Modificati
c/sg(o) Office	Power Transmission Line Boundaries	FBS No. Fire Brigade Station	CZMP Lines
Railway Property Railway Property	DP Boundary Municipal Corporation Bour	Administrative Building For Govt.office	CRZ_II High Tide Line
Public & Semi-Public Auditorium/Drama Theatre	Village Boundary	Government Purpose	Intertidal
сом.н Community Hall	Gaothan Boundary	Night Shelter	· Mangrove Buffer · Mangroves
Swc         Social Welfare Centre           OAH         Old Age Home	Congested Boundary	Old Age Home	Mangroves
FS Fire Station Police Station/Chowky	Cadastral	PA No         Public Amenity           SDC No         Skill Development Center	
Heritage Fort Fort	Building Footprint	Police Commissioner Offic	ce
	Building Footprint		
<b>Notes</b> 1.The Base Map, ELU and Draft PL			
Government / Departments / Stal the discrepancies may occur.	keholders and physical features	depicted from Drone / Satellite	Imagery; hence,
2.Proposed Land-use Shall prevail	l irrespective of property numb r competent Authority.	er / boundary shown on map wh	nich shall be subject to

confirmation from Land Record or competent Authority. 3. The structure on the map does not confirm authorization unless verified and rectified by Planning Authority.

4.SGNP, CRZ, Mangroves with their buffers shown on the plan shall be as per the relevant status. In case of any modifications to such status in future, such boundary and buffer shall automatically stand modified as per the latest notification. 5.The alignment of Metro, Coastal Elevated Road marked on plan are indicative & automatically stand modified by the notification issued by Government from time to time. 6.The alignment of nallah / river / creek is indicative and as per the feature extracted from Drone Imagery and data collected.

7. The boundaries of all the designated sites, Government property are shown as per the image captured by superimposition on cadastral map. This may be subject to change as per the actual acquisition in future. 8.This plan is to be read with UDCPR-2022 and Draft DP Report.

9.Existing road shall have status of the road according to width of road even though not shown in development plan. 10.R-R(Restricted-Residential) Residential Zone subject to handing over area to corporation as per permission/Government rders. 11.R-R1 (Restricted- Residential1) All provision of Residential Zone in UDCPR-2020 will be applicable for this zone subject to

10% of area under Development should be kept for Amenity Space as per direction of Municipal Commissioner with prior permission from Eco-Sensitive Zone Commitee.

12.If the location of Metro Carshed and Metro Line is shifted by MMRDA or Elevated Road is shifted in future, the land leased by such shifting shall stands included in adjoining Zone shown on Development Plan.


Scale				North N
0	0.05	0.1	0.2 km	WEE
		1:2,000		S
1	ल मुल्यनिधार्रव		600+	·






Officer Appointed U/s 21(4A) Draft Revised Development Plan of Mira Bhayandar



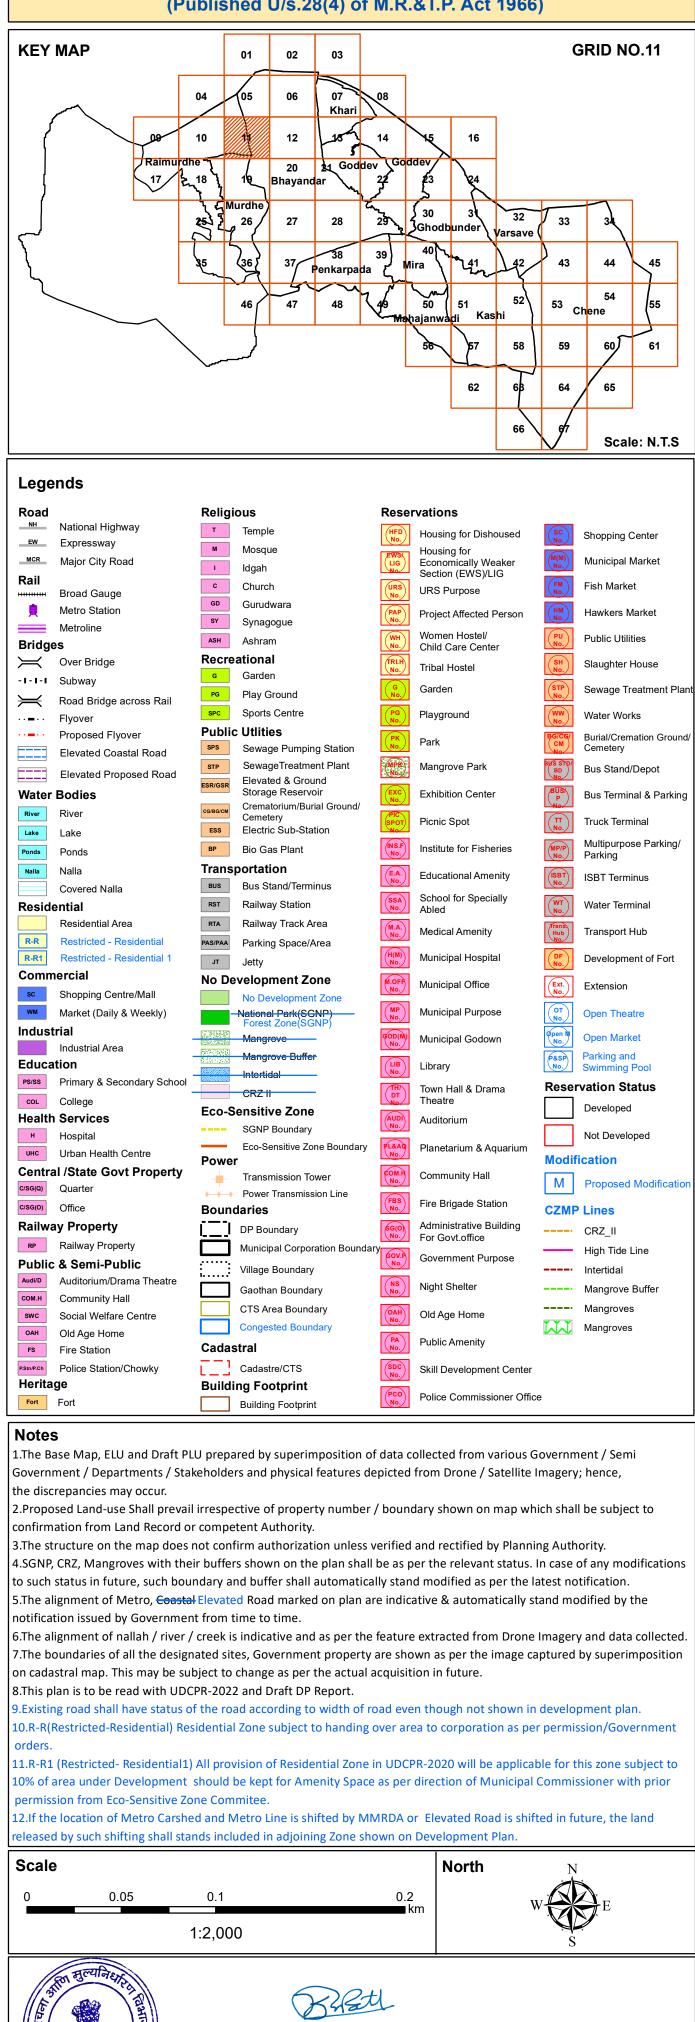

Officer Appointed U/s 21(4A) Draft Revised Development Plan of Mira Bhayandar

Enterna a

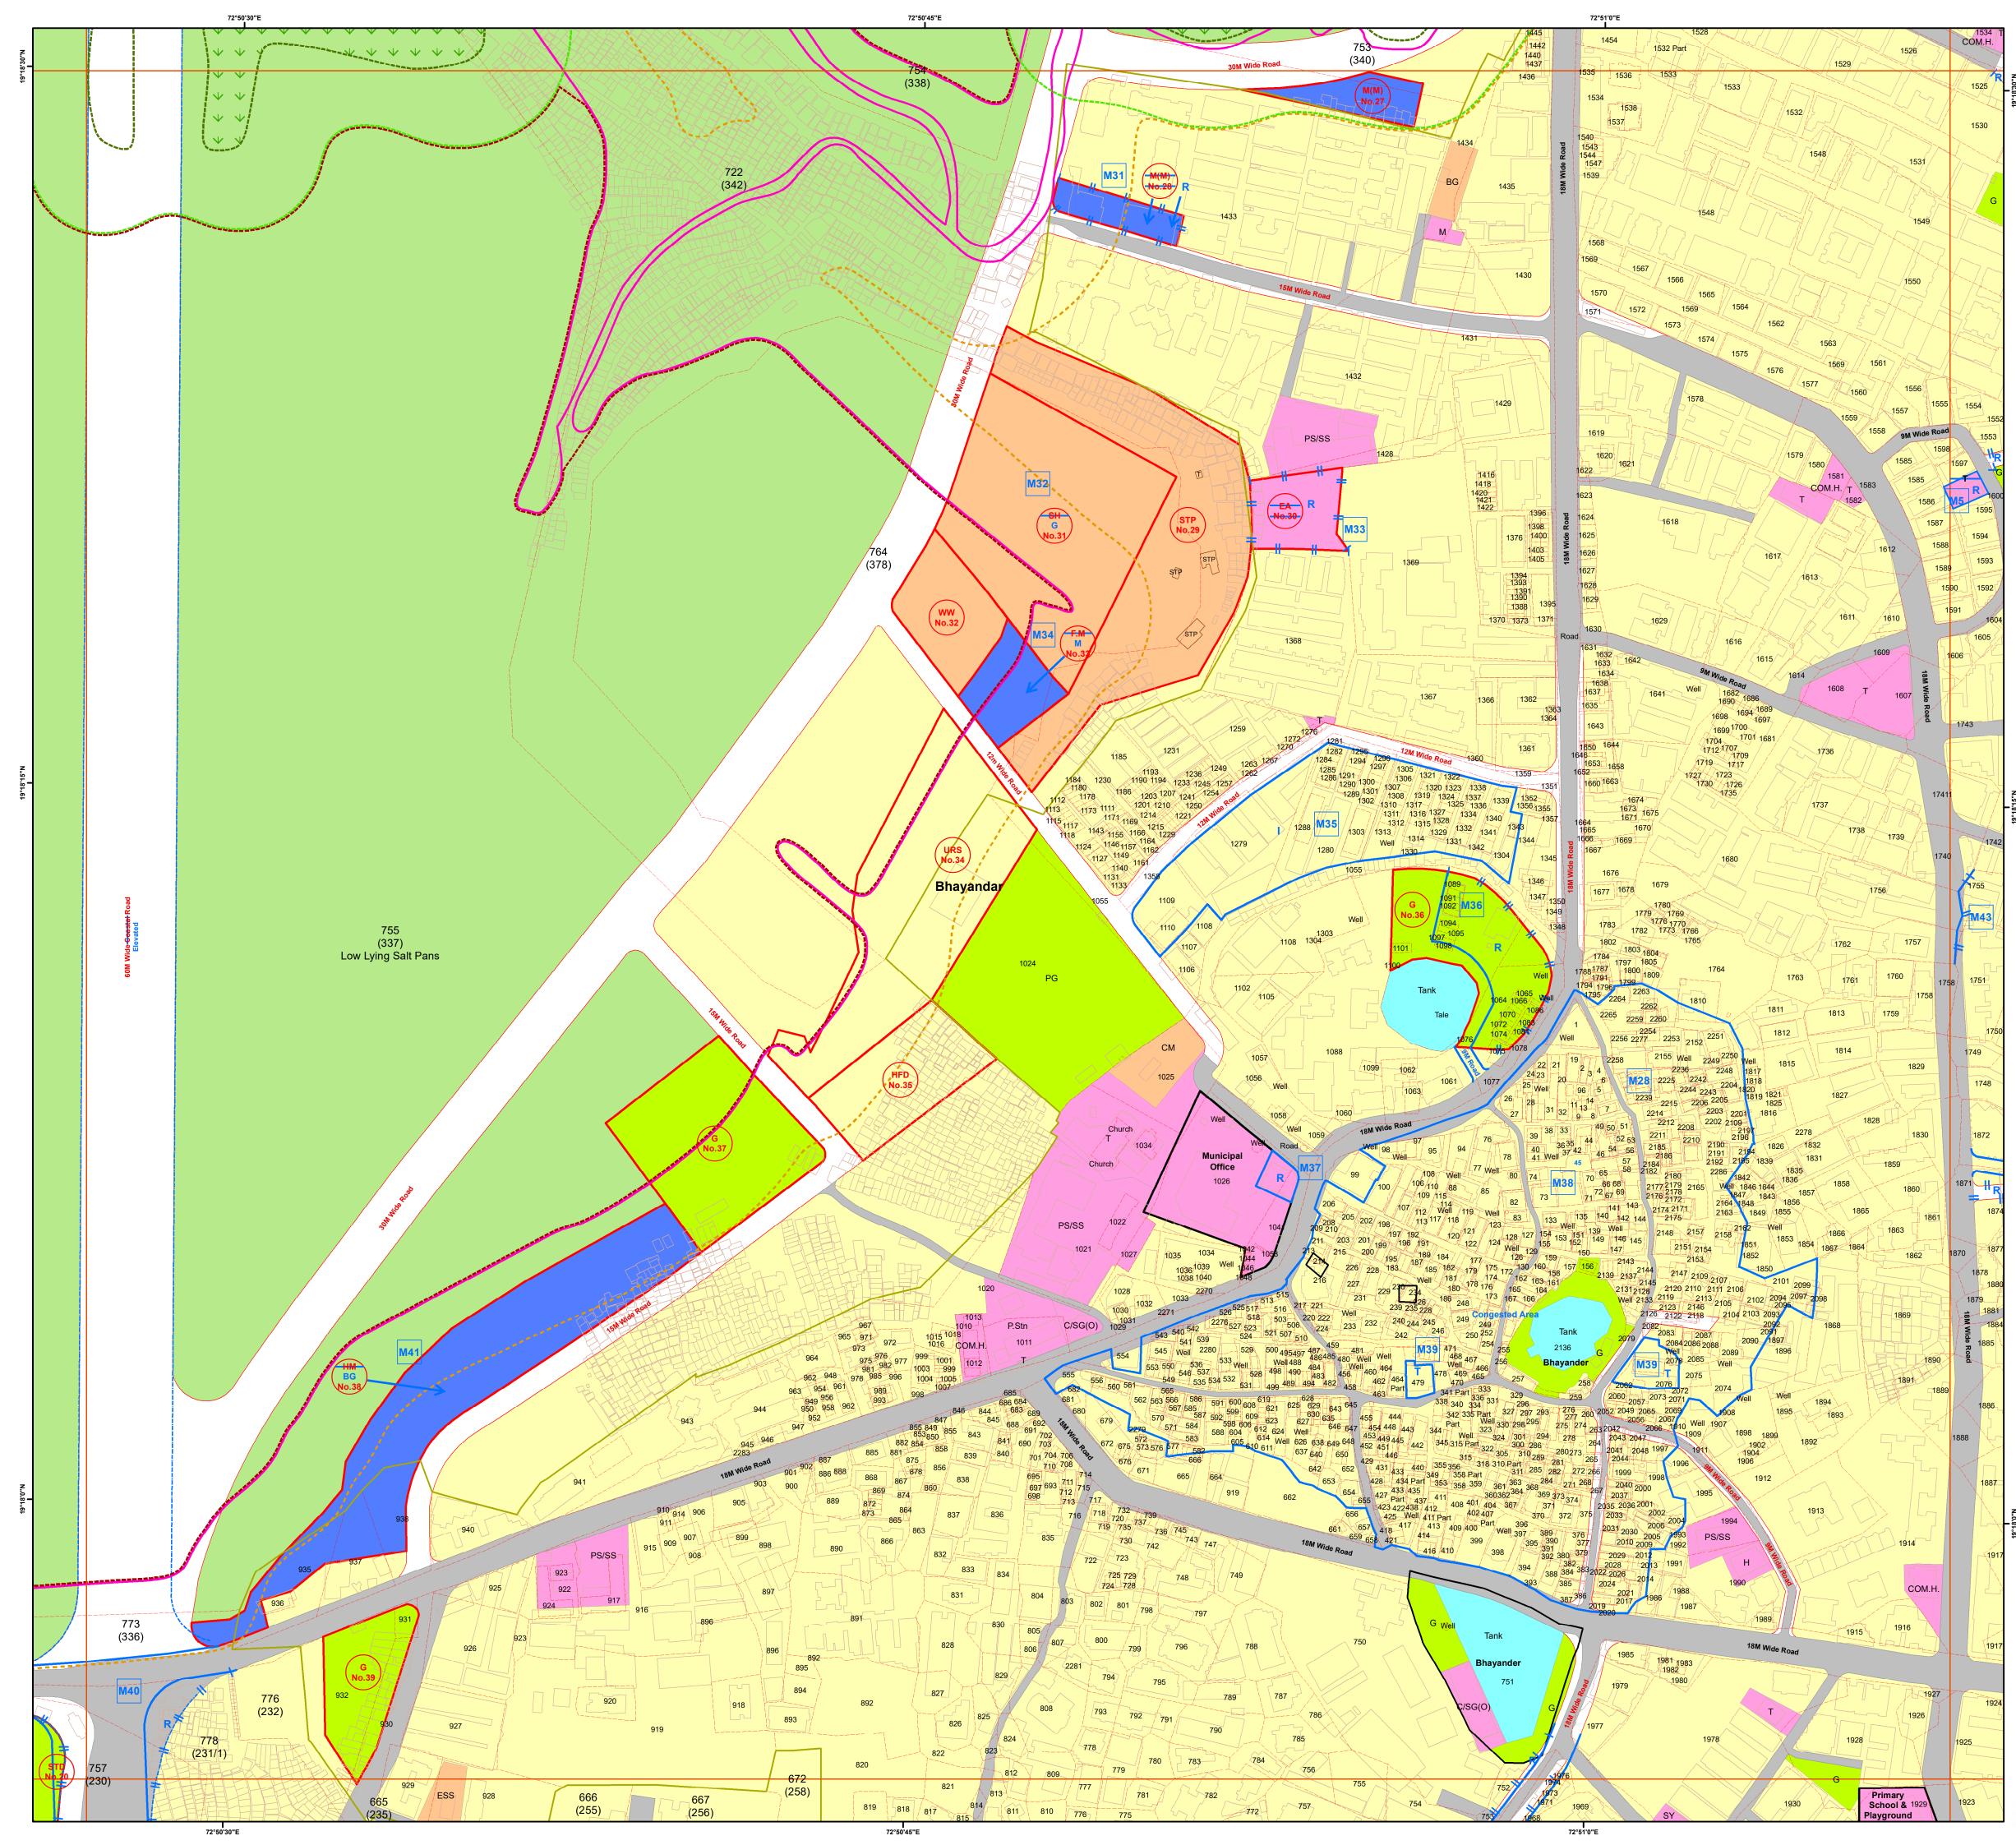



confirmation from Land Record or competent Authority. 3.The structure on the map does not confirm authorization unless verified and rectified by Planning Authority. 4.SGNP, CRZ, Mangroves with their buffers shown on the plan shall be as per the relevant status. In case of any modifications

to such status in future, such boundary and buffer shall automatically stand modified as per the latest notification.
5.The alignment of Metro, <del>Coastal Elevated</del> Road marked on plan are indicative & automatically stand modified by the notification issued by Government from time to time.
6.The alignment of nallah / river / creek is indicative and as per the feature extracted from Drone Imagery and data collected.

7.The boundaries of all the designated sites, Government property are shown as per the image captured by superimposition on cadastral map. This may be subject to change as per the actual acquisition in future.8.This plan is to be read with UDCPR-2022 and Draft DP Report.

9.Existing road shall have status of the road according to width of road even though not shown in development plan.
10.R-R(Restricted-Residential) Residential Zone subject to handing over area to corporation as per permission/Government orders.
11.R-R1 (Restricted- Residential1) All provision of Residential Zone in UDCPR-2020 will be applicable for this zone subject to

10% of area under Development should be kept for Amenity Space as per direction of Municipal Commissioner with prior permission from Eco-Sensitive Zone Commitee.
12.If the location of Metro Carshed and Metro Line is shifted by MMRDA or Elevated Road is shifted in future, the land

released by such shifting shall stands included in adjoining Zone shown on Development Plan.


Scale				North N
0	0.05	0.1	0.2 km	WEE
		1:2,000		S
31101	मुल्यनिधरिष		6004	





Officer Appointed U/s 21(4A)

Draft Revised Development Plan of Mira Bhayandar

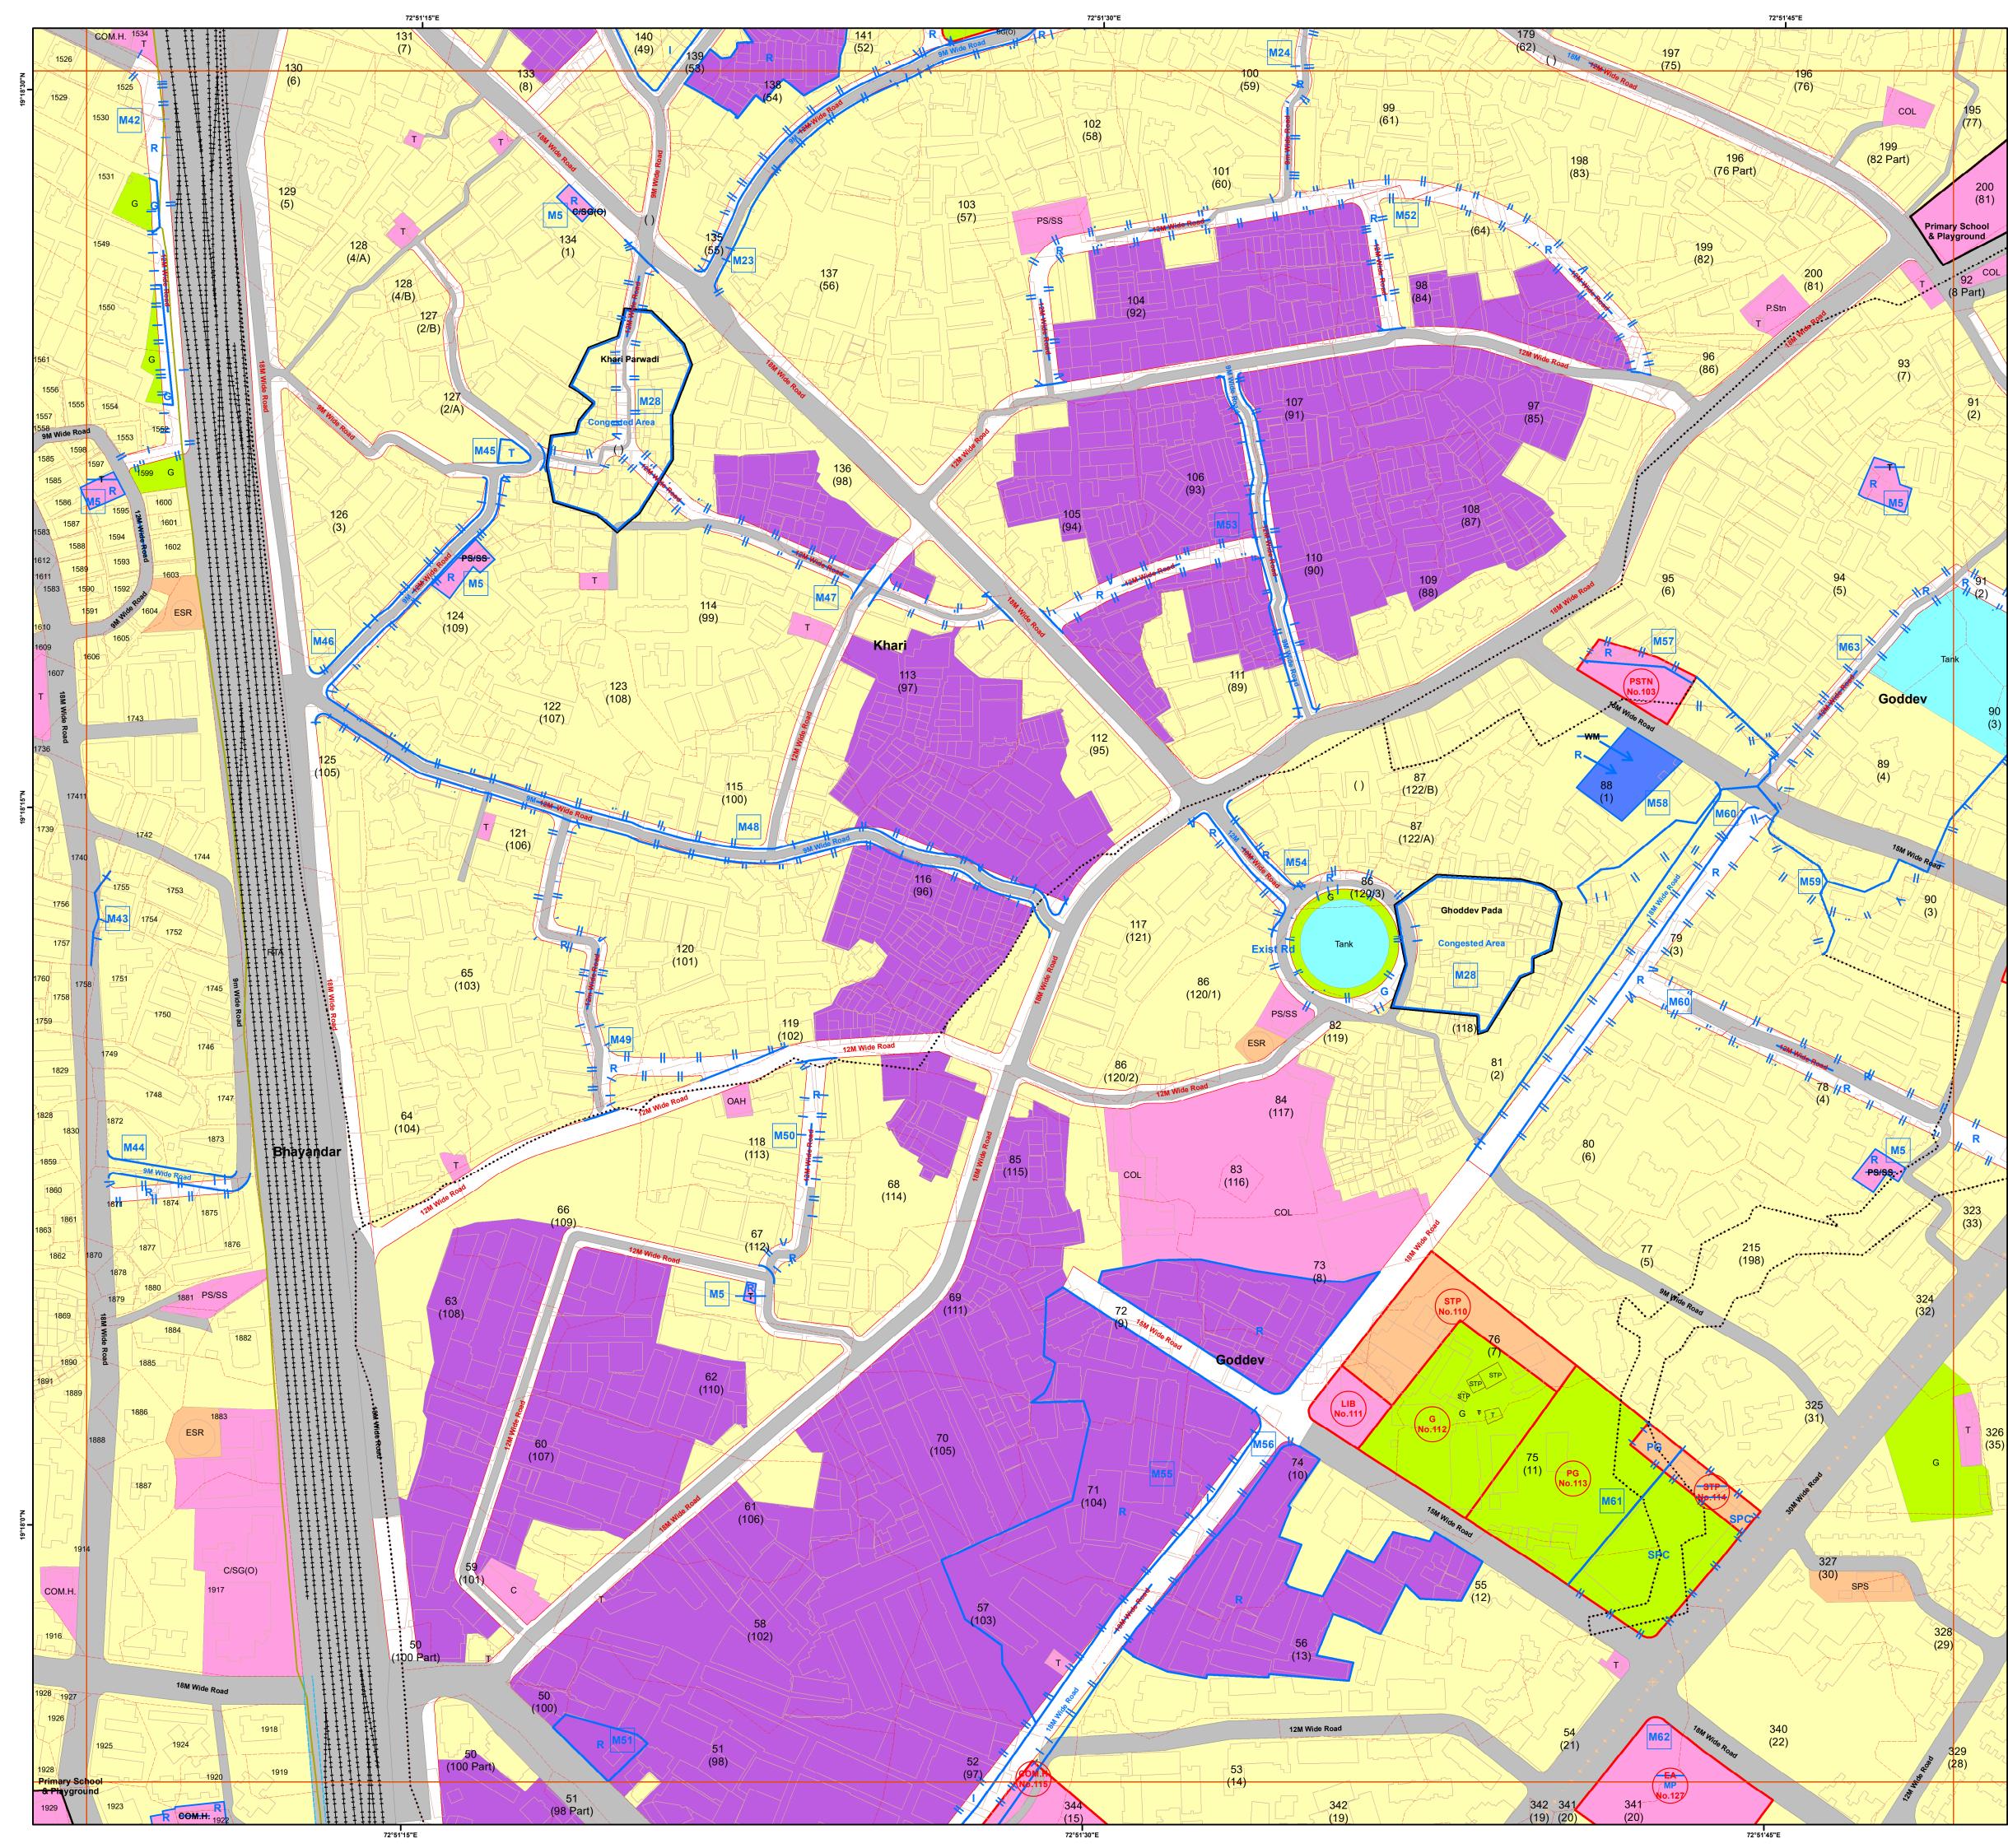

(Pu	iblished U/s.28(4) of	f M.R.&T.P. Act 1966	5)
KEY MAP	01 02 03		GRID NO.13
	04 05 06 07 Khari	08	
	10 11 12 13	14 15 16	
Raimurdh 17 E	18 1 Gode 18 1 19 Bhayandar 1 4 Murdhe	Lev Goddev 27 23 24	
جــــــــــــــــــــــــــــــــــــ	25 26 27 28	29 23 Ghodbunder Varsave	33 34
	35 36 37 Penkarpad	Ha $Hira$ $Hira$ $Hira$ $Hira$ $Hira$ $Ha$	43 44 45
		49 50 51 52 Mahajanwadi Kashi	<sup>53</sup> Chene 55
		56 67 58	59 60 61
		62 6B	64 65
		66 `	67 Scale: N.T.S
Legends			
Road ™National Highway	Religious Temple	Reservations	Shopping Center
EXPressway MCR Major City Road	Mosque	Housing for (ug) Economically Weaker	(M(M) Municipal Market
Rail	ldgah Church	Section (EWS)/LIG	FM Fish Market
Broad Gauge     Metro Station	GD Gurudwara		HM No. Hawkers Market
Metroline	Synagogue	PAP No.         Project Affected Person           WH         Women Hostel/	
Bridges	Ashram Recreational	Child Care Center	PU Public Utilities
-I-I-I Subway	Garden	Tribal Hostel	Slaughter House
Road Bridge across Rail	PG Play Ground	Garden	Sewage Treatment PI
··· <b>-</b> ·· Flyover	spc Sports Centre	Playground Playground	WW Water Works
Proposed Flyover     Elevated Coastal Road	Public Utlities           SPS         Sewage Pumping Station	PK Park	Burial/Cremation Grour
Elevated Proposed Road	SewageTreatment Plant	Mangrove Park	BUS Stand/Depot
Water Bodies	Elevated & Ground Storage Reservoir	Exhibition Center	( <sup>BUS/</sup> Bus Terminal & Parkin
River River	Crematorium/Burial Ground/ Cemetery	(SPOT) Picnic Spot	Truck Terminal
	Electric Sub-Station	Institute for Fisheries	Multipurpose Parking/
Ponds Ponds Nalla	Bio Gas Plant Transportation		No. Parking
Covered Nalla	Bus Stand/Terminus	E.A. No. Educational Amenity	ISBT Terminus
Residential	RST Railway Station	Ssa No. School for Specially Abled	WT Water Terminal
Residential Area R-R Restricted - Residential	RTA Railway Track Area PAS/PAA Parking Space/Area	M.A. No. Medical Amenity	Transport Hub
<b>R-R1</b> Restricted - Residential 1	JT Jetty	(H(M) No. Municipal Hospital	DF No. Development of Fort
Commercial	No Development Zone	Municipal Office	Ext. Extension
Sc Shopping Centre/Mall Market (Daily & Weekly)	No Development Zone National Park(SCNP)	Municipal Purpose	
Industrial	National Park(SCNP)     Forest Zone(SGNP)     Mangrove	(No.) Municipal Godown	Open Market
Industrial Area	Mangrove Buffer		Parking and
Ps/ss Primary & Secondary School	Intertidal	Library	Swimming Pool Reservation Status
CoL College	Eco-Sensitive Zone	Town Hall & Drama Theatre	
Health Services	SGNP Boundary	Auditorium	
н Hospital Urban Health Centre	Eco-Sensitive Zone Boundary	Planetarium & Aquarium	Not Developed
Central /State Govt Property	Power	Community Hall	Modification M Proposed Modificati
c/sg(q) Quarter	Power Transmission Line	FBS Fire Brigade Station	
Crsc(o) Office Railway Property	Boundaries		CZMP Lines
RP Railway Property	Municipal Corporation Boundary	For Govt.office	
Public & Semi-Public	Village Boundary	Government Purpose	Intertidal
Auditorium/Drama Theatre	Gaothan Boundary	Night Shelter	Mangrove Buffer
swc Social Welfare Centre	CTS Area Boundary	Old Age Home	Mangroves
Old Age Home	Congested Boundary	Public Amenity	Mangroves
FS Fire Station PsimPch Police Station/Chowky	Cadastral Cadastre/CTS	Skill Development Center	
Heritage	Building Footprint		
Fort	Building Footprint	Police Commissioner Office	:e
<b>Notes</b> 1.The Base Map, ELU and Draft PL Government / Departments / Stal the discrepancies may occur.			

the discrepancies may occur. 2. Proposed Land-use Shall prevail irrespective of property number / boundary shown on map which shall be subject to confirmation from Land Record or competent Authority.

3. The structure on the map does not confirm authorization unless verified and rectified by Planning Authority. 4.SGNP, CRZ, Mangroves with their buffers shown on the plan shall be as per the relevant status. In case of any modifications to such status in future, such boundary and buffer shall automatically stand modified as per the latest notification. 5. The alignment of Metro, Coastal Elevated Road marked on plan are indicative & automatically stand modified by the notification issued by Government from time to time. 6.The alignment of nallah / river / creek is indicative and as per the feature extracted from Drone Imagery and data collected.

7. The boundaries of all the designated sites, Government property are shown as per the image captured by superimposition on cadastral map. This may be subject to change as per the actual acquisition in future. 8. This plan is to be read with UDCPR-2022 and Draft DP Report.

P.Existing road shall have status of the road according to width of road even though not shown in development plan. 10.R-R(Restricted-Residential) Residential Zone subject to handing over area to corporation as per permission/Government 11.R-R1 (Restricted- Residential1) All provision of Residential Zone in UDCPR-2020 will be applicable for this zone subject to

10% of area under Development should be kept for Amenity Space as per direction of Municipal Commissioner with prior permission from Eco-Sensitive Zone Commitee. 12.If the location of Metro Carshed and Metro Line is shifted by MMRDA or Elevated Road is shifted in future, the land


leased by such shifting shall stands included in adjoining Zone shown on Development Plan.

Scale				North N
0	0.05	0.1	0.2 km	WEE
		1:2,000		S
35160 3	रुर्यनिधरिष			·






Officer Appointed U/s 21(4A) Draft Revised Development Plan of Mira Bhayandar

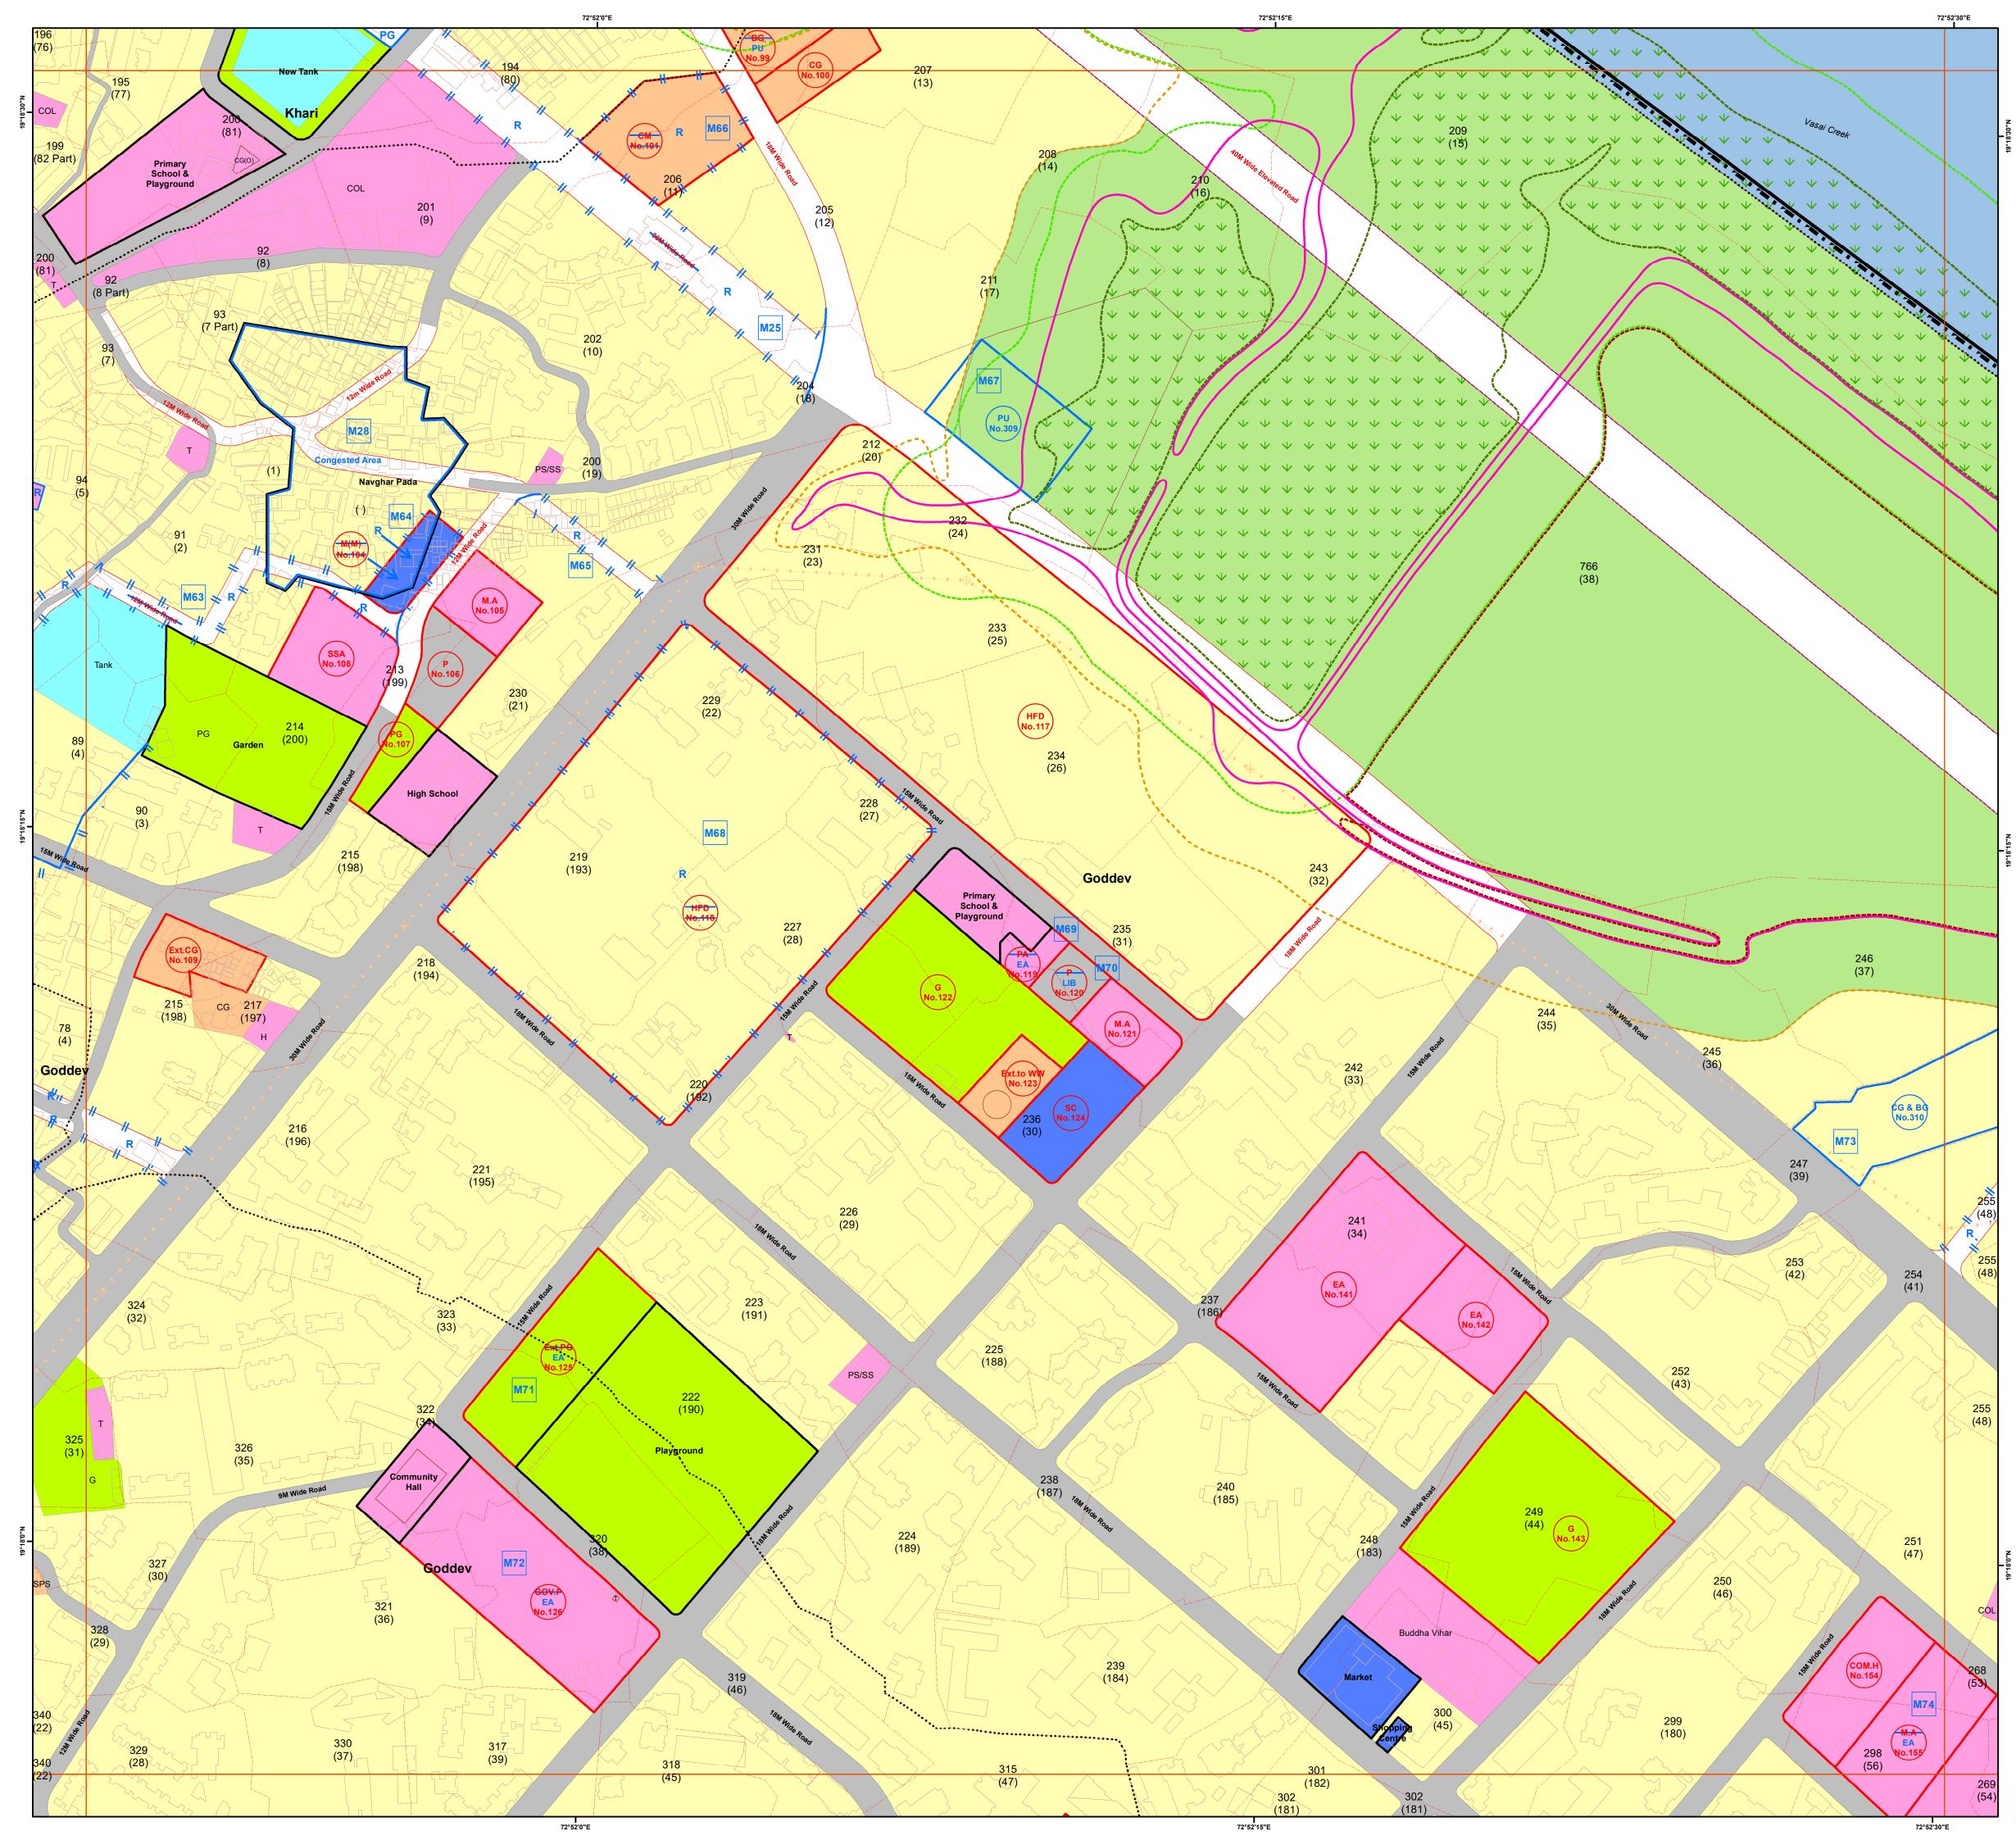



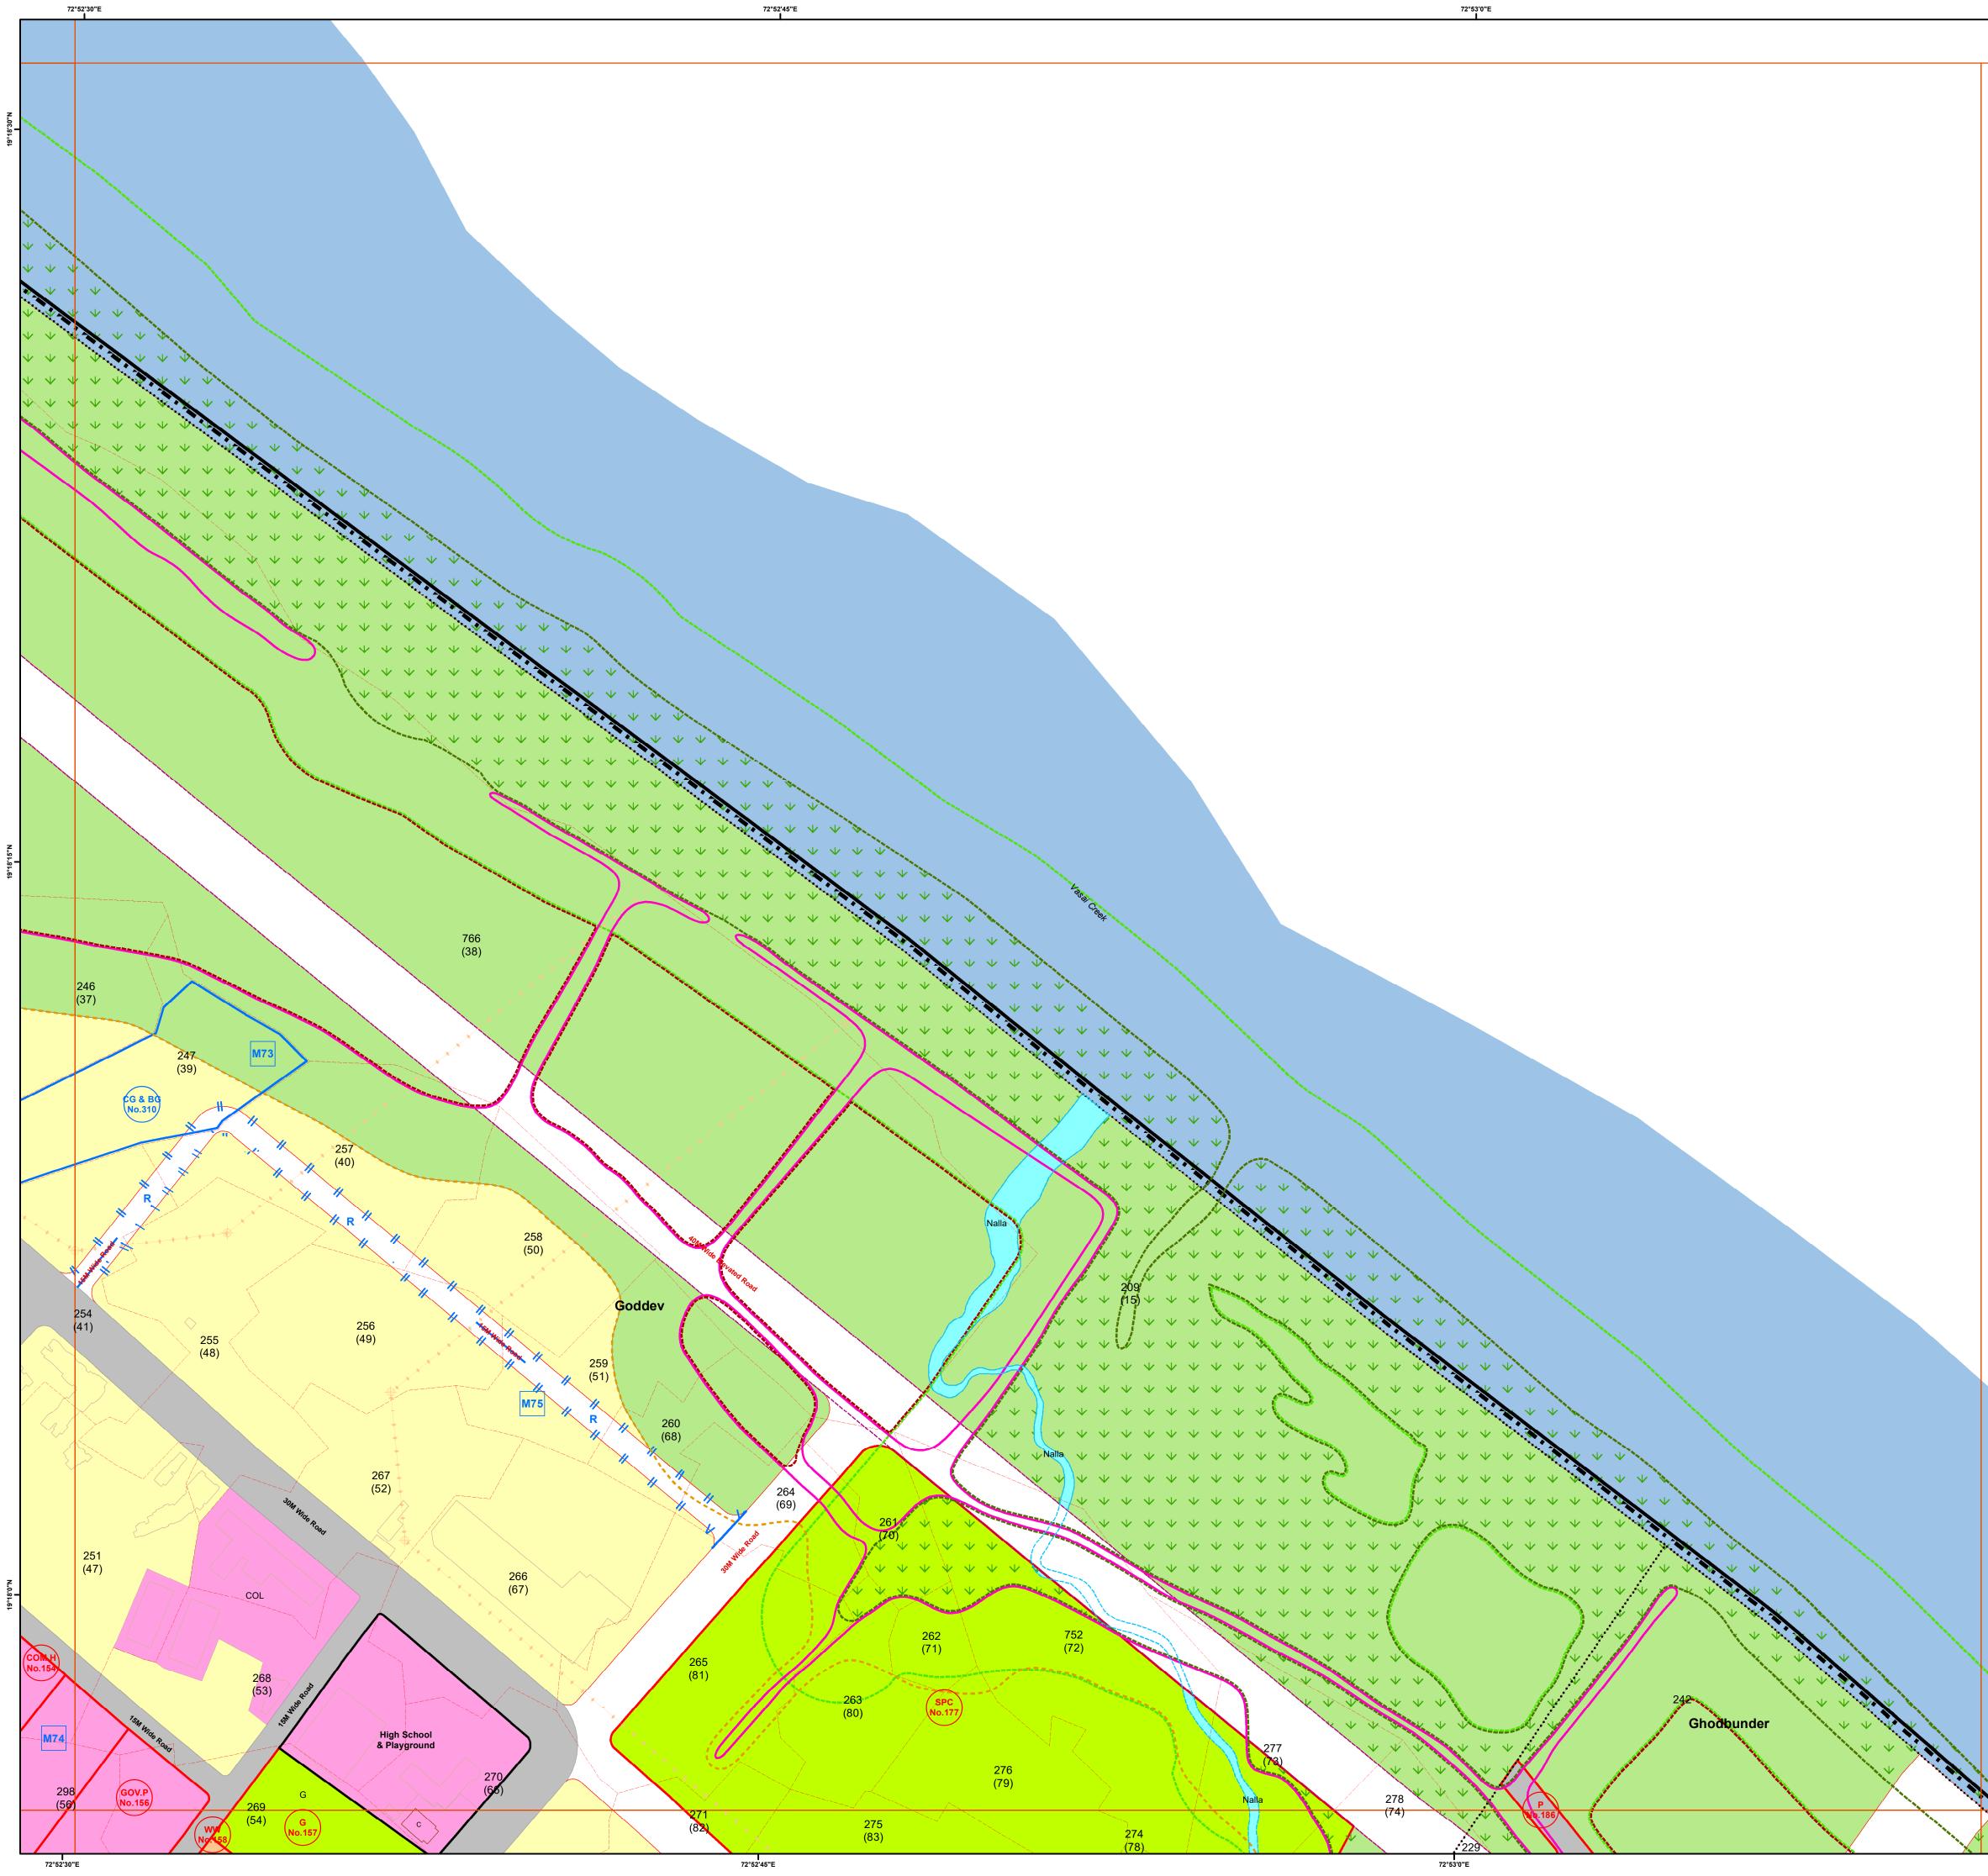







19°18'30"N |


19°18'0"N

Gheal under

72°53'15"E





### DRAFT REVISED DEVELOPMENT PLAN Mira Bhayandar Municipal Corporation (Published U/s.28(4) of M.R.&T.P. Act 1966)

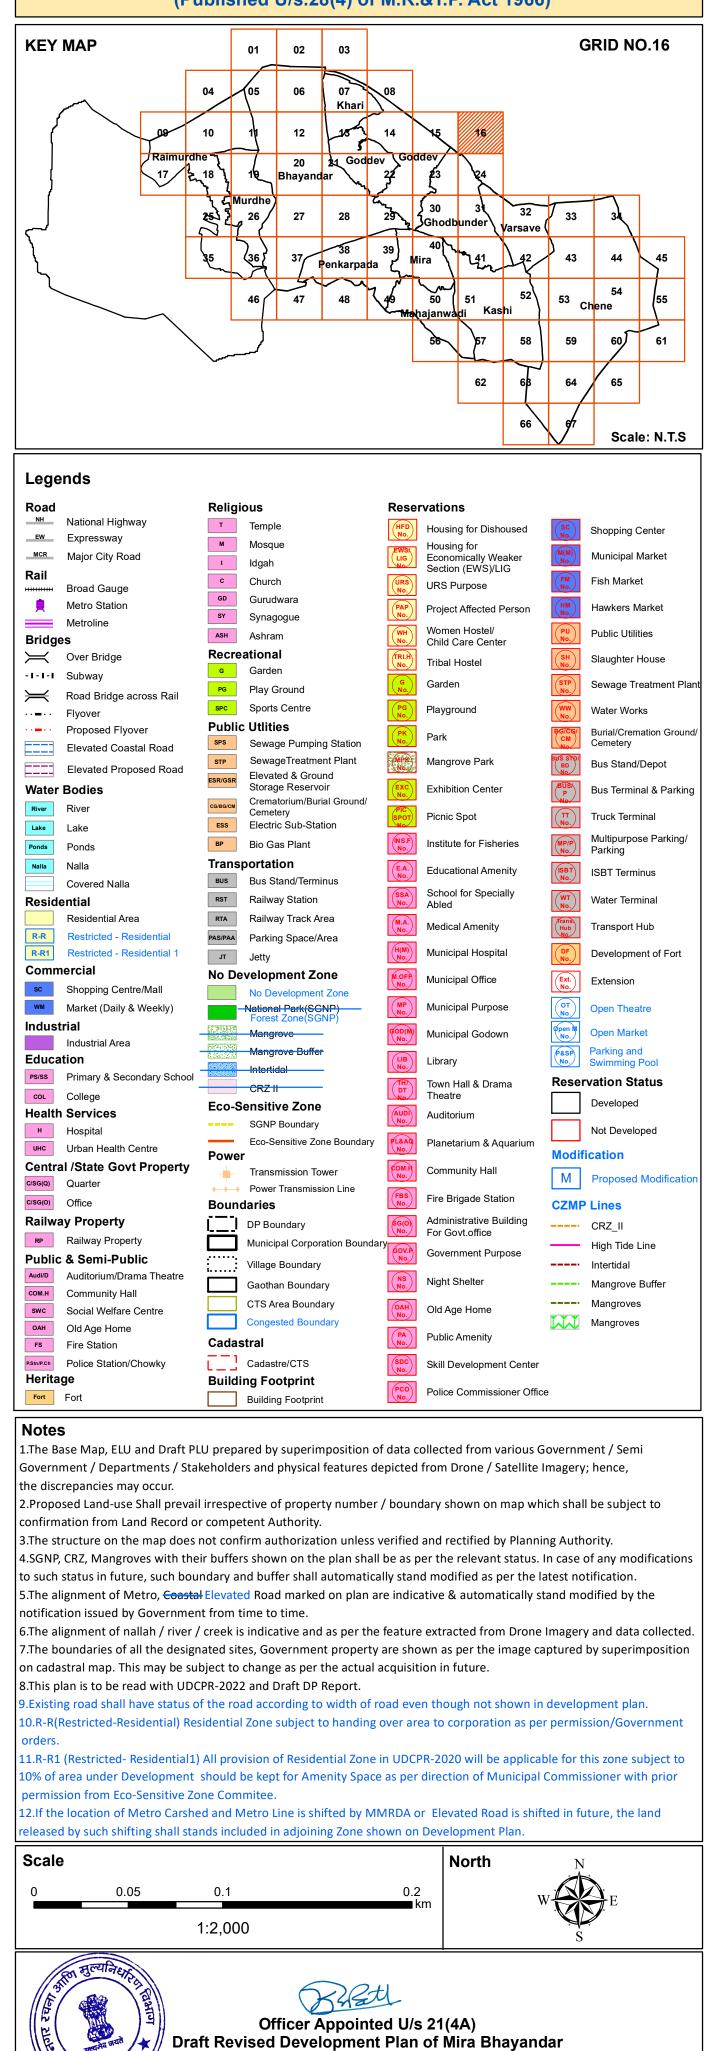

ھ Assistant Director of Town Planning, Thane

ठाणे 🕯

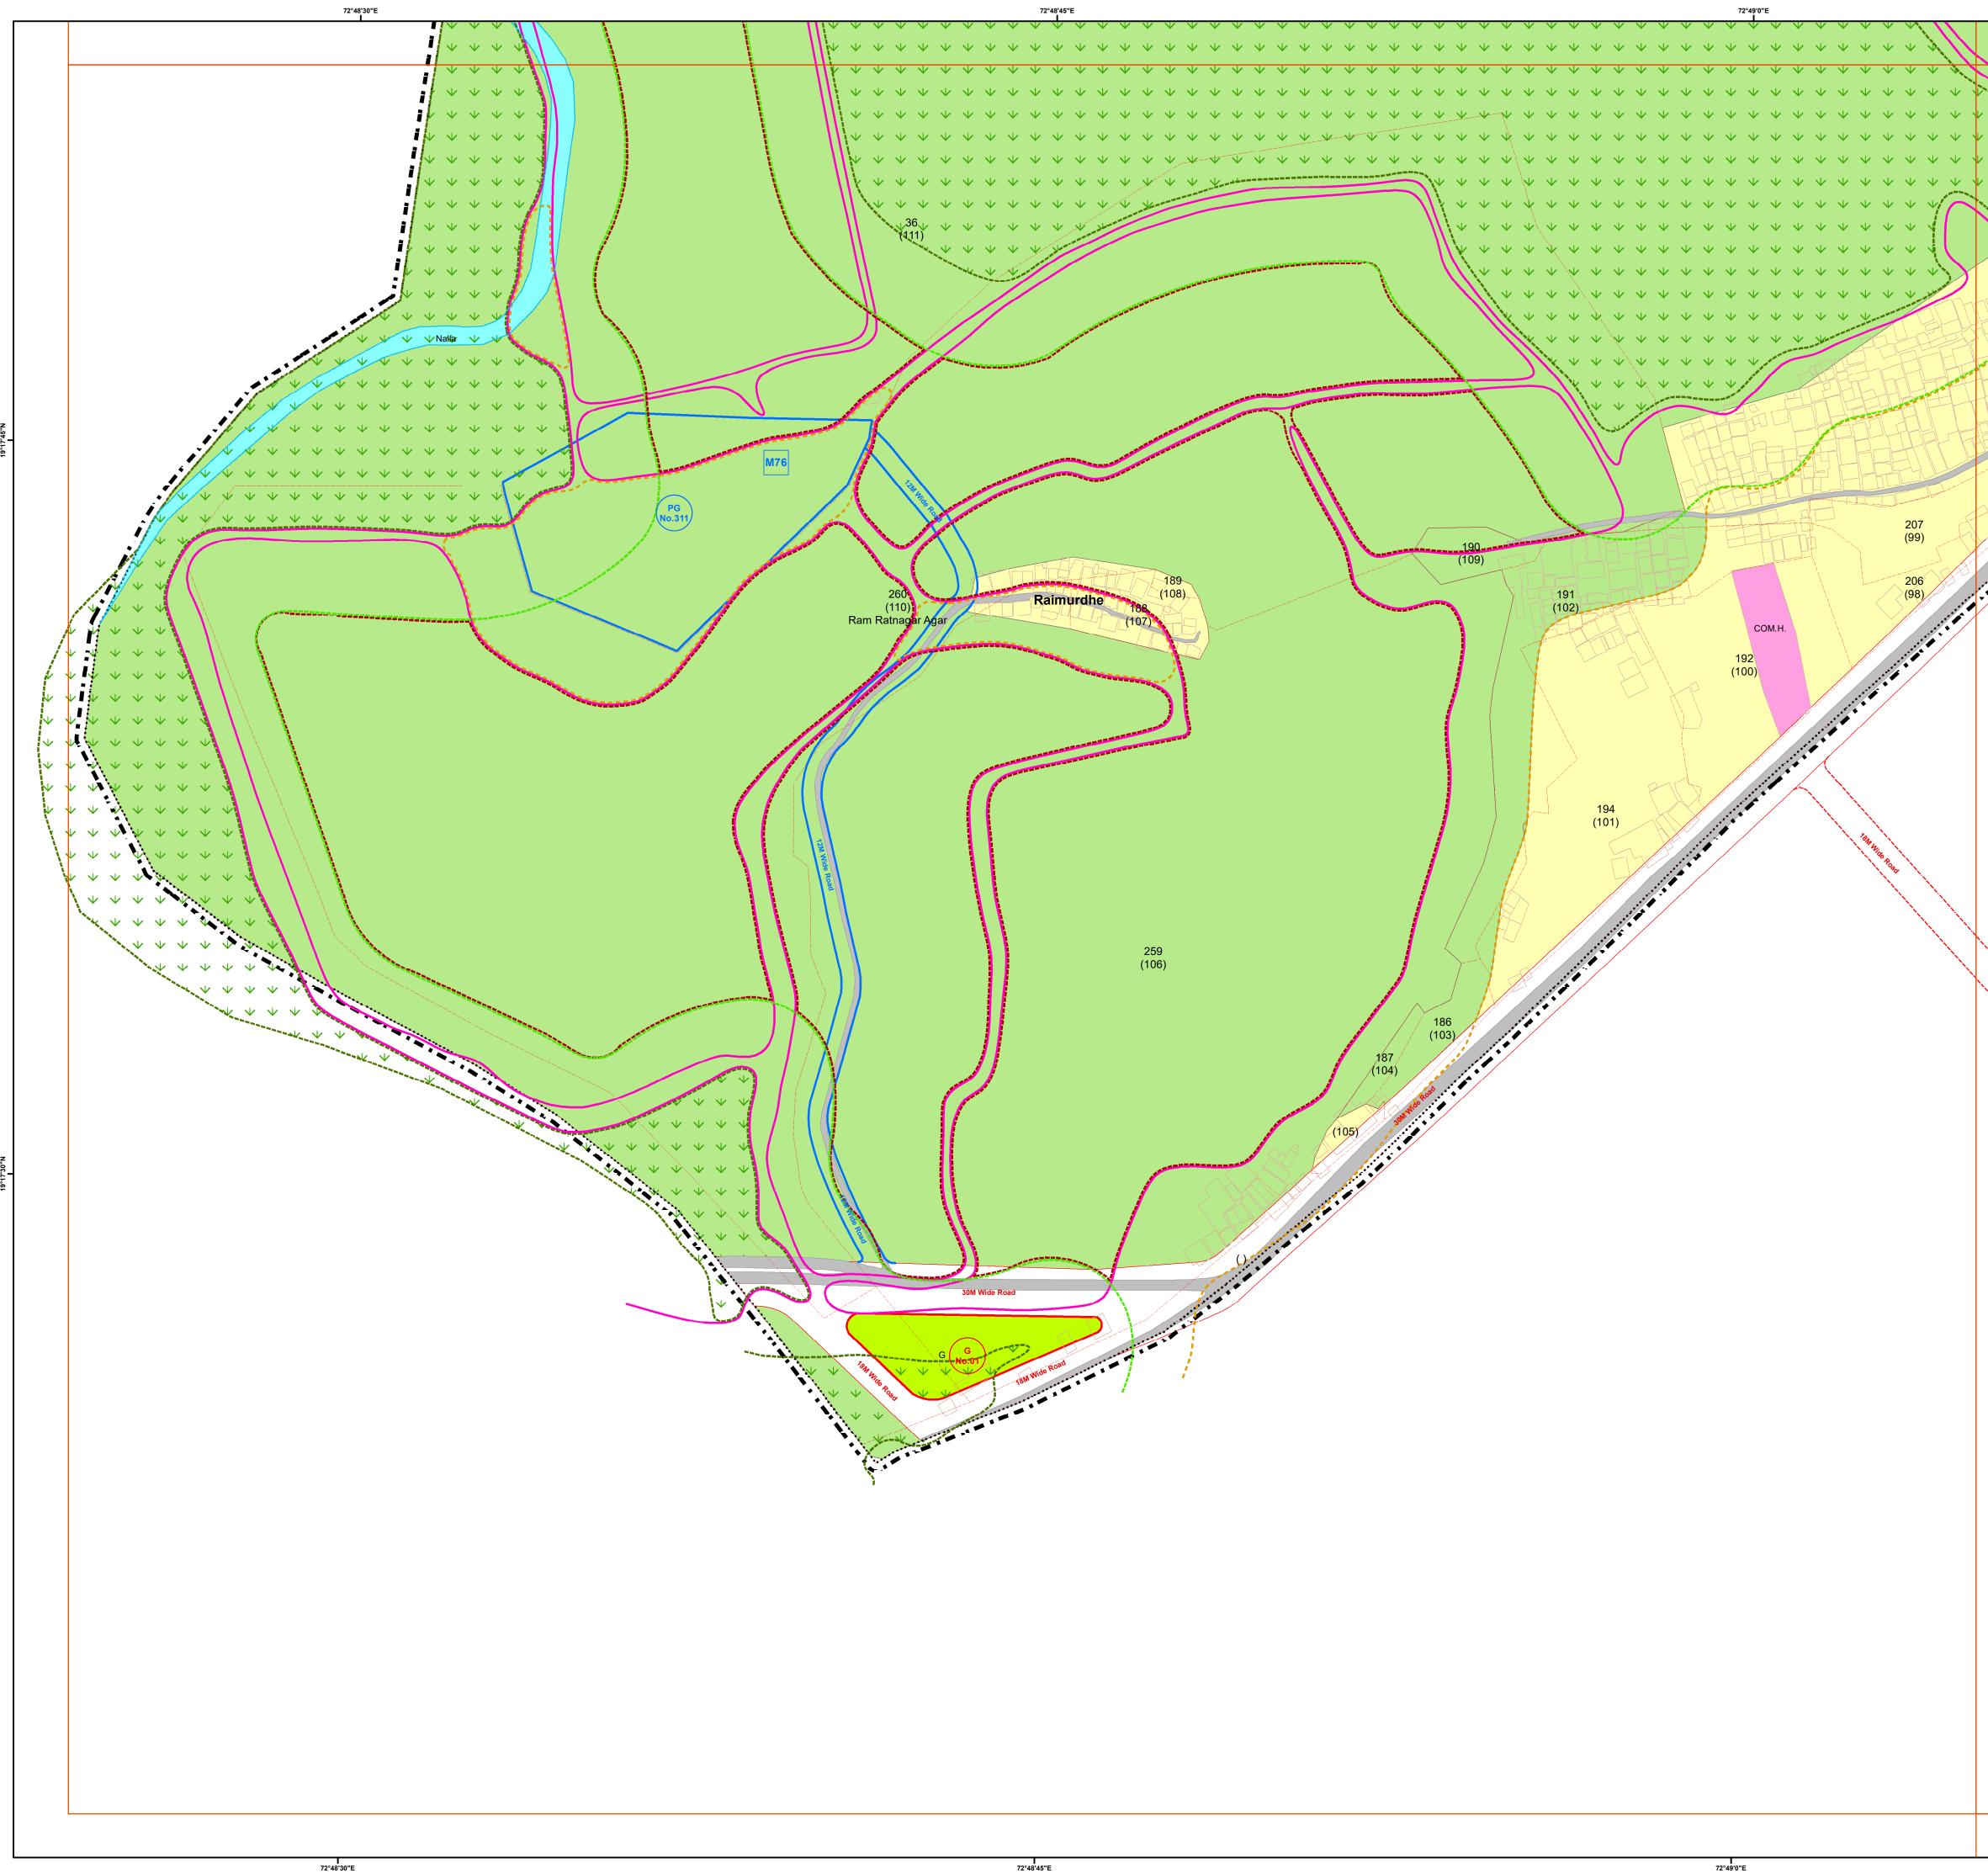

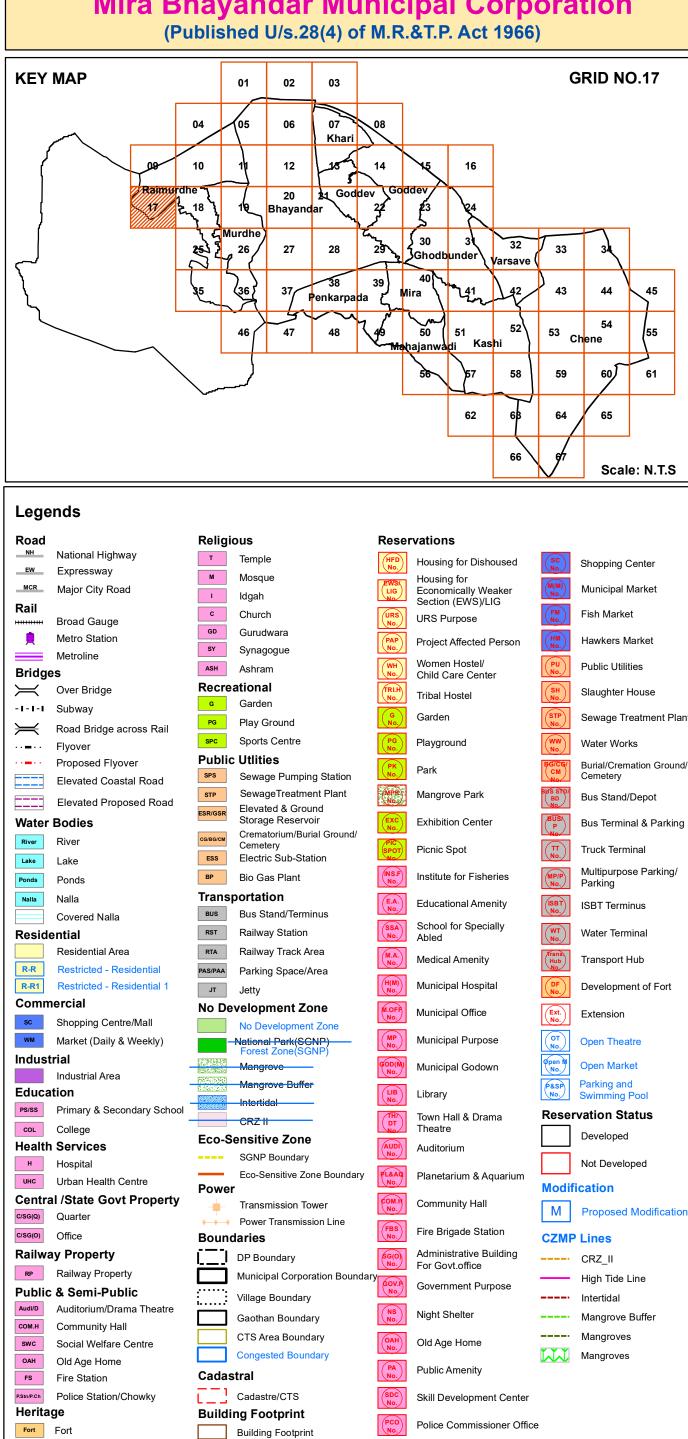

#### Notes

1. The Base Map, ELU and Draft PLU prepared by superimposition of data collected from various Government / Semi Government / Departments / Stakeholders and physical features depicted from Drone / Satellite Imagery; hence, the discrepancies may occur.

2. Proposed Land-use Shall prevail irrespective of property number / boundary shown on map which shall be subject to confirmation from Land Record or competent Authority.

3.The structure on the map does not confirm authorization unless verified and rectified by Planning Authority. 4.SGNP, CRZ, Mangroves with their buffers shown on the plan shall be as per the relevant status. In case of any modifications to such status in future, such boundary and buffer shall automatically stand modified as per the latest notification. 5. The alignment of Metro, <del>Coastal</del> Elevated Road marked on plan are indicative & automatically stand modified by the notification issued by Government from time to time. 6.The alignment of nallah / river / creek is indicative and as per the feature extracted from Drone Imagery and data collected.

7. The boundaries of all the designated sites, Government property are shown as per the image captured by superimposition on cadastral map. This may be subject to change as per the actual acquisition in future. 8.This plan is to be read with UDCPR-2022 and Draft DP Report.


9. Existing road shall have status of the road according to width of road even though not shown in development plan. 10.R-R(Restricted-Residential) Residential Zone subject to handing over area to corporation as per permission/Government orders. 11.R-R1 (Restricted- Residential1) All provision of Residential Zone in UDCPR-2020 will be applicable for this zone subject to

10% of area under Development should be kept for Amenity Space as per direction of Municipal Commissioner with prior permission from Eco-Sensitive Zone Commitee.

12.If the location of Metro Carshed and Metro Line is shifted by MMRDA or Elevated Road is shifted in future, the land leased by such shifting shall stands included in adjoining Zone shown on Development Plan.

Scale				North N
0	0.05	0.1 0.2		WEE
		1:2,000		S

Officer Appointed U/s 21(4A) Draft Revised Development Plan of Mira Bhayandar

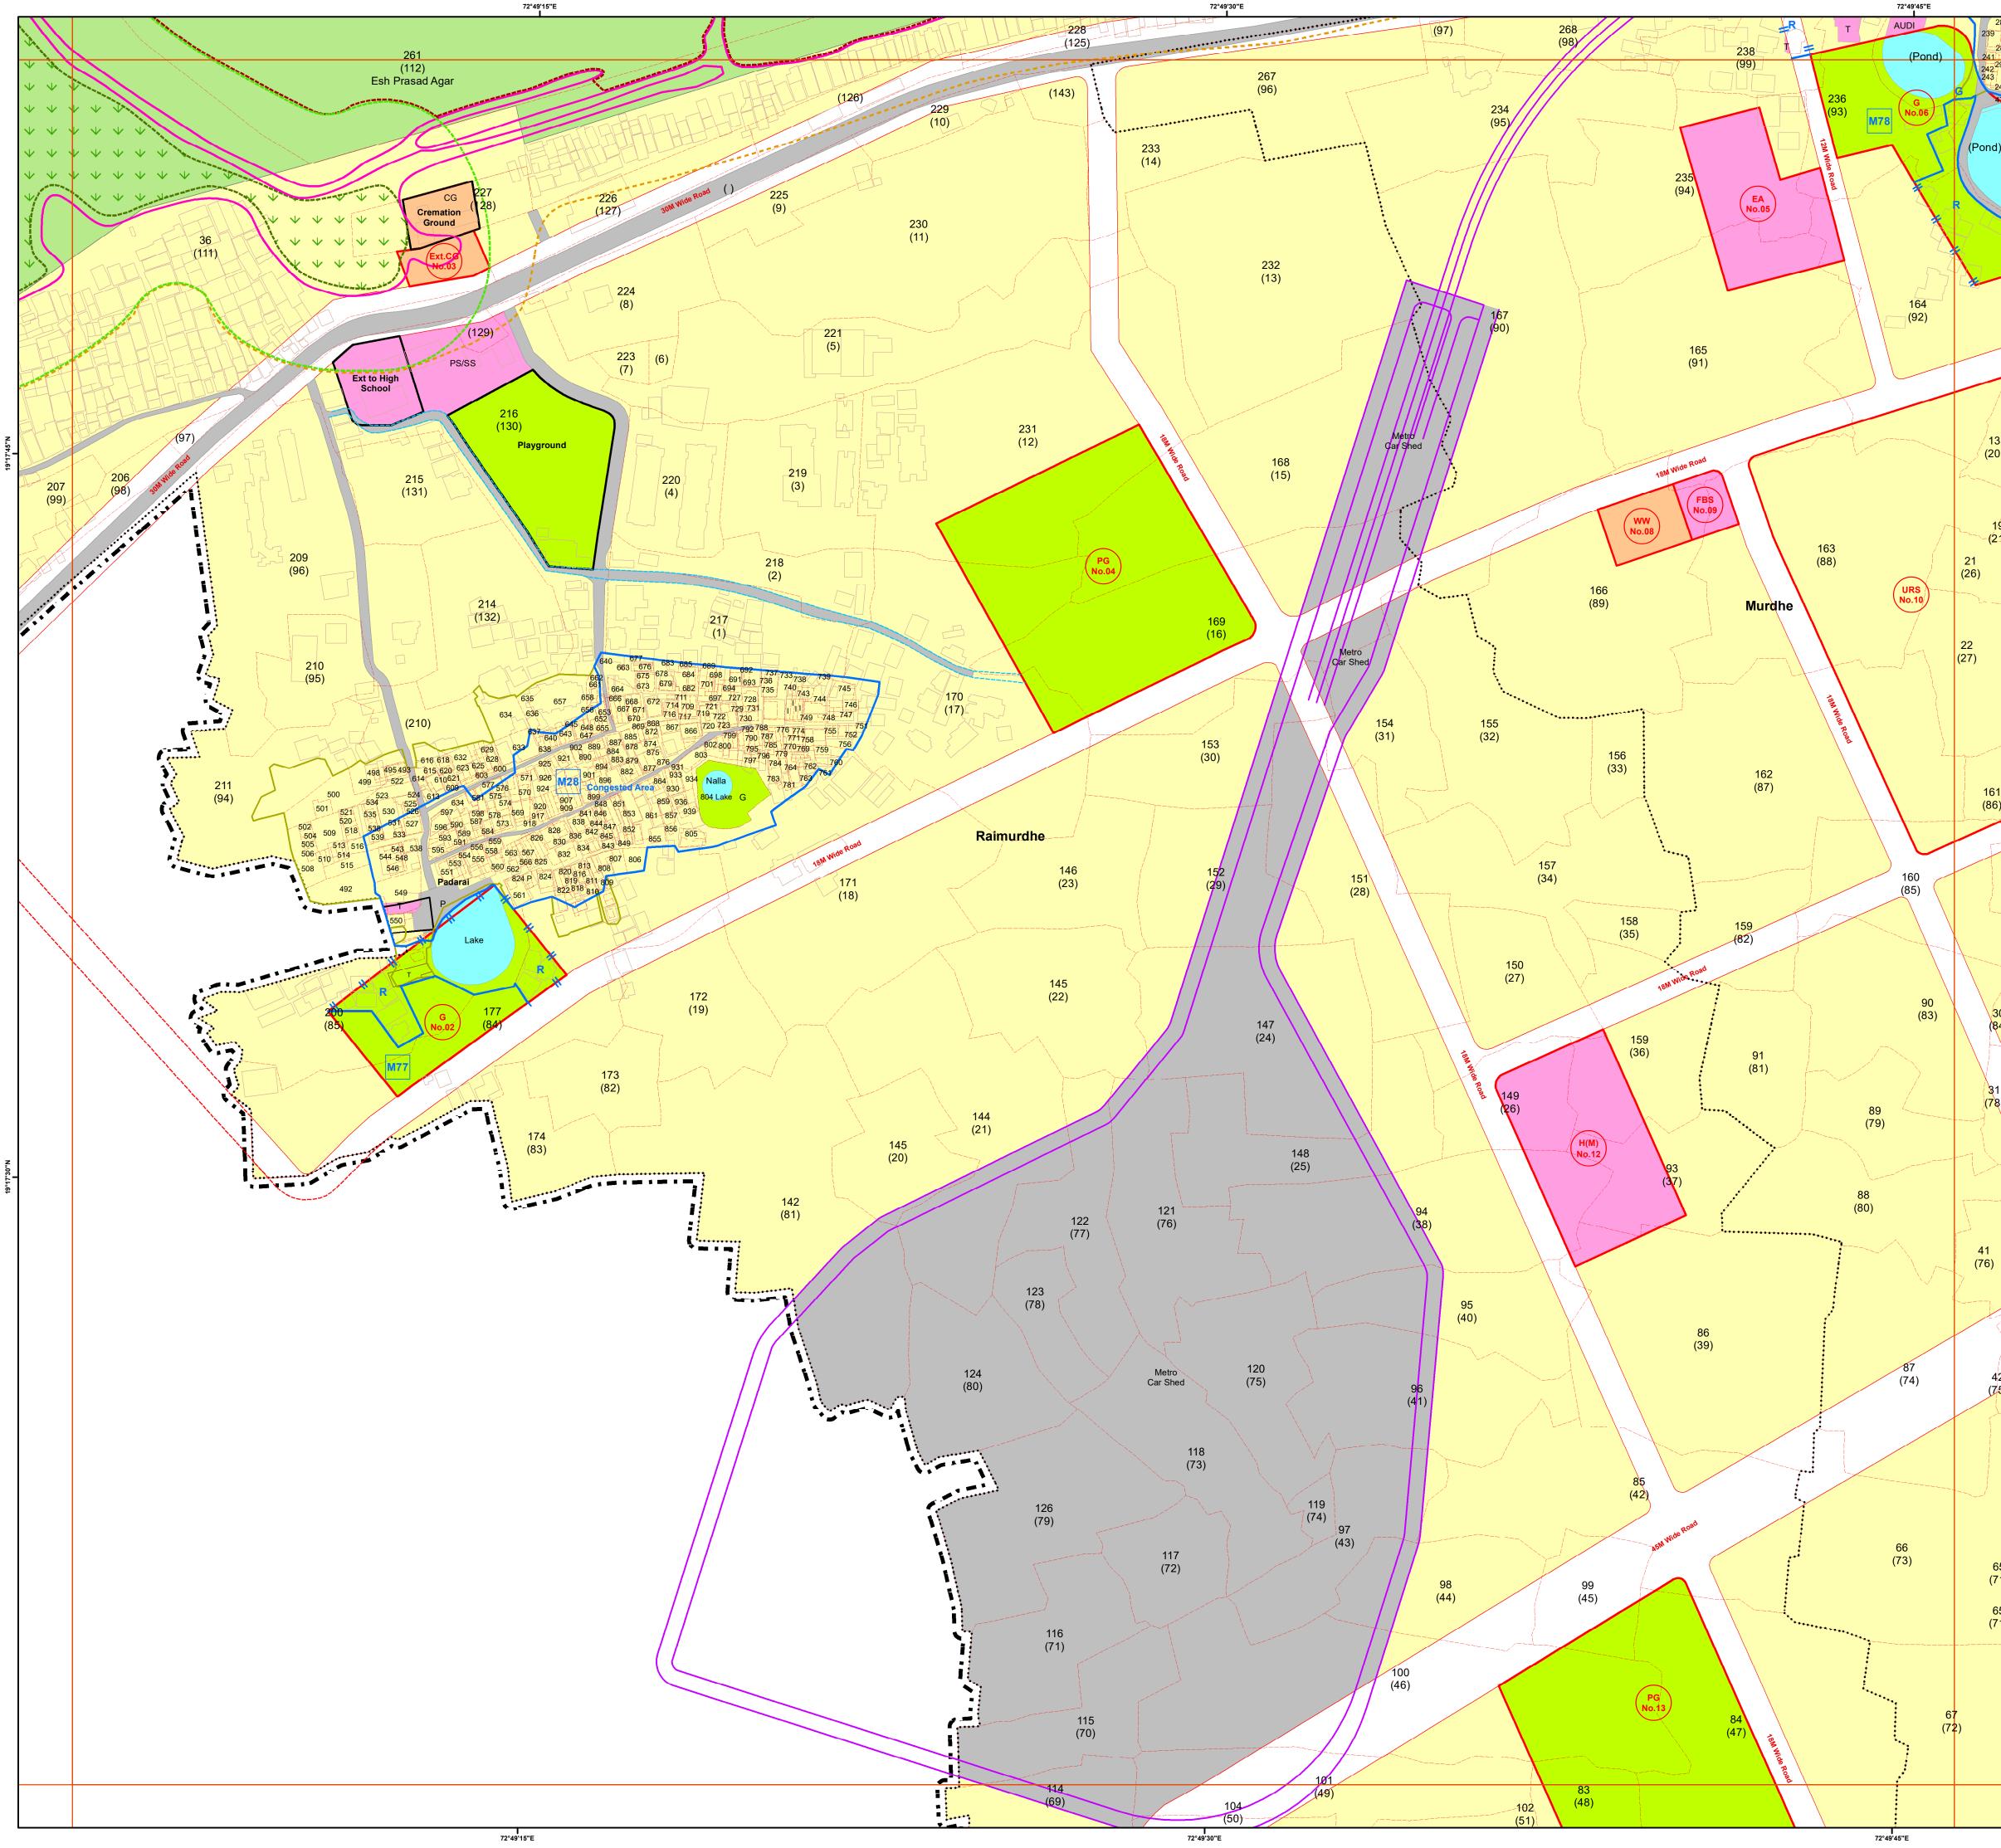

(20)

161

(86)

(84

(78)


42


6!


(71

(71

ठाणे भ

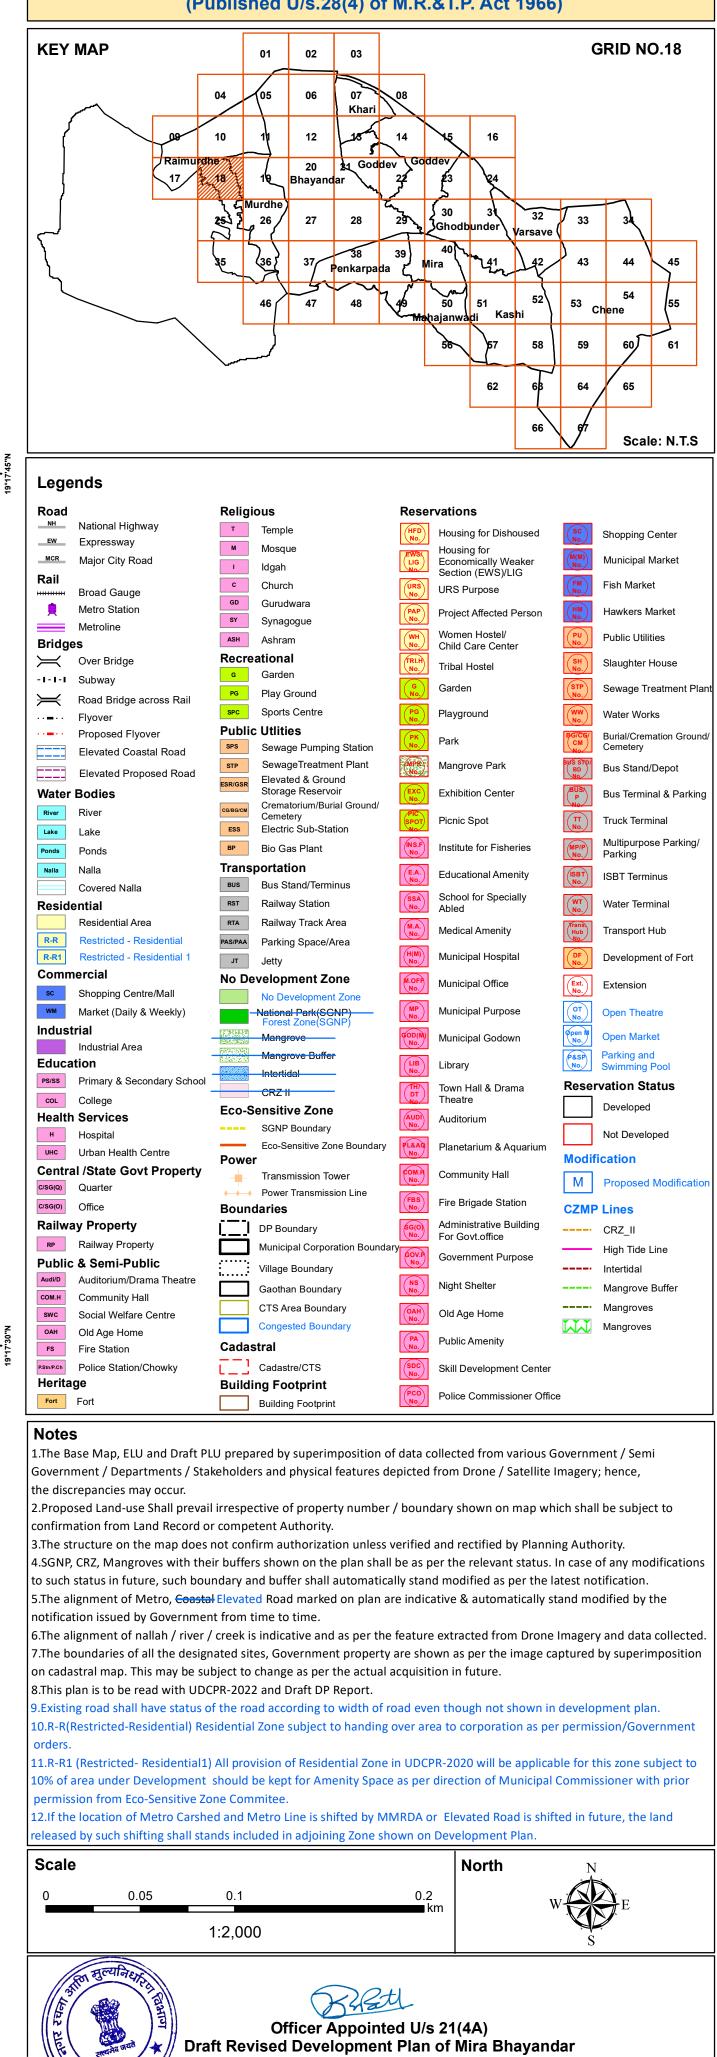

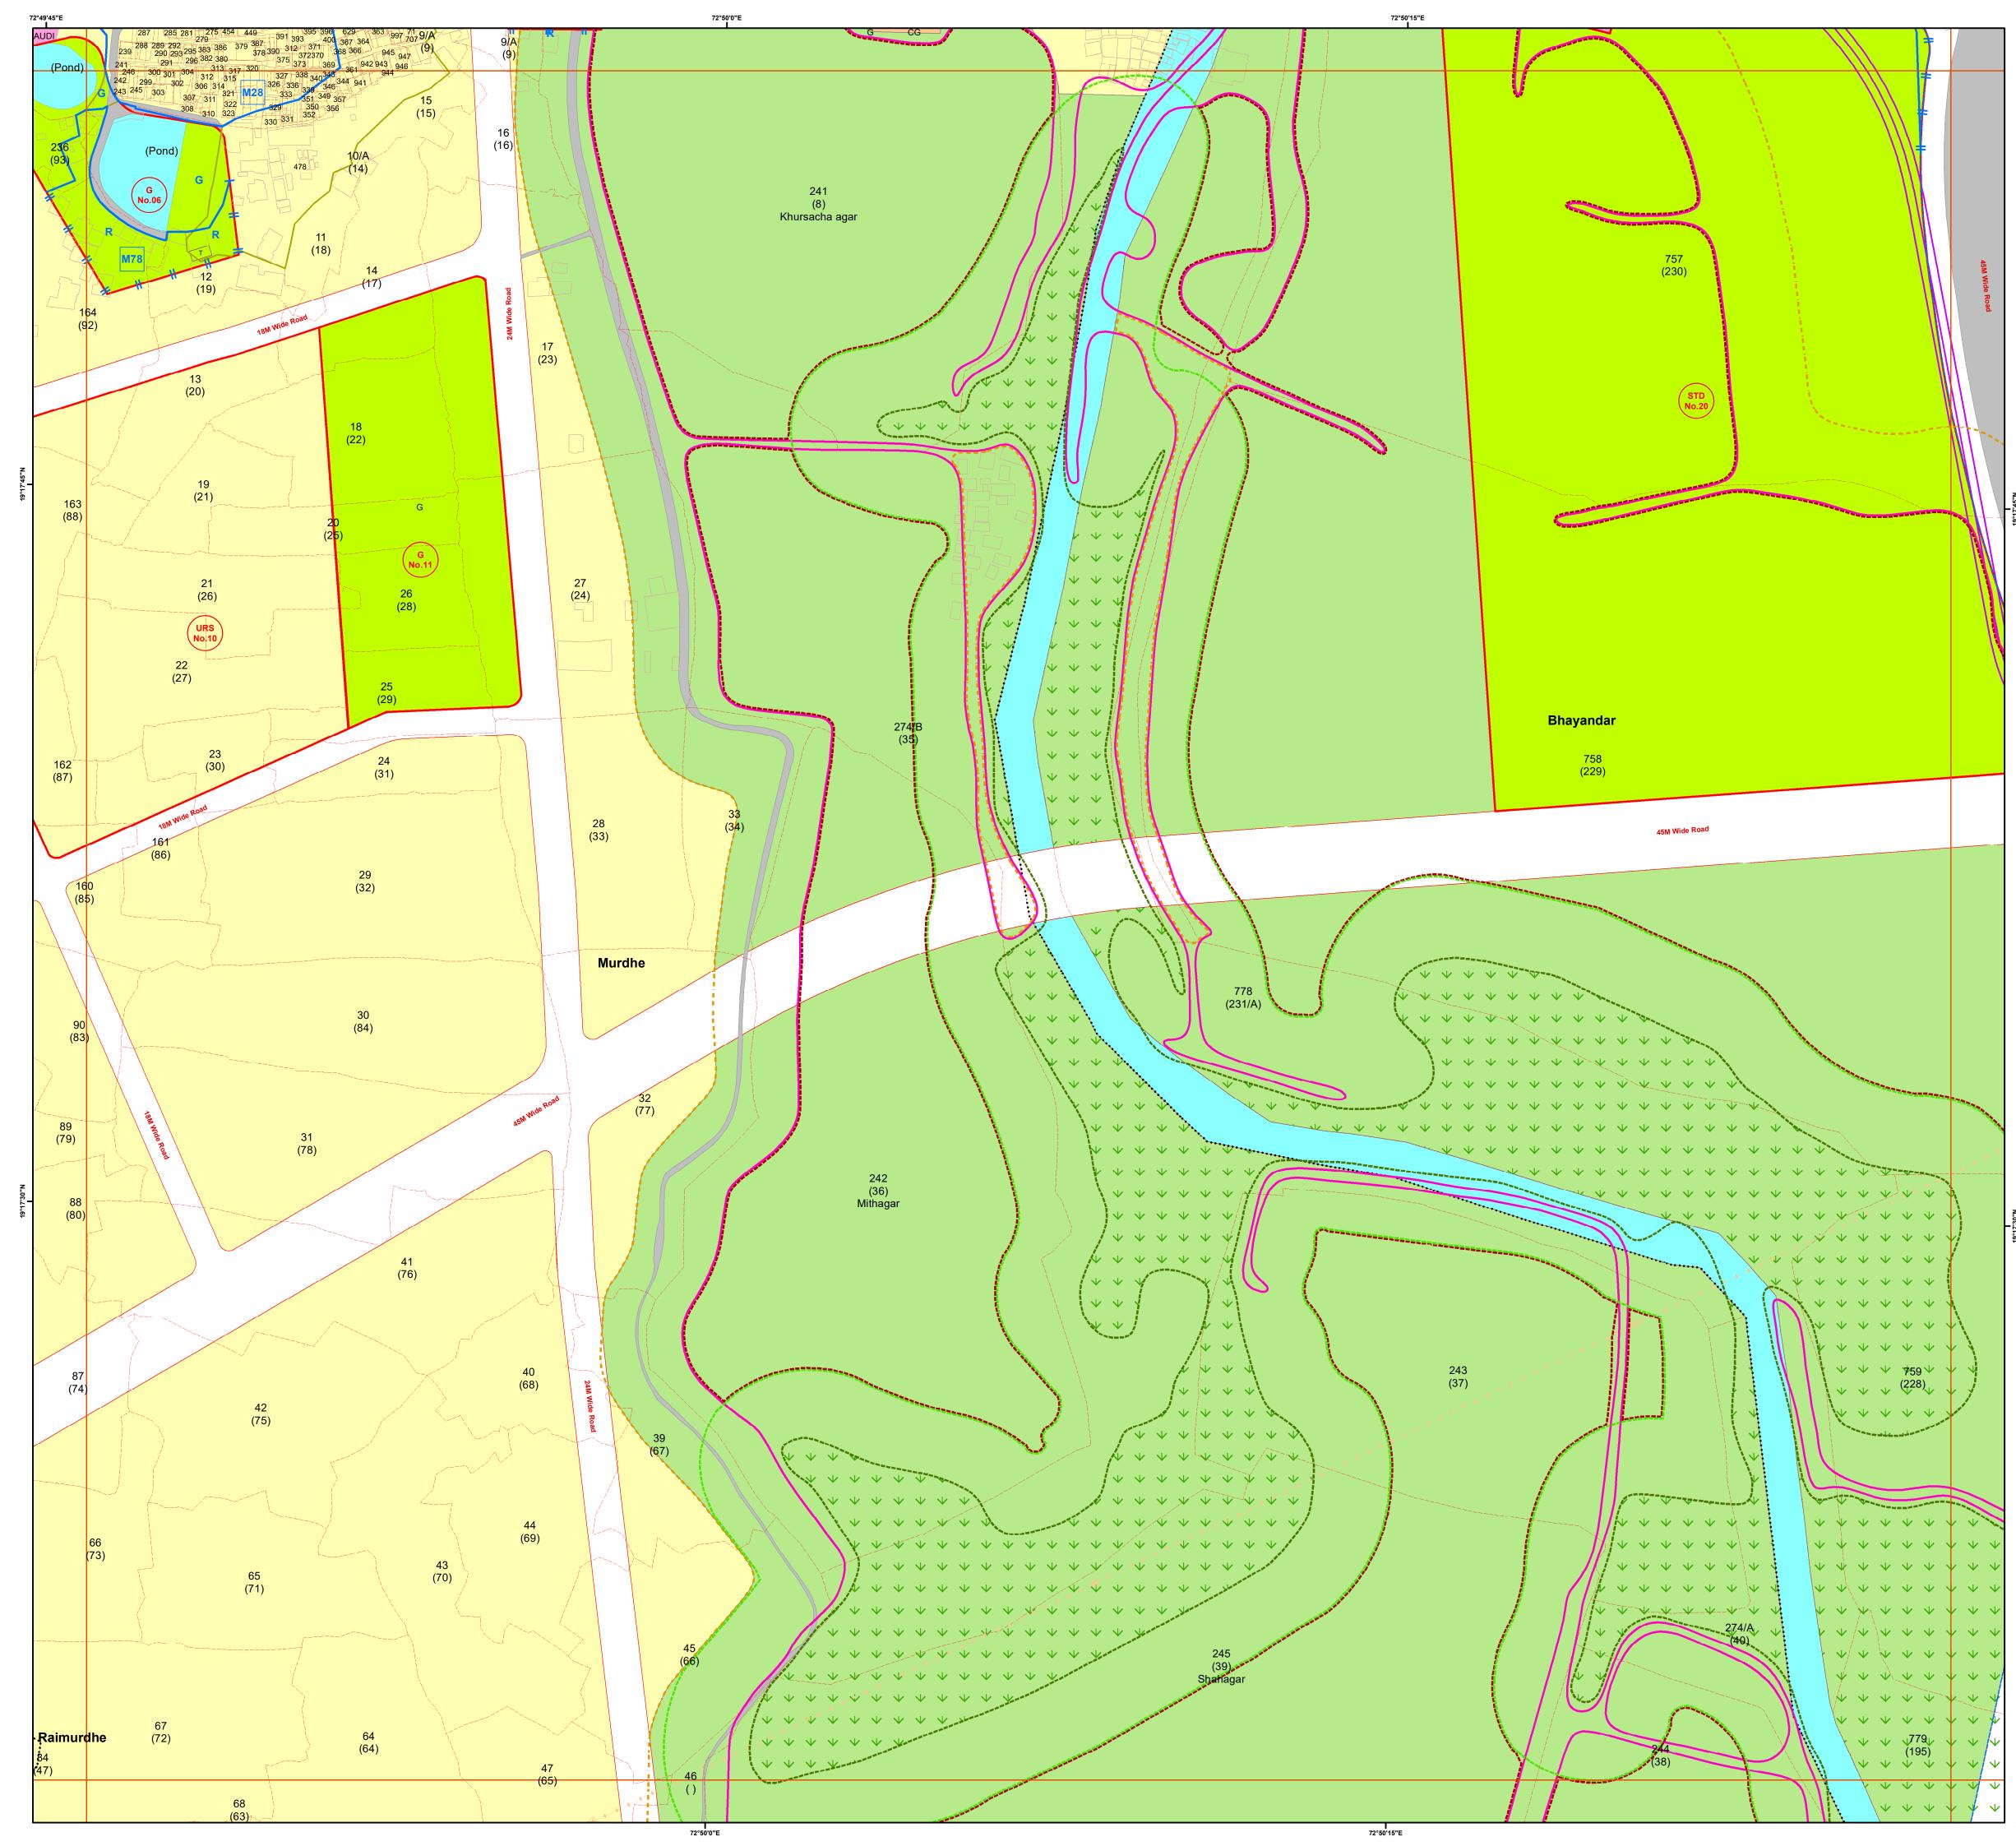

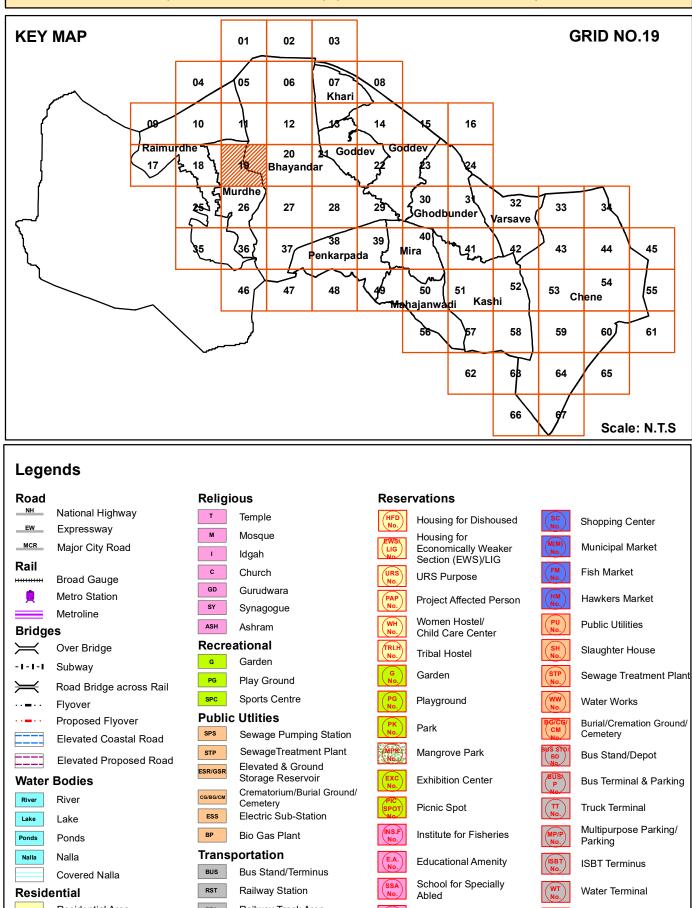

	Elevaled Coastal Road		0 1 0	In the second second			-
	Elevated Proposed Road	STP	SewageTreatment Plant	MPR No	Mangrove Park	BUS STD/ BD No	Bus Stand/Depot
Water	Bodies	ESR/GSR	Elevated & Ground Storage Reservoir	EXC No.	Exhibition Center	(BUS) P	Bus Terminal & Parki
River	River	CG/BG/CM	Crematorium/Burial Ground/ Cemetery	(SPOT)	Picnic Spot	TT No.	Truck Terminal
Lake	Lake	ESS	Electric Sub-Station	No.			Multipurpose Parking
Ponds	Ponds	BP	Bio Gas Plant	INS.F No.	Institute for Fisheries	MP/P No.	Parking
Nalla	Nalla		portation	E.A. No.	Educational Amenity		ISBT Terminus
	Covered Nalla	BUS	Bus Stand/Terminus	SSA	School for Specially		
Resid	ential	RST	Railway Station	No.	Abled	WT No.	Water Terminal
	Residential Area	RTA	Railway Track Area	M.A. No.	Medical Amenity	Trans. Hub No	Transport Hub
R-R	Restricted - Residential	PAS/PAA	Parking Space/Area				·
R-R1	Restricted - Residential 1	JT	Jetty	(H(M) No.	Municipal Hospital	DF No.	Development of Fort
Comm	nercial	No De	velopment Zone	M.OFF No.	Municipal Office	Ext. No.	Extension
SC	Shopping Centre/Mall		No Development Zone				
WM	Market (Daily & Weekly)		National Park(SGNP) Forest Zone(SGNP)	MP No.	Municipal Purpose		Open Theatre
Indust	rial		Mangrove	COD(M) No.	Municipal Godown	Øpen M No.	Open Market
	Industrial Area		Mangrove Buffer			P&SP	Parking and
Educa	· · ·	A CONTRACTOR	-Intertidal		Library	No.	Swimming Pool
PS/SS	Primary & Secondary School		CRZ II		Town Hall & Drama	Reser	vation Status
COL	College	Eco-S	ensitive Zone		Theatre		Developed
Health	I Services	200 0	SGNP Boundary		Auditorium		
н	Hospital		Eco-Sensitive Zone Boundary	PL&AQ	Planetarium & Aquarium		Not Developed
UHC	Urban Health Centre	Power	-	PL&AQ No.		Modif	ication
	al /State Govt Property	-	Transmission Tower	COM.H No.	Community Hall	Μ	Proposed Modificat
C/SG(Q)	Quarter	• • • • •	Power Transmission Line		Fire Drive de Otation		T Toposed Modificat
C/SG(O)	Office	Bound	laries	(FBS No.	Fire Brigade Station	CZMP	Lines
Railwa	ay Property	$(\Box)$	DP Boundary	SG(O) No.	Administrative Building For Govt.office		CRZ_II
RP	Railway Property		Municipal Corporation Boundar		Government Purpose		High Tide Line
Public	& Semi-Public		Village Boundary	No.	Government Fulpose		Intertidal
Audi/D	Auditorium/Drama Theatre		Gaothan Boundary	NS No.	Night Shelter		Mangrove Buffer
СОМ.Н	Community Hall		CTS Area Boundary				Mangroves
SWC	Social Welfare Centre		Congested Boundary	OAH No.	Old Age Home		Mangroves
OAH	Old Age Home			PA No.	Public Amenity		Marigroves
FS	Fire Station	Cadas					
P.Stn/P.Ch	Police Station/Chowky		Cadastre/CTS	SDC No.	Skill Development Center		
Herita	•	Buildi	ng Footprint	PCO	Police Commissioner Offic	e	
Fort	Fort		Building Footprint	No.			

#### Notes

1. The Base Map, ELU and Draft PLU prepared by superimposition of data collected from various Government / Semi Government / Departments / Stakeholders and physical features depicted from Drone / Satellite Imagery; hence, the discrepancies may occur.

2. Proposed Land-use Shall prevail irrespective of property number / boundary shown on map which shall be subject to confirmation from Land Record or competent Authority.

3. The structure on the map does not confirm authorization unless verified and rectified by Planning Authority. 4.SGNP, CRZ, Mangroves with their buffers shown on the plan shall be as per the relevant status. In case of any modifications to such status in future, such boundary and buffer shall automatically stand modified as per the latest notification. 5. The alignment of Metro, Coastal Elevated Road marked on plan are indicative & automatically stand modified by the notification issued by Government from time to time.

6.The alignment of nallah / river / creek is indicative and as per the feature extracted from Drone Imagery and data collected. 7.The boundaries of all the designated sites, Government property are shown as per the image captured by superimposition on cadastral map. This may be subject to change as per the actual acquisition in future. 8.This plan is to be read with UDCPR-2022 and Draft DP Report.

9.Existing road shall have status of the road according to width of road even though not shown in development plan. 10.R-R(Restricted-Residential) Residential Zone subject to handing over area to corporation as per permission/Government orders.

11.R-R1 (Restricted- Residential1) All provision of Residential Zone in UDCPR-2020 will be applicable for this zone subject to 10% of area under Development should be kept for Amenity Space as per direction of Municipal Commissioner with prior permission from Eco-Sensitive Zone Commitee.


12.If the location of Metro Carshed and Metro Line is shifted by MMRDA or Elevated Road is shifted in future, the land eased by such shifting shall stands included in adjoining Zone shown on Development Plan.

Scale				North	N	
0	0.05	0.1	0.2 kr	m	WEE	
		1:2,000			S	
37107 3	नुल्यनिधर्म					






Officer Appointed U/s 21(4A) ★ Draft Revised Development Plan of Mira Bhayandar

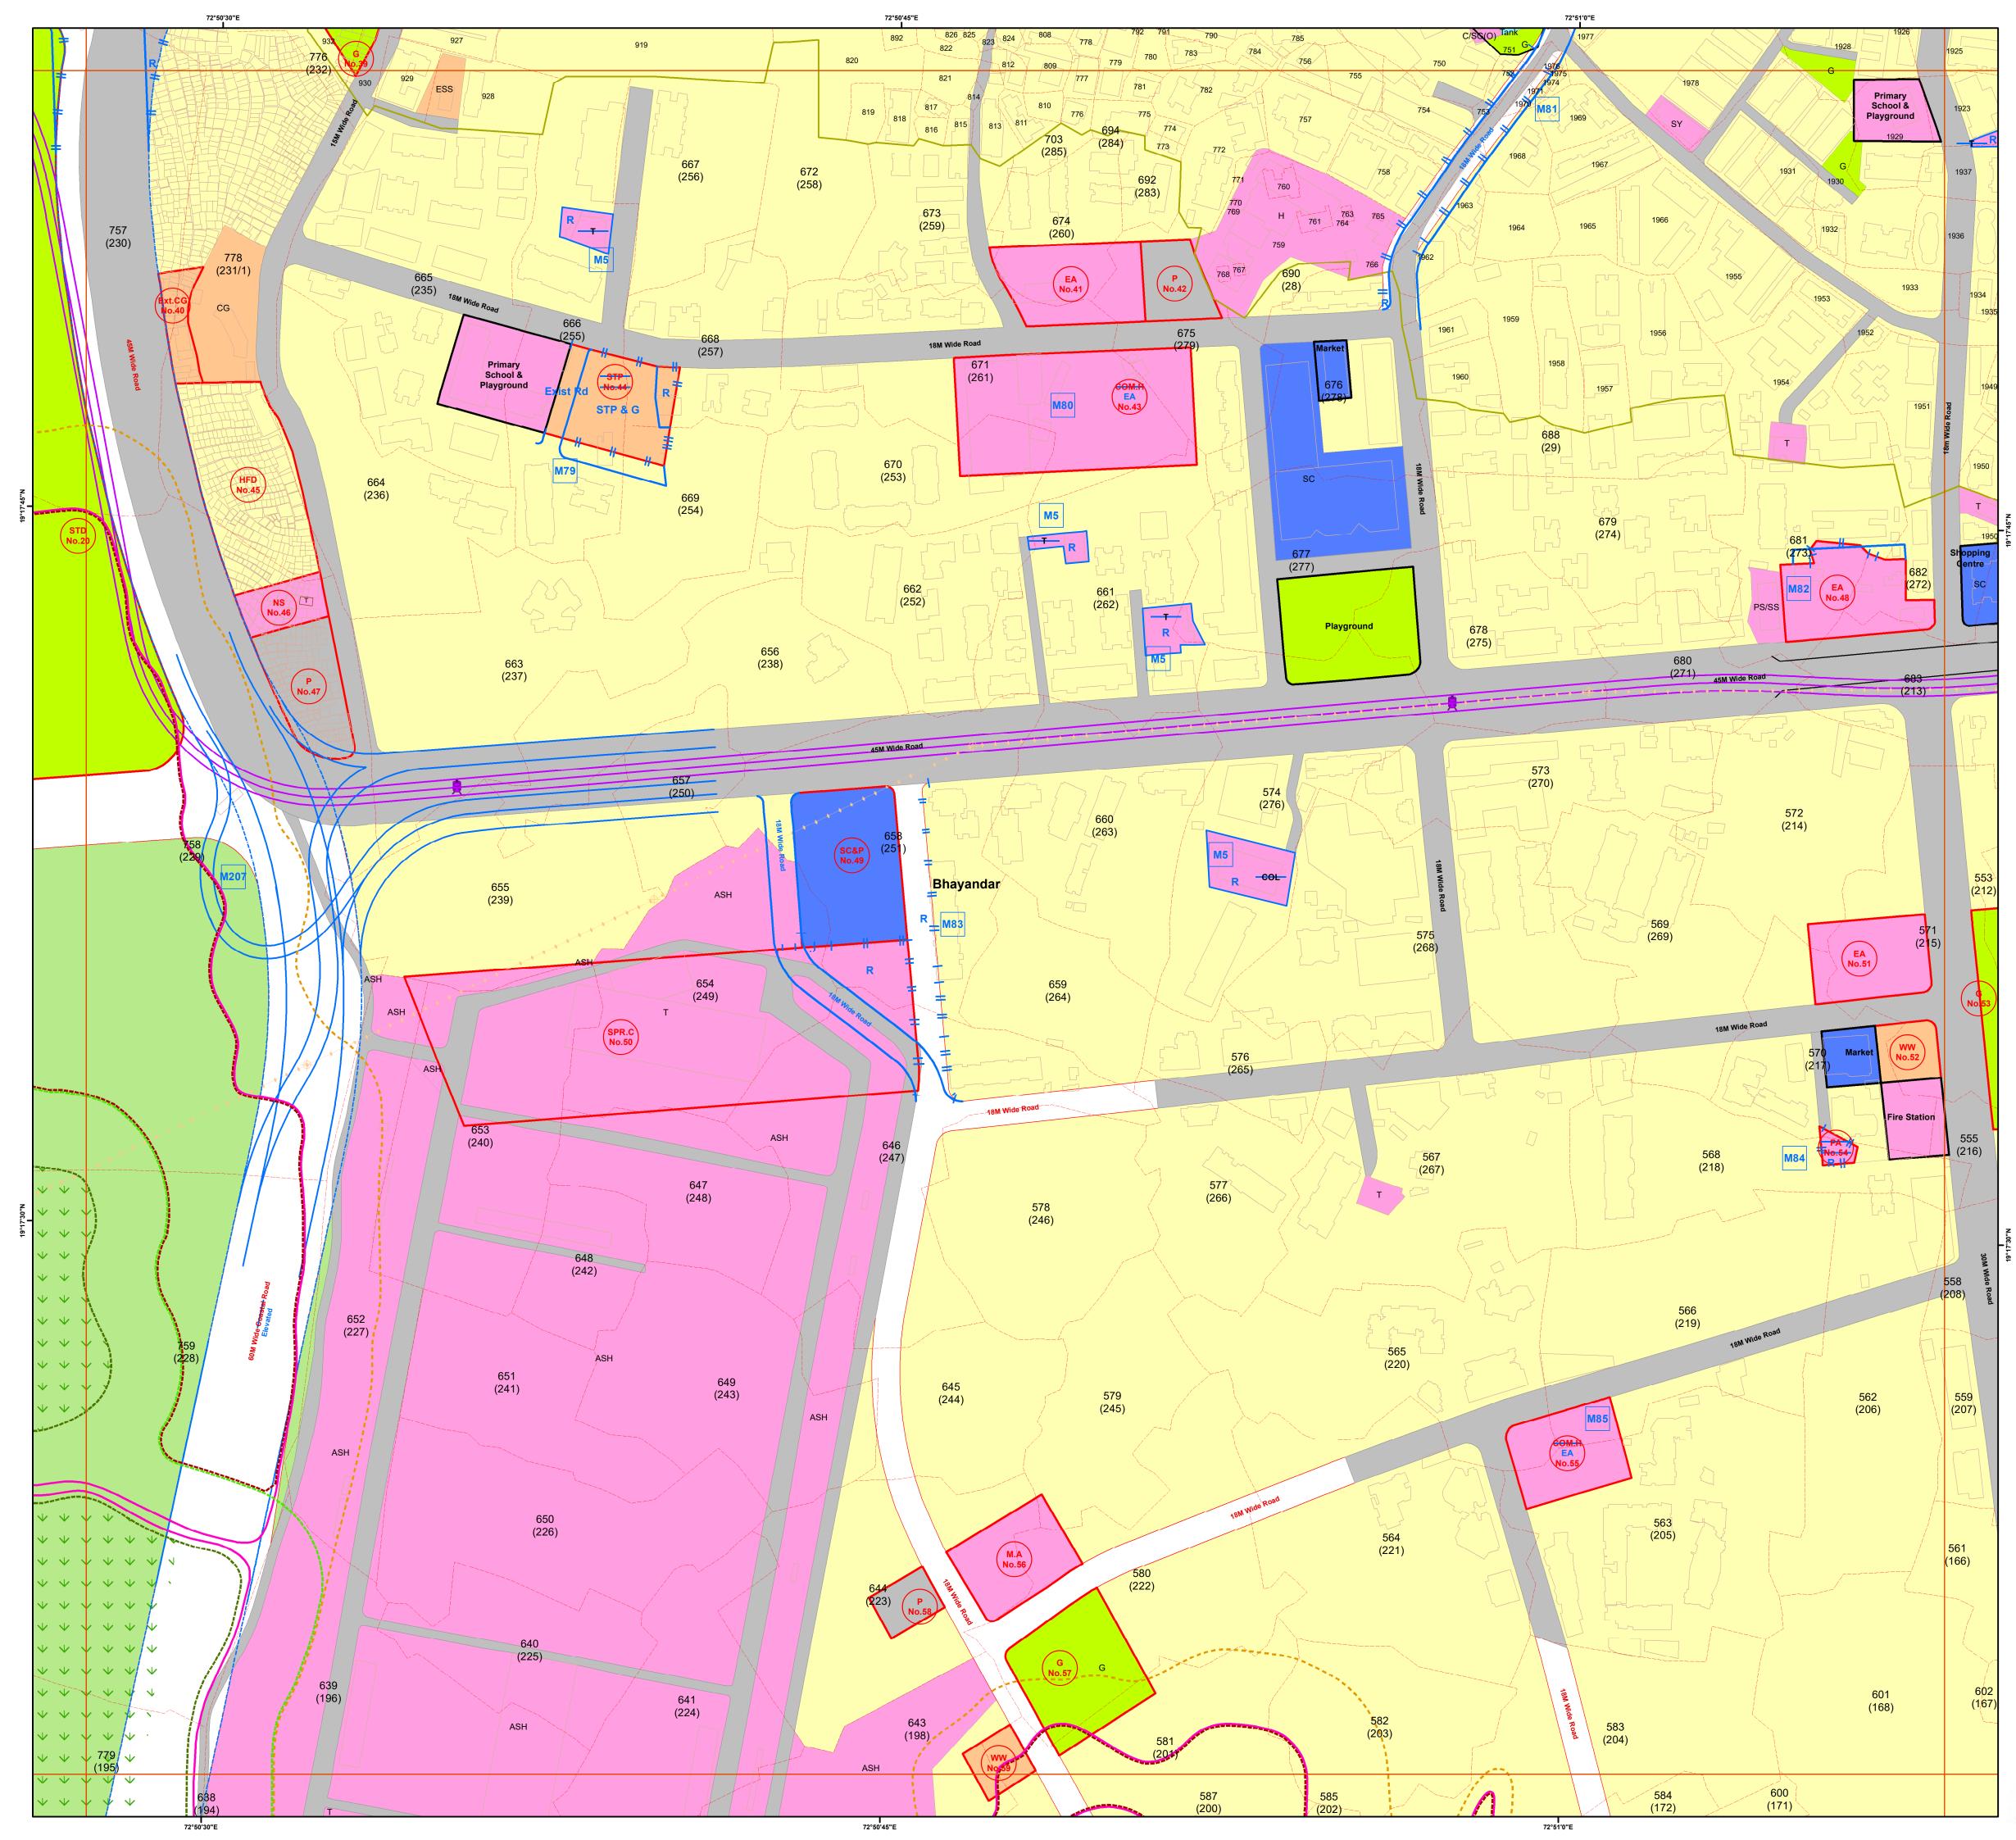



& Assistant Director of Town Planning, Thane

ठाणे भ

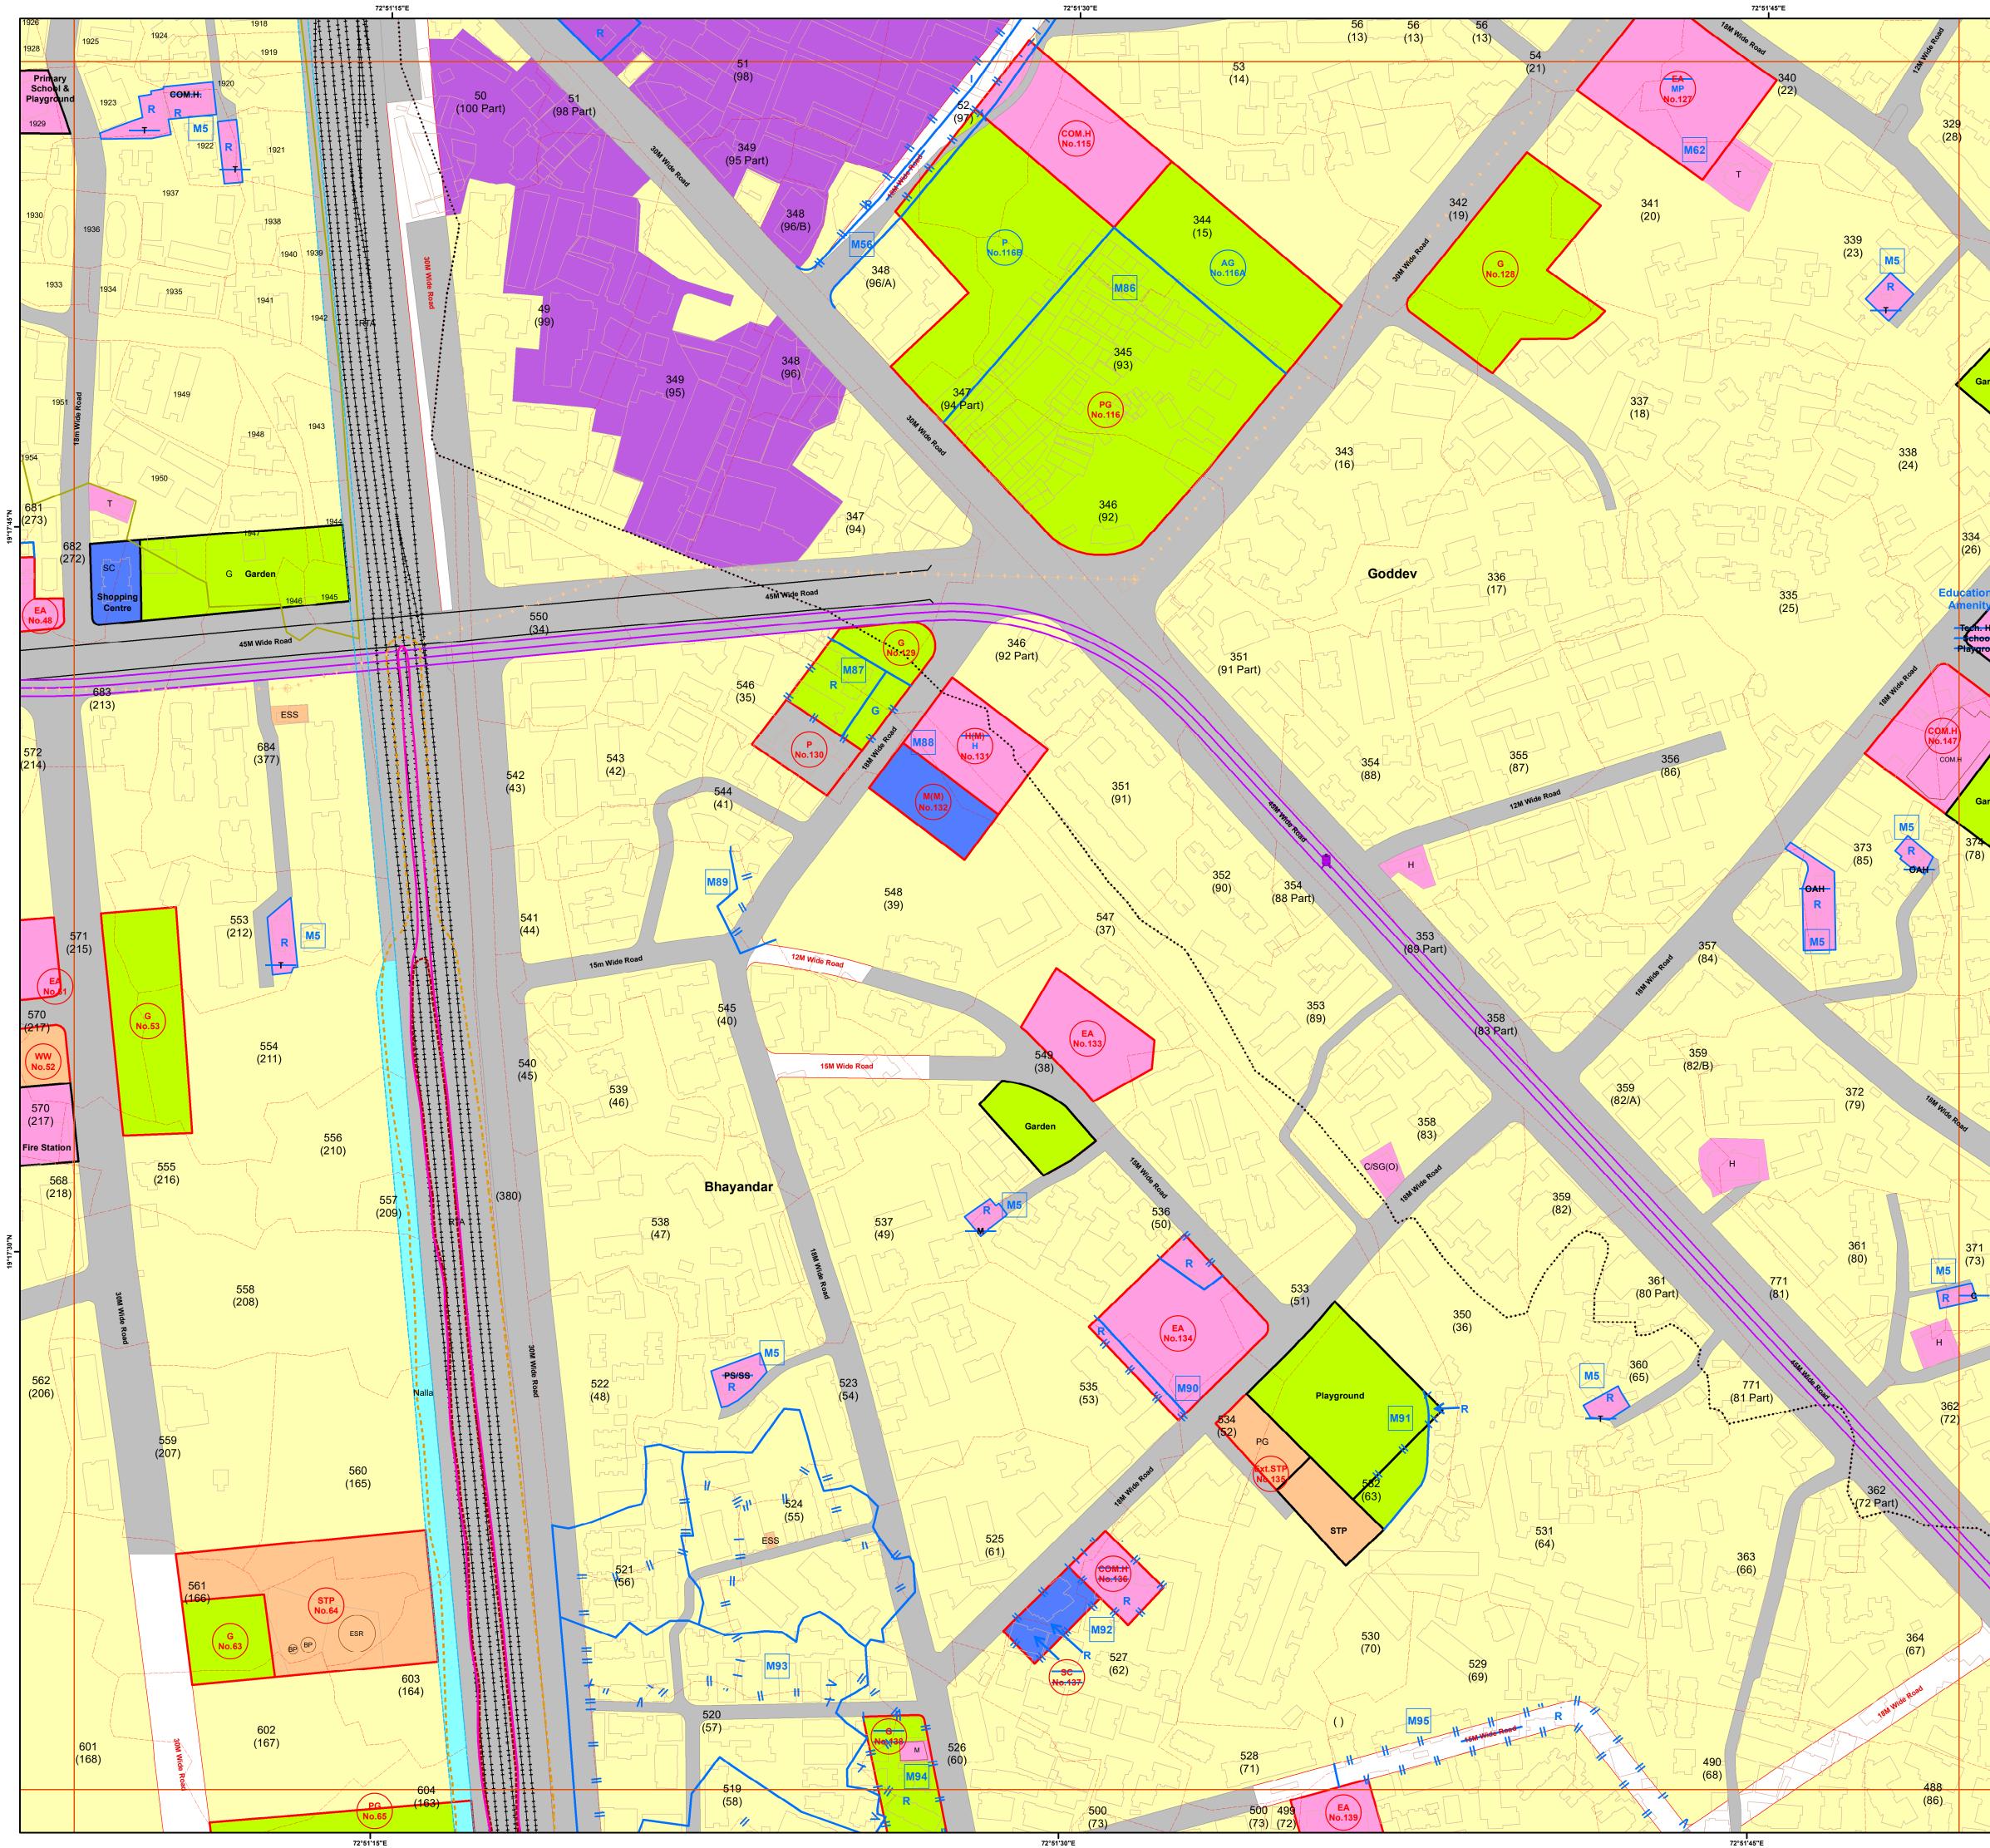



confirmation from Land Record or competent Authority. 3. The structure on the map does not confirm authorization unless verified and rectified by Planning Authority.

4.SGNP, CRZ, Mangroves with their buffers shown on the plan shall be as per the relevant status. In case of any modifications to such status in future, such boundary and buffer shall automatically stand modified as per the latest notification. 5. The alignment of Metro, <del>Coastal</del> Elevated Road marked on plan are indicative & automatically stand modified by the notification issued by Government from time to time. 6. The alignment of nallah / river / creek is indicative and as per the feature extracted from Drone Imagery and data collected.

7. The boundaries of all the designated sites, Government property are shown as per the image captured by superimposition on cadastral map. This may be subject to change as per the actual acquisition in future. 8. This plan is to be read with UDCPR-2022 and Draft DP Report.

P.Existing road shall have status of the road according to width of road even though not shown in development plan. 10.R-R(Restricted-Residential) Residential Zone subject to handing over area to corporation as per permission/Government orders 11.R-R1 (Restricted- Residential1) All provision of Residential Zone in UDCPR-2020 will be applicable for this zone subject to

10% of area under Development should be kept for Amenity Space as per direction of Municipal Commissioner with prior permission from Eco-Sensitive Zone Commitee.

12.If the location of Metro Carshed and Metro Line is shifted by MMRDA or Elevated Road is shifted in future, the land leased by such shifting shall stands included in adjoining Zone shown on Development Plan.

Scale				North N
0	0.05	0.1	0.2 km	WEE
		1:2,000		S
351001 2	मुल्यनिधर्मरुष			



377

(75)


370

(74)




Officer Appointed U/s 21(4A)

Draft Revised Development Plan of Mira Bhayandar

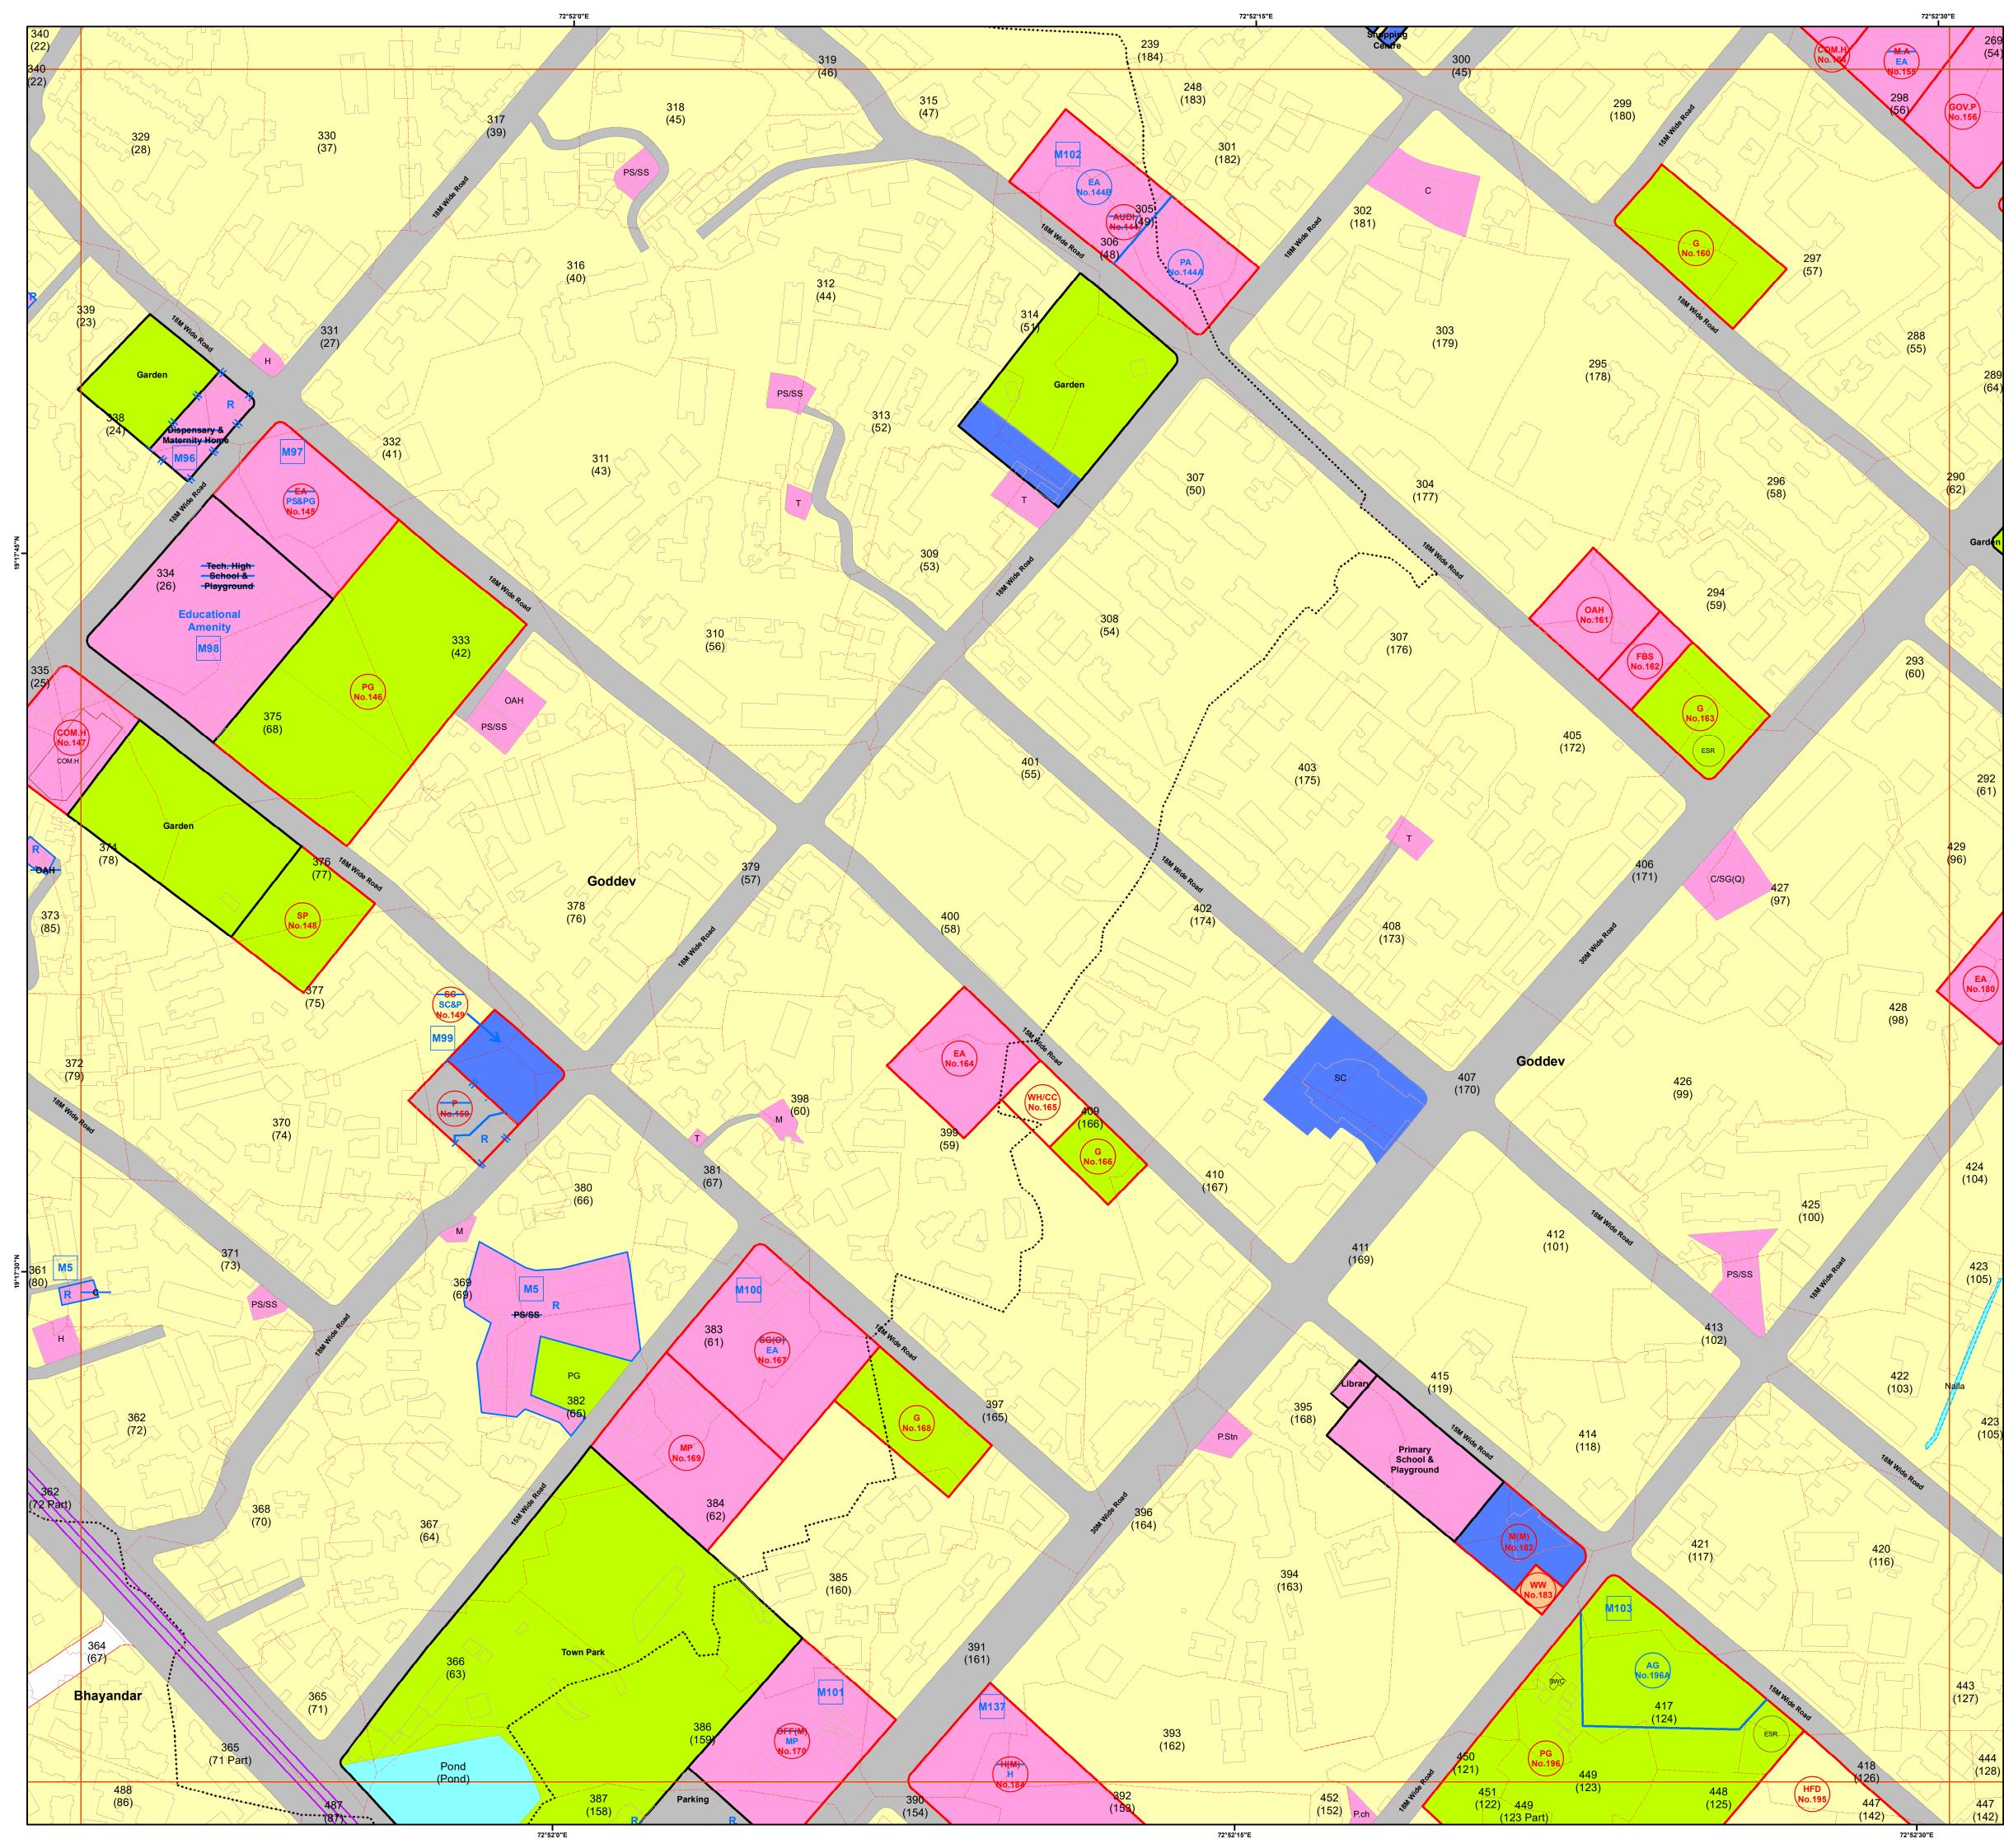



269 (54)

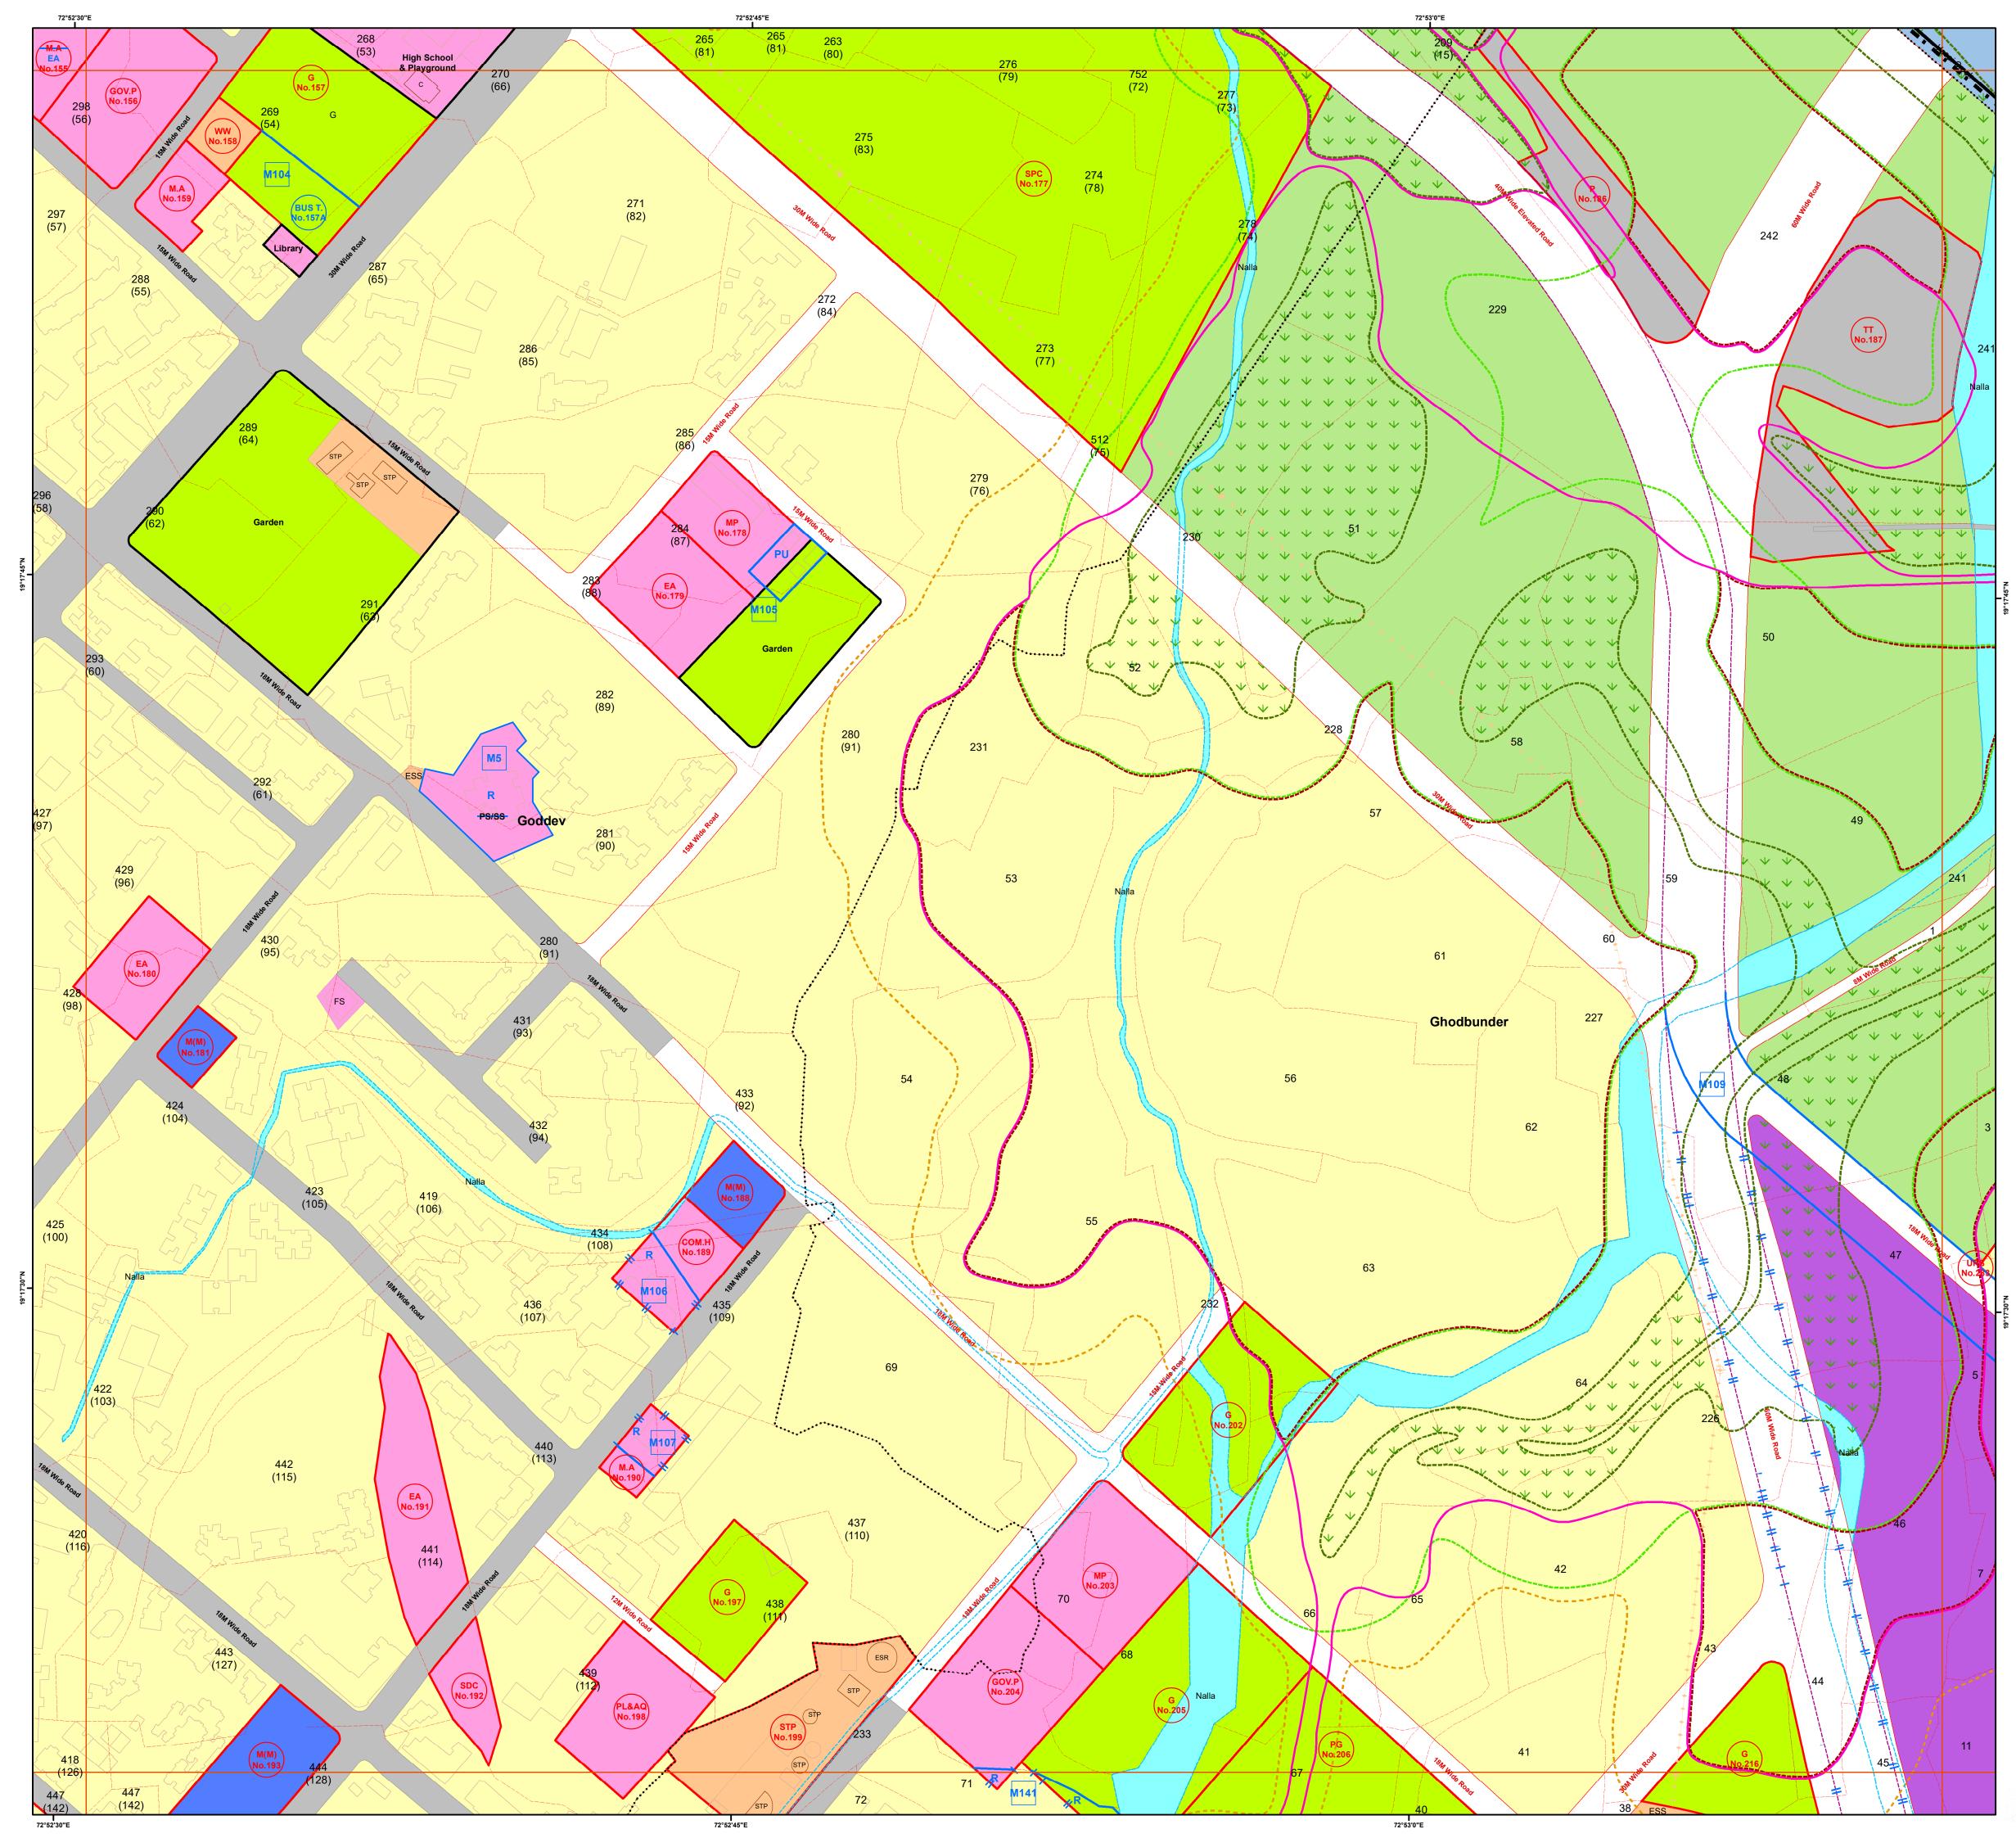



6. The alignment of nallah / river / creek is indicative and as per the feature extracted from Drone Imagery and data collected. 7. The boundaries of all the designated sites, Government property are shown as per the image captured by superimposition on cadastral map. This may be subject to change as per the actual acquisition in future.

8.This plan is to be read with UDCPR-2022 and Draft DP Report.

9.Existing road shall have status of the road according to width of road even though not shown in development plan. 10.R-R(Restricted-Residential) Residential Zone subject to handing over area to corporation as per permission/Government orders.

11.R-R1 (Restricted- Residential1) All provision of Residential Zone in UDCPR-2020 will be applicable for this zone subject to 10% of area under Development should be kept for Amenity Space as per direction of Municipal Commissioner with prior permission from Eco-Sensitive Zone Commitee.


12.If the location of Metro Carshed and Metro Line is shifted by MMRDA or Elevated Road is shifted in future, the land leased by such shifting shall stands included in adjoining Zone shown on Development Plan.

5	Scale			North N
	0 0.05	0.1	0.2 km	WEE
		1:2,000		S
	अस्मि मुल्यनिधारम		6)2+1	






Officer Appointed U/s 21(4A) Draft Revised Development Plan of Mira Bhayandar

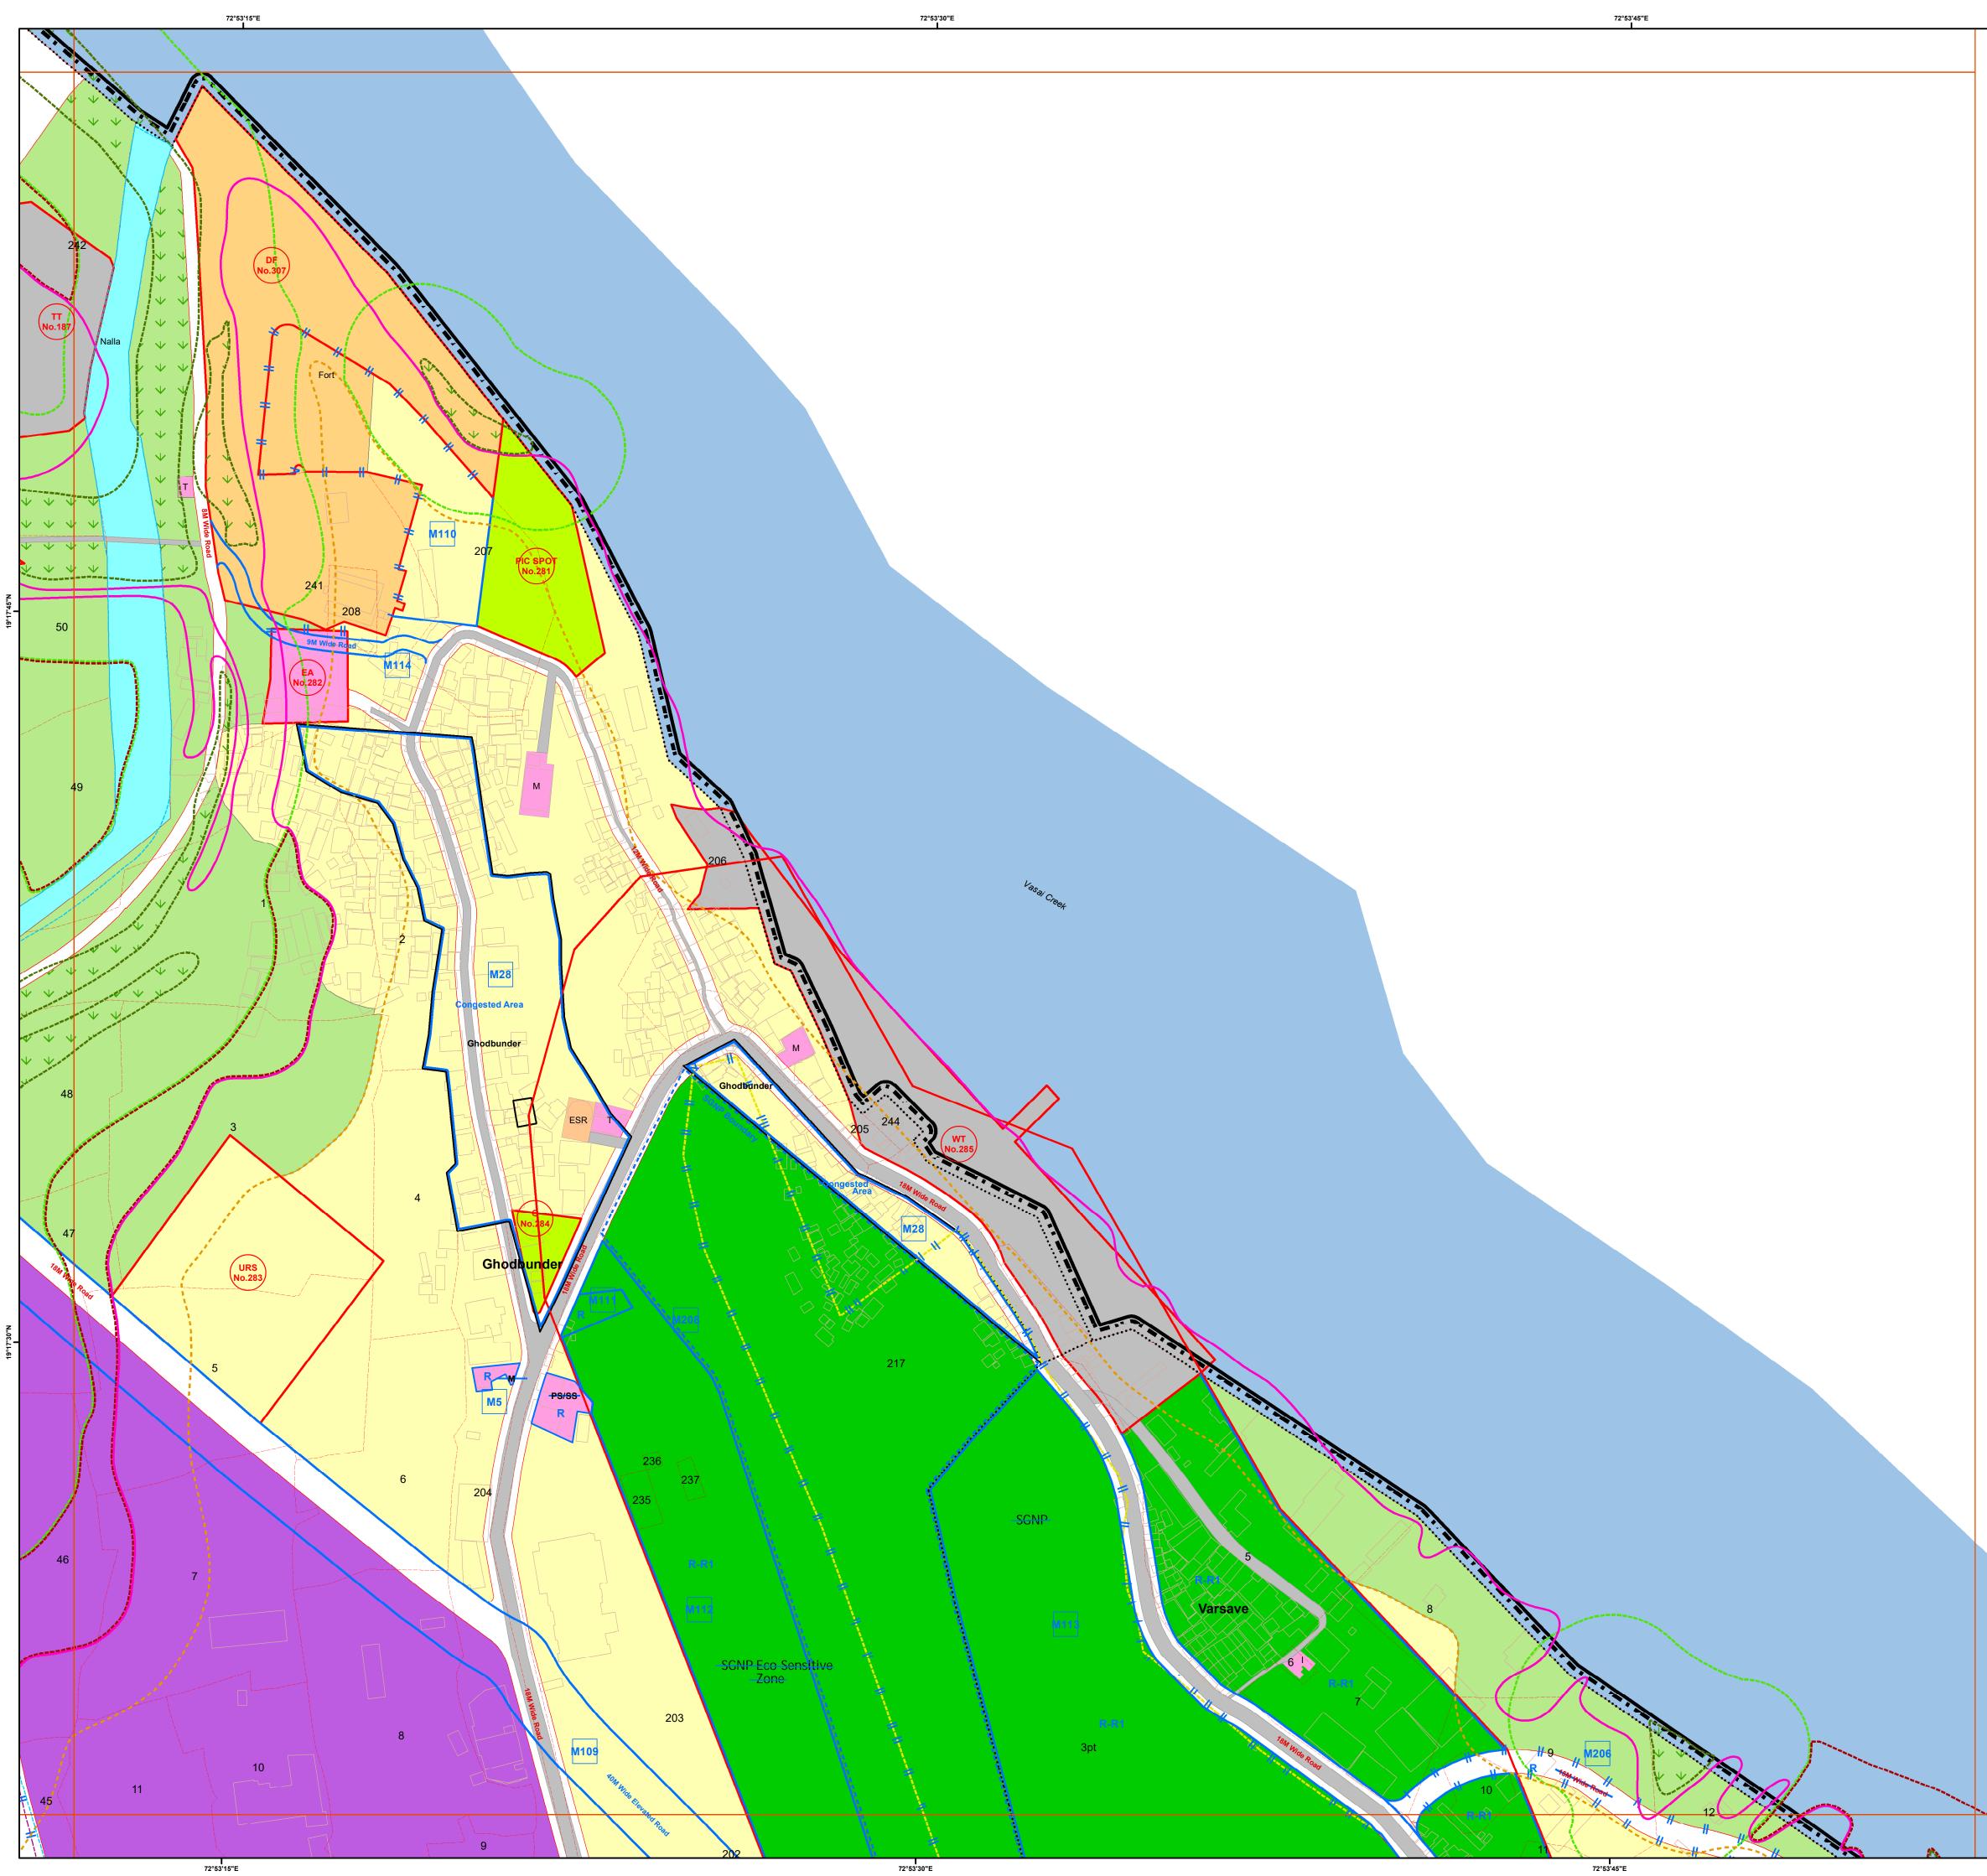








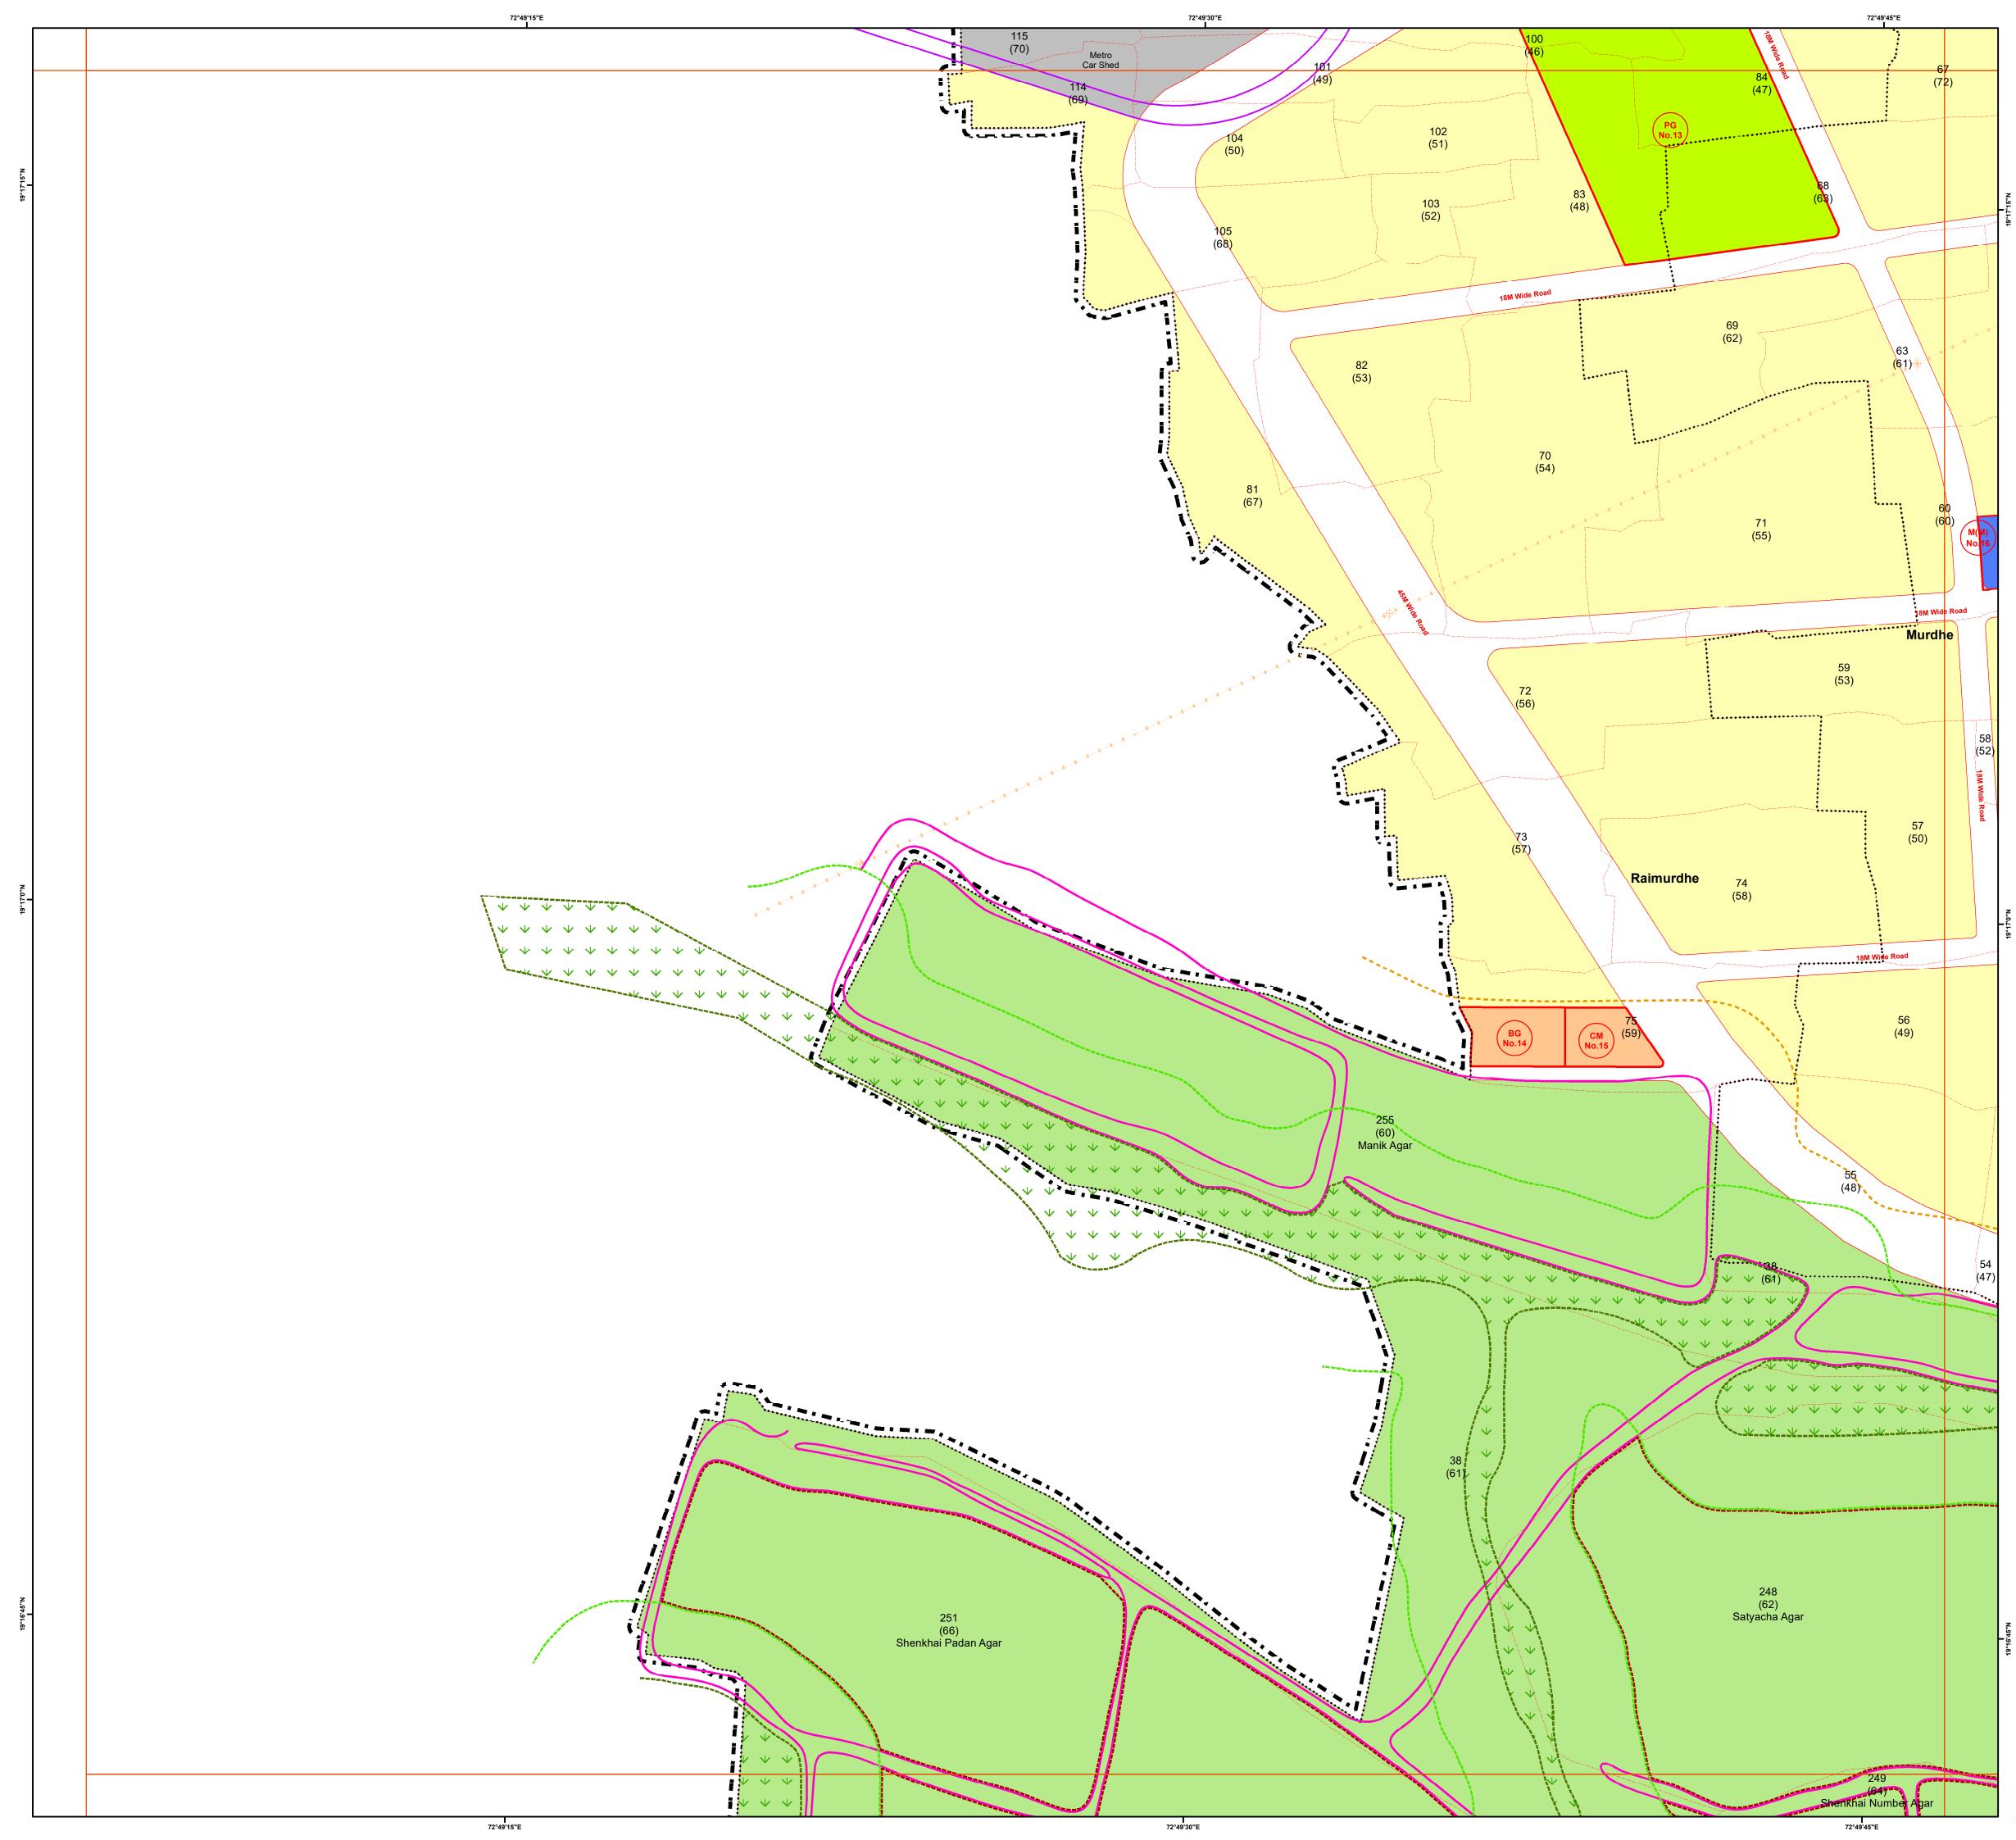





0 0.05 0.1 0.2 1:2,000 km V S Km V S

ठाणे १

 

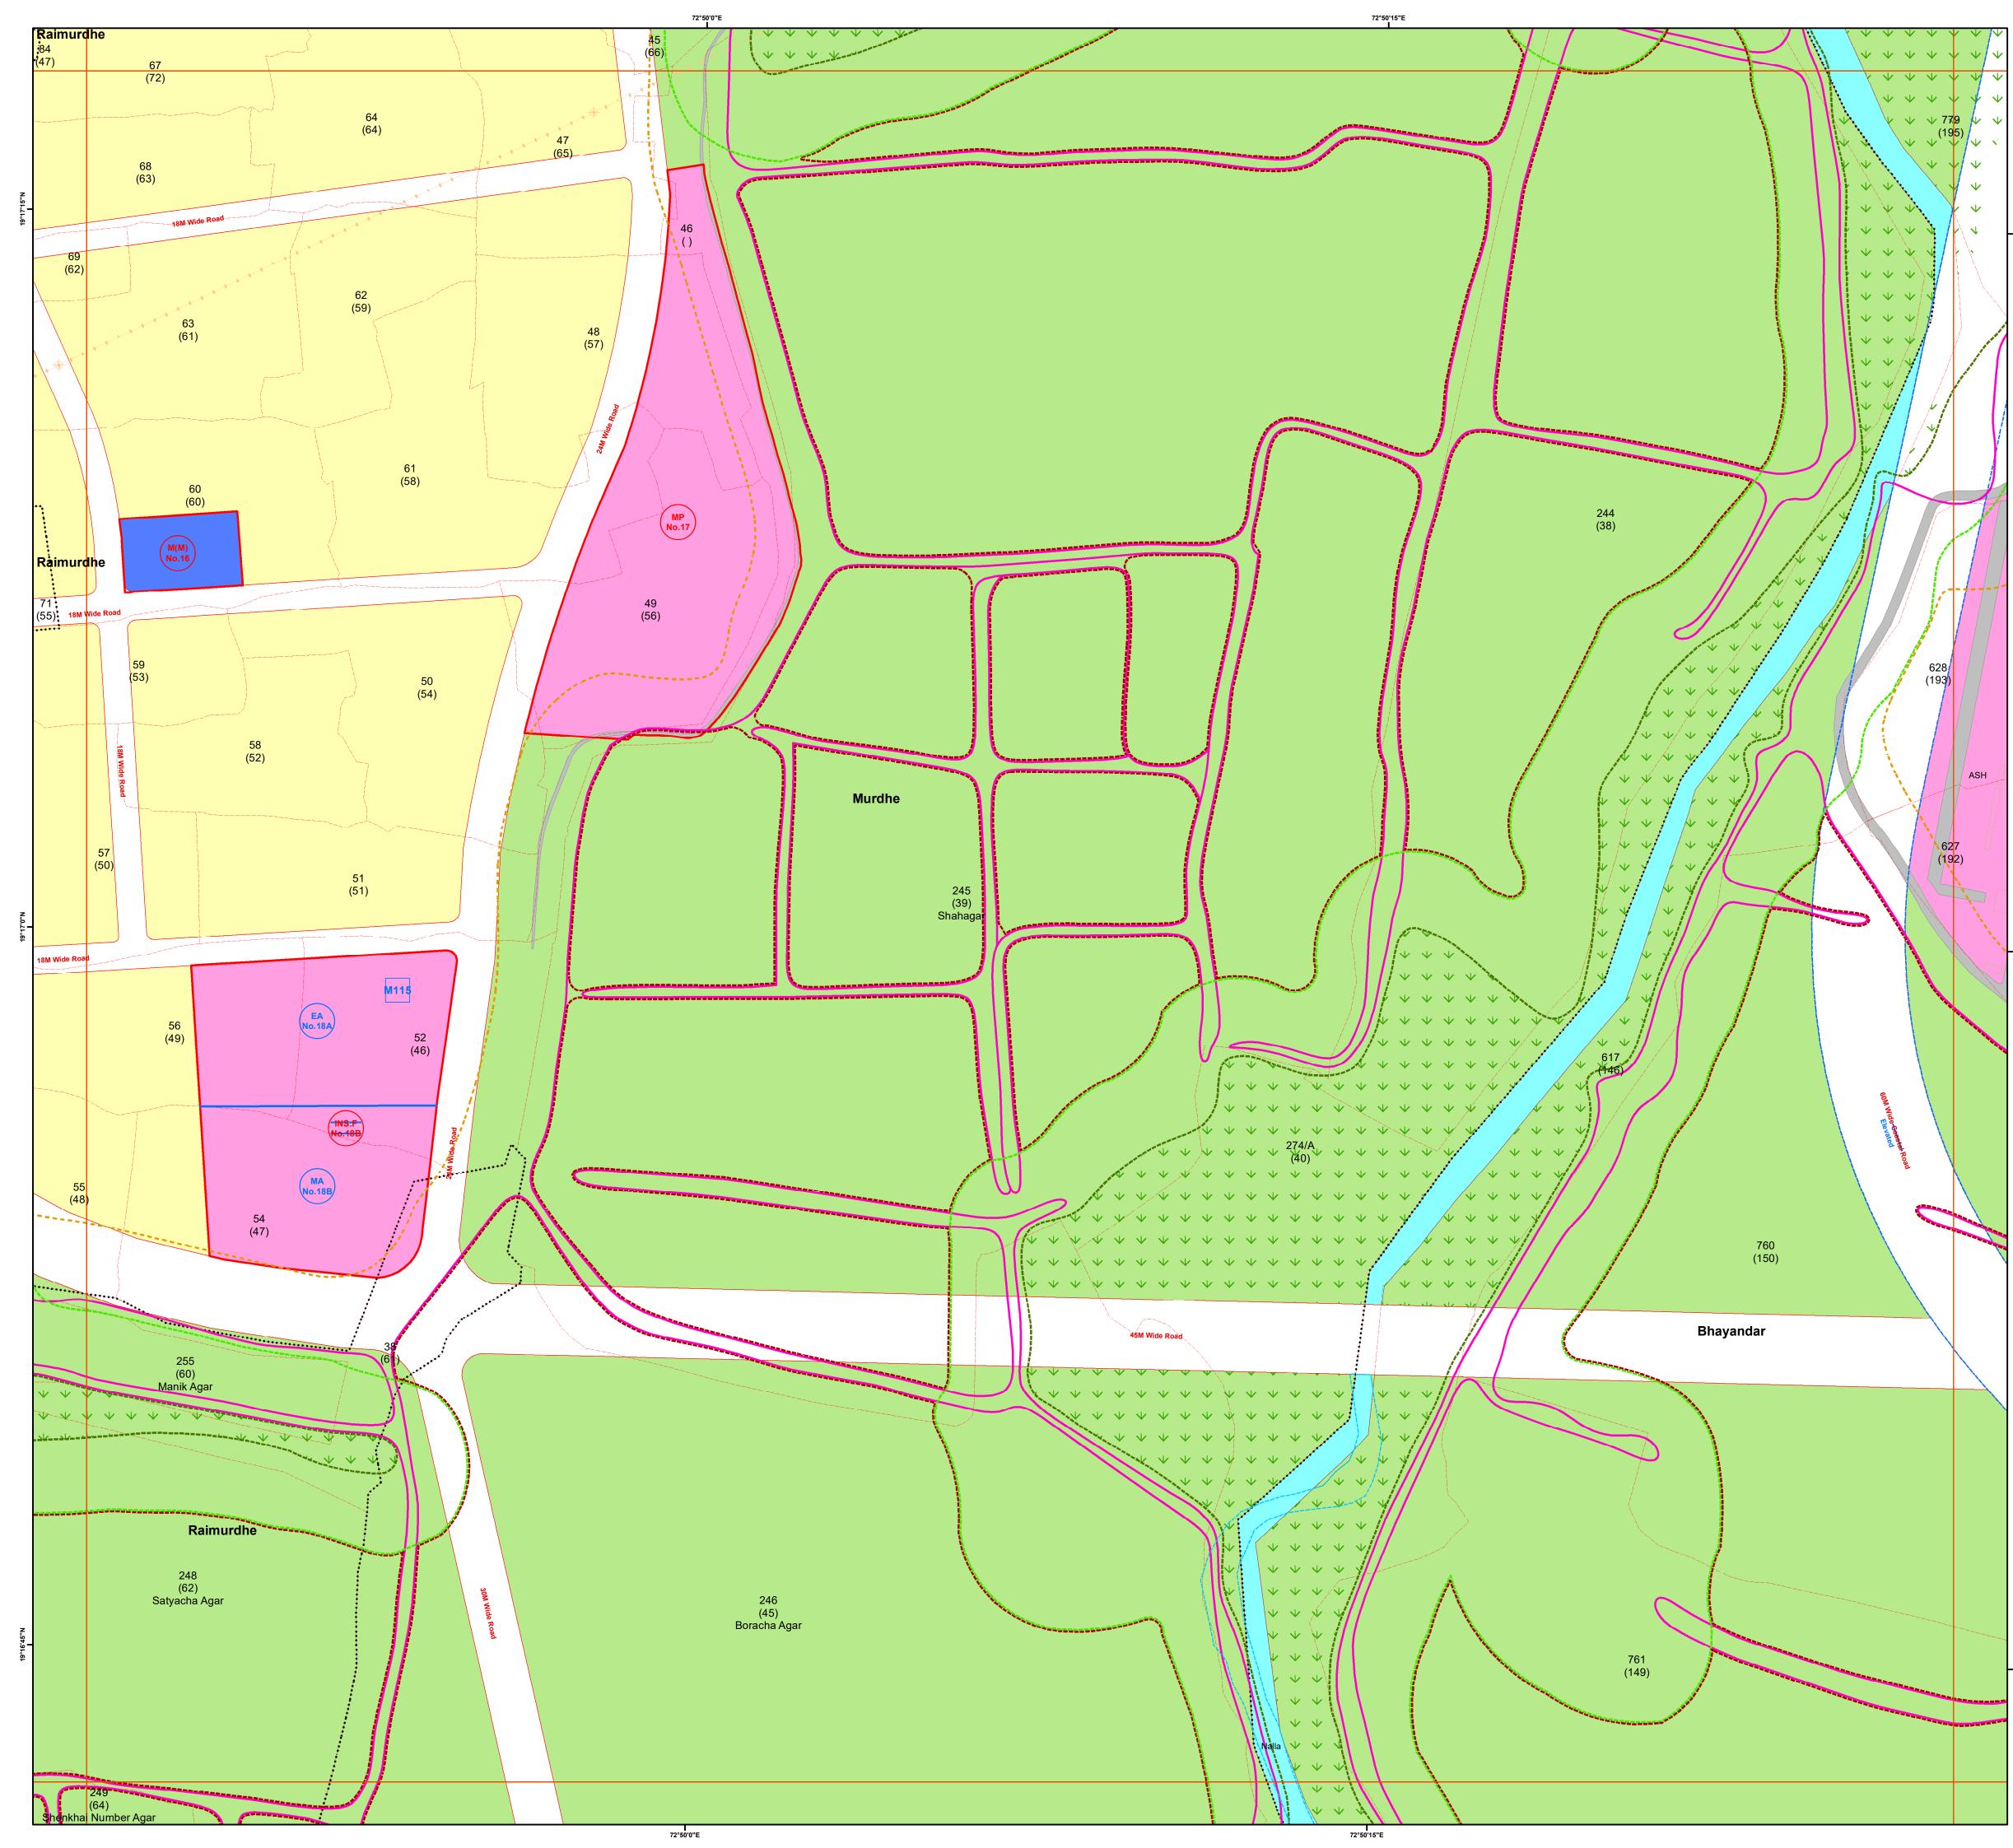

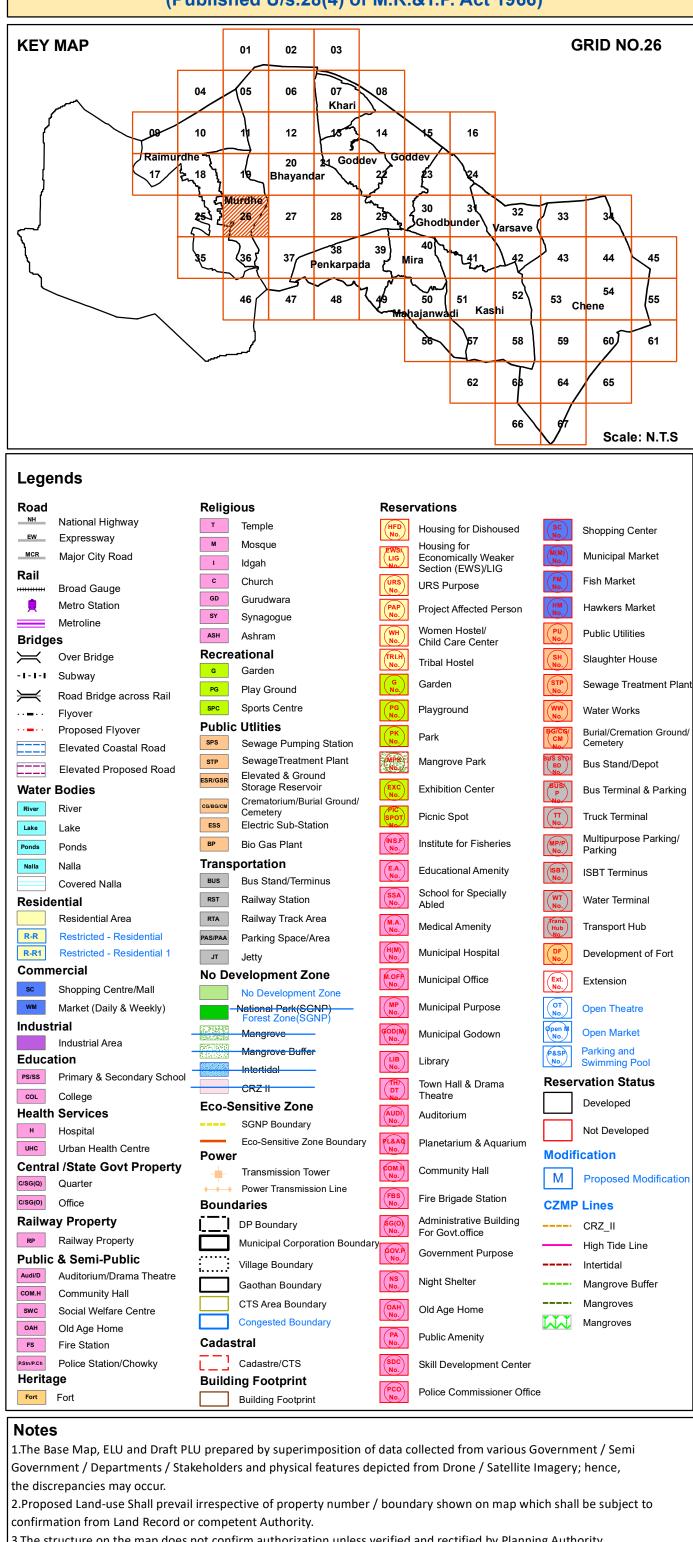

3. The structure on the map does not confirm authorization unless verified and rectified by Planning Authority. 4.SGNP, CRZ, Mangroves with their buffers shown on the plan shall be as per the relevant status. In case of any modifications to such status in future, such boundary and buffer shall automatically stand modified as per the latest notification. 5. The alignment of Metro, <del>Coastal Elevated</del> Road marked on plan are indicative & automatically stand modified by the notification issued by Government from time to time. 6. The alignment of nallah / river / creek is indicative and as per the feature extracted from Drone Imagery and data collected.

7. The boundaries of all the designated sites, Government property are shown as per the image captured by superimposition on cadastral map. This may be subject to change as per the actual acquisition in future. 8.This plan is to be read with UDCPR-2022 and Draft DP Report.

9.Existing road shall have status of the road according to width of road even though not shown in development plan. 10.R-R(Restricted-Residential) Residential Zone subject to handing over area to corporation as per permission/Government orders.

11.R-R1 (Restricted- Residential1) All provision of Residential Zone in UDCPR-2020 will be applicable for this zone subject to 10% of area under Development should be kept for Amenity Space as per direction of Municipal Commissioner with prior permission from Eco-Sensitive Zone Commitee.


12.If the location of Metro Carshed and Metro Line is shifted by MMRDA or Elevated Road is shifted in future, the land eased by such shifting shall stands included in adjoining Zone shown on Development Plan.


Scale				North	N
0	0.05	0.1	0.2		WEE
		1:2,000			s
31101	मुल्यनिधरिष				





Officer Appointed U/s 21(4A) Draft Revised Development Plan of Mira Bhayandar

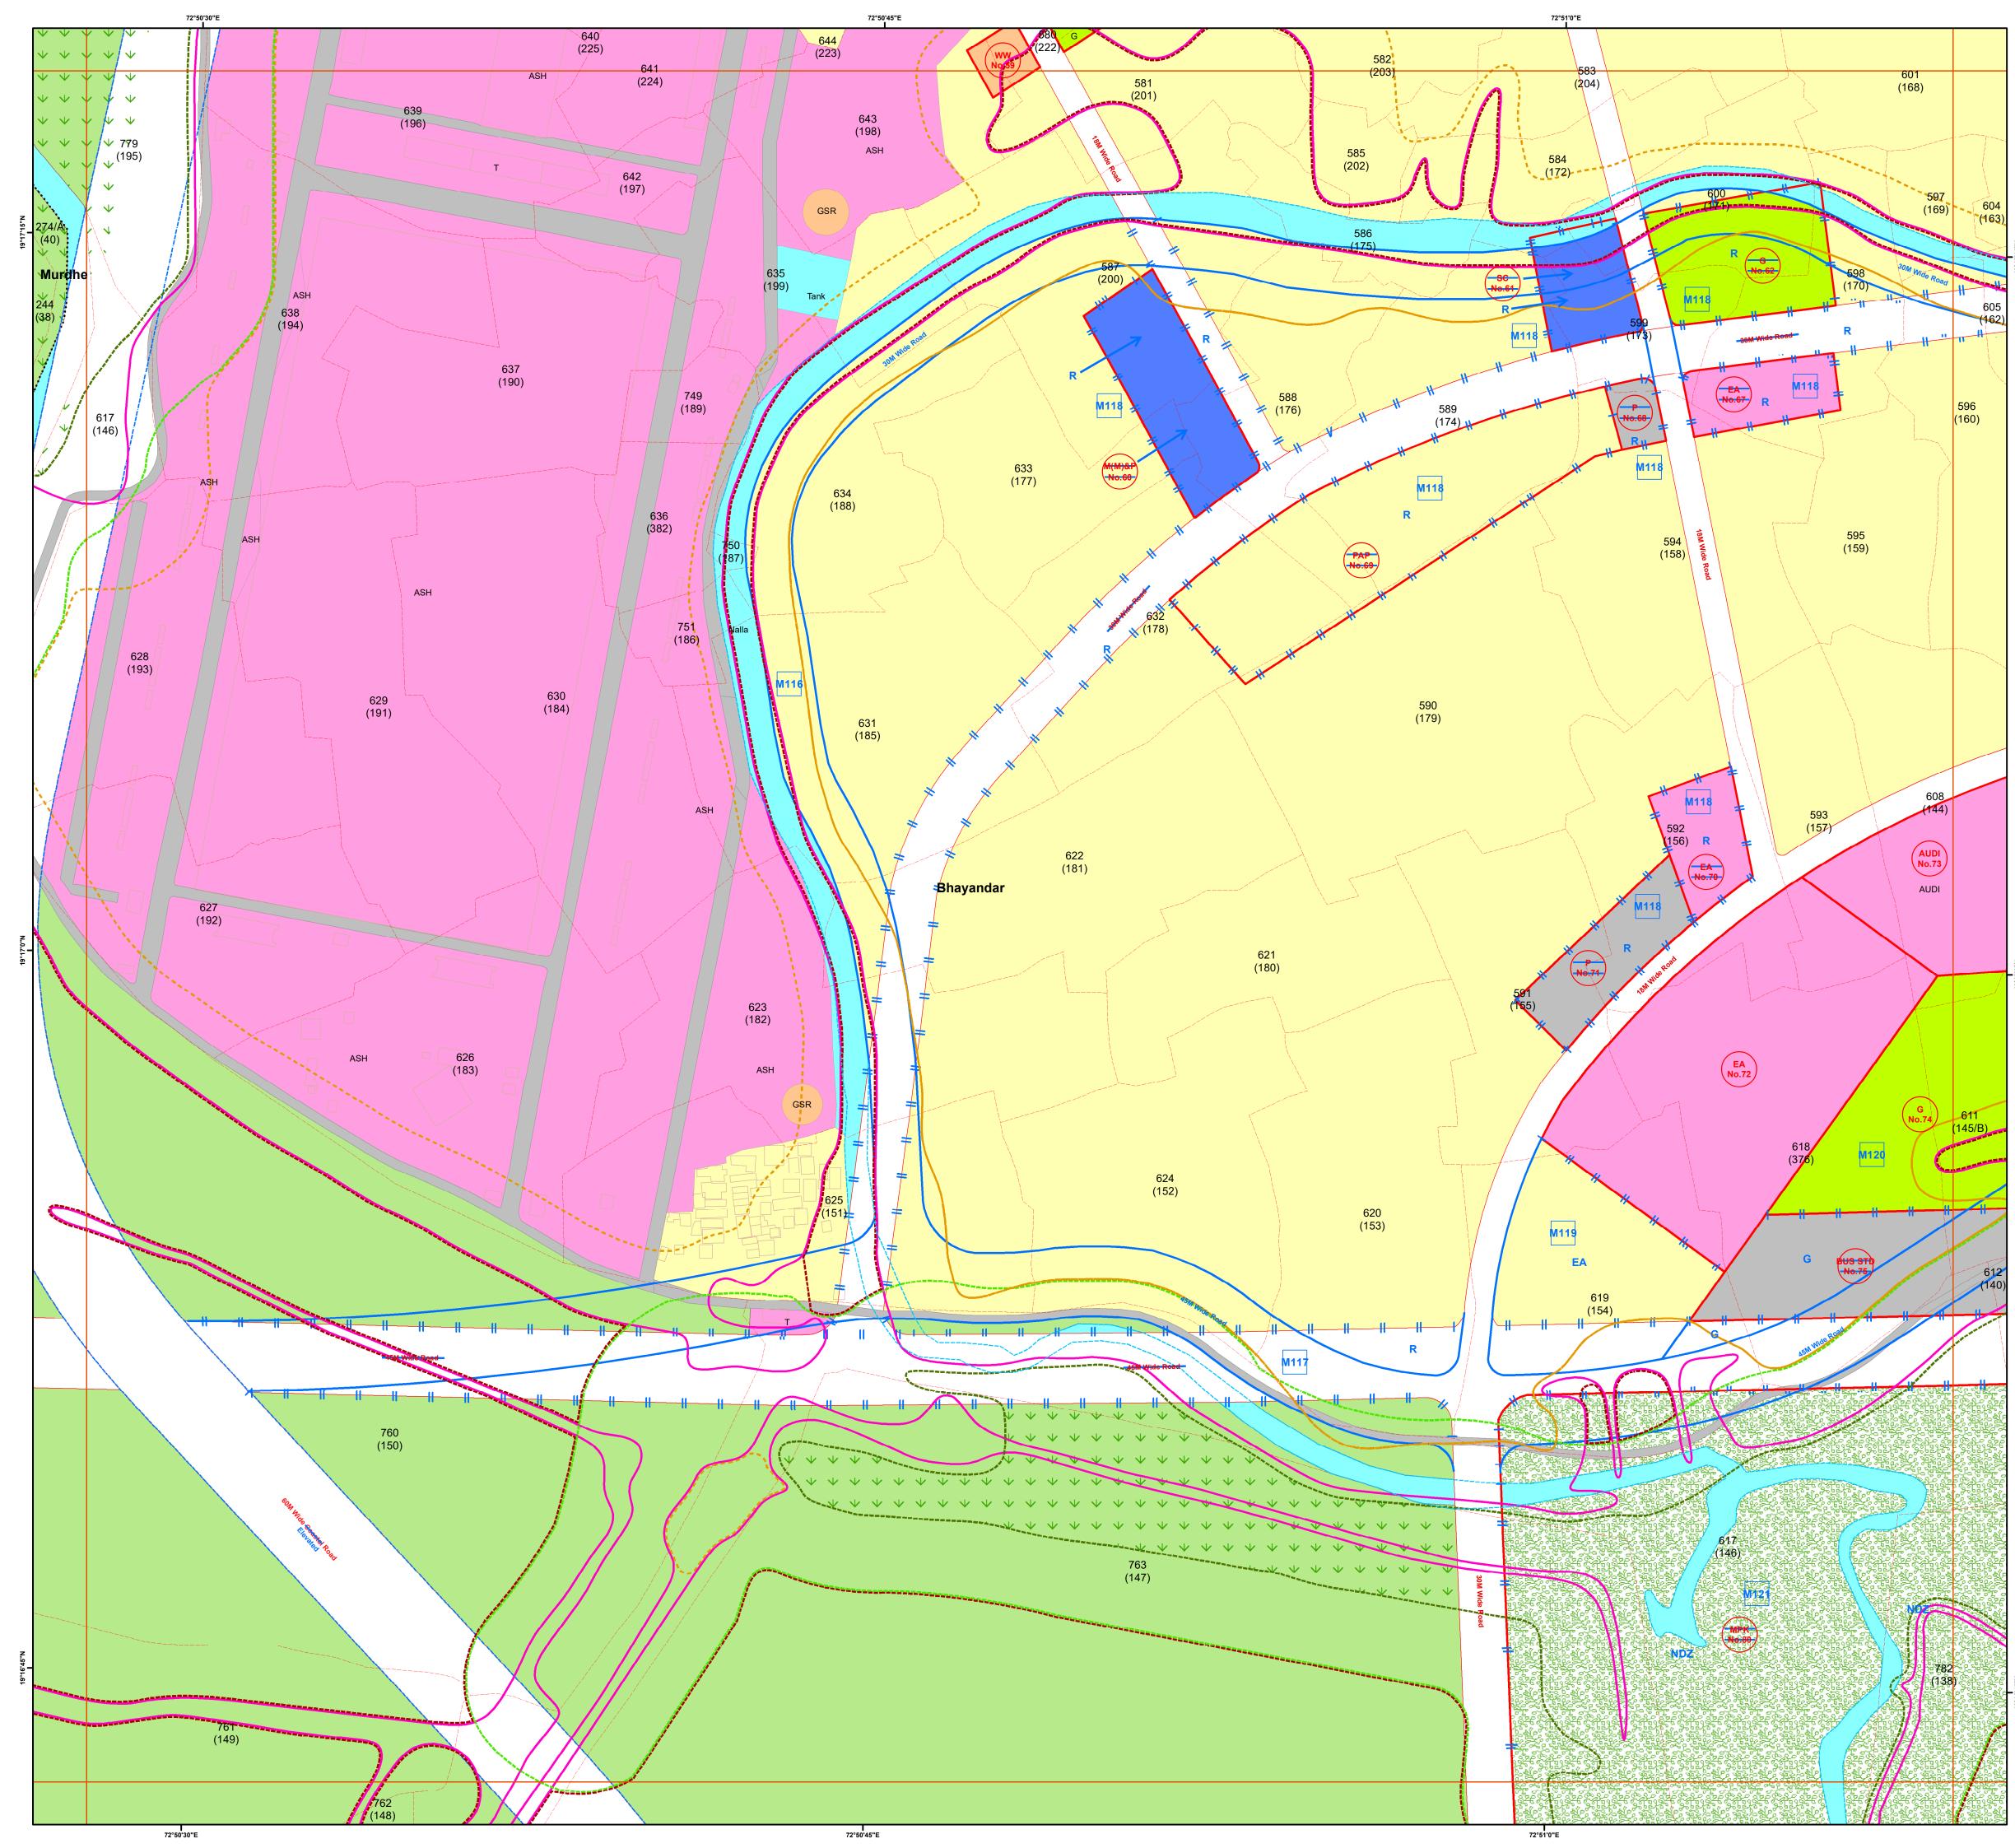

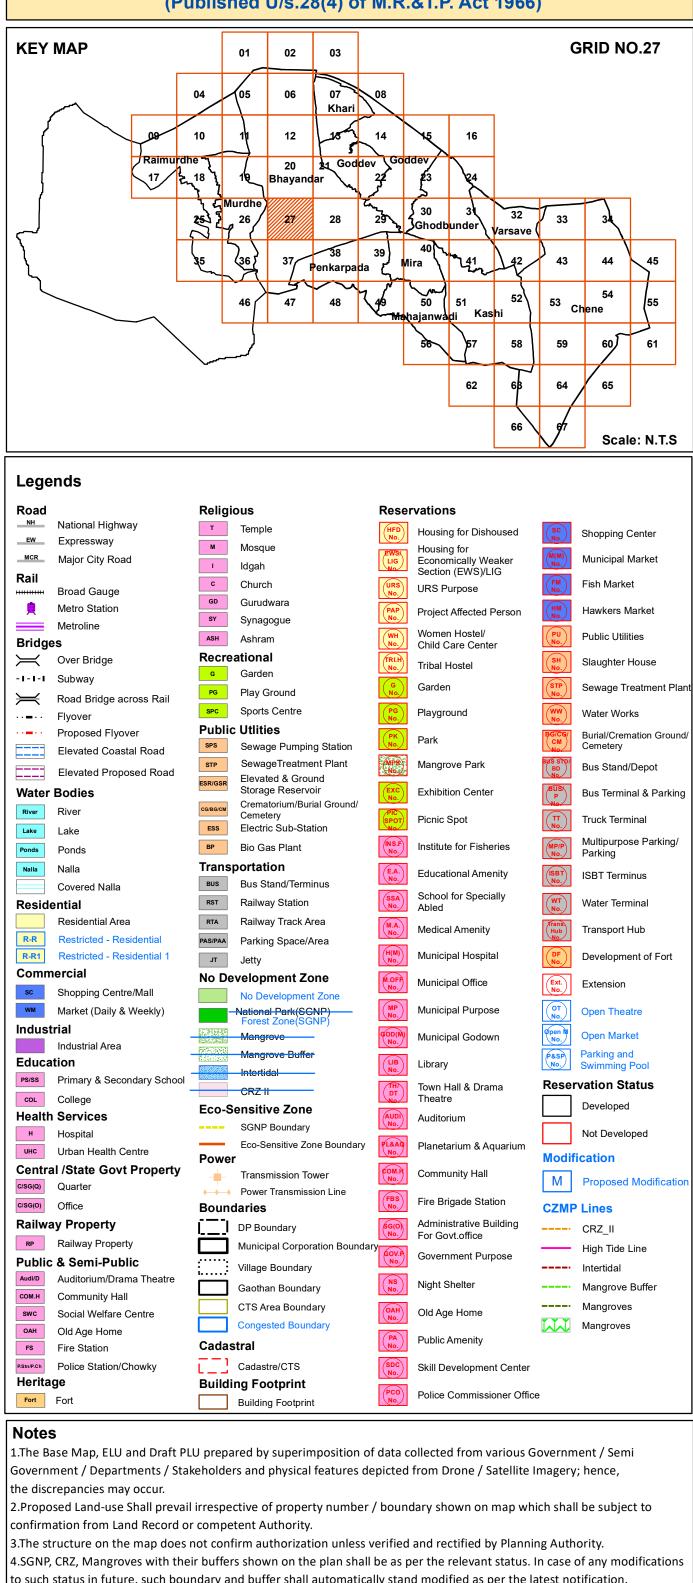

to such status in future, such boundary and buffer shall automatically stand modified as per the latest notification. 5.The alignment of Metro, Coastal Elevated Road marked on plan are indicative & automatically stand modified by the notification issued by Government from time to time.

6. The alignment of nallah / river / creek is indicative and as per the feature extracted from Drone Imagery and data collected. 7. The boundaries of all the designated sites, Government property are shown as per the image captured by superimposition on cadastral map. This may be subject to change as per the actual acquisition in future. 8.This plan is to be read with UDCPR-2022 and Draft DP Report.

P.Existing road shall have status of the road according to width of road even though not shown in development plan. 10.R-R(Restricted-Residential) Residential Zone subject to handing over area to corporation as per permission/Government

11.R-R1 (Restricted- Residential1) All provision of Residential Zone in UDCPR-2020 will be applicable for this zone subject to 10% of area under Development should be kept for Amenity Space as per direction of Municipal Commissioner with prior permission from Eco-Sensitive Zone Commitee.


12.If the location of Metro Carshed and Metro Line is shifted by MMRDA or Elevated Road is shifted in future, the land eased by such shifting shall stands included in adjoining Zone shown on Development Plan.

Scale				North N
0	0.05	0.1	0.2 km	WEE
		1:2,000		S
3110	मुल्यनिधार्म			





Officer Appointed U/s 21(4A) Draft Revised Development Plan of Mira Bhayandar

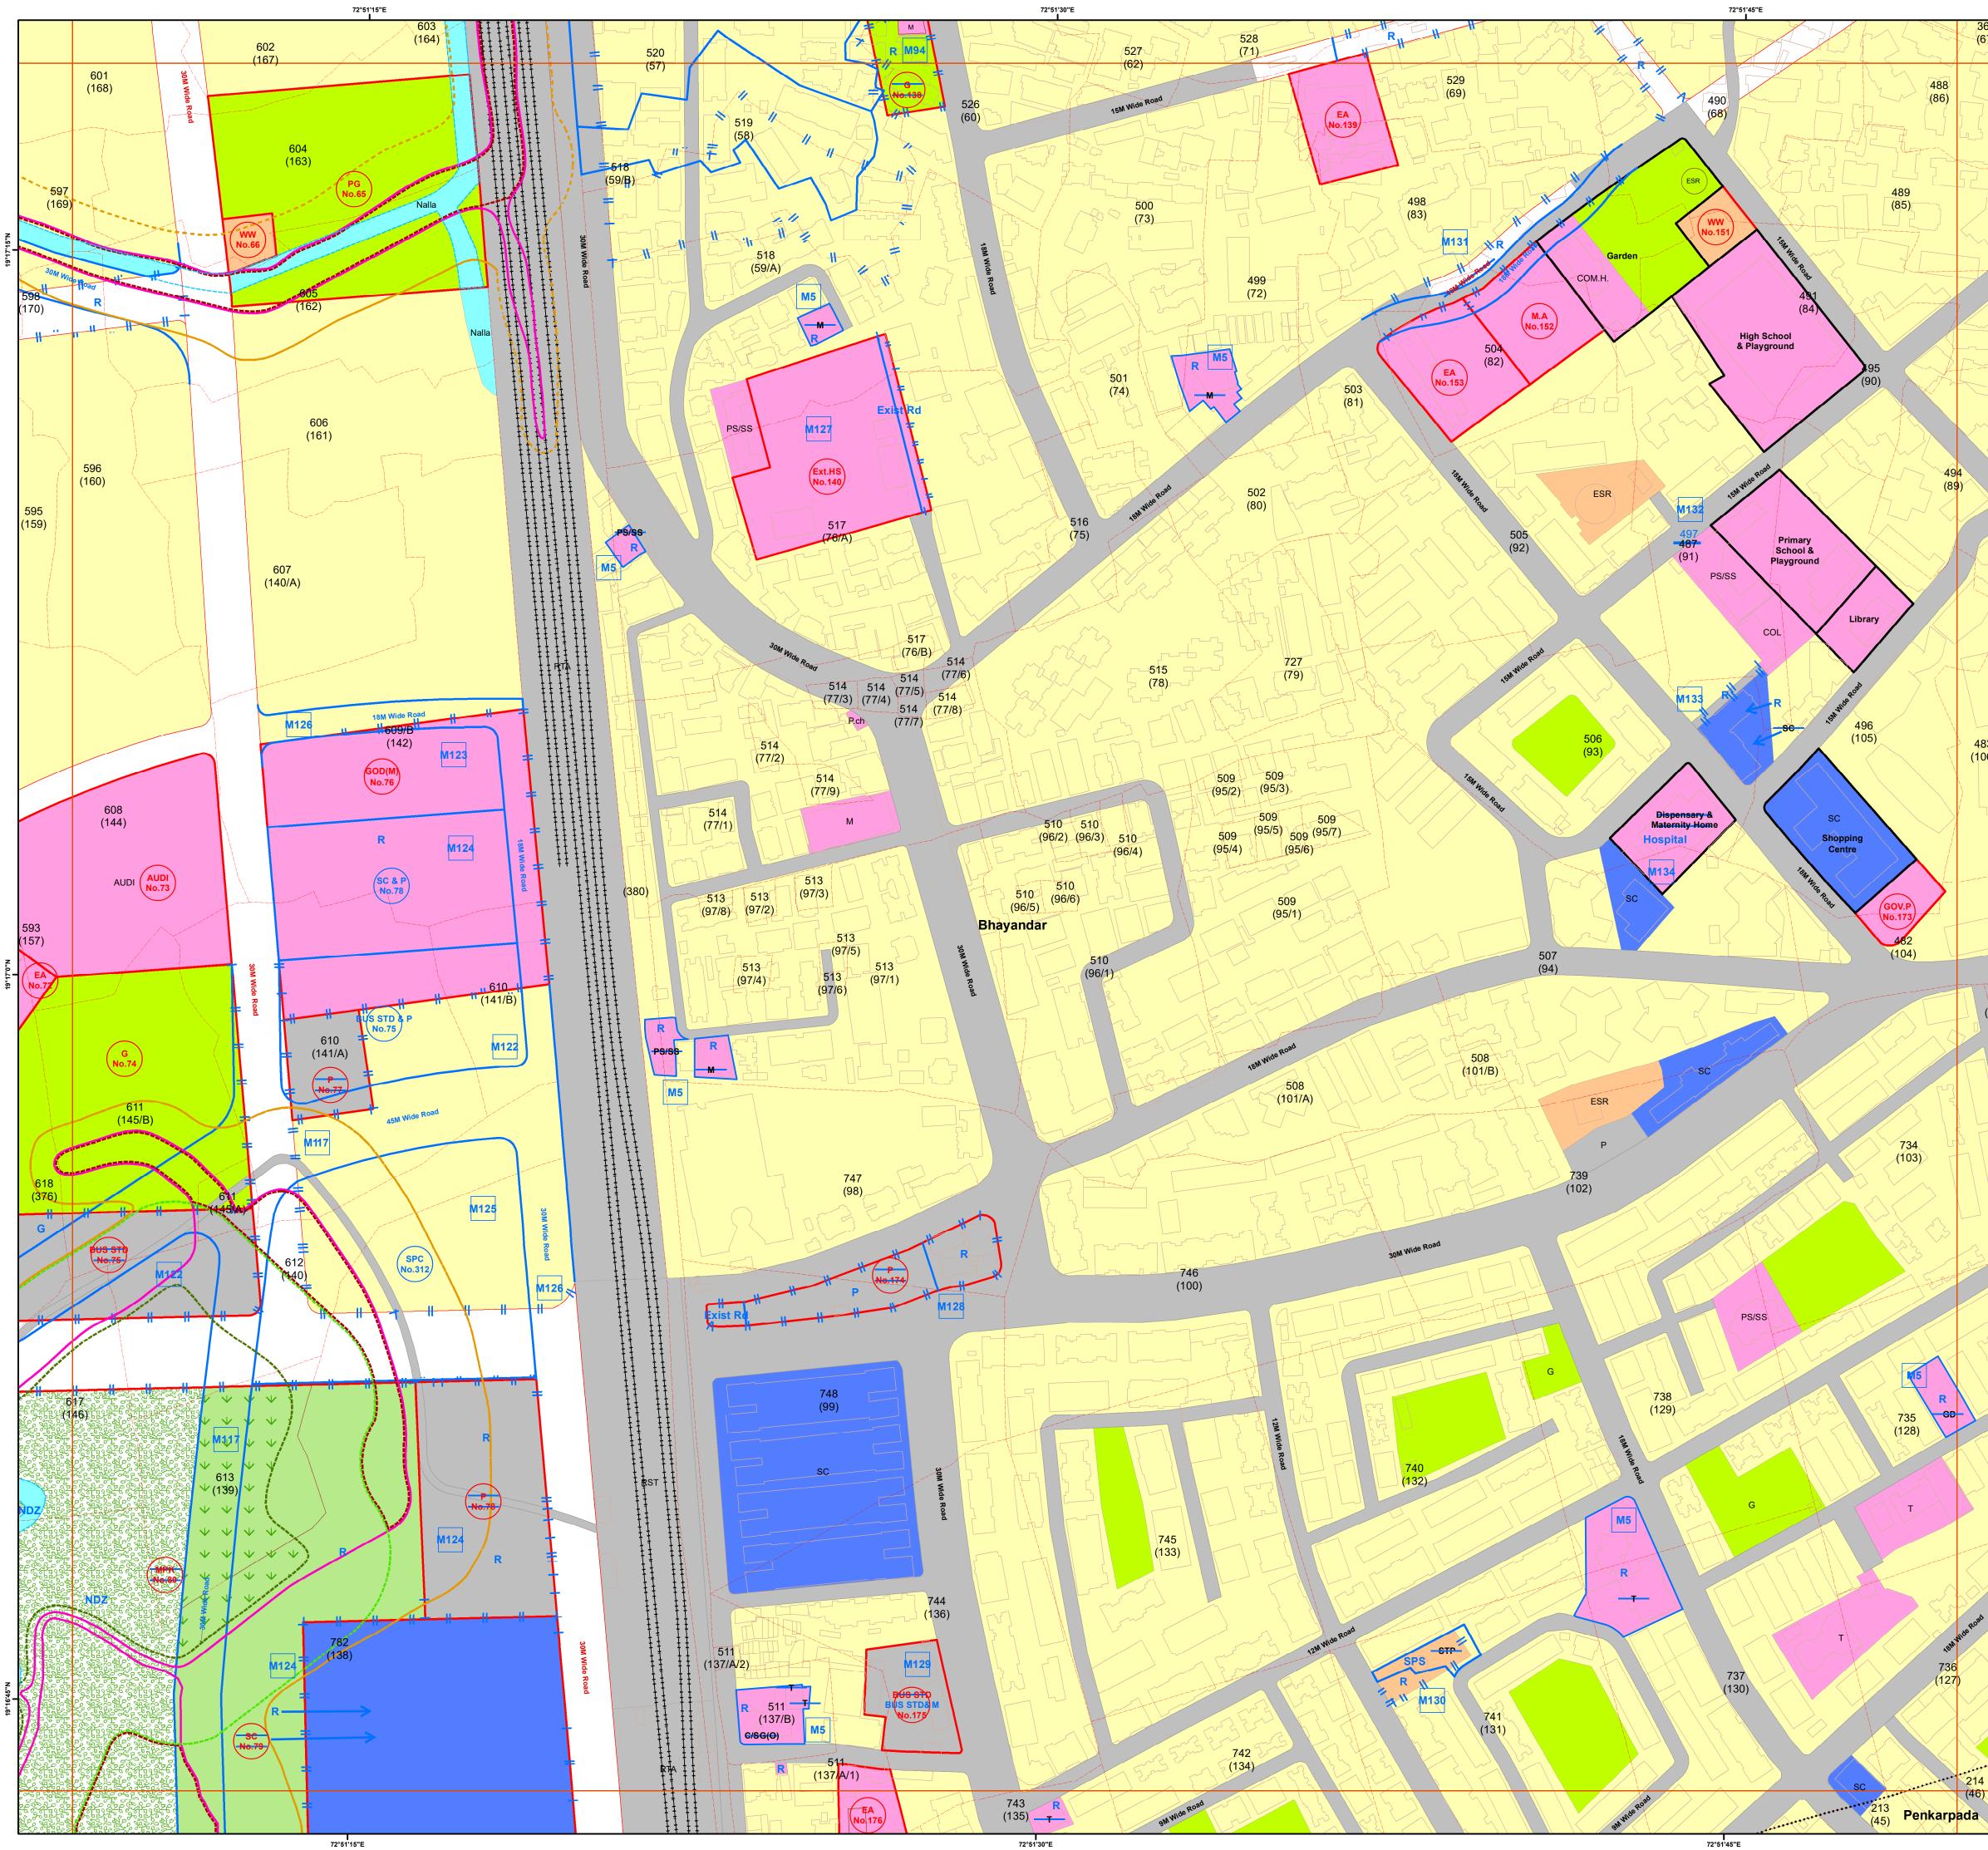

(Pu	blished U/s.2	8(4) of M.R.	&T.P. Act 1966	<b>()</b>
KEY MAP	01 02	03		GRID NO.28
	04 05 06	07 Khari		
Raimurdh		18 14 21 Goddev God	45 16 dev	
	18 19 Bhayan C C Murdhe 25 7 26 27	dar 22 28 29	£3 24 30 3 32	33 34
5		38 39	Ghodbunder Varsave	43 44 45
	46 47	48 49 Max	50 51 52 najanwadi Kashi	53 54 55 Chene 55
			56 67 58	59 60 61
			62 68 66	64 65 67
Legends			L	Scale: N.T.S
Road	Religious	Rese	rvations	
National Highway	Temple	(HFD No.	Housing for Dishoused	Shopping Center
Expressway McR Major City Road	M Mosque	EWS	Housing for Economically Weaker	(MM) Municipal Market
Rail	ldgah	URS	Section (EWS)/LIG	Fish Market
Hetro Station	Gurudwara	No.	URS Purpose	HM No. Hawkers Market
Metroline	sy Synagogue	PAP No.	Project Affected Person Women Hostel/	
Bridges	ASH Ashram Recreational	(WH No.	Child Care Center	Public Utilities
Over Bridge	G Garden	(TRLH No.	Tribal Hostel	Slaughter House
Road Bridge across Rail	PG Play Ground	G No.	Garden	Sewage Treatment Plan
····· Flyover	SPC Sports Centre	PG No.	Playground	WWW Water Works
····· Proposed Flyover	Public Utlities           sps         Sewage Pumpi	ng Station	Park	Burial/Cremation Ground/
Elevated Coastal Road	STP SewageTreatm	-	Mangrove Park	BUS Stand/Depot
Elevated Proposed Road     Water Bodies	Elevated & Gro Storage Reserv		Exhibition Center	Bus Terminal & Parking
River River	Crematorium/Bu Cemetery	rial Ground/		
Lake Lake	Electric Sub-Sta		Picnic Spot	Truck Terminal
Ponds	BP Bio Gas Plant	(NS.F No.	Institute for Fisheries	Multipurpose Parking/ Parking
	Transportation Bus Bus Stand/Tern	E.A. No.	Educational Amenity	ISBT Terminus
Covered Nalla Residential	RST Railway Station		School for Specially Abled	Water Terminal
Residential Area	RTA Railway Track A		Abled Medical Amenity	No.
R-R Restricted - Residential	Pas/Paa Parking Space/	Area		No
R-R1 Restricted - Residential 1 Commercial	JT Jetty	(H(M)) No.	Municipal Hospital	DF No.
Sc Shopping Centre/Mall	No Development Z	No.	Municipal Office	Ext. No. Extension
Market (Daily & Weekly)	National Park(Se Forest Zone(Se		Municipal Purpose	OT Open Theatre
	Mangrove	- COD(M) No.	Municipal Godown	Open M Open Market
Industrial Area	Mangrove Buffe		Library	Parking and Swimming Pool
Ps/ss Primary & Secondary School			Town Hall & Drama	Reservation Status
COL College	Eco-Sensitive Zon		Theatre	Developed
Health Services	SGNP Boundary	(AUDI)	Auditorium	Not Developed
Urban Health Centre	Eco-Sensitive Z	one Boundary	Planetarium & Aquarium	Modification
Central /State Govt Property	Transmission T	ower	Community Hall	
c/sc(Q) Quarter	Power Transmis		Fire Brigade Station	
C(SG(0) Office Railway Property	Boundaries DP Boundary		Administrative Building	CZMP Lines
Realiway Property		ration Boundary	For Govt.office	CRZ_II     High Tide Line
Public & Semi-Public	Village Boundar	GOV.P	Government Purpose	Intertidal
Audi/D Auditorium/Drama Theatre	Gaothan Bound	ary NS No.	Night Shelter	Mangrove Buffer
swc Social Welfare Centre	CTS Area Bound	No.	Old Age Home	Mangroves
Old Age Home	Congested Bour	ndary	Public Amenity	Mangroves
FS Fire Station			-	
Police Station/Chowky Heritage	Cadastre/CTS Building Footprint	(SDC No.	Skill Development Center	
Fort Fort	Building Footprin	nt (PCO No.	Police Commissioner Offic	be a state of the
Notes	I prepared by superi	mosition of data c	ollected from various (	Sovernment / Semi

1. The Base Map, ELU and Draft PLU prepared by superimposition of data collected from various Government / Semi Government / Departments / Stakeholders and physical features depicted from Drone / Satellite Imagery; hence, the discrepancies may occur.

2. Proposed Land-use Shall prevail irrespective of property number / boundary shown on map which shall be subject to confirmation from Land Record or competent Authority.

3. The structure on the map does not confirm authorization unless verified and rectified by Planning Authority. 4.SGNP, CRZ, Mangroves with their buffers shown on the plan shall be as per the relevant status. In case of any modifications to such status in future, such boundary and buffer shall automatically stand modified as per the latest notification. 5. The alignment of Metro, Coastal Elevated Road marked on plan are indicative & automatically stand modified by the notification issued by Government from time to time.

6.The alignment of nallah / river / creek is indicative and as per the feature extracted from Drone Imagery and data collected. 7. The boundaries of all the designated sites, Government property are shown as per the image captured by superimposition on cadastral map. This may be subject to change as per the actual acquisition in future. 8.This plan is to be read with UDCPR-2022 and Draft DP Report.

9.Existing road shall have status of the road according to width of road even though not shown in development plan. 10.R-R(Restricted-Residential) Residential Zone subject to handing over area to corporation as per permission/Government orders.

11.R-R1 (Restricted- Residential1) All provision of Residential Zone in UDCPR-2020 will be applicable for this zone subject to 10% of area under Development should be kept for Amenity Space as per direction of Municipal Commissioner with prior permission from Eco-Sensitive Zone Commitee.

12.If the location of Metro Carshed and Metro Line is shifted by MMRDA or Elevated Road is shifted in future, the land leased by such shifting shall stands included in adjoining Zone shown on Development Plan.

Scale					North N
0	0.05	0.1	С	).2 ∎ km	W
		1:2,000			S
35100	मुल्यनिधारिष				





Officer Appointed U/s 21(4A) Draft Revised Development Plan of Mira Bhayandar


Assistant Director of Town Planning, Thane

729 (124)

483 (106)

364 (67)

492 (88)

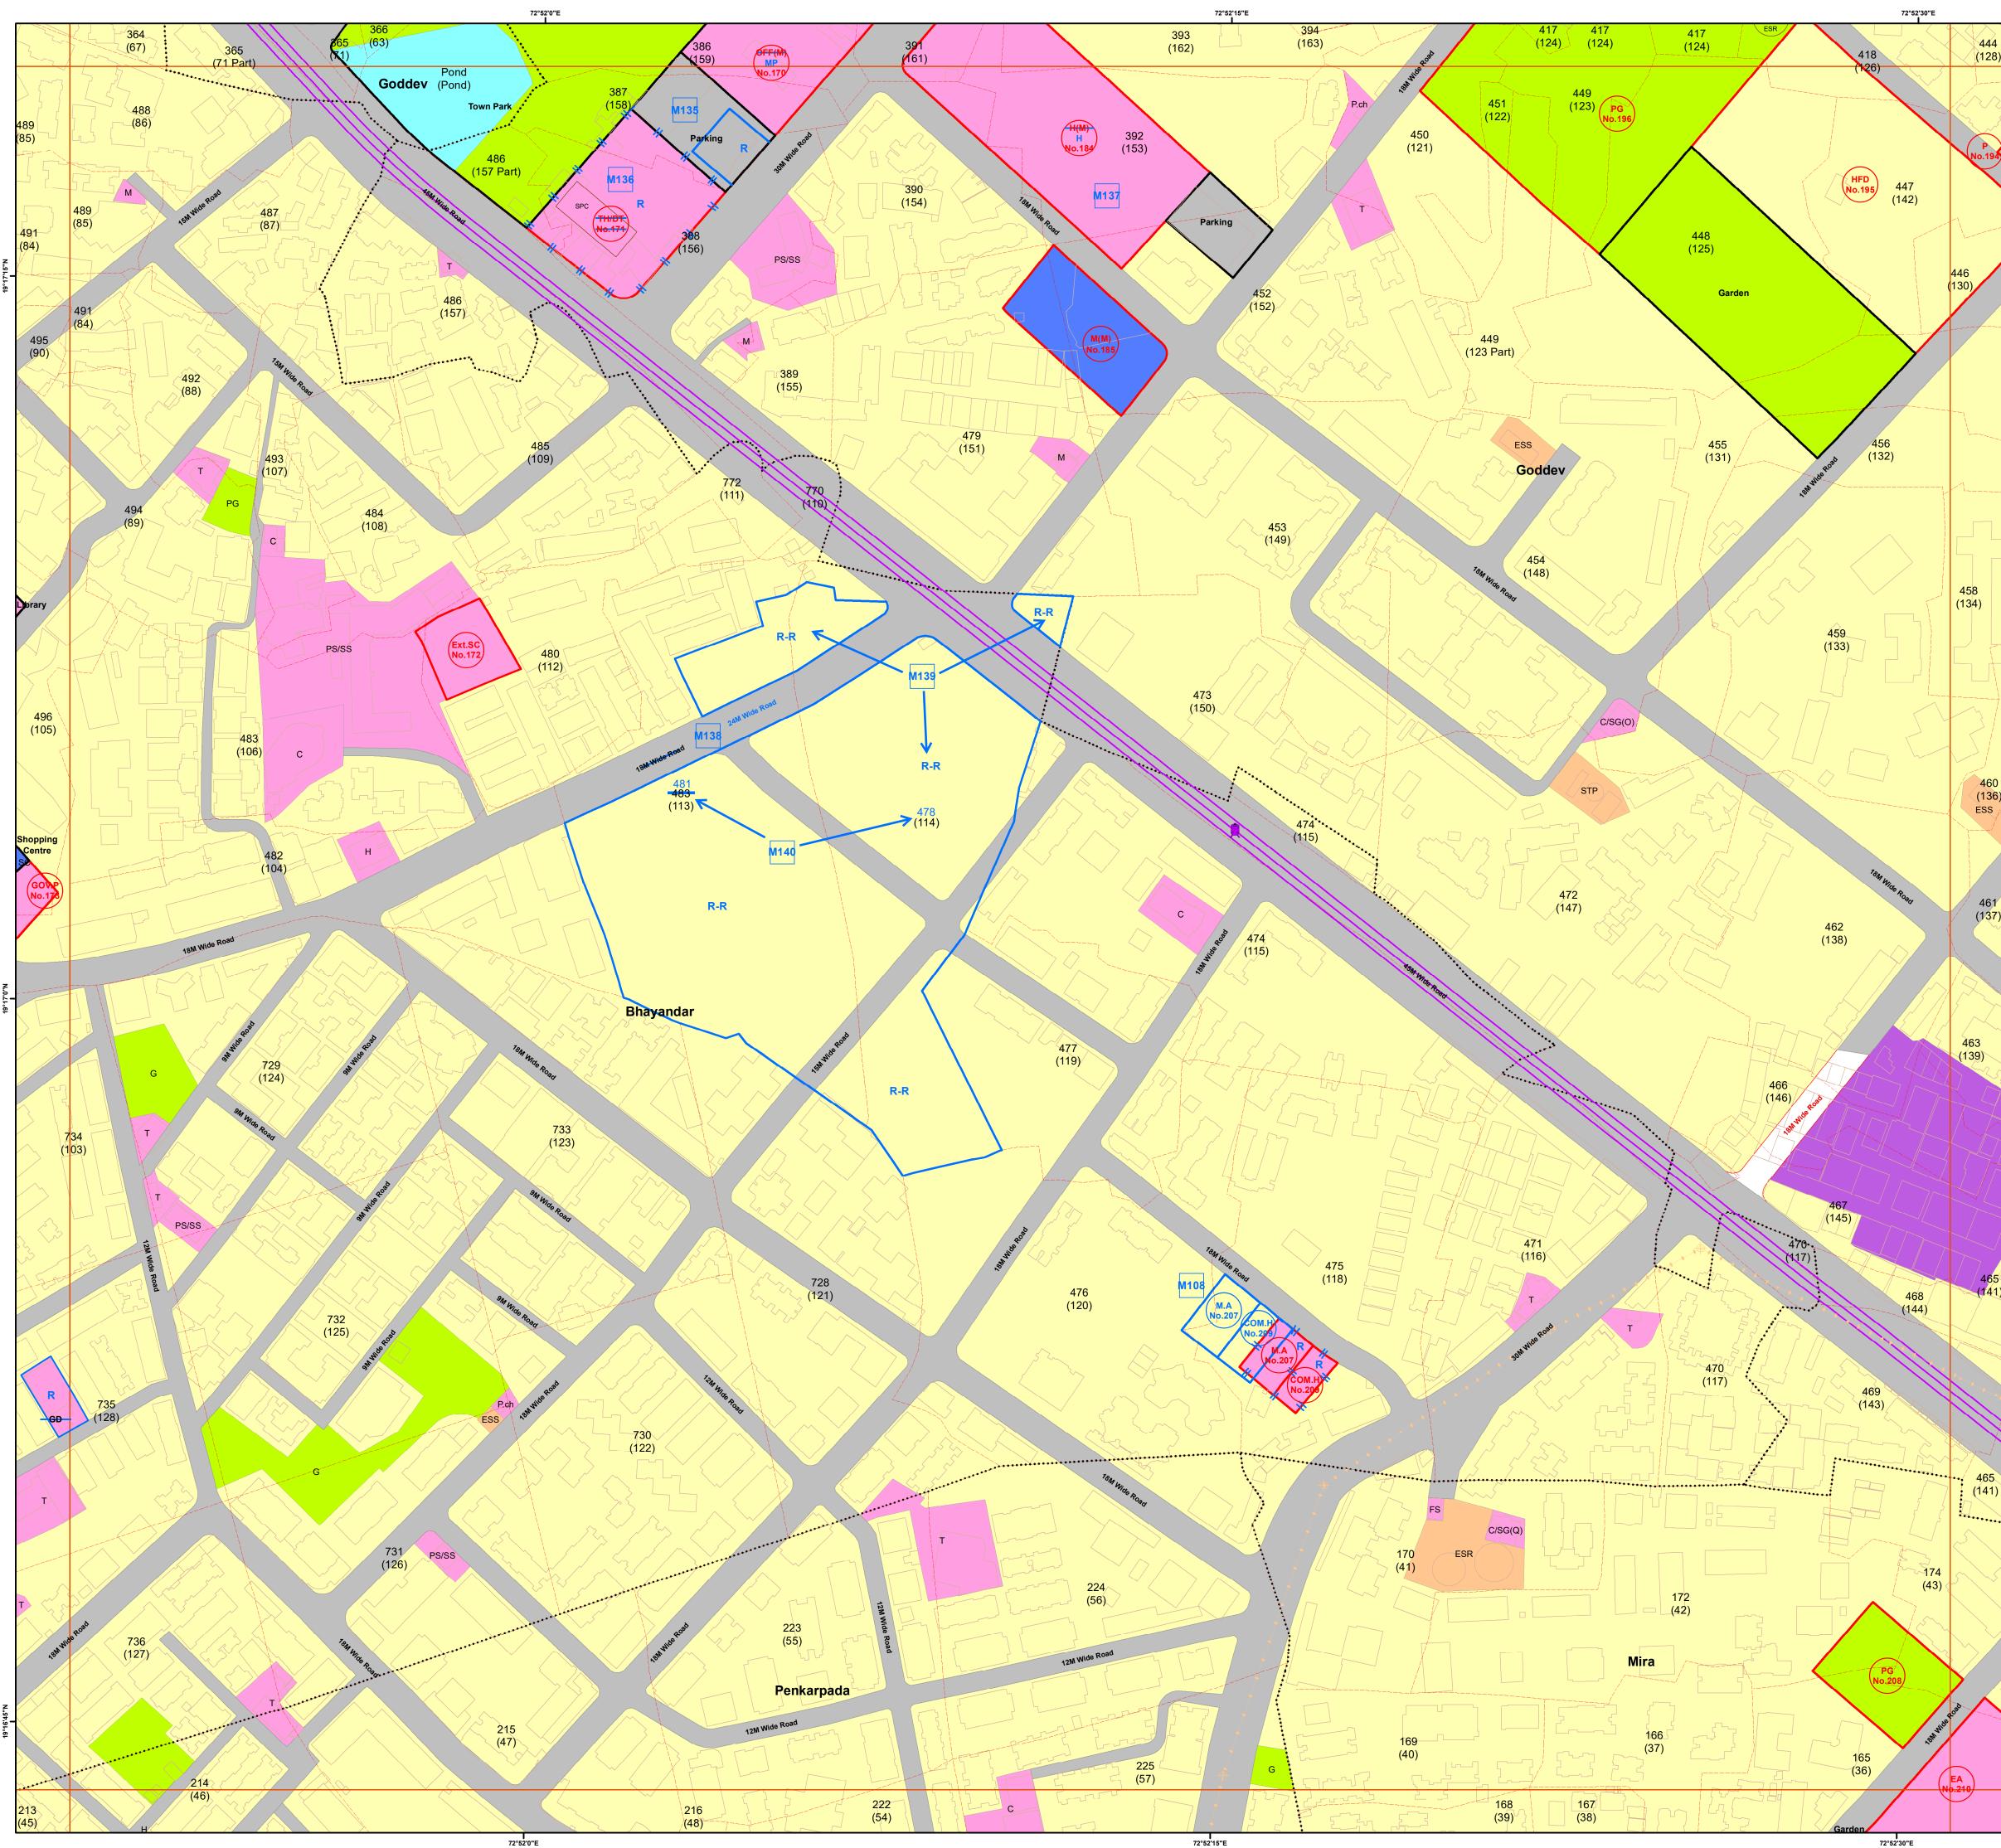

444

(128)

460


ESS


461

(14)

465



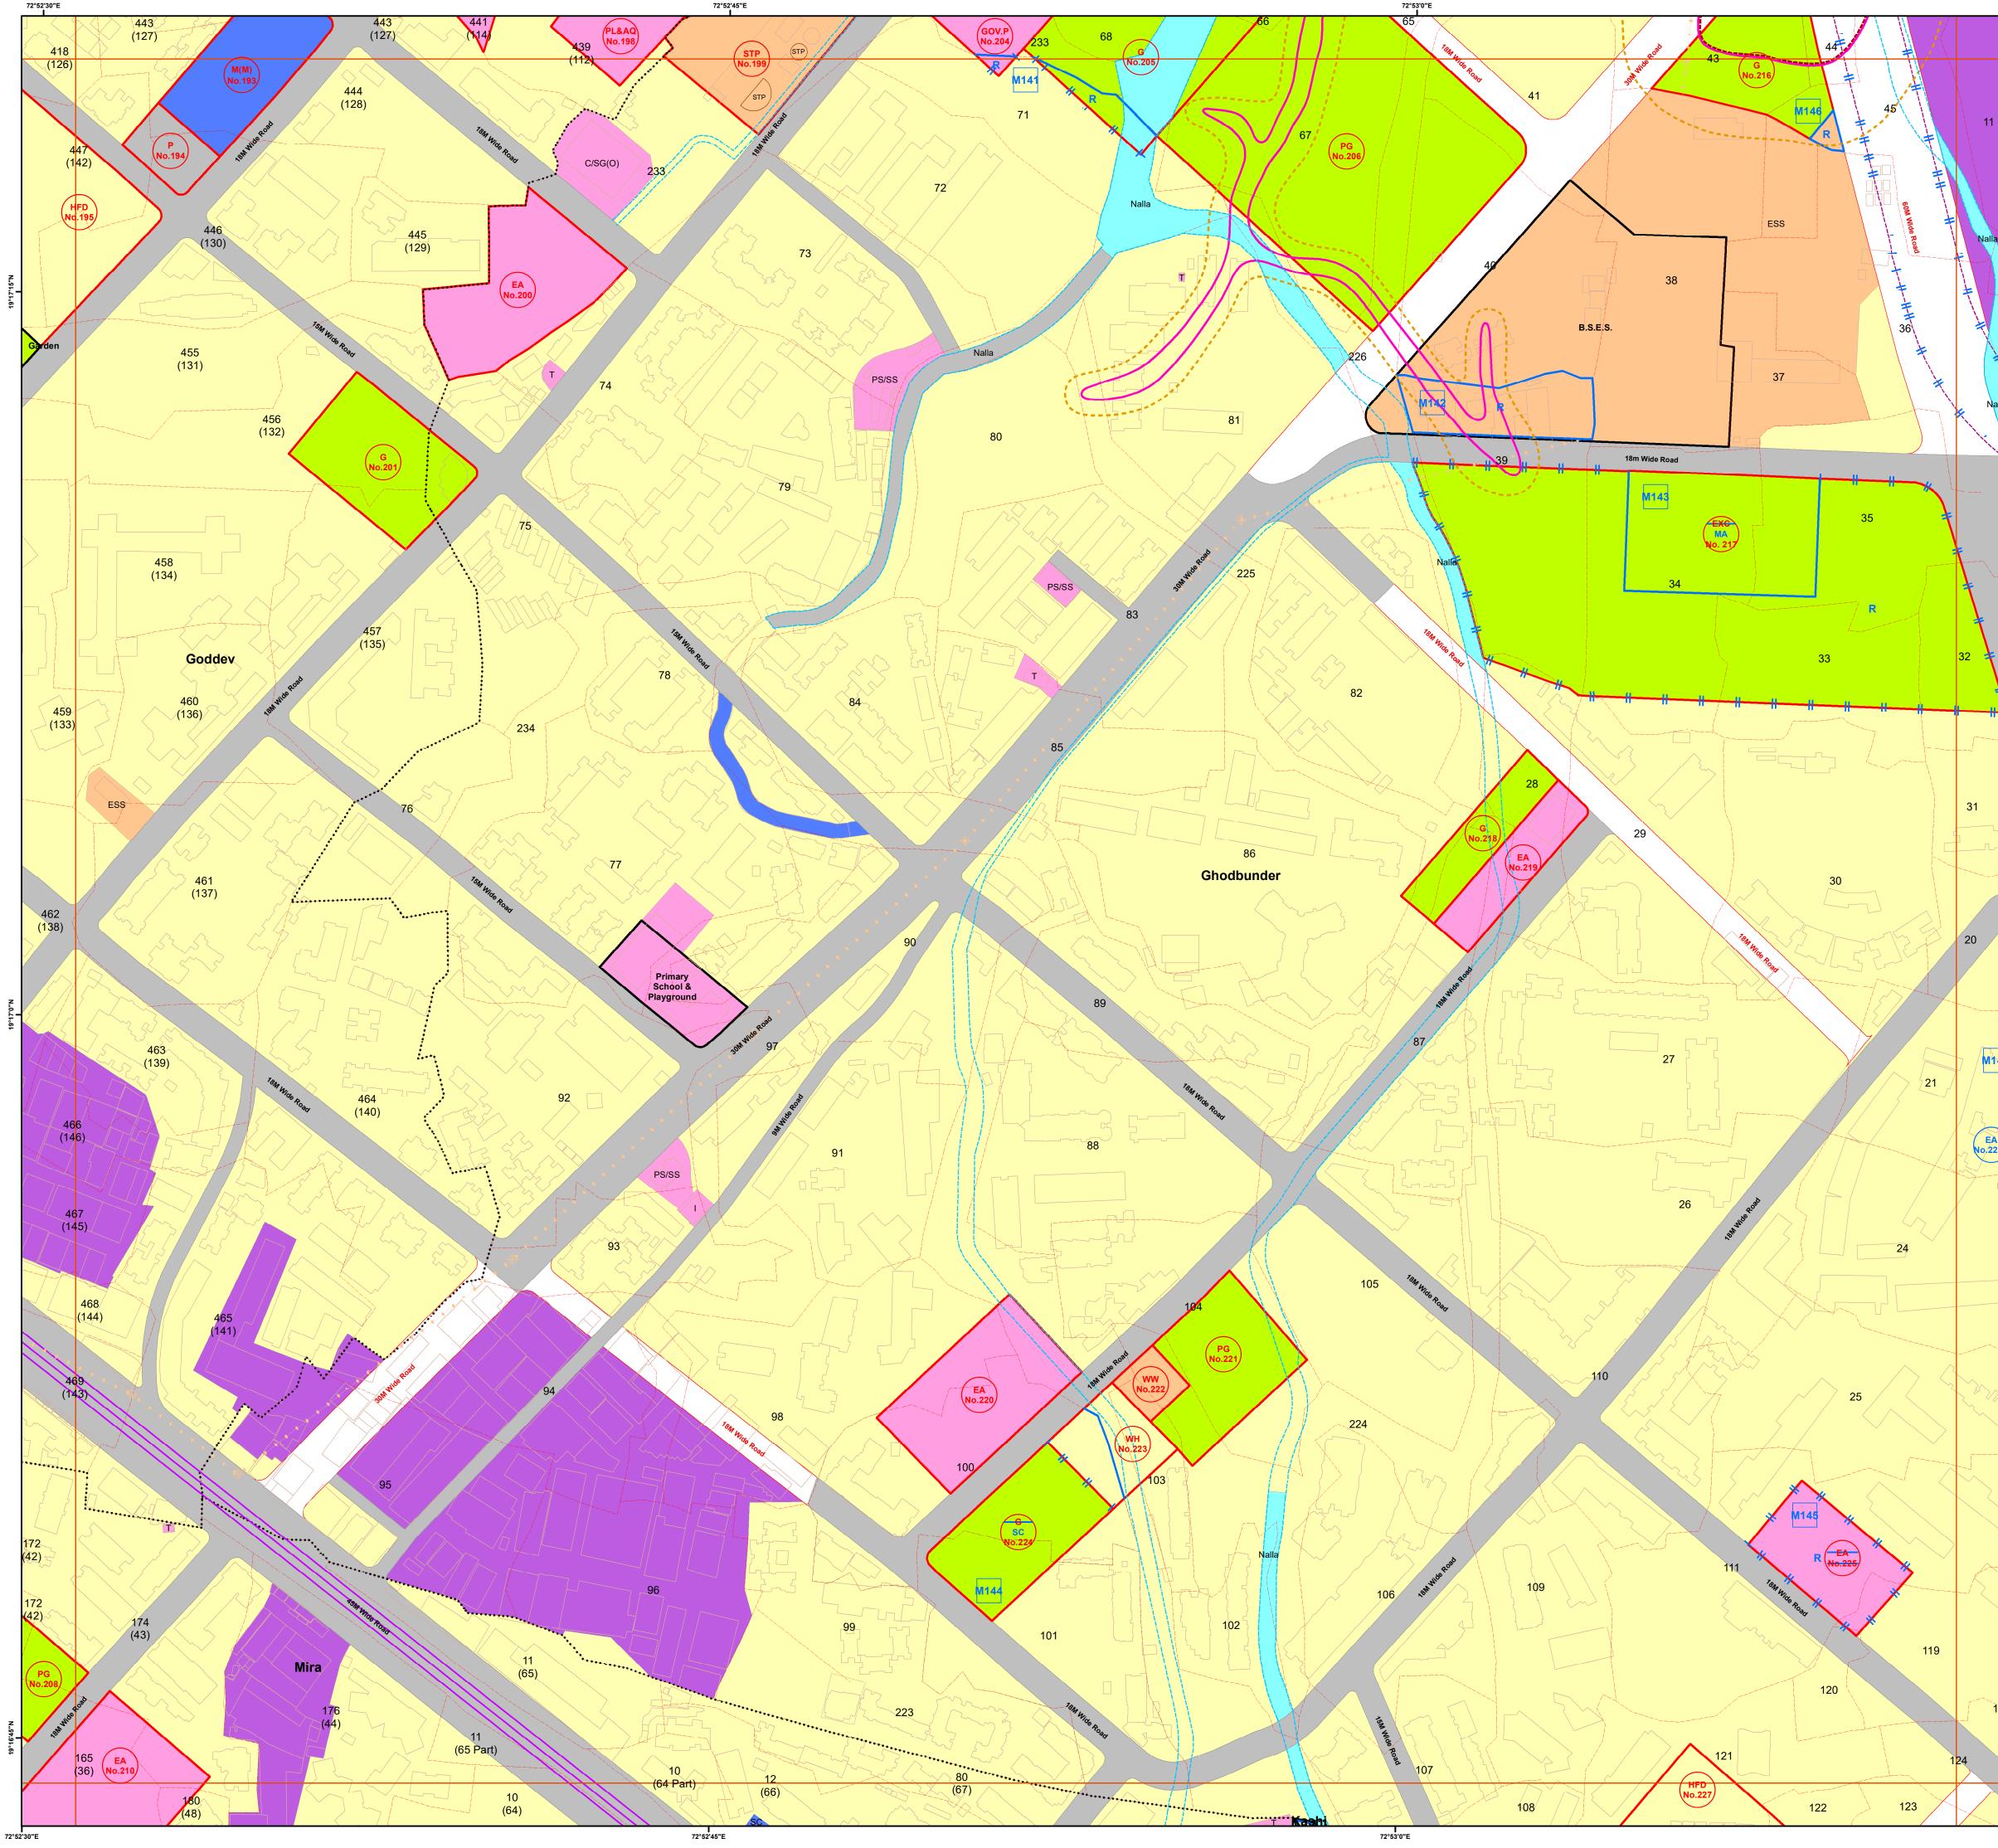

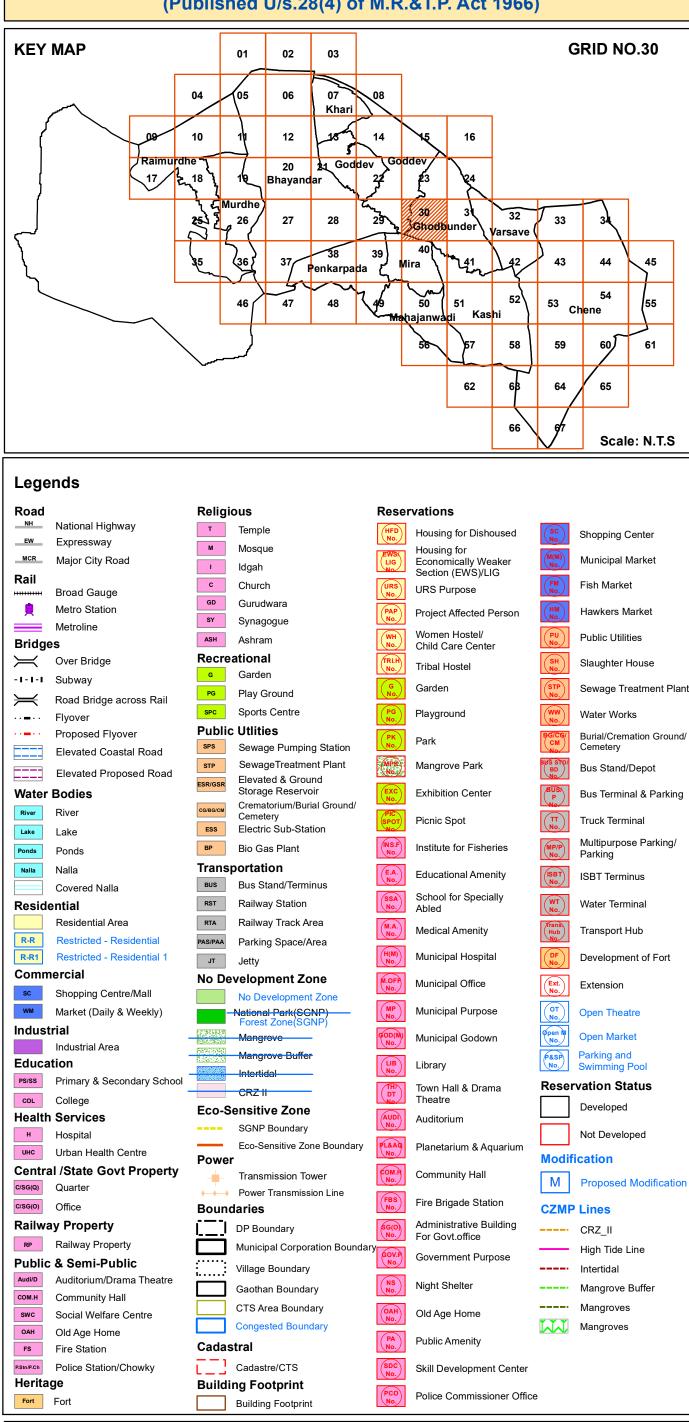

#### Notes

M

1. The Base Map, ELU and Draft PLU prepared by superimposition of data collected from various Government / Semi Government / Departments / Stakeholders and physical features depicted from Drone / Satellite Imagery; hence, the discrepancies may occur.

2. Proposed Land-use Shall prevail irrespective of property number / boundary shown on map which shall be subject to confirmation from Land Record or competent Authority.

3. The structure on the map does not confirm authorization unless verified and rectified by Planning Authority. 4.SGNP, CRZ, Mangroves with their buffers shown on the plan shall be as per the relevant status. In case of any modifications to such status in future, such boundary and buffer shall automatically stand modified as per the latest notification. 5. The alignment of Metro, <del>Coastal</del> Elevated Road marked on plan are indicative & automatically stand modified by the notification issued by Government from time to time. 6. The alignment of nallah / river / creek is indicative and as per the feature extracted from Drone Imagery and data collected.

7. The boundaries of all the designated sites, Government property are shown as per the image captured by superimposition on cadastral map. This may be subject to change as per the actual acquisition in future. 8. This plan is to be read with UDCPR-2022 and Draft DP Report.

9.Existing road shall have status of the road according to width of road even though not shown in development plan. 10.R-R(Restricted-Residential) Residential Zone subject to handing over area to corporation as per permission/Government orders.

11.R-R1 (Restricted- Residential1) All provision of Residential Zone in UDCPR-2020 will be applicable for this zone subject to 10% of area under Development should be kept for Amenity Space as per direction of Municipal Commissioner with prior permission from Eco-Sensitive Zone Commitee.


12.If the location of Metro Carshed and Metro Line is shifted by MMRDA or Elevated Road is shifted in future, the land leased by such shifting shall stands included in adjoining Zone shown on Development Plan.


Scale				North N
0	0.05	0.1	0.2 km	WEE
		1:2,000		S
- ALE	मुल्यनिधरिष			·





Officer Appointed U/s 21(4A) Draft Revised Development Plan of Mira Bhayandar

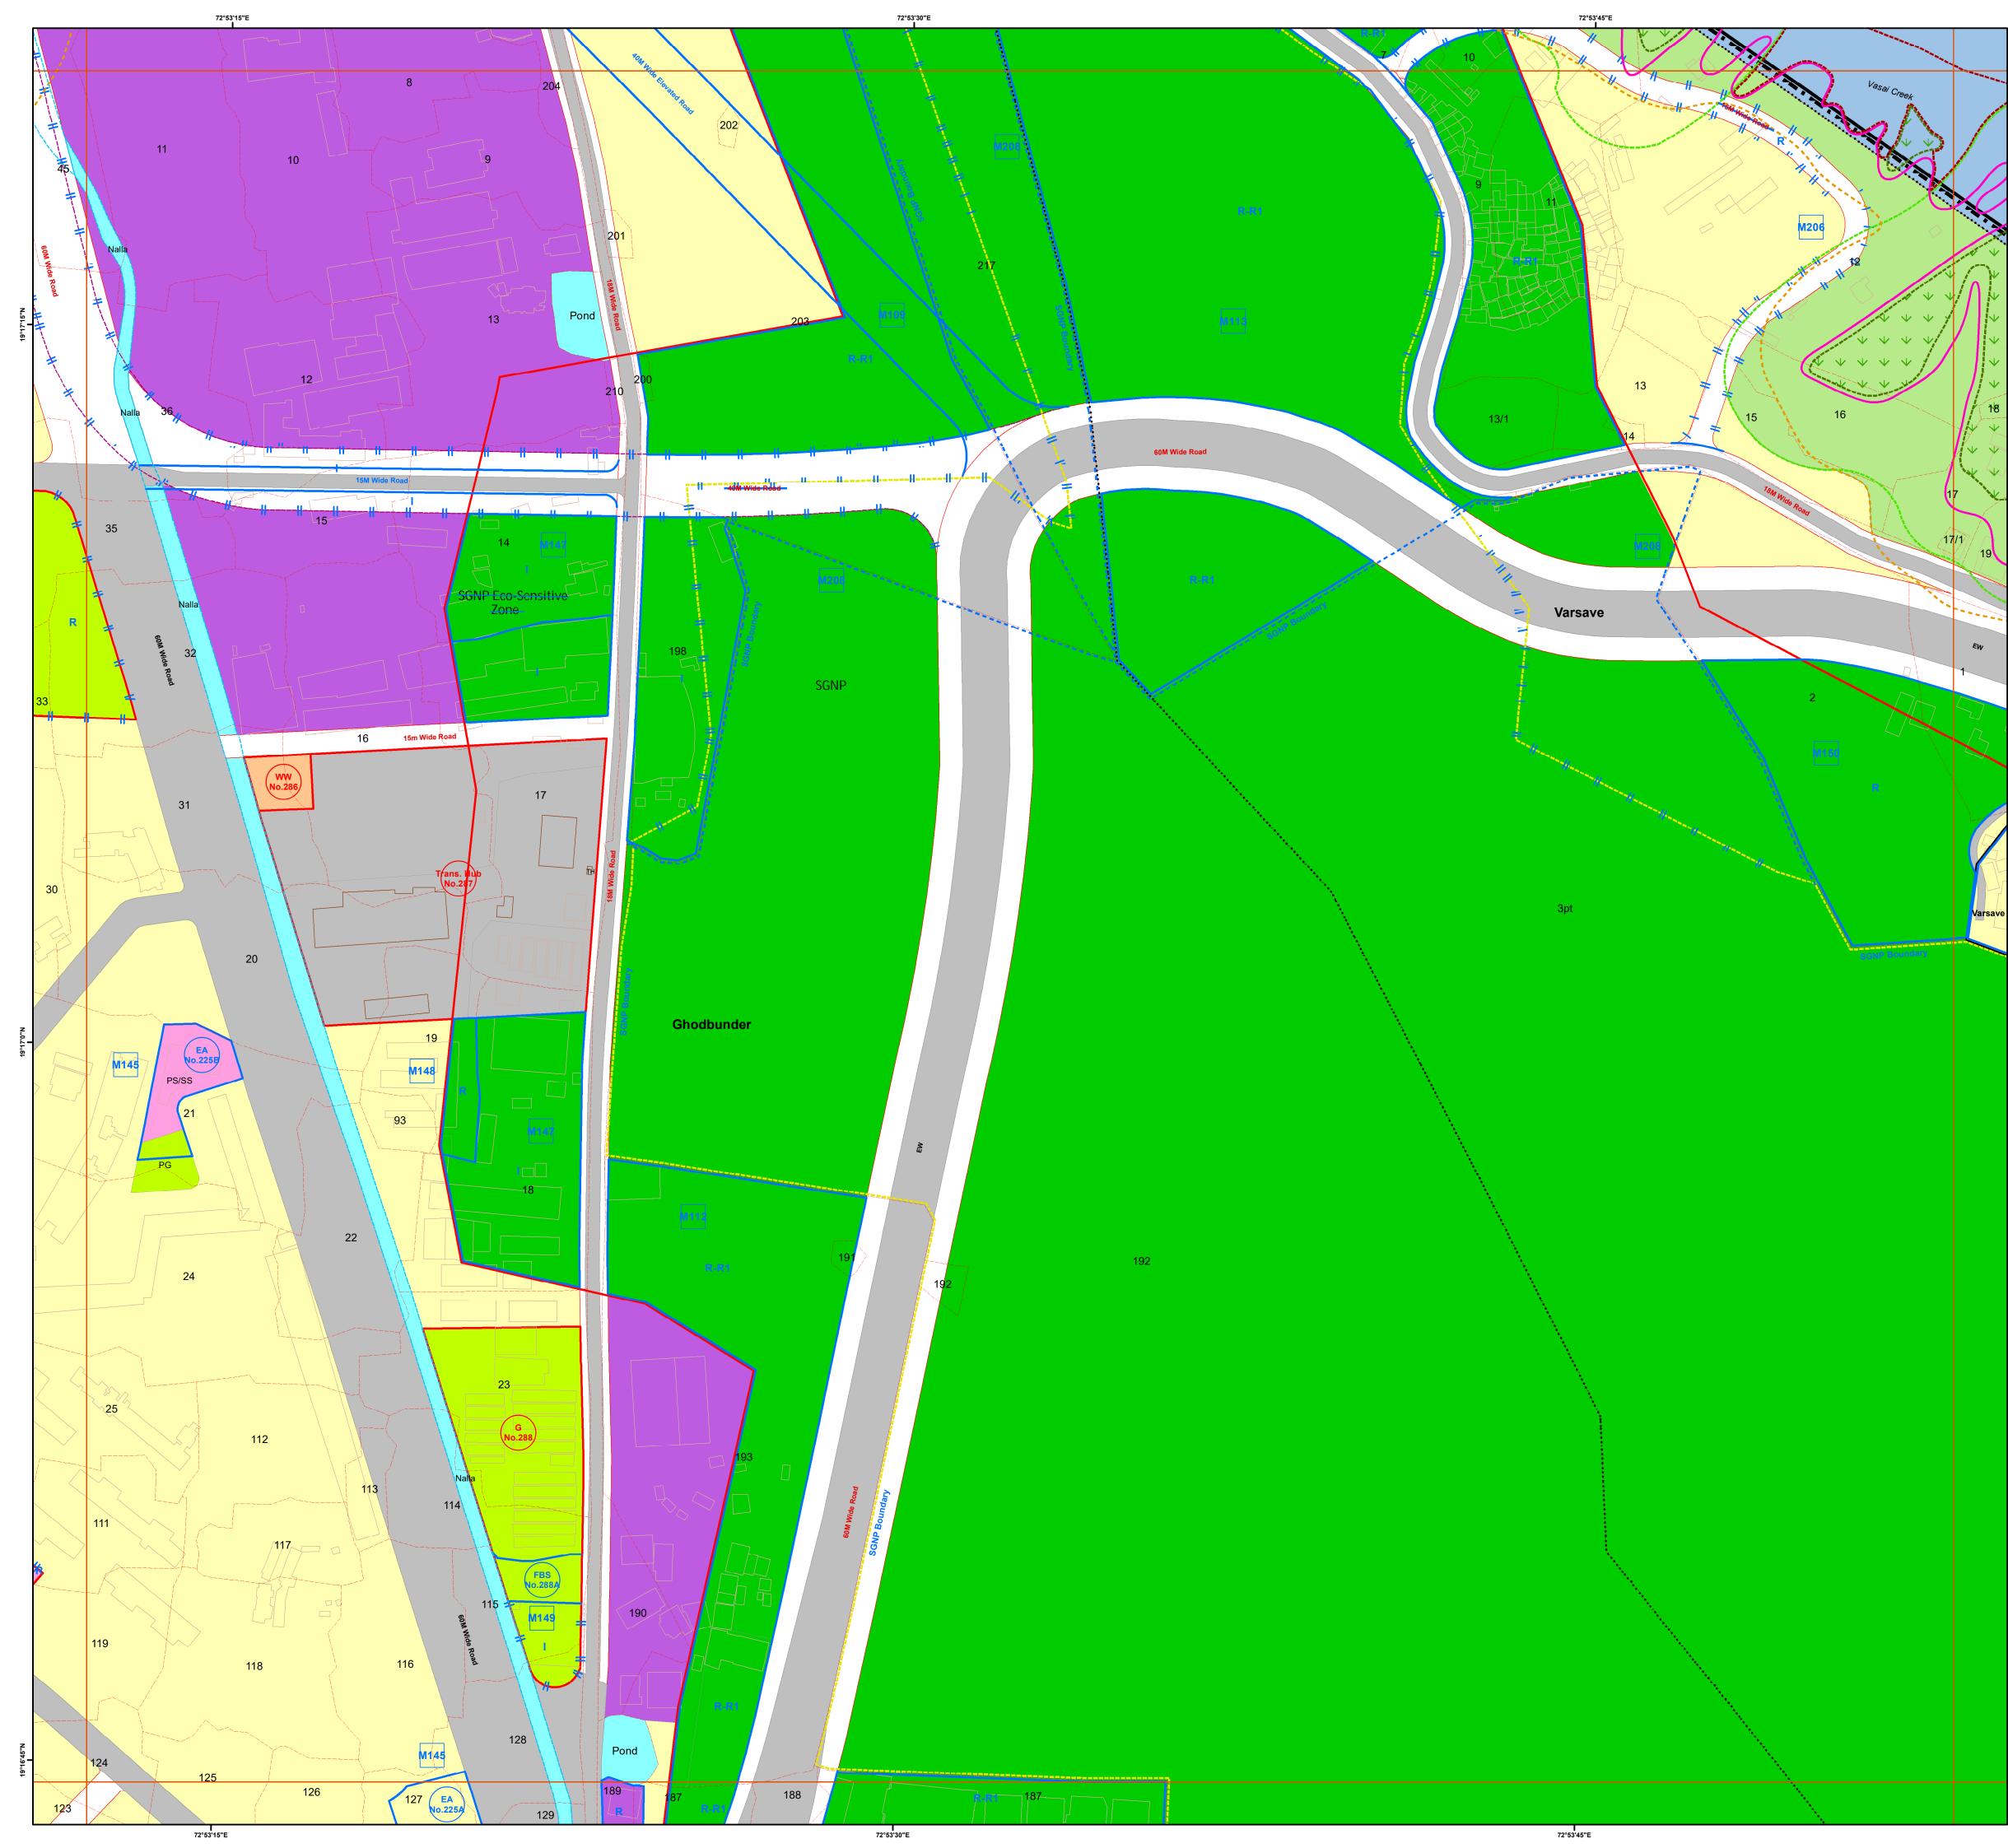

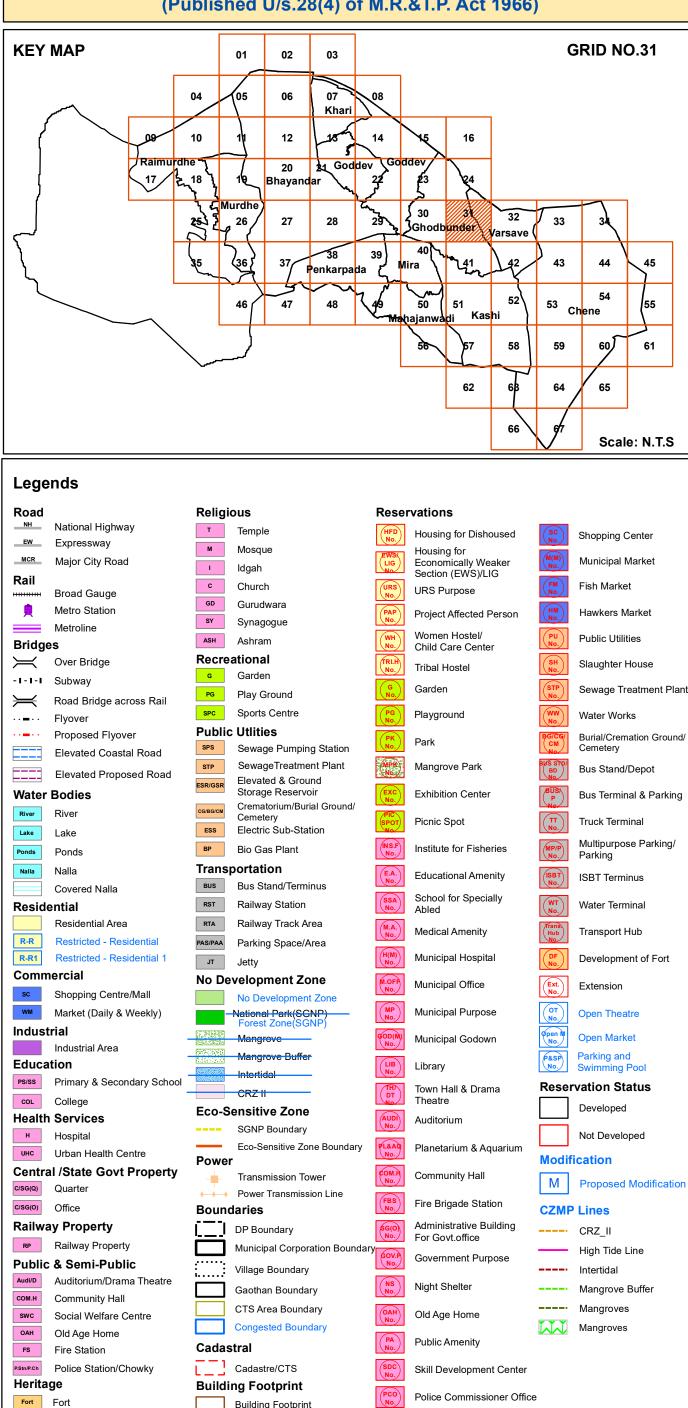

#### Notes

1. The Base Map, ELU and Draft PLU prepared by superimposition of data collected from various Government / Semi Government / Departments / Stakeholders and physical features depicted from Drone / Satellite Imagery; hence, the discrepancies may occur.

Building Footprint

2.Proposed Land-use Shall prevail irrespective of property number / boundary shown on map which shall be subject to confirmation from Land Record or competent Authority.

3.The structure on the map does not confirm authorization unless verified and rectified by Planning Authority. 4.SGNP, CRZ, Mangroves with their buffers shown on the plan shall be as per the relevant status. In case of any modifications to such status in future, such boundary and buffer shall automatically stand modified as per the latest notification. 5. The alignment of Metro, <del>Coastal</del> Elevated Road marked on plan are indicative & automatically stand modified by the notification issued by Government from time to time.

6. The alignment of nallah / river / creek is indicative and as per the feature extracted from Drone Imagery and data collected. 7. The boundaries of all the designated sites, Government property are shown as per the image captured by superimposition on cadastral map. This may be subject to change as per the actual acquisition in future. 8.This plan is to be read with UDCPR-2022 and Draft DP Report.

9. Existing road shall have status of the road according to width of road even though not shown in development plan. 10.R-R(Restricted-Residential) Residential Zone subject to handing over area to corporation as per permission/Government orders.

11.R-R1 (Restricted- Residential1) All provision of Residential Zone in UDCPR-2020 will be applicable for this zone subject to 10% of area under Development should be kept for Amenity Space as per direction of Municipal Commissioner with prior permission from Eco-Sensitive Zone Commitee.


12.If the location of Metro Carshed and Metro Line is shifted by MMRDA or Elevated Road is shifted in future, the land eleased by such shifting shall stands included in adjoining Zone shown on Development Plan.


Scale				North N	
0	0.05	0.1	0.2 km	w	·E
		1:2,000		S	
35101 2	मुल्यनिधर्मरुष				





Officer Appointed U/s 21(4A) Draft Revised Development Plan of Mira Bhayandar

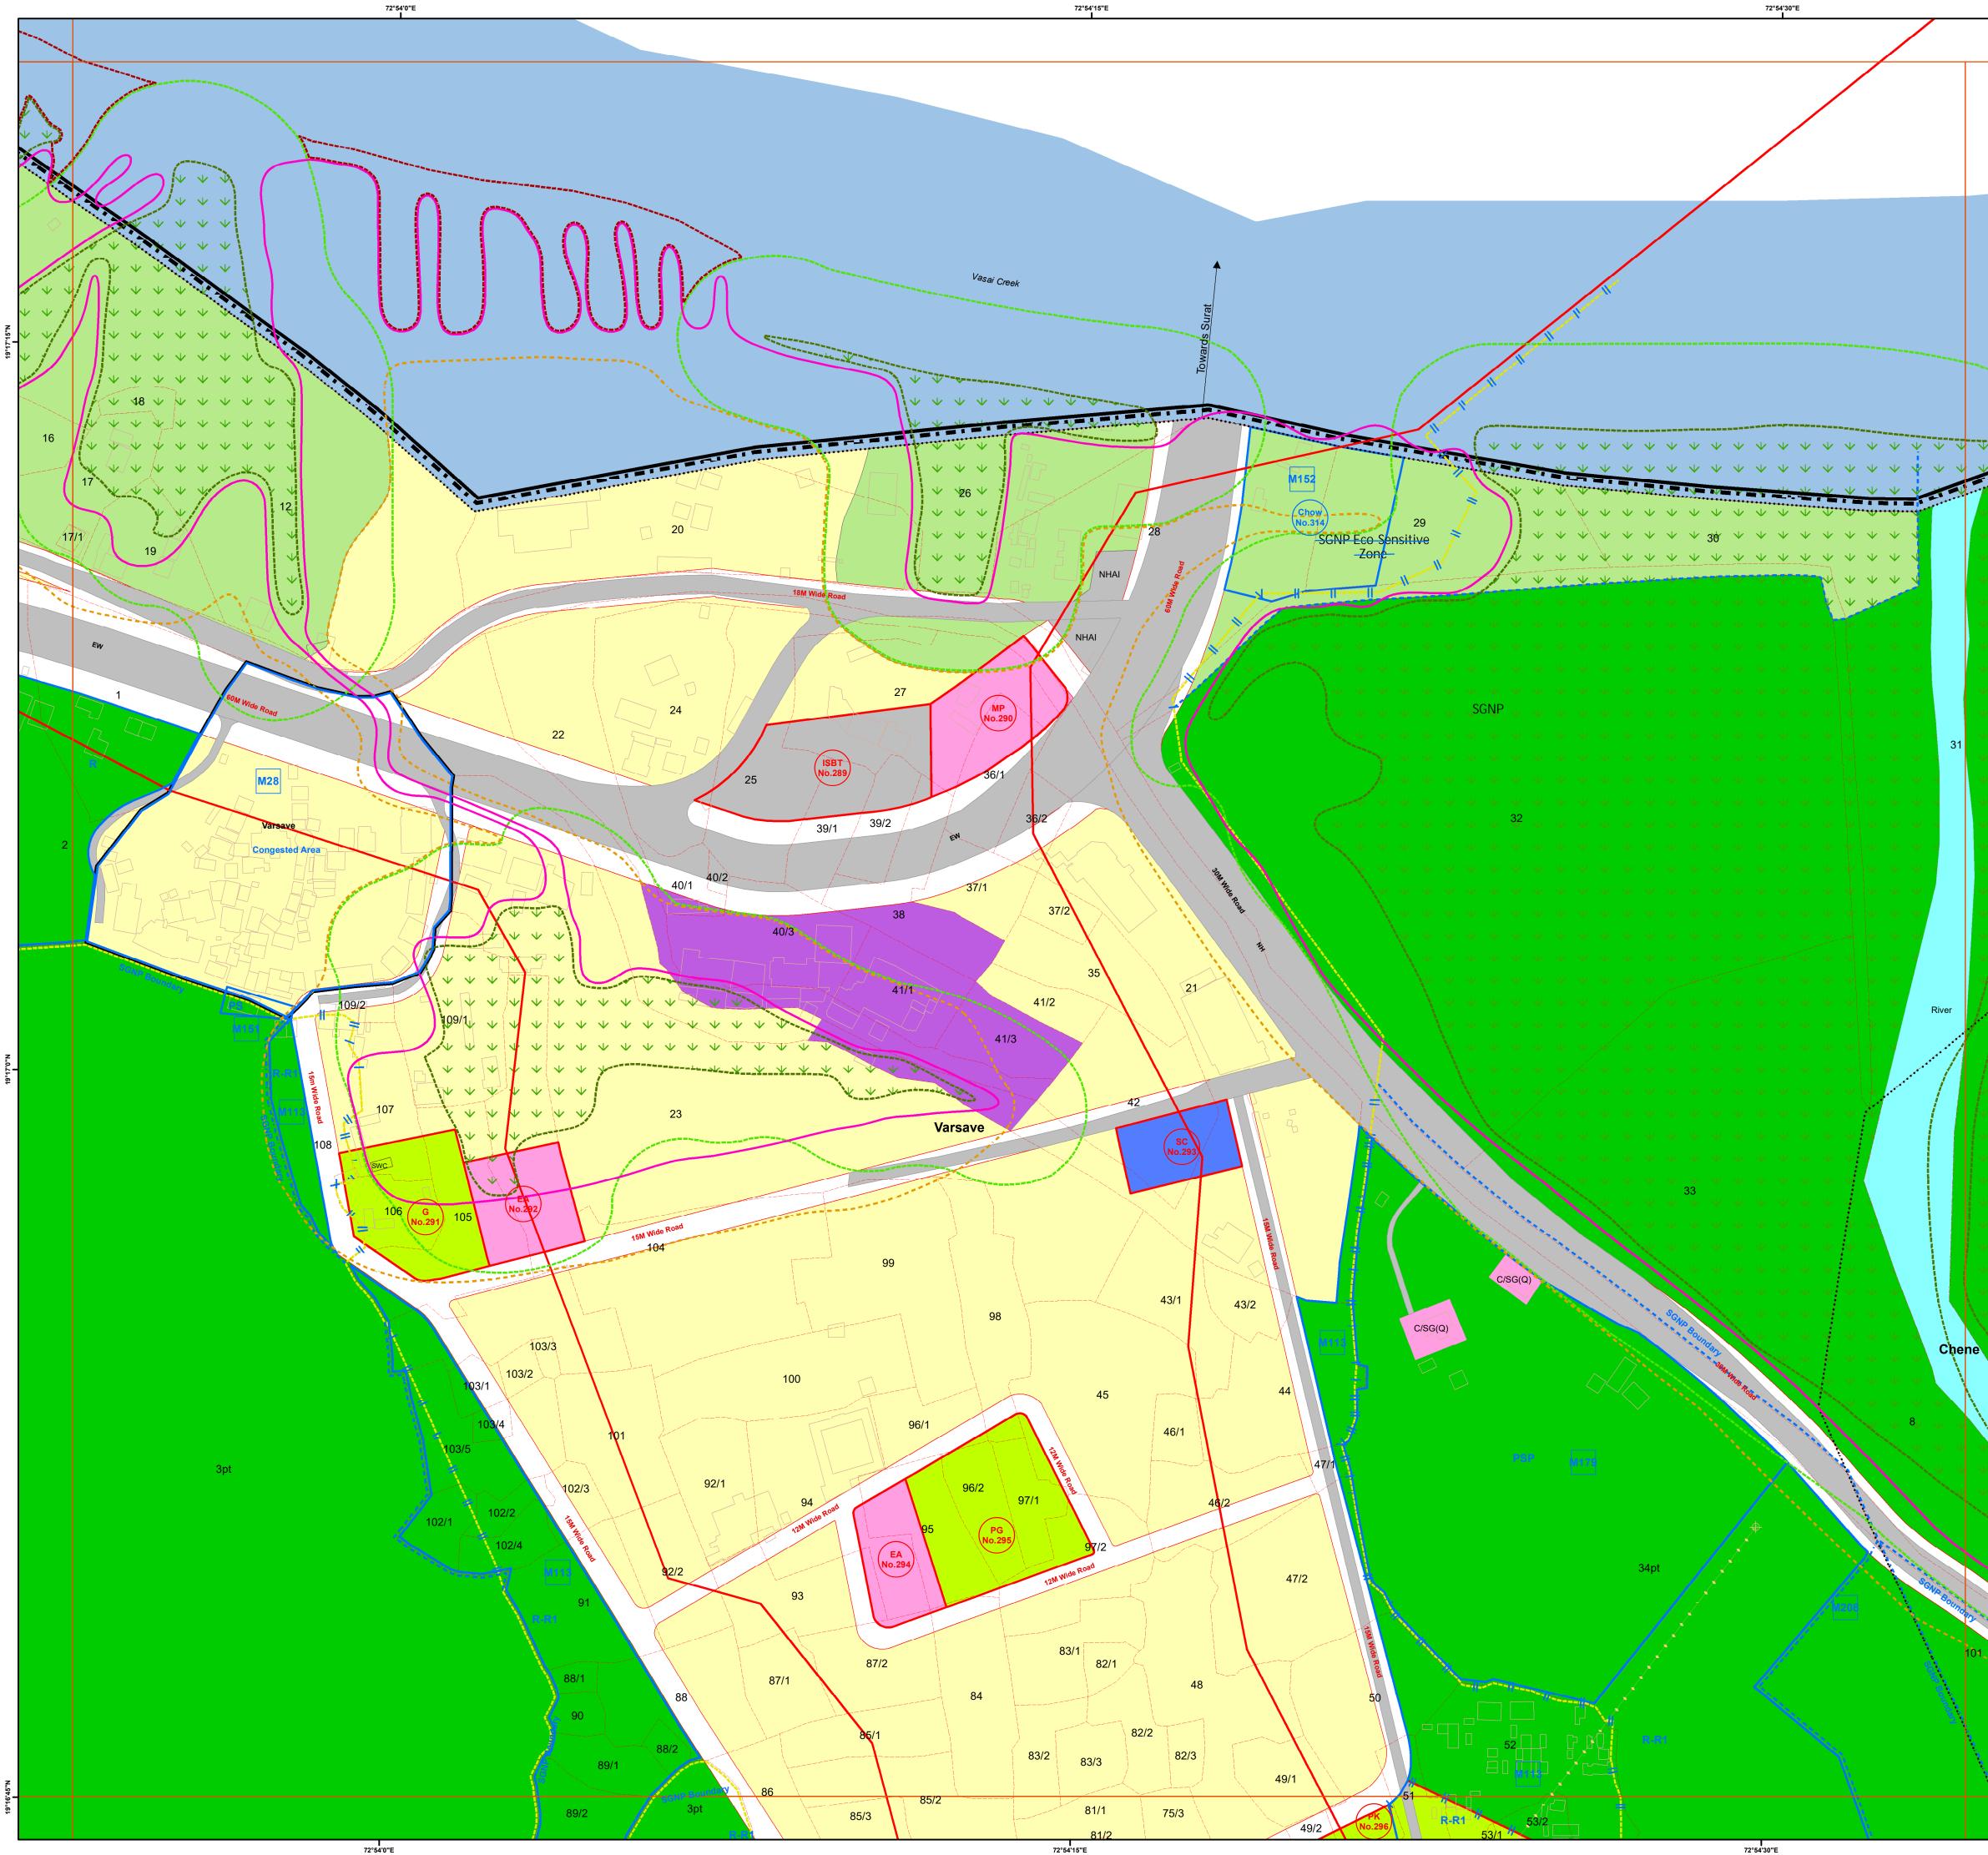

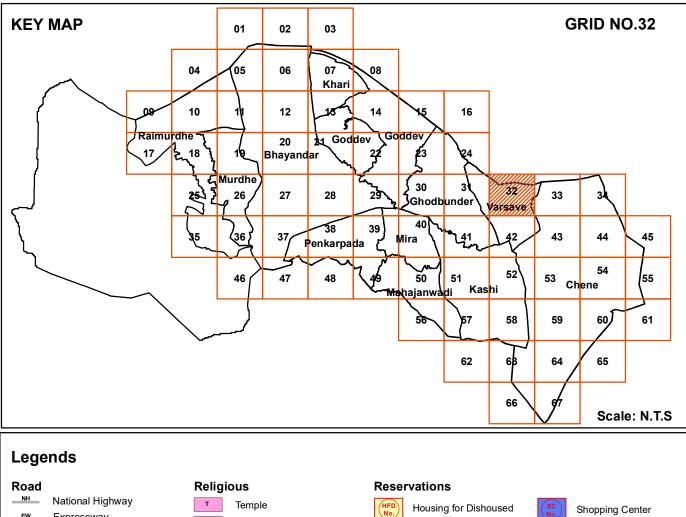

Road		Religi	ous	Rese	rvations		
NH	National Highway	Т	Temple	HFD No.	Housing for Dishoused	SC No.	Shopping Center
EW	Expressway	м	Mosque	EWS	Housing for		Munisia - Manlas
	Major City Road	I	ldgah		Economically Weaker Section (EWS)/LIG	(M(M) No.	Municipal Market
Rail	Broad Gauge	с	Church	URS No.	URS Purpose	(FM No.	Fish Market
良	Metro Station	GD	Gurudwara	PAP	Project Affected Person	(HM No.)	Hawkers Market
	Metroline	SY	Synagogue	No.	, Women Hostel/		Date in a latitudina
Bridge	es	ASH	Ashram	(WH No.	Child Care Center	(PU No.	Public Utilities
$ \succ$	Over Bridge		ational Garden	TRI.H No.	Tribal Hostel	SH No.	Slaughter House
-1-1-1	Subway	G PG		G No.	Garden	STP	Sewage Treatment Plar
$\mid$	Road Bridge across Rail	SPC	Play Ground Sports Centre		Discourse	No.	
•••	Flyover		: Utlities	(PG No.	Playground	No.	Water Works
•••	Proposed Flyover	SPS	Sewage Pumping Station	PK No.	Park	BG/CG/ CM	Burial/Cremation Ground Cemetery
	Elevated Coastal Road	STP	SewageTreatment Plant	MPR No.	Mangrove Park	BIS STD/ BD No	Bus Stand/Depot
	Elevated Proposed Road	ESR/GSR	Elevated & Ground				Dus Stand/Depot
Water	Bodies		Storage Reservoir Crematorium/Burial Ground/	(EXC No.	Exhibition Center	(BUS) P	Bus Terminal & Parking
River	River	CG/BG/CM	Cemetery	PIC SPOT	Picnic Spot	TT No.	Truck Terminal
Lake	Lake	ESS	Electric Sub-Station				Multipurpose Parking/
Ponds	Ponds	BP	Bio Gas Plant	INS.F No.	Institute for Fisheries	MP/P No.	Parking
Nalla	Nalla		portation	E.A. No.	Educational Amenity		ISBT Terminus
	Covered Nalla	BUS	Bus Stand/Terminus	SSA	School for Specially	WT	···· - · ·
Resid		RST	Railway Station	No.	Abled	No.	Water Terminal
R-R	Residential Area	RTA	Railway Track Area	(M.A. No.	Medical Amenity	Trans. Hub No	Transport Hub
R-R1	Restricted - Residential Restricted - Residential 1	PAS/PAA	Parking Space/Area	H(M) No.	Municipal Hospital	DF No.	Development of Fort
	nercial		Jetty velopment Zone				Development of Fort
sc	Shopping Centre/Mall		No Development Zone	M.OFF No.	Municipal Office	(Ext. No.	Extension
WM	Market (Daily & Weekly)	-	National Park(SGNP)	MP No.	Municipal Purpose	OT No.	Open Theatre
Indust	rial	1.7.20 <b>7</b> 0	Forest Zone(SGNP)		Municipal Godown	Øpen M No.	Open Market
	Industrial Area	250.00816 2507(3593)	Mangrove Buffer	GOD(M) No.	Municipal Godown	No.	Parking and
Educa		25000335	Intertidal		Library	No.	Swimming Pool
PS/SS	Primary & Secondary School		CRZ II	(TH) DT No	Town Hall & Drama	Rese	rvation Status
COL	College	Eco-S	ensitive Zone		Theatre		Developed
Health	Services		SGNP Boundary	AUDI No.	Auditorium		Not Developed
UHC	Hospital Urban Health Centre		Eco-Sensitive Zone Boundary	PL&AQ	Planetarium & Aquarium		·
	al /State Govt Property	Power			O	Modif	ication
C/SG(Q)	Quarter	-	Transmission Tower Power Transmission Line	COM.H No.	Community Hall	Μ	Proposed Modification
C/SG(O)	Office	Bound		(FBS No.	Fire Brigade Station	CZMF	P Lines
Railwa	ay Property		DP Boundary	SG(O) No.	Administrative Building		CRZ II
RP	Railway Property	ř	Municipal Corporation Boundar	V	For Govt.office		High Tide Line
Public	& Semi-Public		Village Boundary	GOV.P No.	Government Purpose		Intertidal
Audi/D	Auditorium/Drama Theatre	······	0	NS No.	Night Shelter		
СОМ.Н	Community Hall		Gaothan Boundary		right choice		Mangrove Buffer
swc	Social Welfare Centre		CTS Area Boundary	OAH No.	Old Age Home	YYY	Mangroves
OAH	Old Age Home		Congested Boundary	PA No.	Public Amenity		Mangroves
FS	Fire Station	Cadas					
P.Stn/P.Ch	Police Station/Chowky		Cadastre/CTS	(SDC No.	Skill Development Center		
Herita	-	Buildi	ng Footprint	PCO No.	Police Commissioner Offic	е	
Fort	Fort		Building Footprint	NO.			

#### Notes

1. The Base Map, ELU and Draft PLU prepared by superimposition of data collected from various Government / Semi Government / Departments / Stakeholders and physical features depicted from Drone / Satellite Imagery; hence, the discrepancies may occur.

2. Proposed Land-use Shall prevail irrespective of property number / boundary shown on map which shall be subject to confirmation from Land Record or competent Authority.

3. The structure on the map does not confirm authorization unless verified and rectified by Planning Authority. 4.SGNP, CRZ, Mangroves with their buffers shown on the plan shall be as per the relevant status. In case of any modifications to such status in future, such boundary and buffer shall automatically stand modified as per the latest notification. 5. The alignment of Metro, Coastal Elevated Road marked on plan are indicative & automatically stand modified by the notification issued by Government from time to time.

6.The alignment of nallah / river / creek is indicative and as per the feature extracted from Drone Imagery and data collected. 7. The boundaries of all the designated sites, Government property are shown as per the image captured by superimposition on cadastral map. This may be subject to change as per the actual acquisition in future. 8. This plan is to be read with UDCPR-2022 and Draft DP Report.


9.Existing road shall have status of the road according to width of road even though not shown in development plan. 10.R-R(Restricted-Residential) Residential Zone subject to handing over area to corporation as per permission/Government orders.


11.R-R1 (Restricted- Residential1) All provision of Residential Zone in UDCPR-2020 will be applicable for this zone subject to 10% of area under Development should be kept for Amenity Space as per direction of Municipal Commissioner with prior permission from Eco-Sensitive Zone Commitee.

12.If the location of Metro Carshed and Metro Line is shifted by MMRDA or Elevated Road is shifted in future, the land leased by such shifting shall stands included in adjoining Zone shown on Development Plan.

Scale				North N
0	0.05	0.1	0.2 km	WEE
		1:2,000		S
23510	सुल्यनिधर्म् वा विभ		Right	·



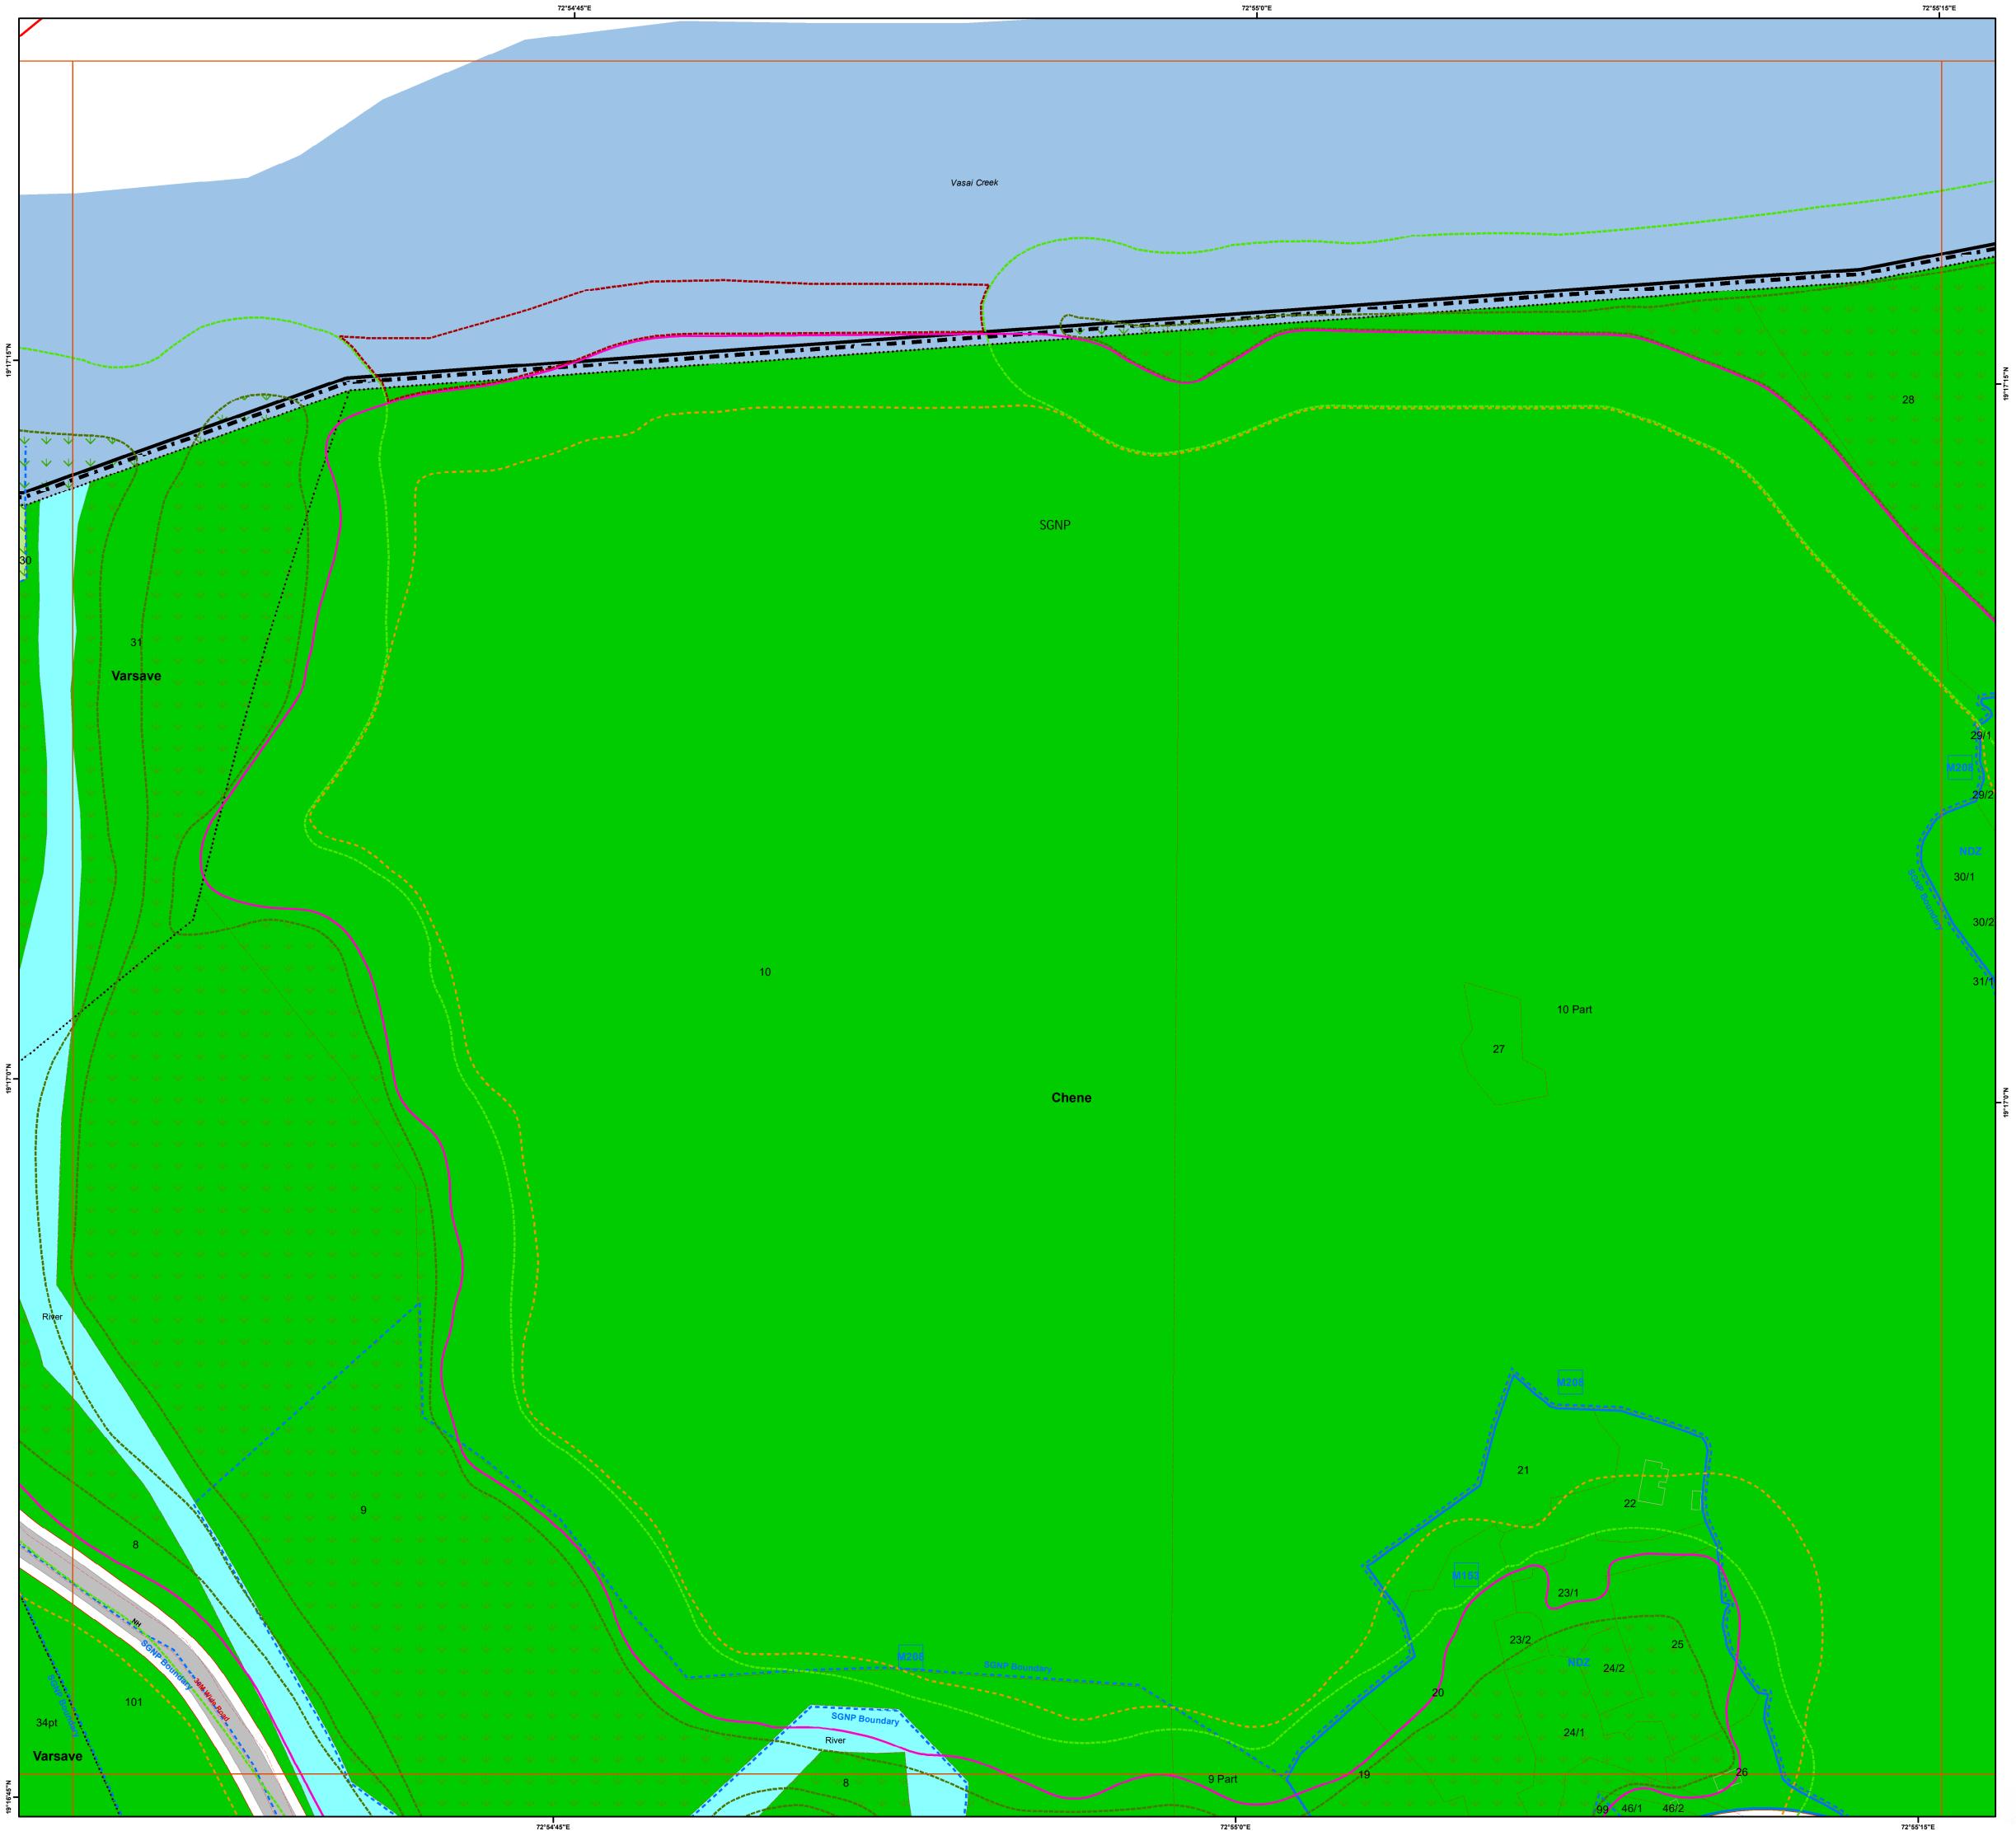

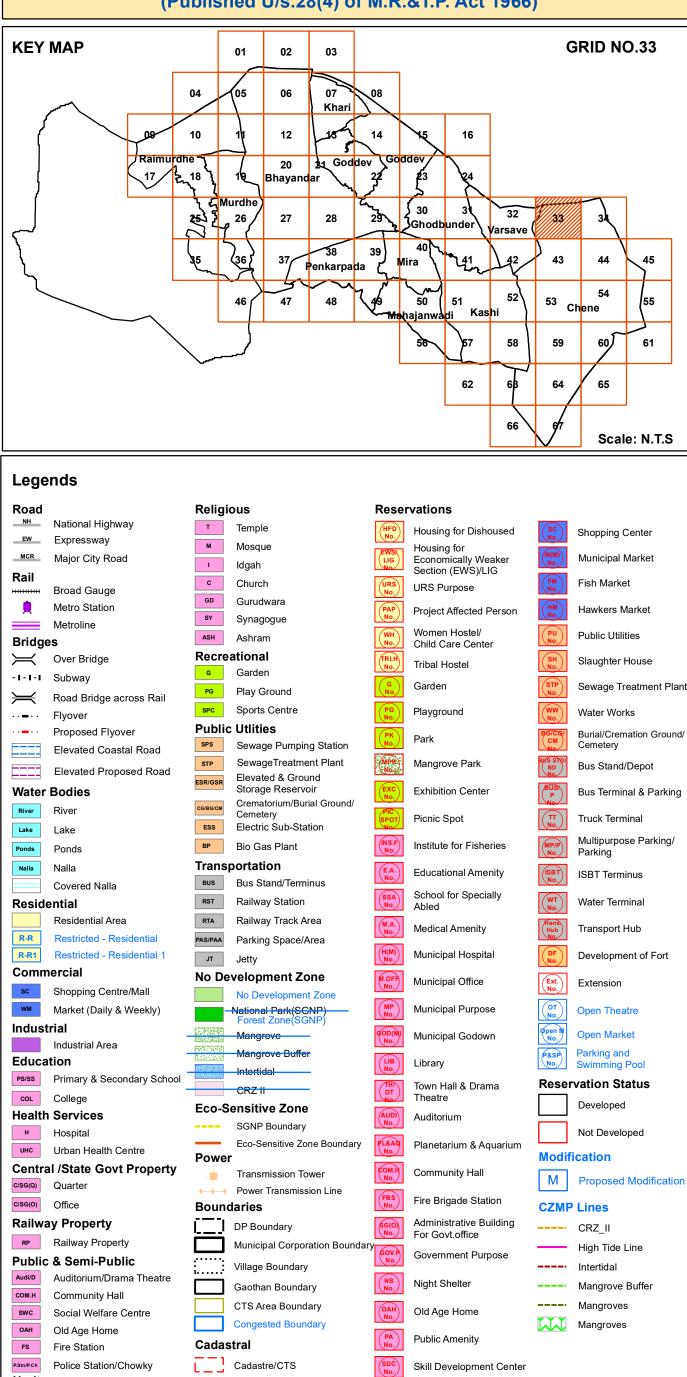

#### Notes

Heritage

Fort Fort

1. The Base Map, ELU and Draft PLU prepared by superimposition of data collected from various Government / Semi Government / Departments / Stakeholders and physical features depicted from Drone / Satellite Imagery; hence, the discrepancies may occur.

Police Commissioner Office

**Building Footprint** 

Building Footprint

2. Proposed Land-use Shall prevail irrespective of property number / boundary shown on map which shall be subject to confirmation from Land Record or competent Authority.

3. The structure on the map does not confirm authorization unless verified and rectified by Planning Authority. 4.SGNP, CRZ, Mangroves with their buffers shown on the plan shall be as per the relevant status. In case of any modifications to such status in future, such boundary and buffer shall automatically stand modified as per the latest notification. 5. The alignment of Metro, <del>Coastal</del> Elevated Road marked on plan are indicative & automatically stand modified by the notification issued by Government from time to time.

6. The alignment of nallah / river / creek is indicative and as per the feature extracted from Drone Imagery and data collected. 7. The boundaries of all the designated sites, Government property are shown as per the image captured by superimposition on cadastral map. This may be subject to change as per the actual acquisition in future.

8.This plan is to be read with UDCPR-2022 and Draft DP Report.

9.Existing road shall have status of the road according to width of road even though not shown in development plan. 10.R-R(Restricted-Residential) Residential Zone subject to handing over area to corporation as per permission/Government orders.

11.R-R1 (Restricted- Residential1) All provision of Residential Zone in UDCPR-2020 will be applicable for this zone subject to 10% of area under Development should be kept for Amenity Space as per direction of Municipal Commissioner with prior permission from Eco-Sensitive Zone Commitee.


12.If the location of Metro Carshed and Metro Line is shifted by MMRDA or Elevated Road is shifted in future, the land leased by such shifting shall stands included in adjoining Zone shown on Development Plan.


Scale				North N
0	0.05	0.1	0.2 km	WEE
		1:2,000		S
31101	मुल्यनिधारिष			





☐ Officer Appointed U/s 21(4A) ► Draft Revised Development Plan of Mira Bhayandar

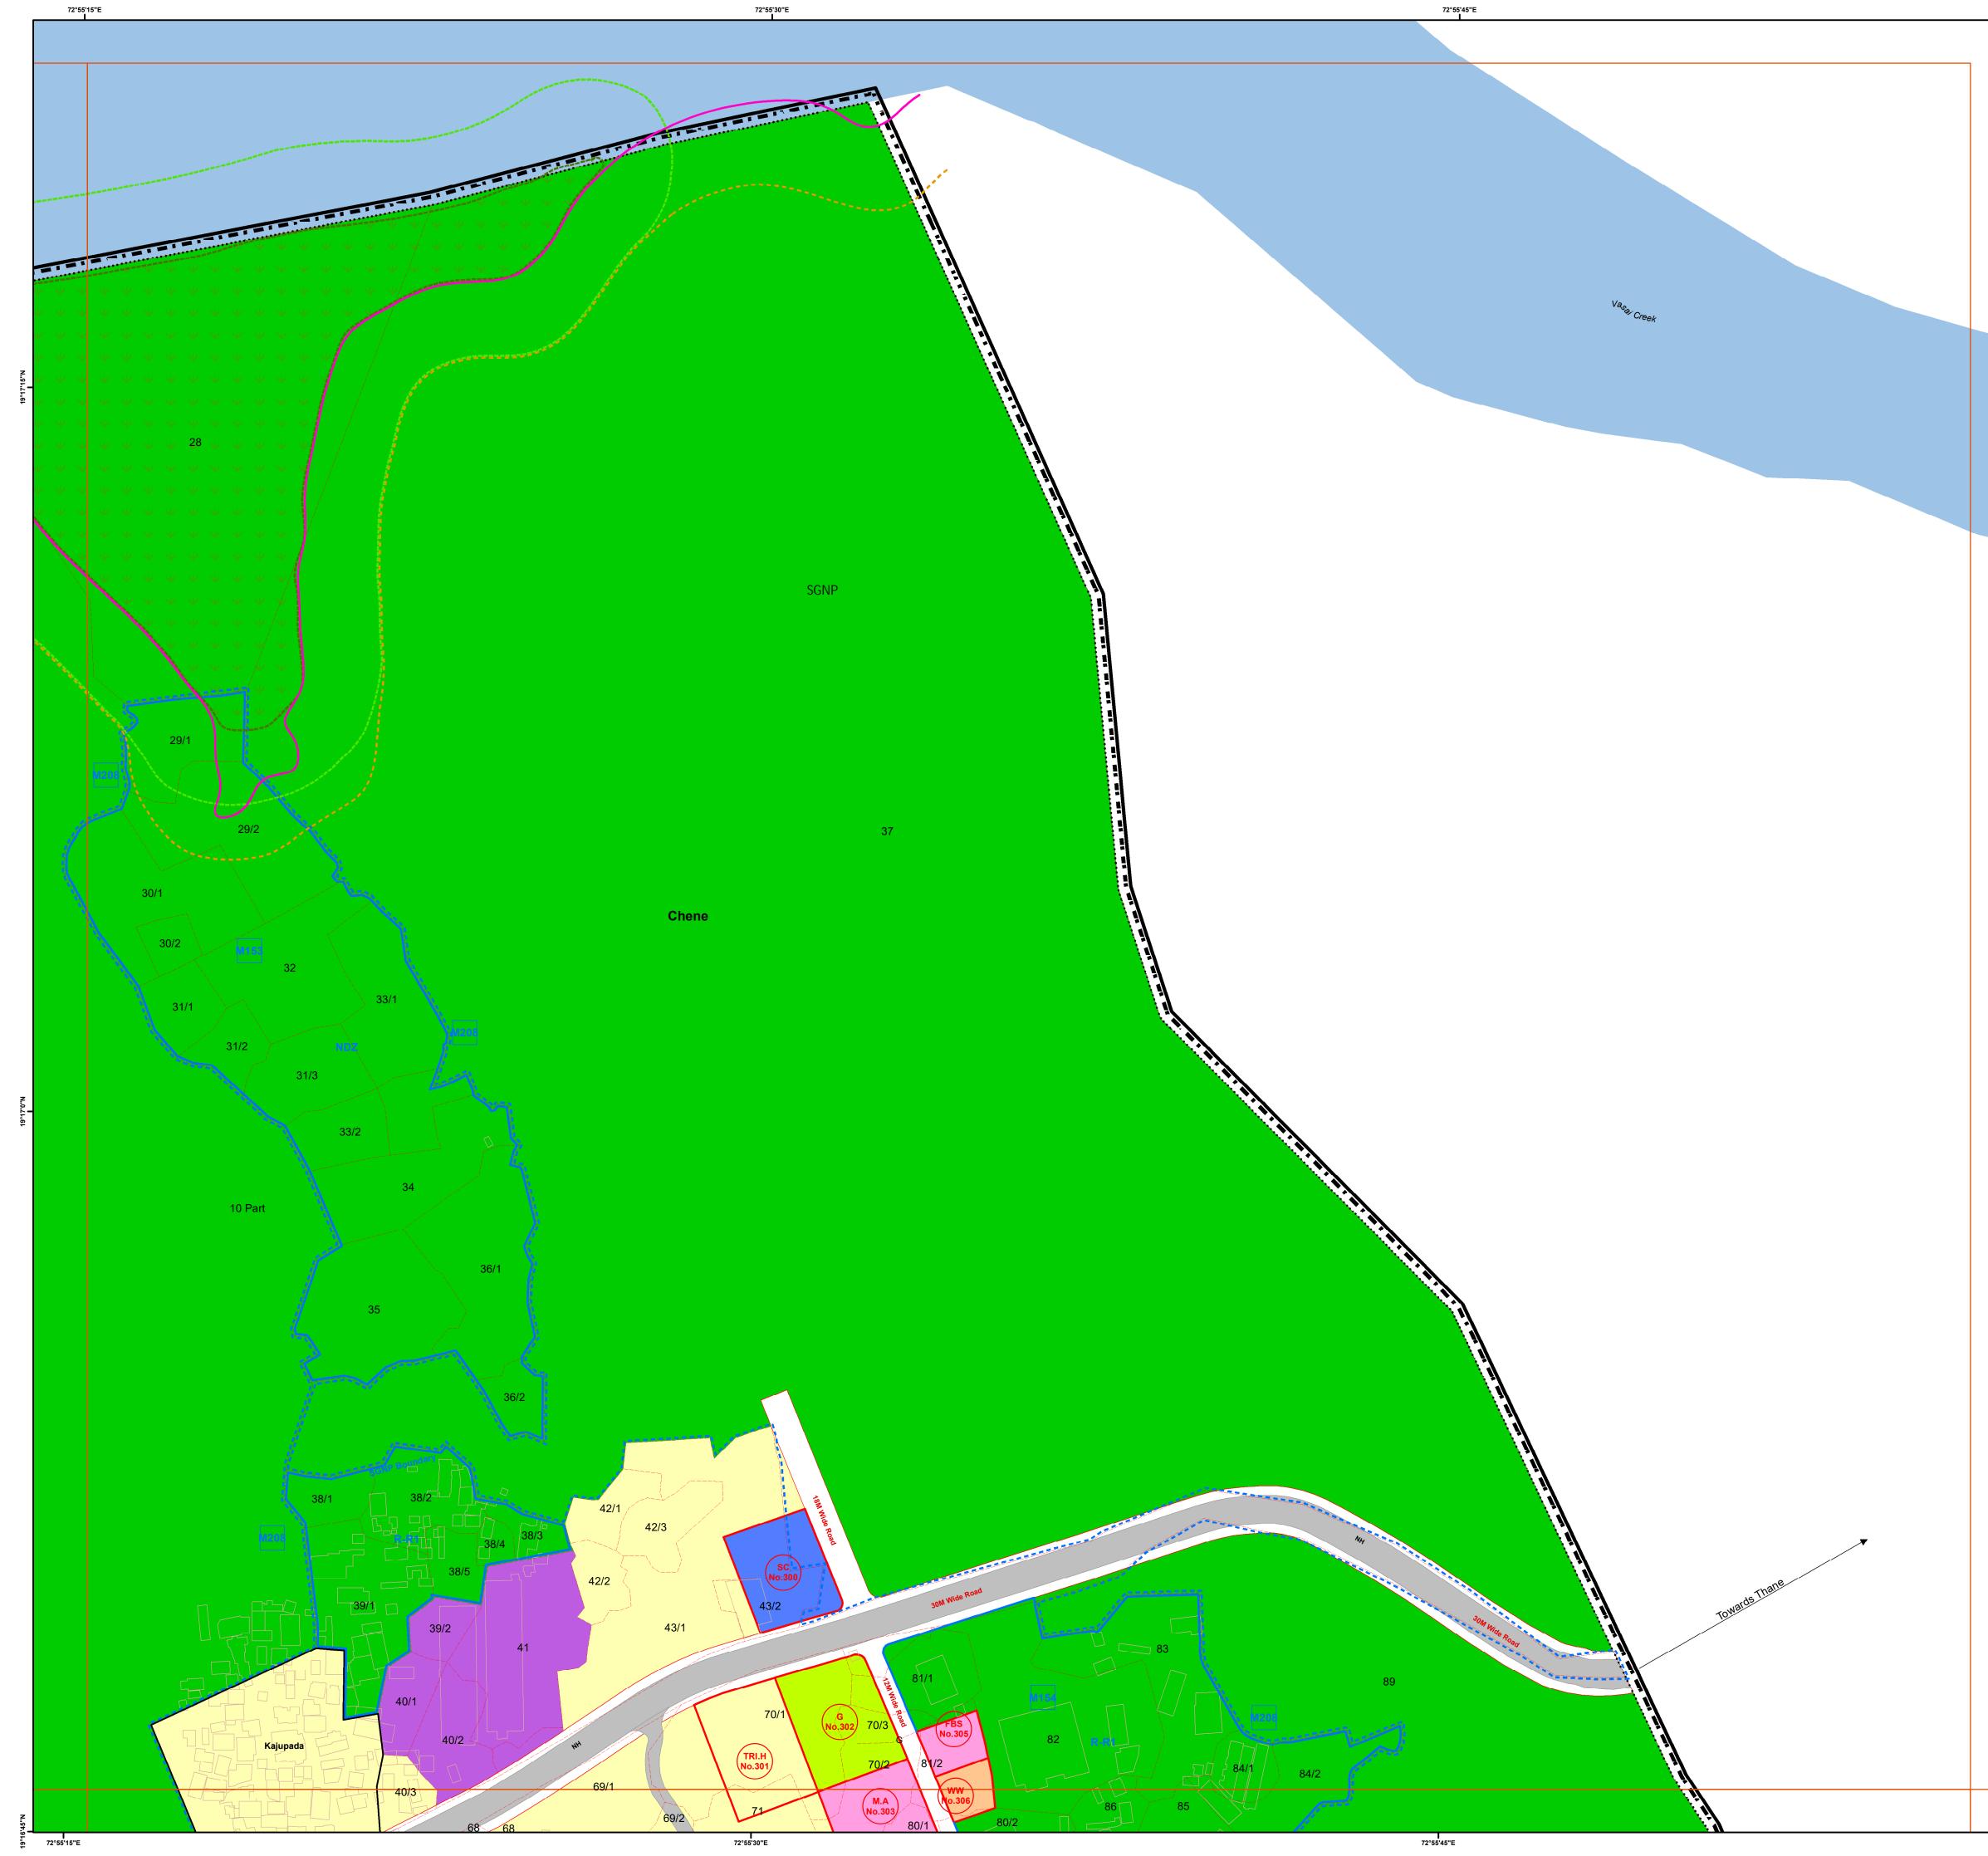

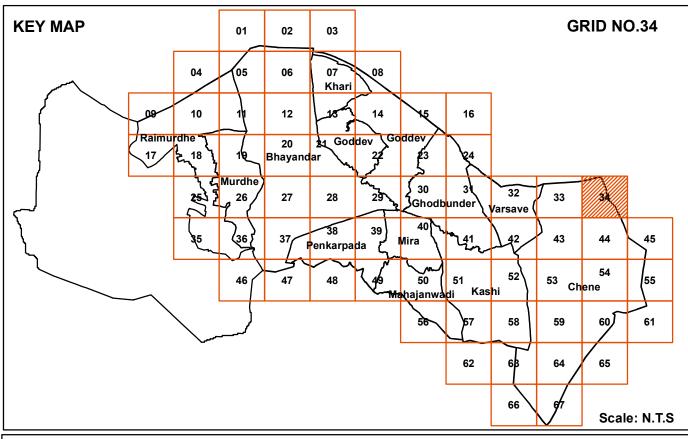

Road	N. 6	Religi	ous	Rese	rvations		
EW	National Highway Expressway	т	Temple	HFD No.	Housing for Dishoused	SC No.	Shopping Center
MCR	Major City Road	м	Mosque	EWS( LIG	Housing for Economically Weaker	M(M) No.	Municipal Market
Rail	Major ony Rodu	1	ldgah	No	Section (EWS)/LIG		·
	Broad Gauge	C	Church	URS No.	URS Purpose	(FM No.	Fish Market
<u>,</u>	Metro Station	GD SY	Gurudwara	(PAP No.)	Project Affected Person	(HM No.)	Hawkers Market
	Metroline	ASH	Synagogue Ashram	WH	Women Hostel/	PU No.	Public Utilities
Bridge	es Over Bridge		ational	No.	Child Care Center	No.	
<u> </u>	Subway	G	Garden	No.	Tribal Hostel	No.	Slaughter House
	Road Bridge across Rail	PG	Play Ground	G No.	Garden	STP No.	Sewage Treatment Plar
	Flyover	SPC	Sports Centre	PG No.	Playground	ww	Water Works
	Proposed Flyover	Public	: Utlities	PK		No. BG/CG/	Burial/Cremation Ground
	Elevated Coastal Road	SPS	Sewage Pumping Station	No.	Park		Cemetery
	Elevated Proposed Road	STP	SewageTreatment Plant	MPR No	Mangrove Park	BUS STD/ BD No	Bus Stand/Depot
vater	Bodies	ESR/GSR	Elevated & Ground Storage Reservoir	EXC	Exhibition Center	BUS	Bus Terminal & Parking
River	River	CG/BG/CM	Crematorium/Burial Ground/ Cemeterv	No.		P No.	J. J
Lake	Lake	ESS	Electric Sub-Station	SPOT	Picnic Spot		Truck Terminal
Ponds	Ponds	BP	Bio Gas Plant	INS.F No.	Institute for Fisheries	MP/P No.	Multipurpose Parking/ Parking
Nalla	Nalla	Trans	portation	E.A. No.	Educational Amenity		ISBT Terminus
	Covered Nalla	BUS	Bus Stand/Terminus			No.	ISBT Terminus
eside	ential	RST	Railway Station	(SSA No.	School for Specially Abled	WT No.	Water Terminal
	Residential Area	RTA	Railway Track Area	M.A. No.	Medical Amenity	(Trans) (Hub)	Transport Hub
R-R	Restricted - Residential	PAS/PAA	Parking Space/Area			No	
R-R1	Restricted - Residential 1	JT	Jetty	(H(M) No.	Municipal Hospital	DF No.	Development of Fort
sc	Shopping Centre/Mall	No De	velopment Zone	M.OFF No.	Municipal Office	Ext. No.	Extension
WM	Market (Daily & Weekly)		No Development Zone	MP No.	Municipal Purpose	ОТ	Open Theatre
ndust			National Park(SCNP) Forest Zone(SGNP)			No. Øpen M	
	Industrial Area		Mangrove	GOD(M) No.	Municipal Godown	No.	Open Market
duca	tion	250002000 250002000	Mangrove Buffer	LIB No.	Library	P&SP No.	Parking and Swimming Pool
S/SS	Primary & Secondary School		Intertidal		Town Hall & Drama	Reser	vation Status
COL	College	Eco S	ensitive Zone		Theatre		Developed
ealth	Services	EC0-3	SGNP Boundary	AUDI No.	Auditorium		
н	Hospital		Eco-Sensitive Zone Boundary	PL&AQ	Planetarium & Aquarium		Not Developed
UHC	Urban Health Centre	Power		No.		Modif	ication
sg(Q)	al /State Govt Property Quarter	-	Transmission Tower	COM.H No.	Community Hall	Μ	Proposed Modification
SG(Q)	Office	<b>→→</b>	Power Transmission Line	FBS	Fire Brigade Station		
	ay Property	Bound		No.	Administrative Building	CZMP	Lines
RP	Railway Property		DP Boundary	SG(O) No.	For Govt.office		CRZ_II
	& Semi-Public		Municipal Corporation Boundar	SOV.P No.	Government Purpose		High Tide Line
	Auditorium/Drama Theatre		Village Boundary				Intertidal
юм.н	Community Hall		Gaothan Boundary	NS No.	Night Shelter		Mangrove Buffer
swc	Social Welfare Centre		CTS Area Boundary	OAH No.	Old Age Home		Mangroves
ОАН	Old Age Home		Congested Boundary		Dublic America	M	Mangroves
FS	Fire Station	Cadas	stral	(PA No.)	Public Amenity		
Stn/P.Ch	Police Station/Chowky	[]]	Cadastre/CTS	SDC No.	Skill Development Center		
lerita			ng Footprint	NO.			

#### Notes

1. The Base Map, ELU and Draft PLU prepared by superimposition of data collected from various Government / Semi Government / Departments / Stakeholders and physical features depicted from Drone / Satellite Imagery; hence, the discrepancies may occur.

2. Proposed Land-use Shall prevail irrespective of property number / boundary shown on map which shall be subject to confirmation from Land Record or competent Authority.

3. The structure on the map does not confirm authorization unless verified and rectified by Planning Authority. 4.SGNP, CRZ, Mangroves with their buffers shown on the plan shall be as per the relevant status. In case of any modifications to such status in future, such boundary and buffer shall automatically stand modified as per the latest notification. 5.The alignment of Metro, Coastal Elevated Road marked on plan are indicative & automatically stand modified by the notification issued by Government from time to time. 6.The alignment of nallah / river / creek is indicative and as per the feature extracted from Drone Imagery and data collected.

7. The boundaries of all the designated sites, Government property are shown as per the image captured by superimposition on cadastral map. This may be subject to change as per the actual acquisition in future. 8.This plan is to be read with UDCPR-2022 and Draft DP Report.

9.Existing road shall have status of the road according to width of road even though not shown in development plan. 10.R-R(Restricted-Residential) Residential Zone subject to handing over area to corporation as per permission/Government orders.


11.R-R1 (Restricted- Residential1) All provision of Residential Zone in UDCPR-2020 will be applicable for this zone subject to 10% of area under Development should be kept for Amenity Space as per direction of Municipal Commissioner with prior permission from Eco-Sensitive Zone Commitee.

12.If the location of Metro Carshed and Metro Line is shifted by MMRDA or Elevated Road is shifted in future, the land leased by such shifting shall stands included in adjoining Zone shown on Development Plan.

Scale				North N
0	0.05	0.1	0.2 km	WEE
		1:2,000		S S S S S S S S S S S S S S S S S S S
3510	मुल्यनिधारम		DRt	





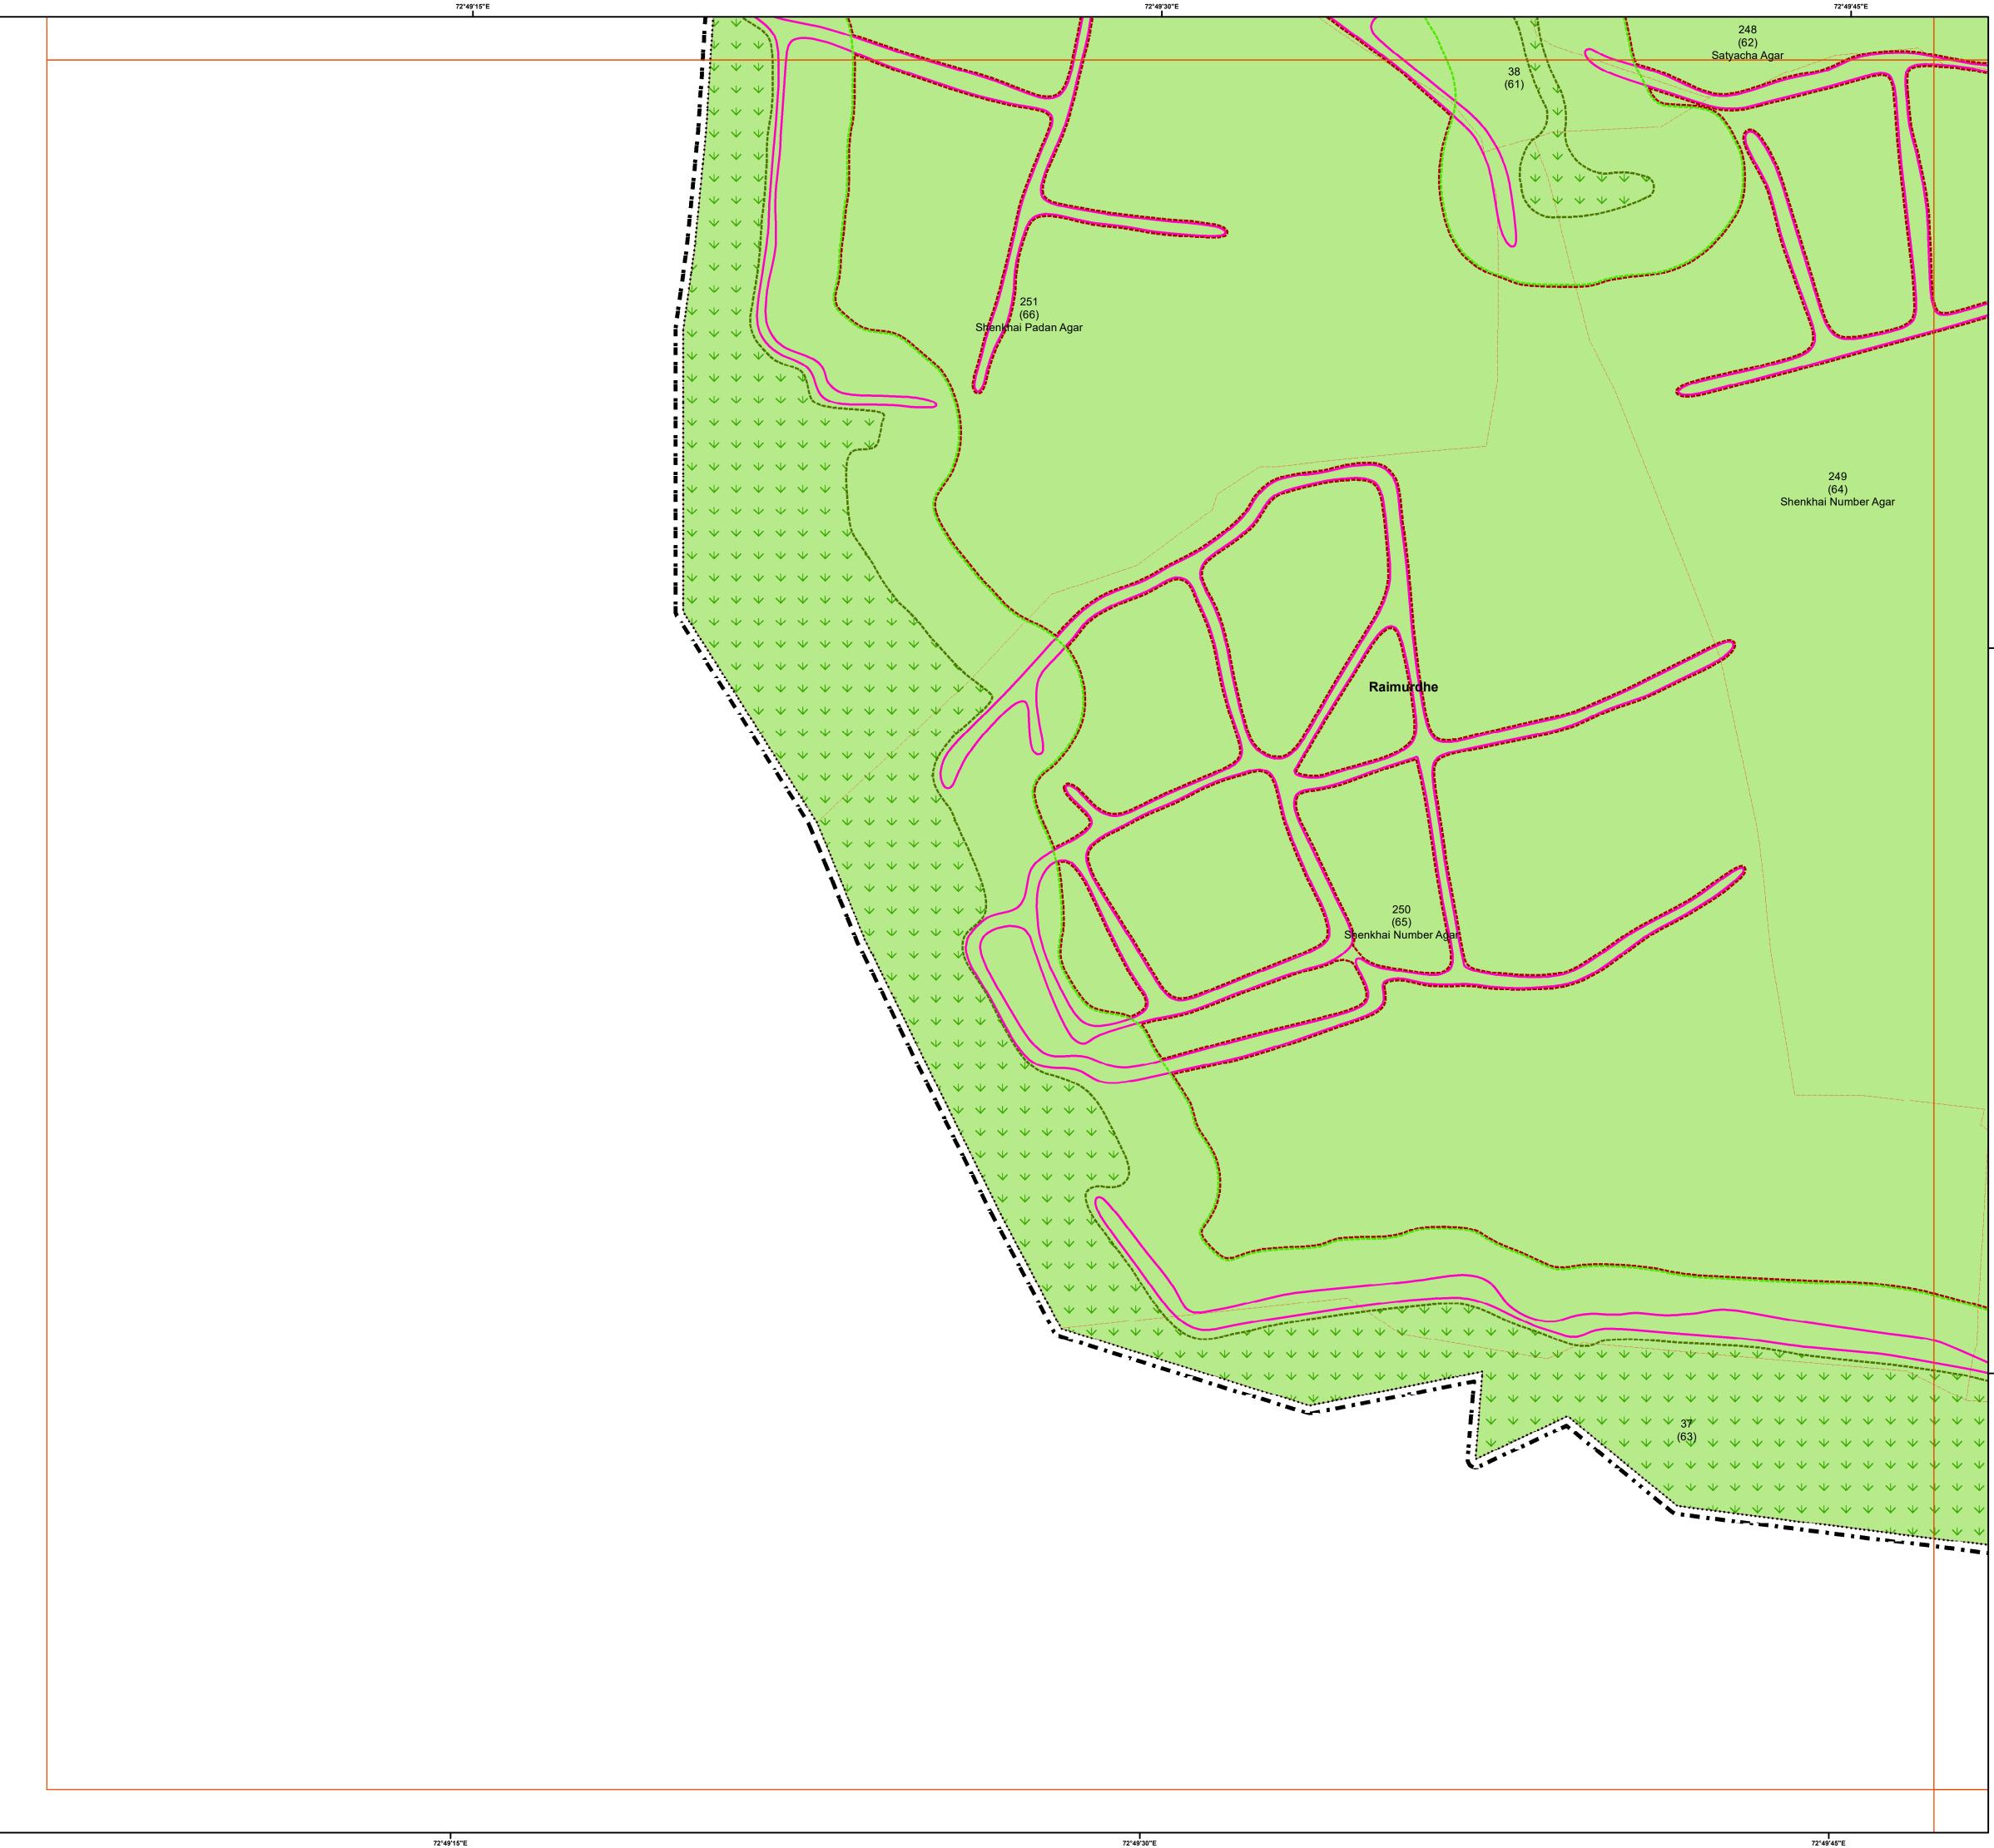




ant ever	मुल्यनिस	WE DI S
गर रचन		विभाग
140	सम्यमेव जयां ठाणे श	TAI N



1:2,000

Officer Appointed U/s 21(4A) Draft Revised Development Plan of Mira Bhayandar

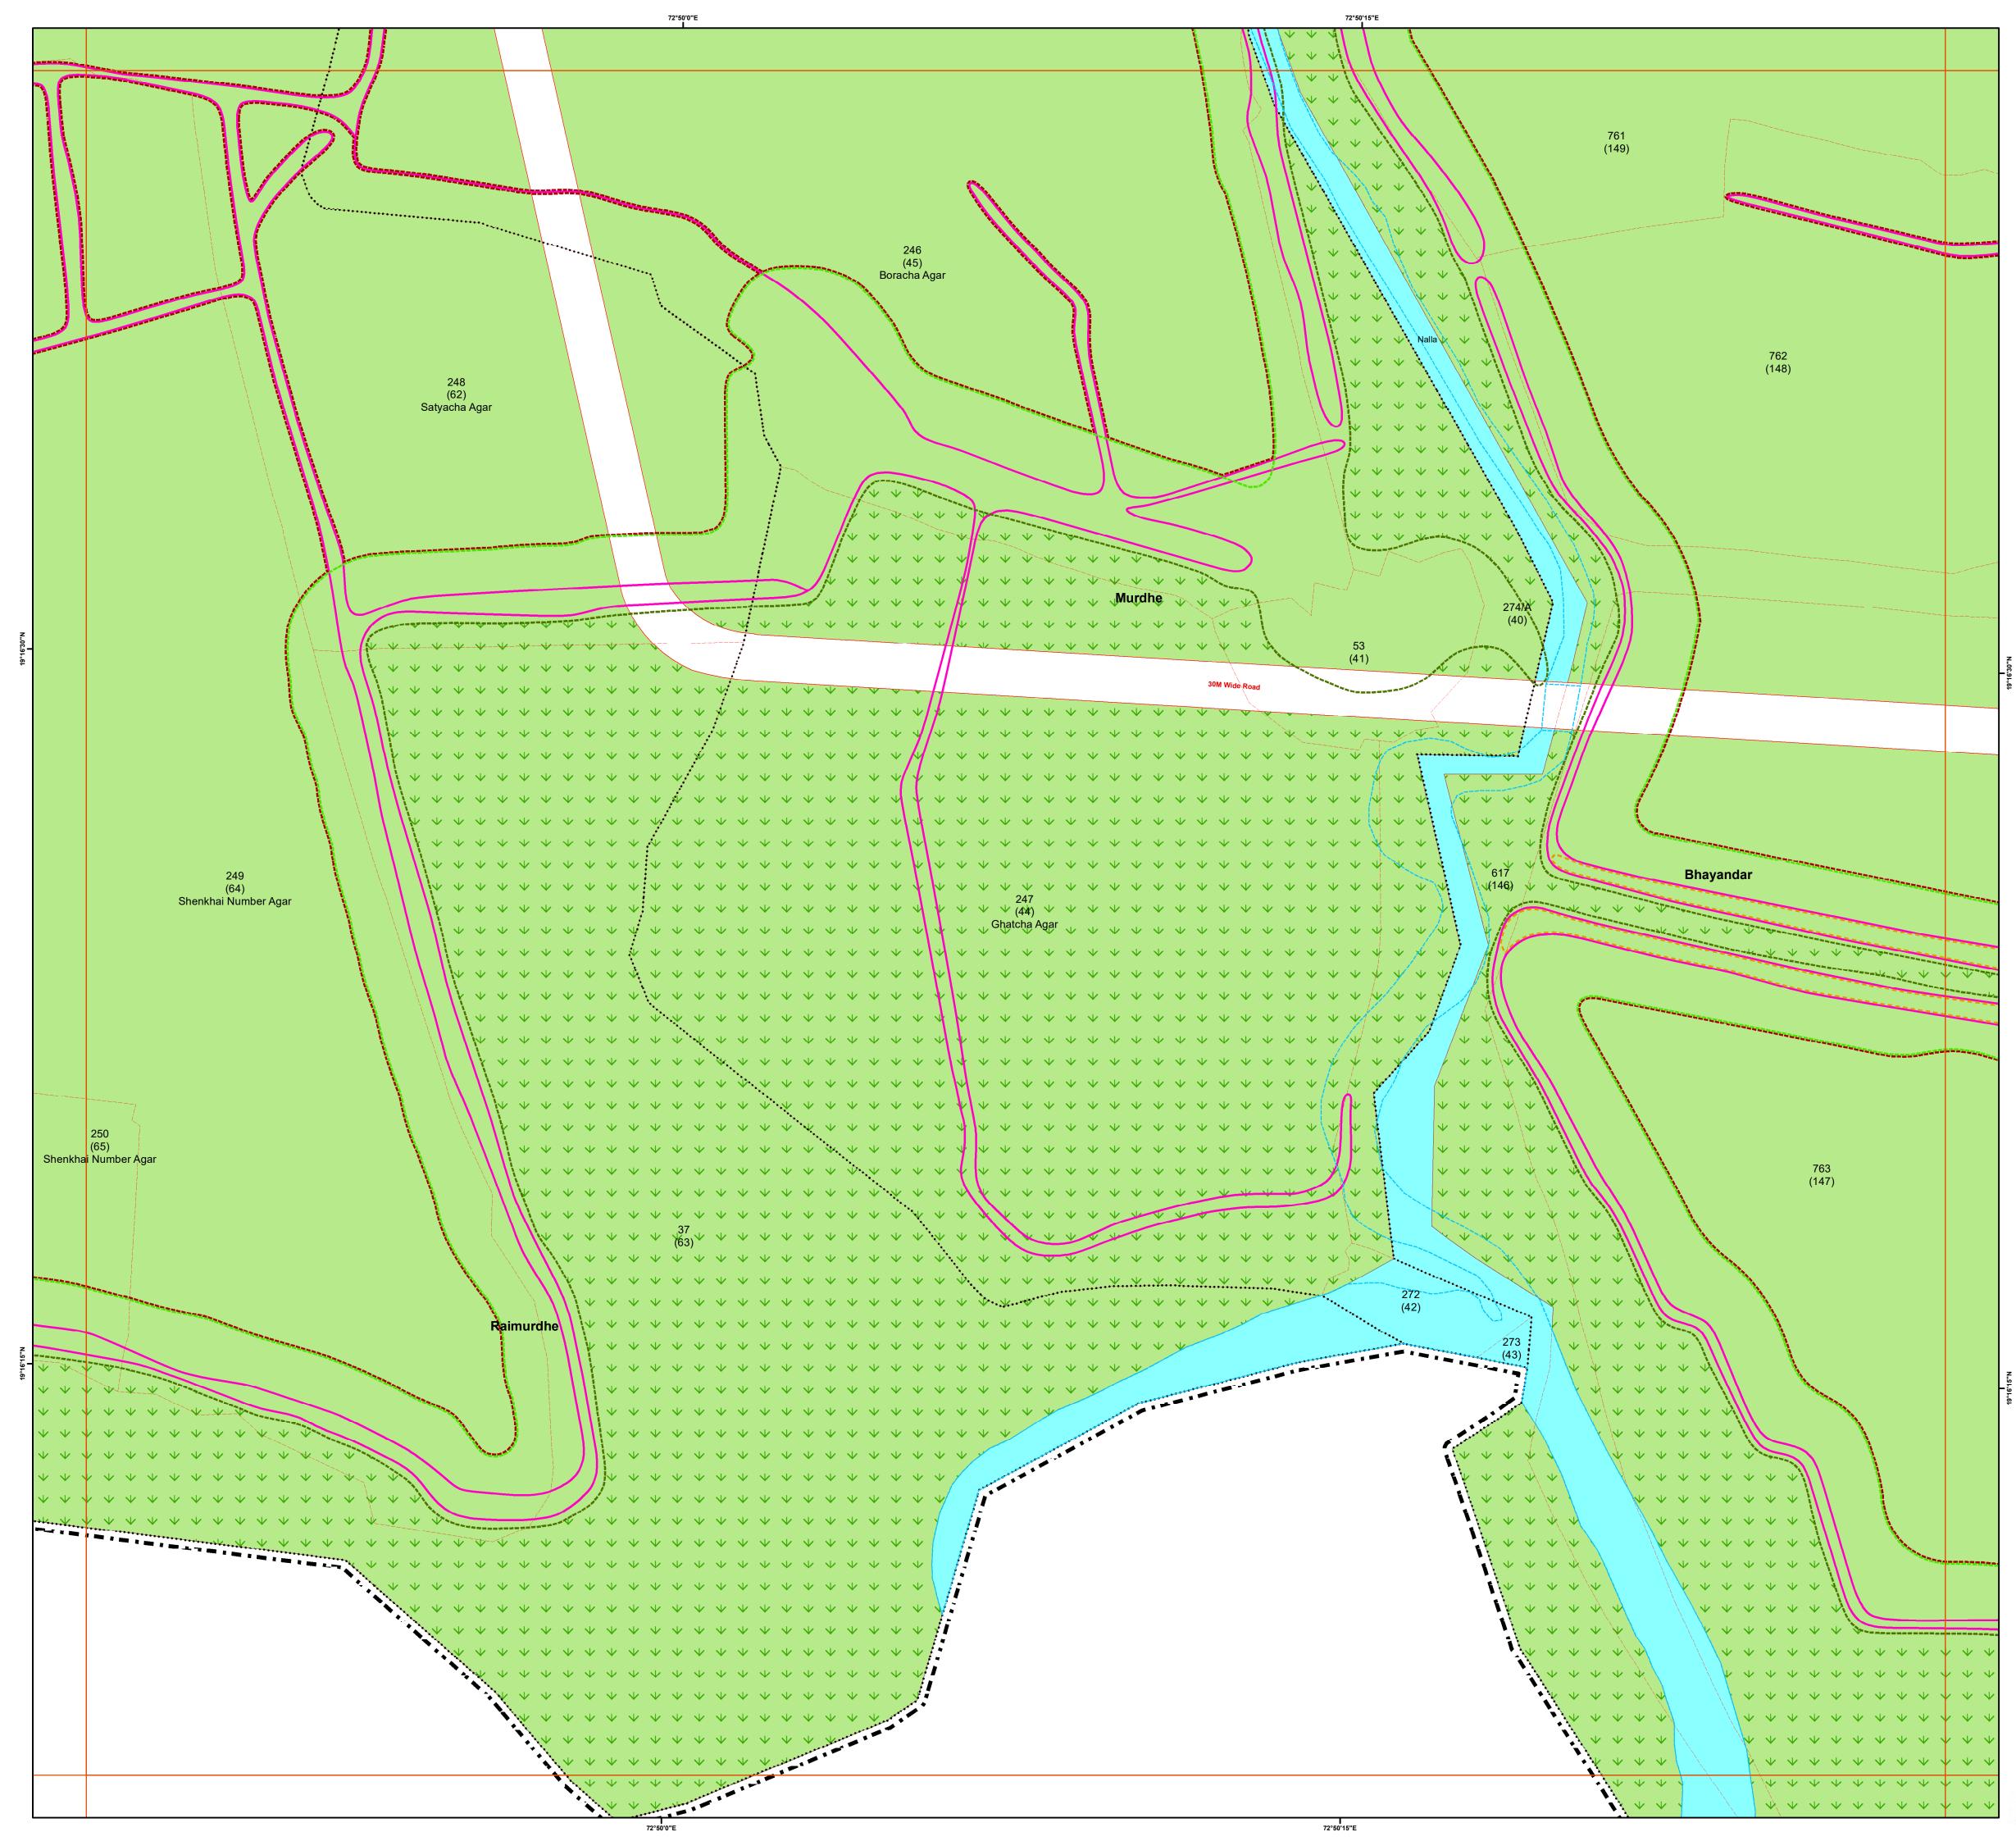




Scale				North N
0	0.05	0.1	0.2 km	WEE
		1:2,000		S
SHEPT	मुल्यनिधारम			·
त्व			Brist	





Officer Appointed U/s 21(4A) Draft Revised Development Plan of Mira Bhayandar



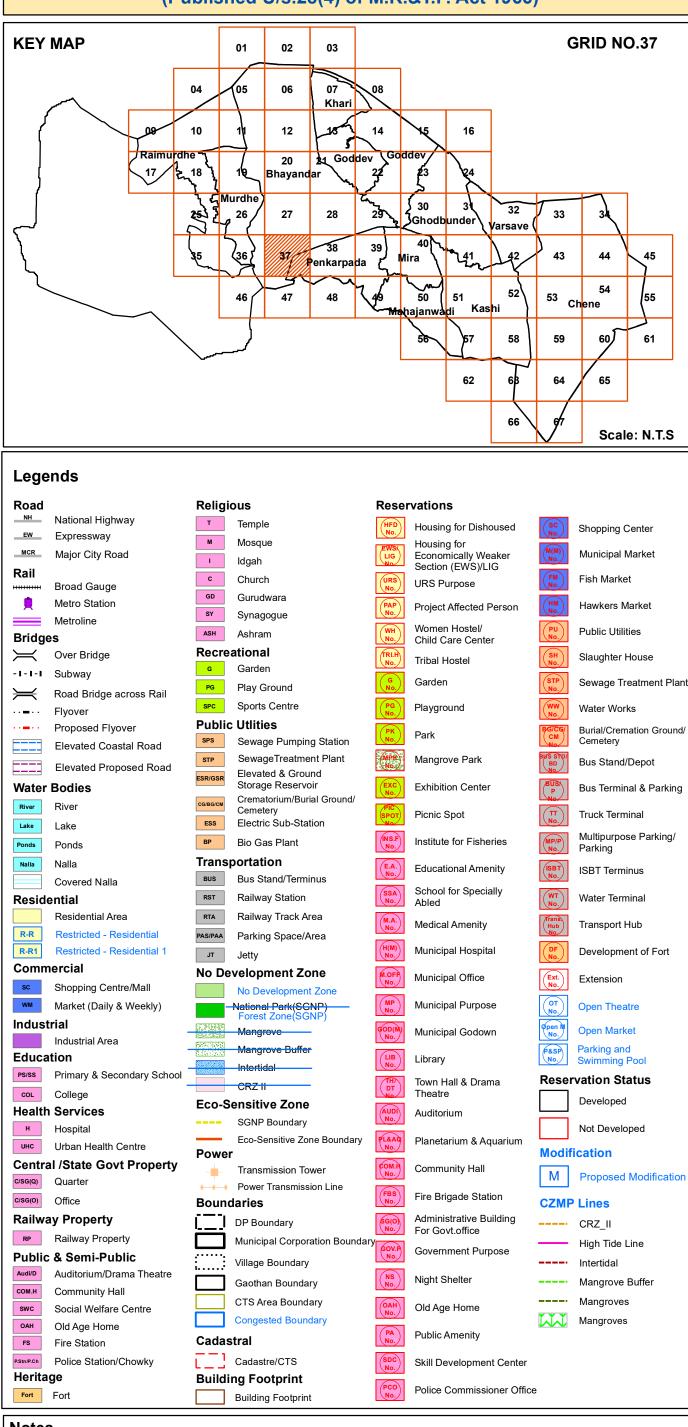

#### Notes

1. The Base Map, ELU and Draft PLU prepared by superimposition of data collected from various Government / Semi Government / Departments / Stakeholders and physical features depicted from Drone / Satellite Imagery; hence, the discrepancies may occur.

2. Proposed Land-use Shall prevail irrespective of property number / boundary shown on map which shall be subject to confirmation from Land Record or competent Authority.

3. The structure on the map does not confirm authorization unless verified and rectified by Planning Authority. 4.SGNP, CRZ, Mangroves with their buffers shown on the plan shall be as per the relevant status. In case of any modifications to such status in future, such boundary and buffer shall automatically stand modified as per the latest notification. 5.The alignment of Metro, Coastal Elevated Road marked on plan are indicative & automatically stand modified by the notification issued by Government from time to time.

6. The alignment of nallah / river / creek is indicative and as per the feature extracted from Drone Imagery and data collected. 7. The boundaries of all the designated sites, Government property are shown as per the image captured by superimposition on cadastral map. This may be subject to change as per the actual acquisition in future. 8. This plan is to be read with UDCPR-2022 and Draft DP Report.

9.Existing road shall have status of the road according to width of road even though not shown in development plan. 10.R-R(Restricted-Residential) Residential Zone subject to handing over area to corporation as per permission/Government

11.R-R1 (Restricted- Residential1) All provision of Residential Zone in UDCPR-2020 will be applicable for this zone subject to 10% of area under Development should be kept for Amenity Space as per direction of Municipal Commissioner with prior permission from Eco-Sensitive Zone Commitee.

12.If the location of Metro Carshed and Metro Line is shifted by MMRDA or Elevated Road is shifted in future, the land eased by such shifting shall stands included in adjoining Zone shown on Development Plan.


Scale				North N
0	0.05	0.1	0.2 km	WEE
		1:2,000		S
3110	मुल्यनिधारम		62041	·





Officer Appointed U/s 21(4A)

Draft Revised Development Plan of Mira Bhayandar

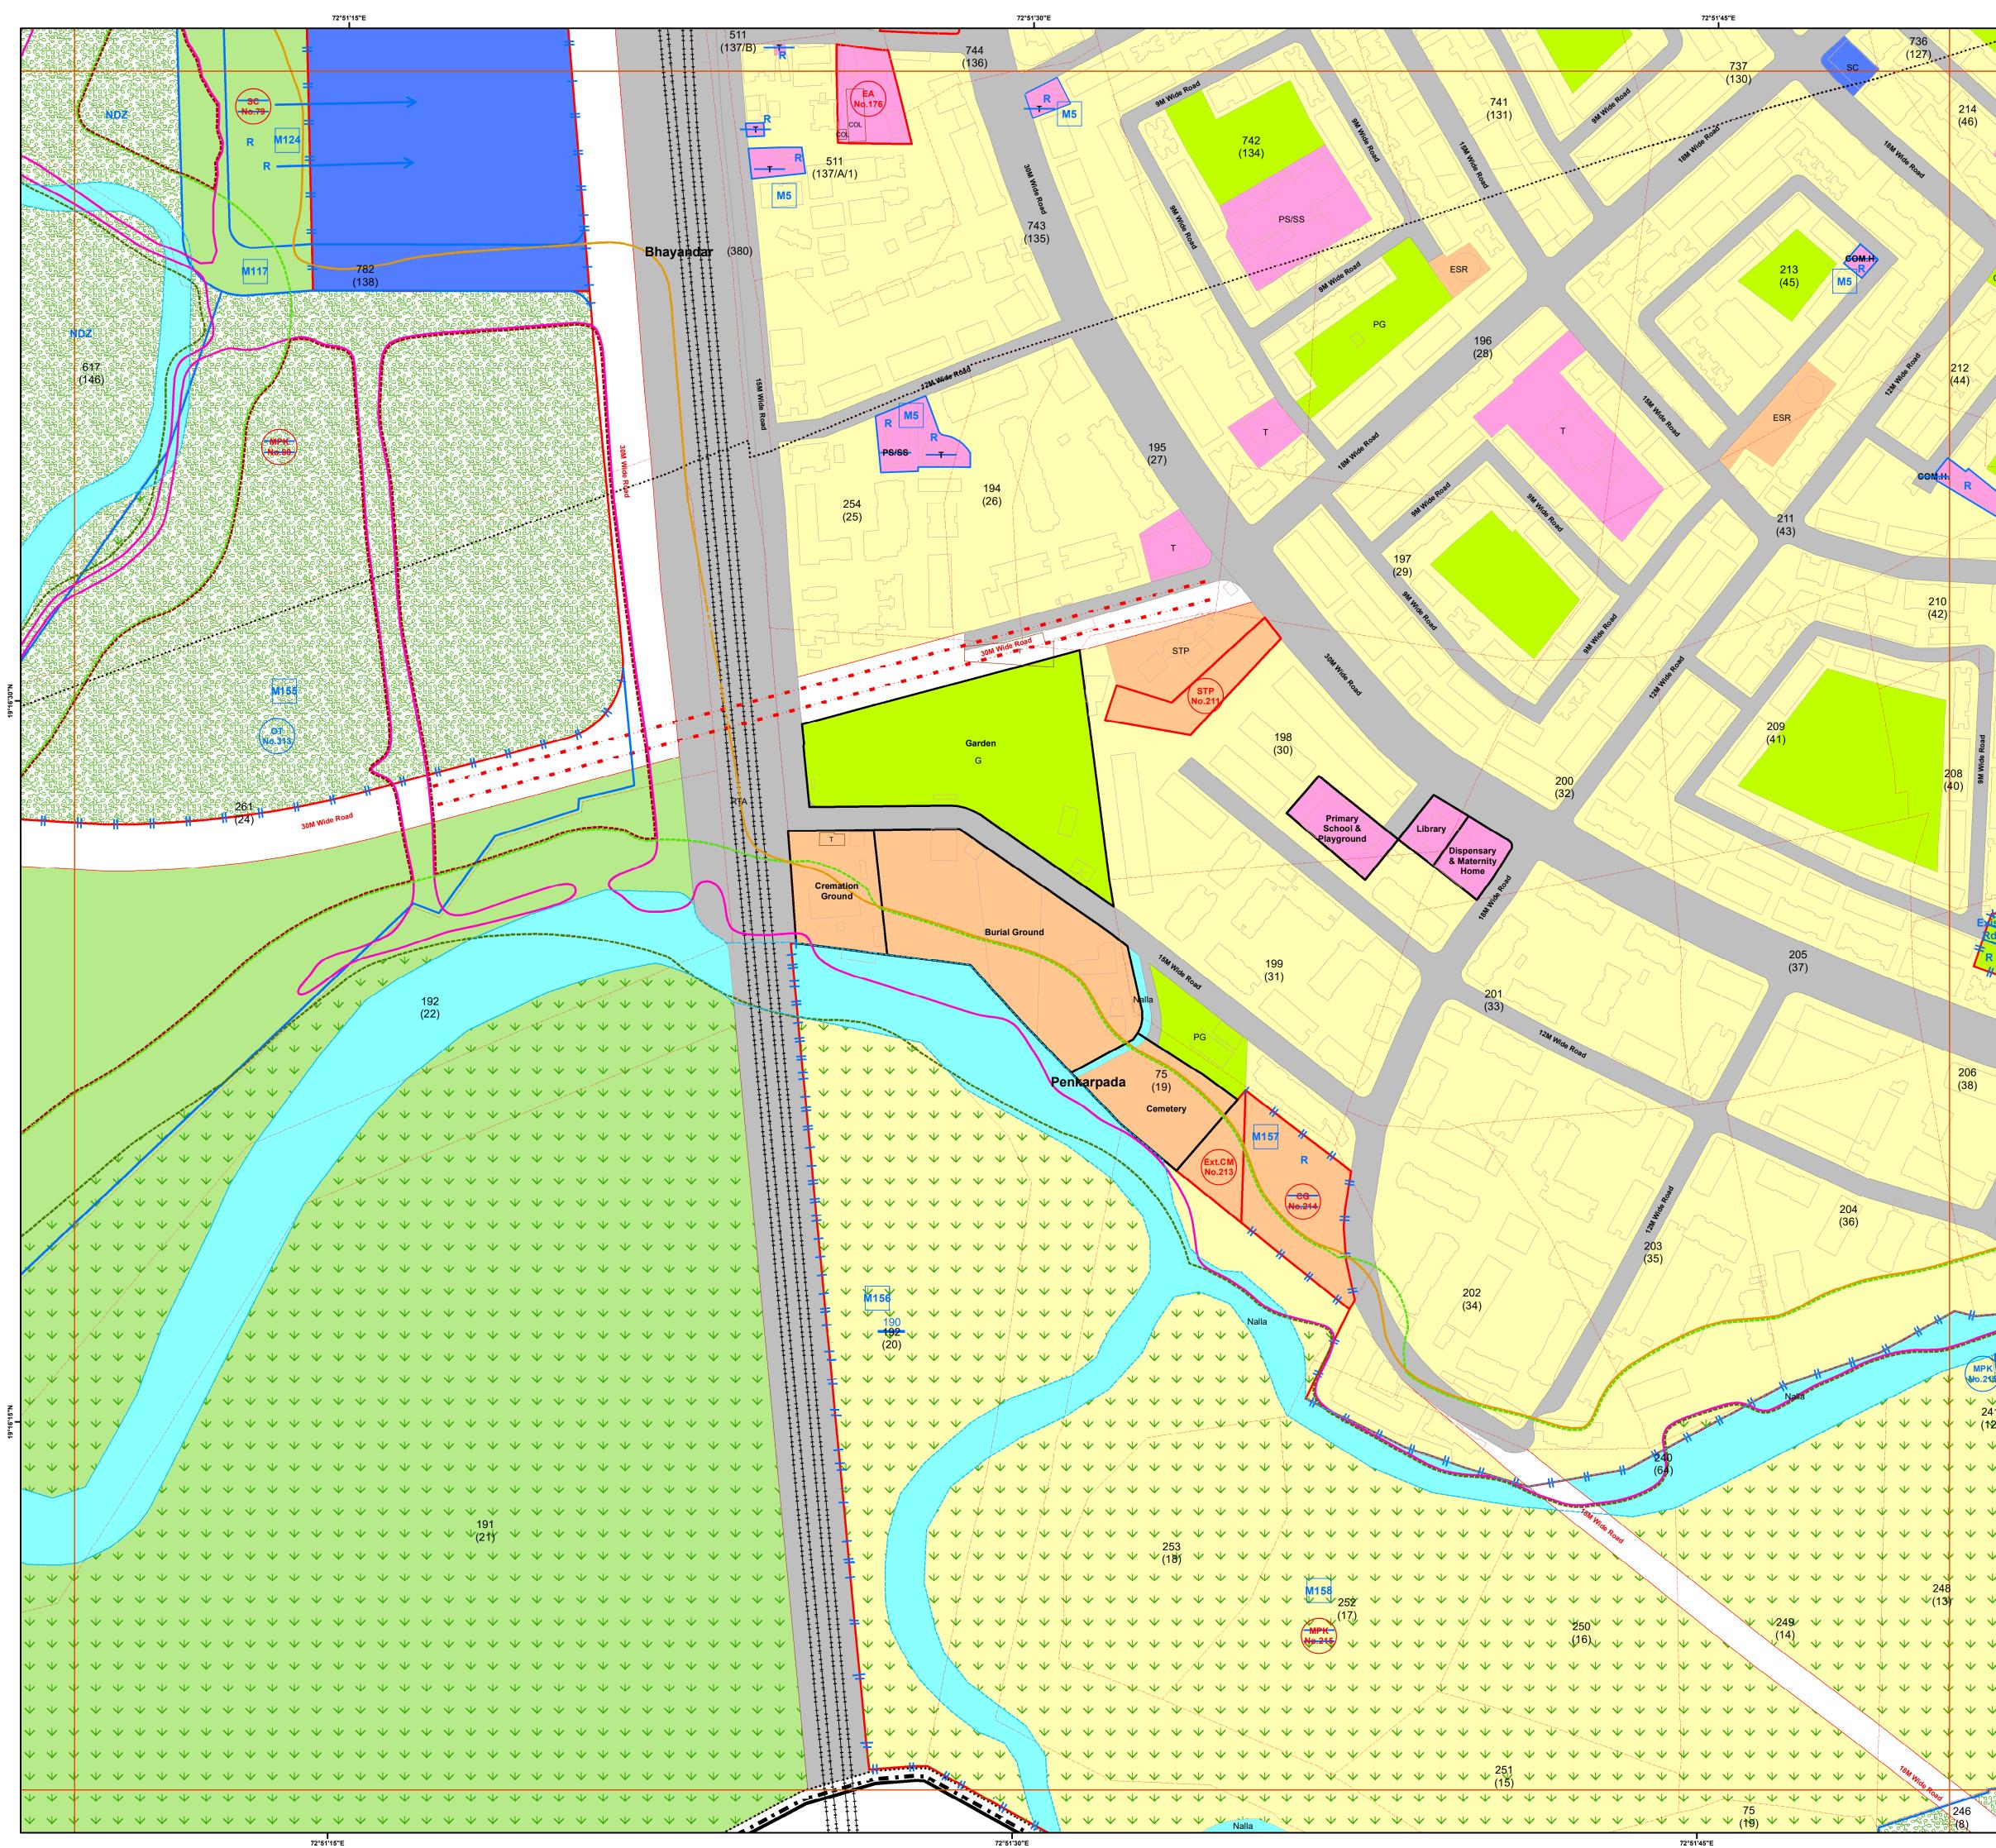

(Pt	ublished U/s.28(4) of	M.R.&T.P. Act 196	6)
KEY MAP	01 02 03		GRID NO.38
Raimurdi 17 E	04 05 06 07 Khari 10 11 12 15 10 15 10 12 15 10 15 10 15 10 12 15 10 15 10 15 10 15 10 15 10 15 10	27 23 24 30 3 32 Ghodbunder Varsave 39 40 41 42	33       34         43       44         53       54         59       60         64       65         67       Scale: N.T.S
Legends			
Road	Religious	Reservations	
National Highway	Temple	HFD Housing for Dishoused	Shopping Center
EW Expressway McR Major City Road	Mosque	Housing for Economically Weaker	(M(M) No. Municipal Market
Rail	Idgah	Section (EVVS)/LIG	Fish Market
Himmen Broad Gauge	GD Gurudwara	No.	Hawkers Market
Metroline	Synagogue	Project Affected Person	
Bridges — Over Bridge	Ash Ashram Recreational	Child Care Center	No.
-I-I-I Subway	G Garden	No. Iribal Hostel	Slaughter House
Road Bridge across Rail	PG Play Ground	Garden	Sewage Treatment Plant
···     ··     Flyover     Proposed Flyover	Sports Centre	PG Playground	WWW Water Works
Elevated Coastal Road	Sewage Pumping Station	PK No. Park	BG/CG/ CM No. Burial/Cremation Ground/ Cemetery
Elevated Proposed Road	SewageTreatment Plant Elevated & Ground	Mangrove Park	BUS Stand/Depot
Water Bodies	Storage Reservoir	Exhibition Center	Bus Terminal & Parking
River River	Crematorium/Burial Ground/ Cemetery Ess Electric Sub-Station	Pic Picnic Spot	Truck Terminal
Lake Lake Ponds	Electric Sub-Station BP Bio Gas Plant	Institute for Fisheries	Multipurpose Parking/
Nalla Nalla	Transportation	EA. Educational Amenity	
Covered Nalla	Bus Stand/Terminus		
Residential Residential Area	RST Railway Station RTA Railway Track Area	No. Abled	WT Water Terminal
R-R Restricted - Residential	PAS/PAA Parking Space/Area	M.A. No. Medical Amenity	Transport Hub
<b>R-R1</b> Restricted - Residential 1	JT Jetty	(H(M) No. Municipal Hospital	DF No. Development of Fort
Sc Shopping Centre/Mall	No Development Zone	Municipal Office	Ext. Extension
Market (Daily & Weekly)	No Development Zone     National Park(SGNP)     Forest Zone(SGNP)	Municipal Purpose	OT Open Theatre
Industrial	Mangrove	Municipal Godown	Open M No. Open Market
Industrial Area Education	Mangrove Buffer	Library	Parking and Swimming Pool
Primary & Secondary School		Town Hall & Drama	Reservation Status
College	Eco-Sensitive Zone	Theatre	Developed
Health Services Hospital	SGNP Boundary	Auditorium	Not Developed
Urban Health Centre	Eco-Sensitive Zone Boundary Power	Planetarium & Aquarium	Modification
Central /State Govt Property C/SG(Q) Quarter	Transmission Tower	Community Hall	M Proposed Modification
c/sg(0) Office	← → Power Transmission Line Boundaries	FBS Fire Brigade Station	CZMP Lines
Railway Property	DP Boundary	Administrative Building For Govt.office	CRZ_II
Railway Property Public & Semi-Public	Municipal Corporation Bounda		High Tide Line
Auditorium/Drama Theatre	Village Boundary	Night Shelter	Intertidal     Mangrove Buffer
COM.H Community Hall	CTS Area Boundary		· Mangroves
Social Welfare Centre Old Age Home	Congested Boundary	Old Age Home	Mangroves
Fire Station	Cadastral	PA No. Public Amenity	
Police Station/Chowky Heritage	Cadastre/CTS Building Footprint	Skill Development Center	r
Fort Fort	Building Footprint	Police Commissioner Off	ice
Notes			

#### Notes

1. The Base Map, ELU and Draft PLU prepared by superimposition of data collected from various Government / Semi Government / Departments / Stakeholders and physical features depicted from Drone / Satellite Imagery; hence, the discrepancies may occur.

2. Proposed Land-use Shall prevail irrespective of property number / boundary shown on map which shall be subject to confirmation from Land Record or competent Authority.

3. The structure on the map does not confirm authorization unless verified and rectified by Planning Authority. 4.SGNP, CRZ, Mangroves with their buffers shown on the plan shall be as per the relevant status. In case of any modifications to such status in future, such boundary and buffer shall automatically stand modified as per the latest notification. 5.The alignment of Metro, Coastal Elevated Road marked on plan are indicative & automatically stand modified by the notification issued by Government from time to time.

6.The alignment of nallah / river / creek is indicative and as per the feature extracted from Drone Imagery and data collected. 7. The boundaries of all the designated sites, Government property are shown as per the image captured by superimposition on cadastral map. This may be subject to change as per the actual acquisition in future. 8.This plan is to be read with UDCPR-2022 and Draft DP Report.

P.Existing road shall have status of the road according to width of road even though not shown in development plan. 10.R-R(Restricted-Residential) Residential Zone subject to handing over area to corporation as per permission/Government rders.

11.R-R1 (Restricted- Residential1) All provision of Residential Zone in UDCPR-2020 will be applicable for this zone subject to 10% of area under Development should be kept for Amenity Space as per direction of Municipal Commissioner with prior ermission from Eco-Sensitive Zone Commitee.


12.If the location of Metro Carshed and Metro Line is shifted by MMRDA or Elevated Road is shifted in future, the land ased by such shifting shall stands included in adjoining Zone shown on Development Plan.

	Scale				North	N	
	0	0.05	0.1	0.2 k	m	WEE	
			1:2,000			S	
ſ	31101 2	मुल्यनिधरिषा		6004			





☐ Officer Appointed U/s 21(4A) ★ Draft Revised Development Plan of Mira Bhayandar

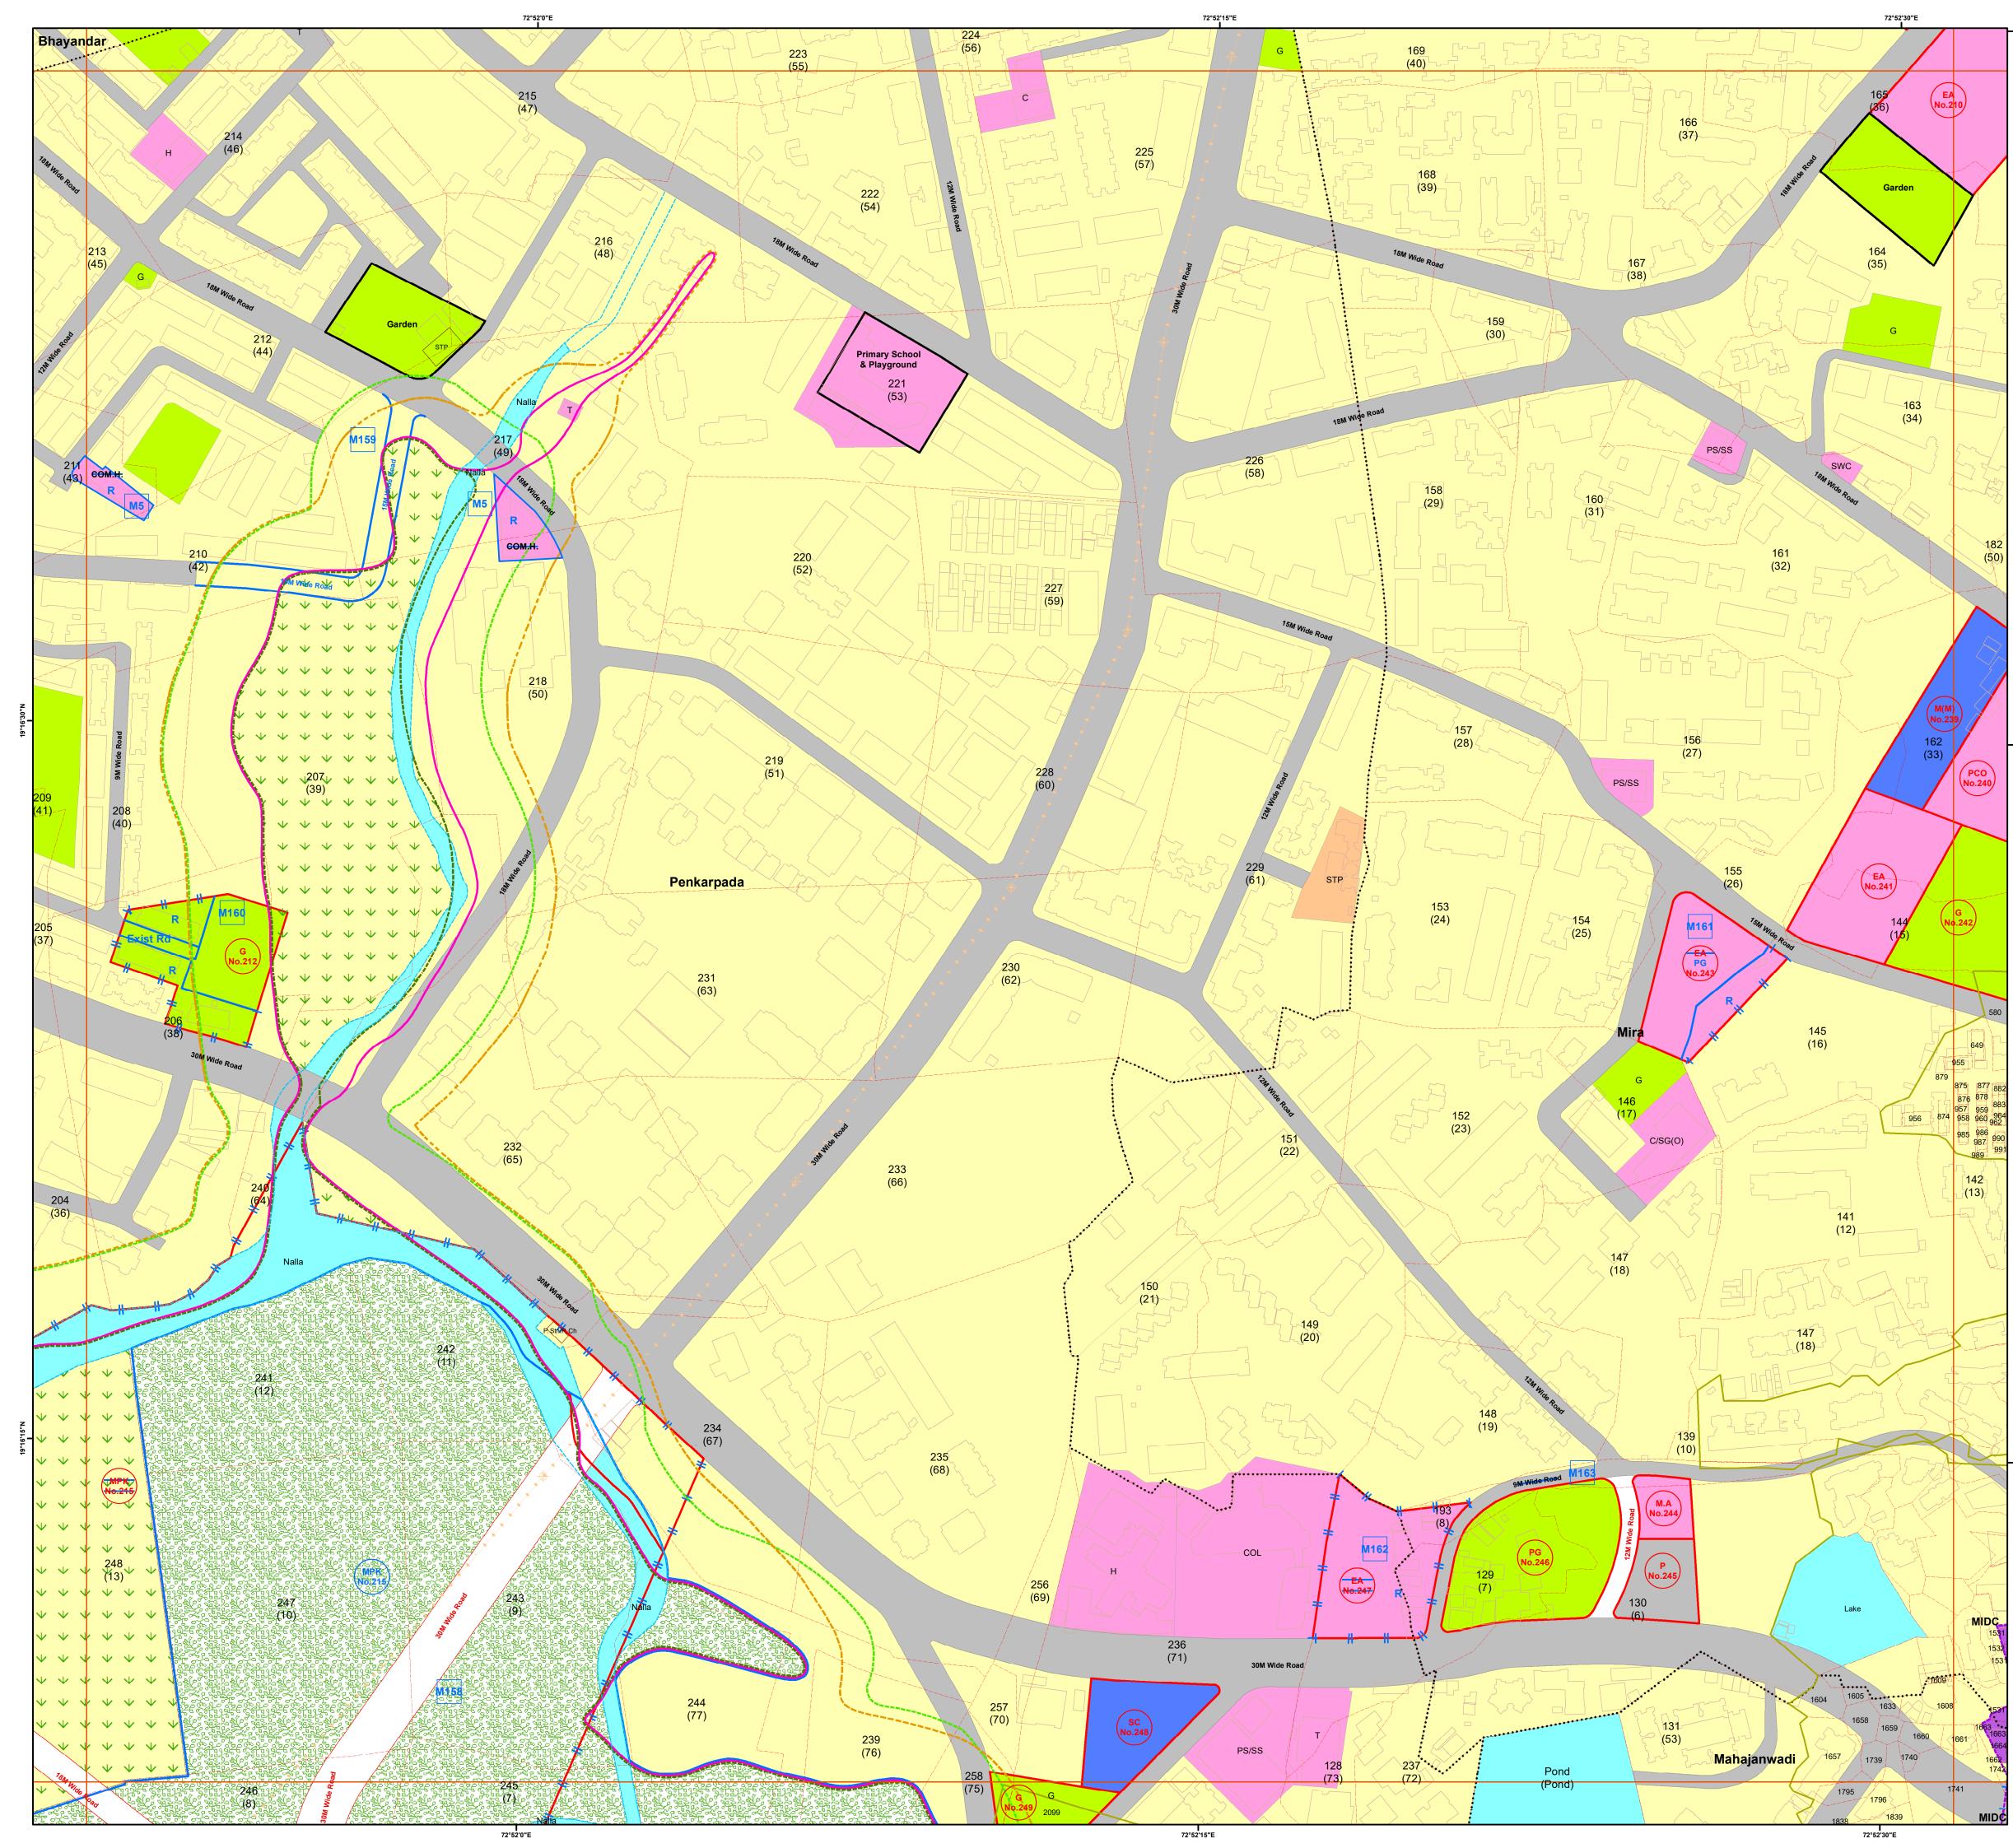




permission from Eco-Sensitive Zone Commitee.


12.If the location of Metro Carshed and Metro Line is shifted by MMRDA or Elevated Road is shifted in future, the land leased by such shifting shall stands included in adjoining Zone shown on Development Plan.

Scale				North N
0	0.05	0.1	0.2 km	WEEE
		1:2,000		S



Officer Appointed U/s 21(4A) Draft Revised Development Plan of Mira Bhayandar

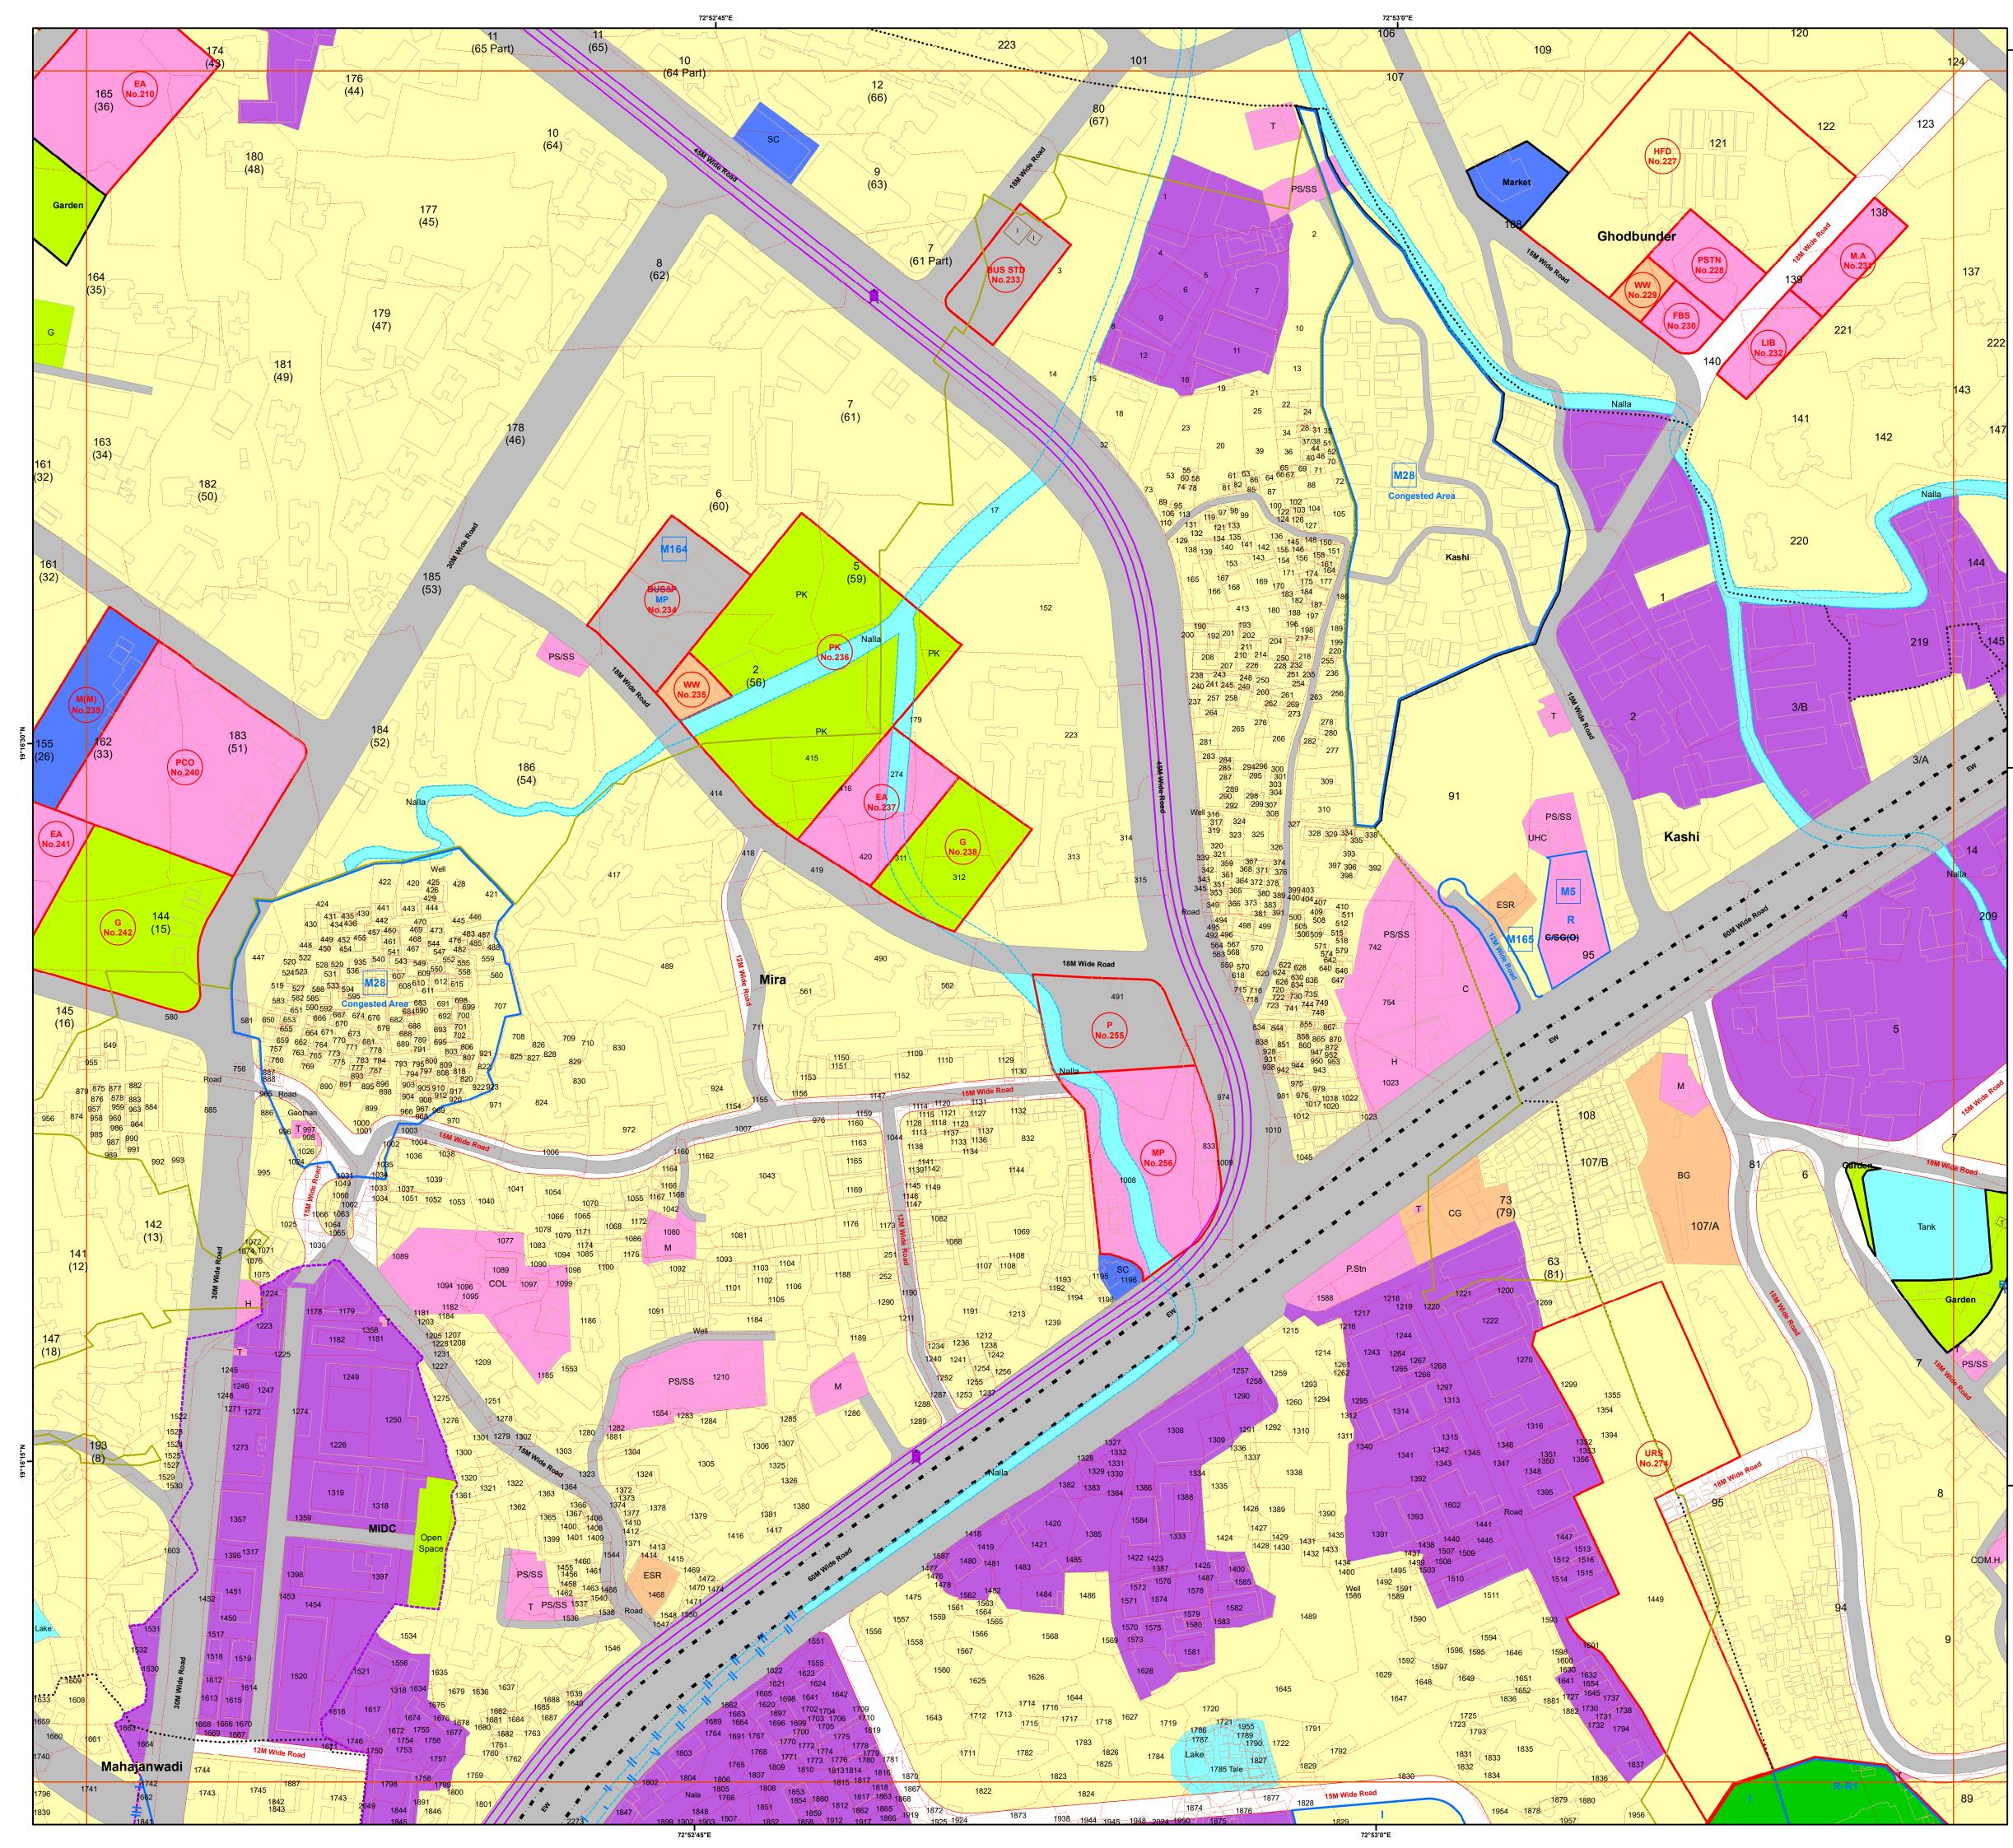

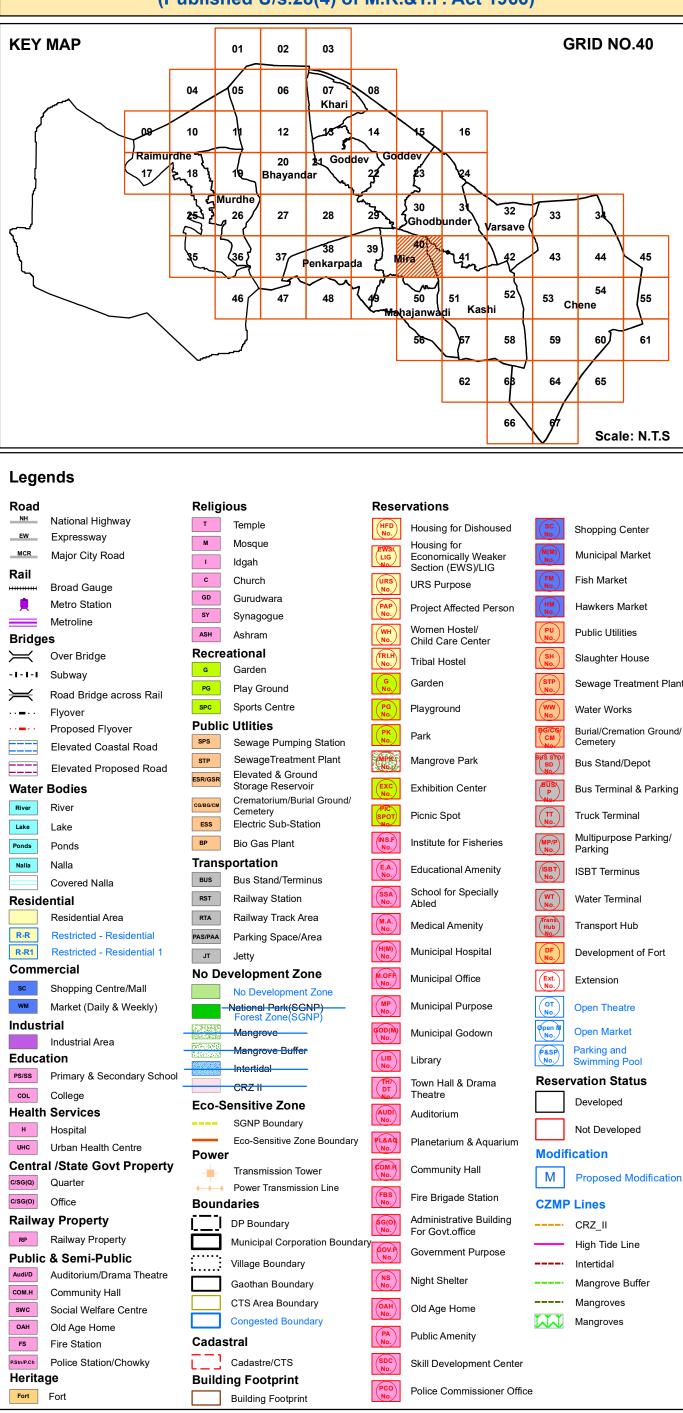

#### Notes

1.The Base Map, ELU and Draft PLU prepared by superimposition of data collected from various Government / Semi Government / Departments / Stakeholders and physical features depicted from Drone / Satellite Imagery; hence, the discrepancies may occur.

2. Proposed Land-use Shall prevail irrespective of property number / boundary shown on map which shall be subject to confirmation from Land Record or competent Authority.

3. The structure on the map does not confirm authorization unless verified and rectified by Planning Authority. 4.SGNP, CRZ, Mangroves with their buffers shown on the plan shall be as per the relevant status. In case of any modifications to such status in future, such boundary and buffer shall automatically stand modified as per the latest notification. 5. The alignment of Metro, <del>Coastal Elevated</del> Road marked on plan are indicative & automatically stand modified by the notification issued by Government from time to time. 6.The alignment of nallah / river / creek is indicative and as per the feature extracted from Drone Imagery and data collected.

7. The boundaries of all the designated sites, Government property are shown as per the image captured by superimposition on cadastral map. This may be subject to change as per the actual acquisition in future. 8.This plan is to be read with UDCPR-2022 and Draft DP Report.

P.Existing road shall have status of the road according to width of road even though not shown in development plan. 10.R-R(Restricted-Residential) Residential Zone subject to handing over area to corporation as per permission/Government

11.R-R1 (Restricted- Residential1) All provision of Residential Zone in UDCPR-2020 will be applicable for this zone subject to 10% of area under Development should be kept for Amenity Space as per direction of Municipal Commissioner with prior permission from Eco-Sensitive Zone Commitee.

12.If the location of Metro Carshed and Metro Line is shifted by MMRDA or Elevated Road is shifted in future, the land eased by such shifting shall stands included in adjoining Zone shown on Development Plan.


Scale				North	N
0	0.05	0.1	0.2		WEE
		1:2,000			S


ठाणे भ



Officer Appointed U/s 21(4A) Draft Revised Development Plan of Mira Bhayandar

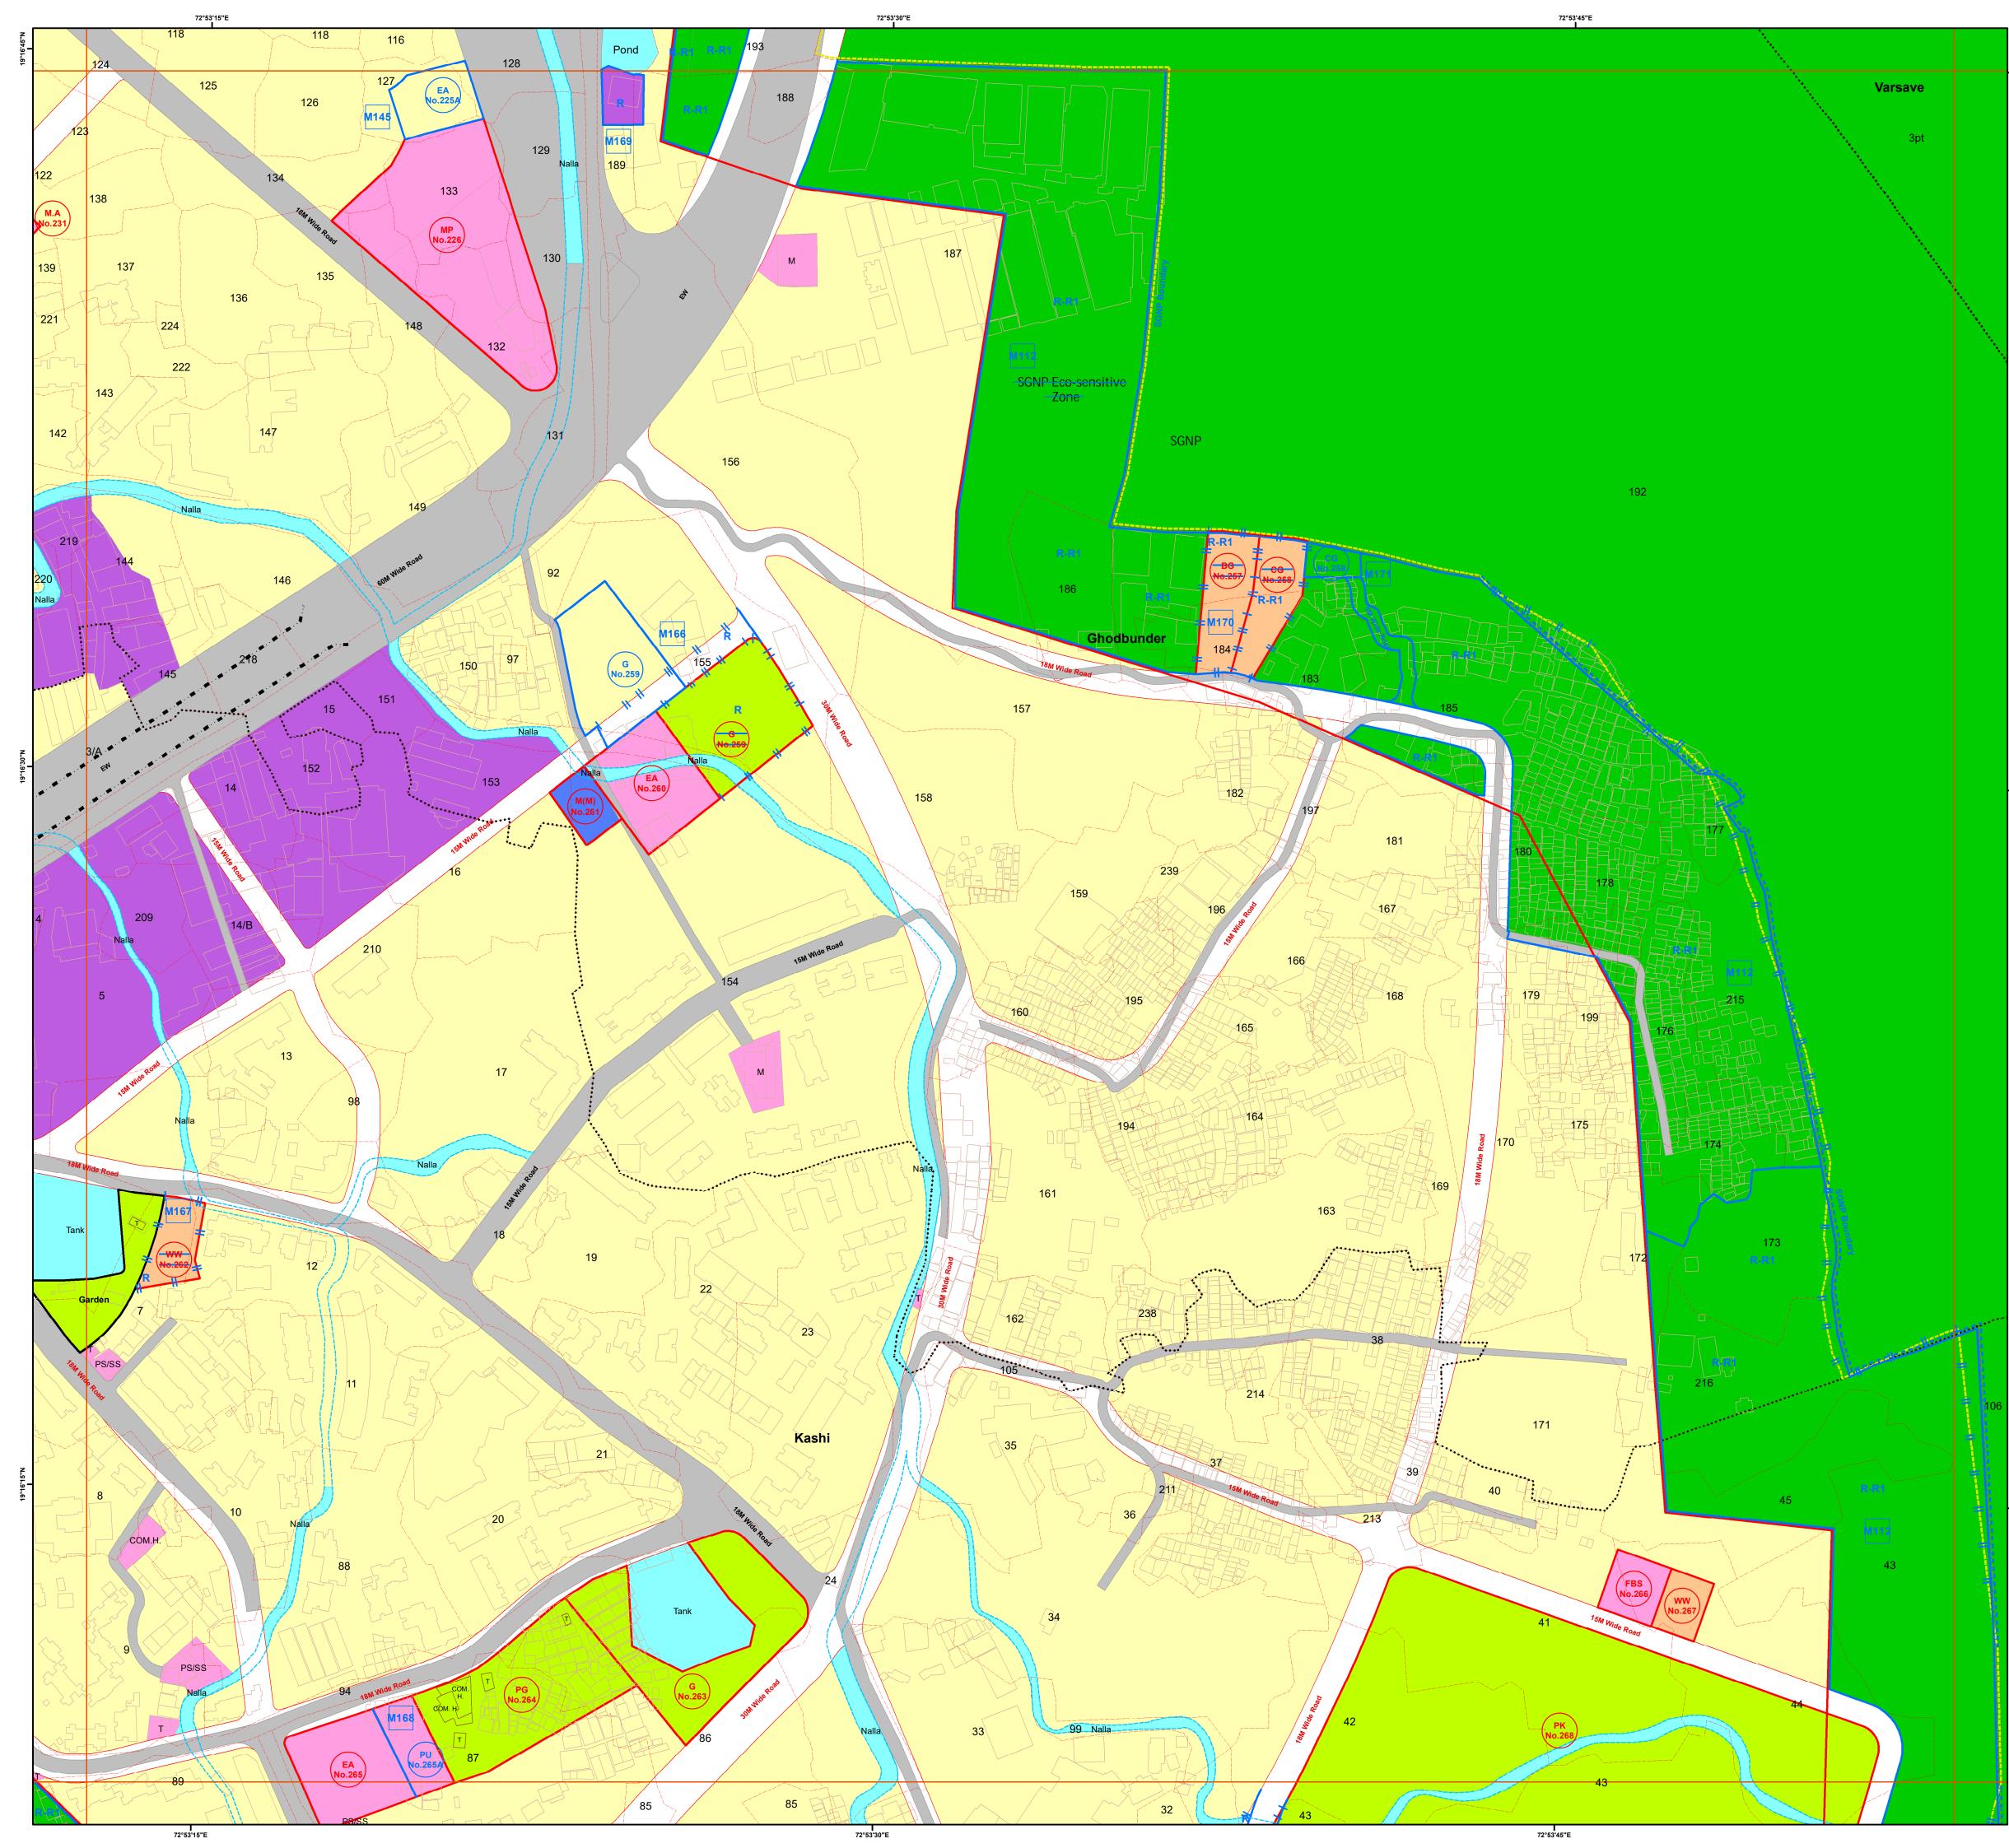



3.The structure on the map does not confirm authorization unless verified and rectified by Planning Authority. 4.SGNP, CRZ, Mangroves with their buffers shown on the plan shall be as per the relevant status. In case of any modifications to such status in future, such boundary and buffer shall automatically stand modified as per the latest notification. 5. The alignment of Metro, <del>Coastal</del> Elevated Road marked on plan are indicative & automatically stand modified by the notification issued by Government from time to time. 6. The alignment of nallah / river / creek is indicative and as per the feature extracted from Drone Imagery and data collected.

7. The boundaries of all the designated sites, Government property are shown as per the image captured by superimposition on cadastral map. This may be subject to change as per the actual acquisition in future. 8.This plan is to be read with UDCPR-2022 and Draft DP Report.

9.Existing road shall have status of the road according to width of road even though not shown in development plan. 10.R-R(Restricted-Residential) Residential Zone subject to handing over area to corporation as per permission/Government orders 11.R-R1 (Restricted- Residential1) All provision of Residential Zone in UDCPR-2020 will be applicable for this zone subject to

10% of area under Development should be kept for Amenity Space as per direction of Municipal Commissioner with prior permission from Eco-Sensitive Zone Commitee.

12.If the location of Metro Carshed and Metro Line is shifted by MMRDA or Elevated Road is shifted in future, the land eased by such shifting shall stands included in adjoining Zone shown on Development Plan.

Scale				North N
0	0.05	0.1	0.2 km	WEE
		1:2,000		S
35167 3	मुल्यनिधारम		500+1	



Officer Appointed U/s 21(4A) Draft Revised Development Plan of Mira Bhayandar



(Pl	ublished U/s.28(4) of	WI.R.& I.P. ACT 196	)
KEY MAP	01 02 03		GRID NO.42
	04 05 06 07 Khari	08	
Raimurdi	10 11 12 18 10 11 20 21 Godden	14 15 16	
17 2	18 19 Bhayandar C Murdhe 25 7 28	27 $23$ $2429$ $30$ $3$ $3232$	33 34
5	38	39 Mira	
	46 47 48	49 50 51 52	53 54 55
		Mahajanwadi Kashi	59 60 61
		62 68	64 65
		66	67
			Scale: N.T.S
Legends	Delinicus	Department	
Road MH National Highway Ew Expressway	Religious T Temple Mosque	Reservations HFD Housing for Dishoused	Shopping Center
Major City Road Rail	I Idgah	Housing for Economically Weaker Section (EWS)/LIG	Municipal Market
Hero Station	GD Gurudwara	URS Purpose           URS Purpose           Pap No.           Project Affected Person	Fish Market Hawkers Market
Metroline Bridges	ASH Ashram	Women Hostel/ Child Care Center	Public Utilities
Over Bridge	Garden	Tribal Hostel	(SH) Slaughter House (STP) Sewage Treatment Plant
Road Bridge across Rail	PG Play Ground SPC Sports Centre	Garden (Ro) Playground	Step         Sewage Treatment Plant           WWW         Water Works
Proposed Flyover     Elevated Coastal Road	Sewage Pumping Station	PK Park	Burial/Cremation Ground/ Cemetery
Elevated Proposed Road	STP         SewageTreatment Plant           Elevated & Ground         Elevated & Ground	Mangrove Park	Bus Stand/Depot
Water Bodies River River	Storage Reservoir Crematorium/Burial Ground/ Cemetery	Exhibition Center	Bus Terminal & Parking
Lake Lake Ponds	Electric Sub-Station BP Bio Gas Plant	Institute for Fisheries	Multipurpose Parking/ Parking
Nalla Covered Nalla	Transportation Bus Stand/Terminus	Educational Amenity	ISBT Terminus
Residential Residential Area	RST Railway Station RTA Railway Track Area	School for Specially Abled	WT Water Terminal
R-R Restricted - Residential R-R1 Restricted - Residential 1	Pas/Paa Parking Space/Area	MAN No Medical Amenity	Transport Hub
Commercial Sc Shopping Centre/Mall	No Development Zone	More Municipal Office	Ext. No.
Market (Daily & Weekly)	No Development Zone  Notional Park(SGNP) Forest Zone(SGNP)	Municipal Purpose	Open Theatre
Industrial Industrial Area	Mangrove Buffer	Municipal Godown	Open Market Parking and Swimming Pool
Education PS/SS Primary & Secondary School	- Intertidal CRZ II	Library Theorem Hall & Drama	Swimming Pool Reservation Status
College Health Services	Eco-Sensitive Zone	Auditorium	Developed
н Hospital инс Urban Health Centre	Eco-Sensitive Zone Boundary Power	Planetarium & Aquarium	Not Developed Modification
Central /State Govt Property C/SG(Q) Quarter		Community Hall	M Proposed Modification
CISGO) Office Railway Property	Boundaries	FBS No.       Fire Brigade Station         Administrative Building	CZMP Lines
Railway Property Public & Semi-Public	Municipal Corporation Boundar	No.         For Govt.office           y         Government Purpose	High Tide Line
Auditorium/Drama Theatre	Cillage Boundary	Night Shelter	Intertidal     Mangrove Buffer
Swc Social Welfare Centre	CTS Area Boundary Congested Boundary	Old Age Home	Mangroves Mangroves
Fire Station		PA No SbC Skill Development Center	
Police Station/Chowky Heritage	Cadastre/CTS Building Footprint	Sbc         Skill Development Center           PCO         Police Commissioner Official	
Fort Fort	Building Footprint	N05	
<b>Notes</b> 1.The Base Map, ELU and Draft Pl	U prepared by superimposition of	f data collected from various	Government / Semi

1.The Base Map, ELU and Draft PLU prepared by superimposition of data collected from various Government / Semi Government / Departments / Stakeholders and physical features depicted from Drone / Satellite Imagery; hence, the discrepancies may occur.

2. Proposed Land-use Shall prevail irrespective of property number / boundary shown on map which shall be subject to confirmation from Land Record or competent Authority.

3. The structure on the map does not confirm authorization unless verified and rectified by Planning Authority. 4.SGNP, CRZ, Mangroves with their buffers shown on the plan shall be as per the relevant status. In case of any modifications to such status in future, such boundary and buffer shall automatically stand modified as per the latest notification. 5. The alignment of Metro, Coastal Elevated Road marked on plan are indicative & automatically stand modified by the notification issued by Government from time to time.

6.The alignment of nallah / river / creek is indicative and as per the feature extracted from Drone Imagery and data collected. 7. The boundaries of all the designated sites, Government property are shown as per the image captured by superimposition on cadastral map. This may be subject to change as per the actual acquisition in future. 8.This plan is to be read with UDCPR-2022 and Draft DP Report.


9.Existing road shall have status of the road according to width of road even though not shown in development plan. 10.R-R(Restricted-Residential) Residential Zone subject to handing over area to corporation as per permission/Government orders.


11.R-R1 (Restricted- Residential1) All provision of Residential Zone in UDCPR-2020 will be applicable for this zone subject to 10% of area under Development should be kept for Amenity Space as per direction of Municipal Commissioner with prior permission from Eco-Sensitive Zone Commitee.

12.If the location of Metro Carshed and Metro Line is shifted by MMRDA or Elevated Road is shifted in future, the land eleased by such shifting shall stands included in adjoining Zone shown on Development Plan.

Scale				North	N
0	0.05	0.1	0.2 km		WEE
		1:2,000			S
351801	मुल्यनिधारिष				

Officer Appointed U/s 21(4A) ★ Draft Revised Development Plan of Mira Bhayandar

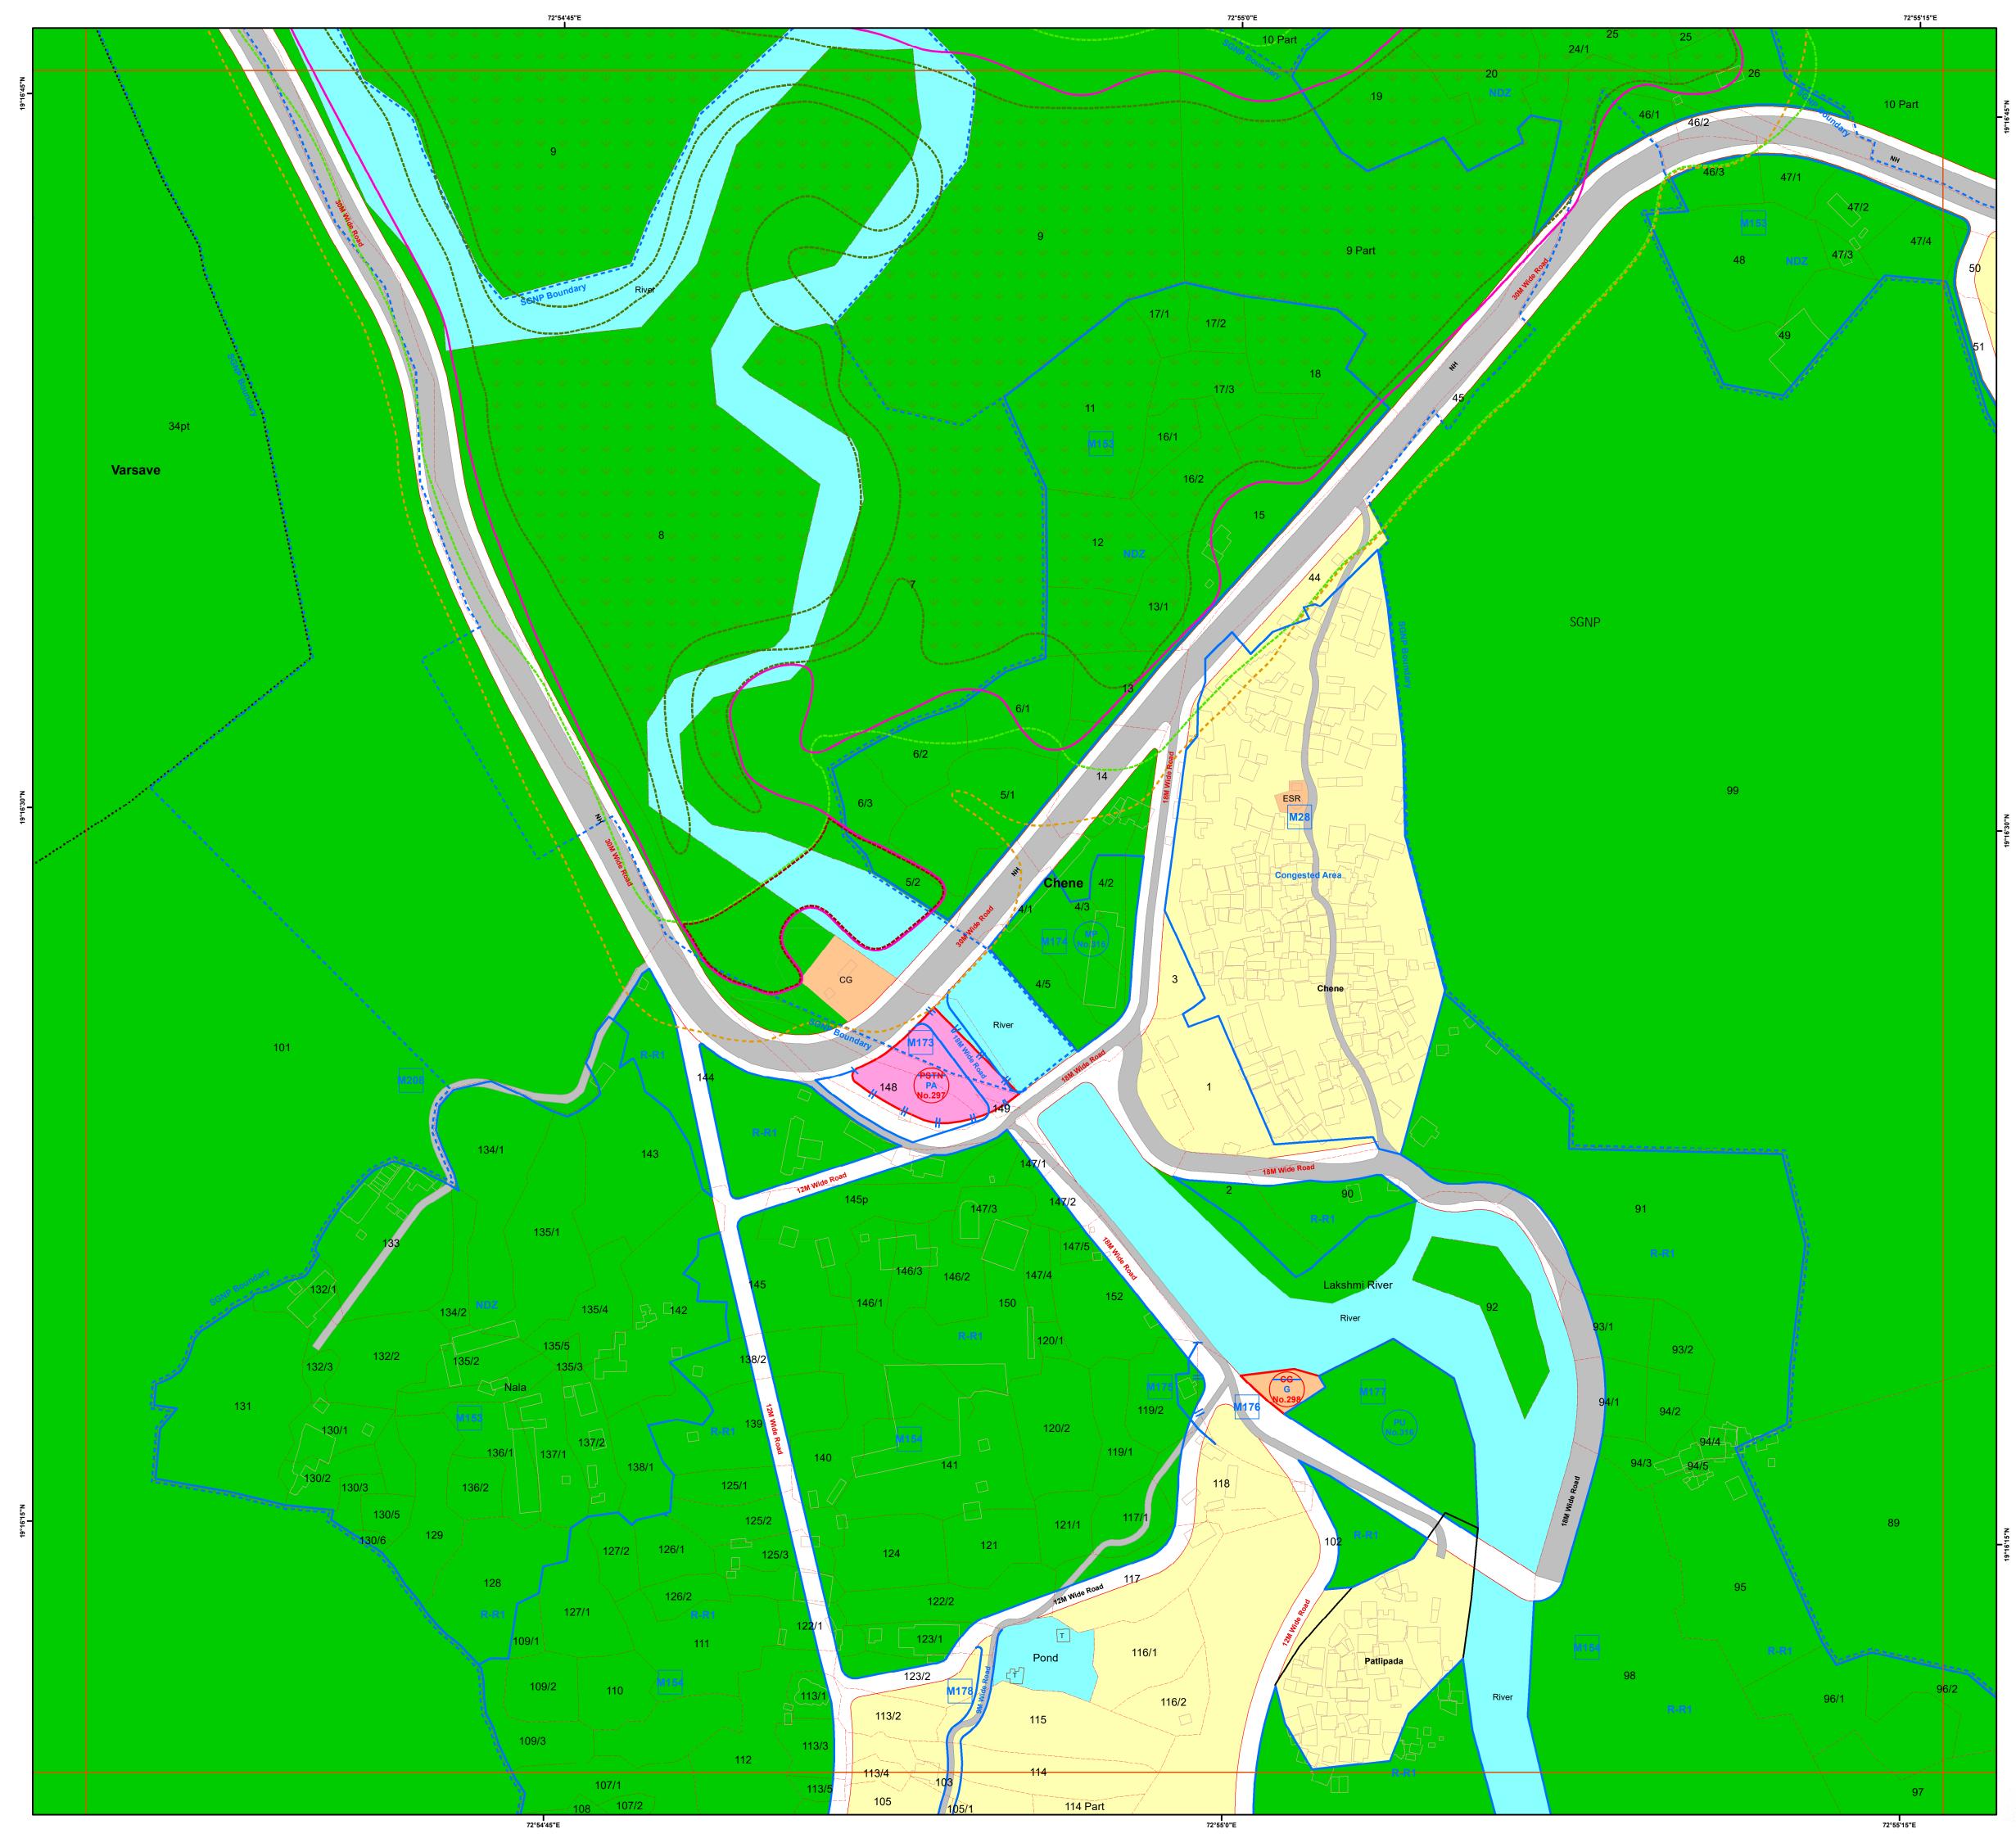

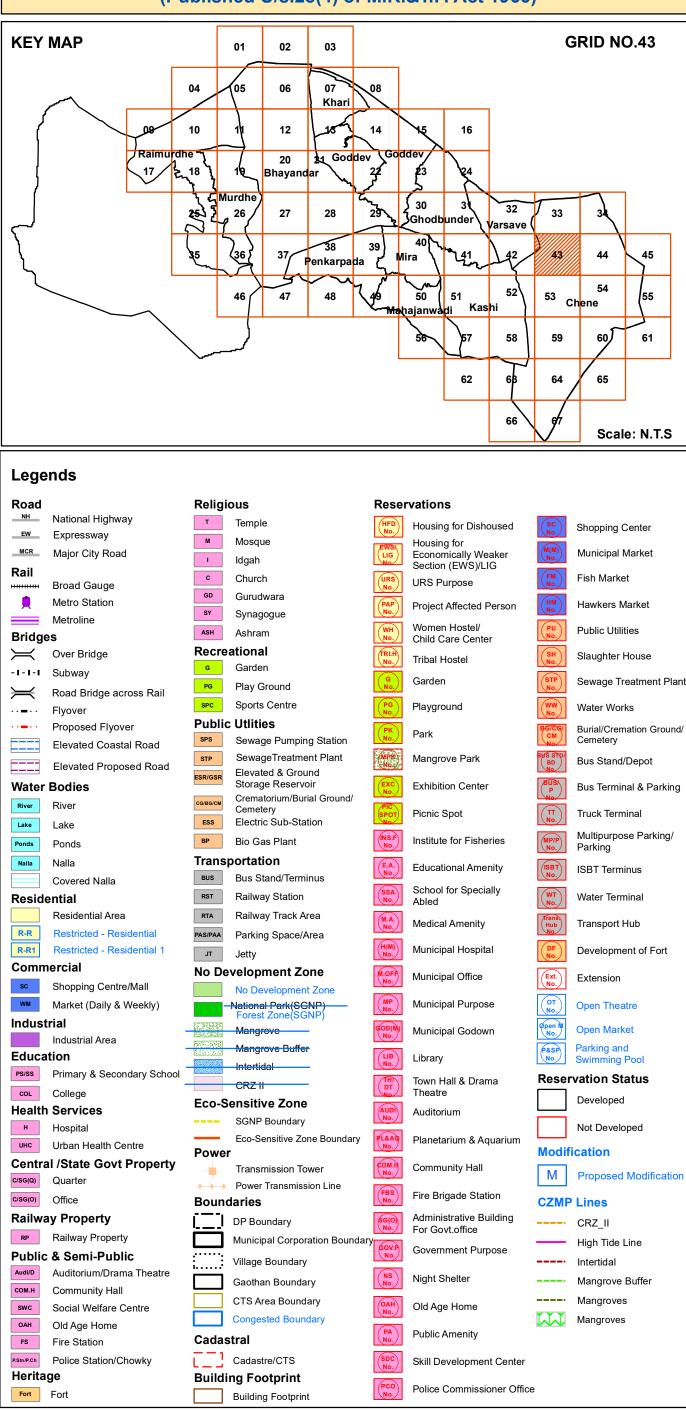

#### Notes

1.The Base Map, ELU and Draft PLU prepared by superimposition of data collected from various Government / Semi Government / Departments / Stakeholders and physical features depicted from Drone / Satellite Imagery; hence, the discrepancies may occur.

2.Proposed Land-use Shall prevail irrespective of property number / boundary shown on map which shall be subject to confirmation from Land Record or competent Authority.

3.The structure on the map does not confirm authorization unless verified and rectified by Planning Authority.
4.SGNP, CRZ, Mangroves with their buffers shown on the plan shall be as per the relevant status. In case of any modifications to such status in future, such boundary and buffer shall automatically stand modified as per the latest notification.
5.The alignment of Metro, Coastal Elevated Road marked on plan are indicative & automatically stand modified by the notification issued by Government from time to time.
6.The alignment of nallah / river / creek is indicative and as per the feature extracted from Drone Imagery and data collected.

7.The boundaries of all the designated sites, Government property are shown as per the image captured by superimposition on cadastral map. This may be subject to change as per the actual acquisition in future.
8.This plan is to be read with UDCPR-2022 and Draft DP Report.

9.Existing road shall have status of the road according to width of road even though not shown in development plan.
10.R-R(Restricted-Residential) Residential Zone subject to handing over area to corporation as per permission/Government orders.
11.R-R1 (Restricted- Residential1) All provision of Residential Zone in UDCPR-2020 will be applicable for this zone subject to

10% of area under Development should be kept for Amenity Space as per direction of Municipal Commissioner with prior permission from Eco-Sensitive Zone Commitee.

12.If the location of Metro Carshed and Metro Line is shifted by MMRDA or Elevated Road is shifted in future, the land released by such shifting shall stands included in adjoining Zone shown on Development Plan.


Scale				North N
0	0.05	0.1	0.2 km	WEE
		1:2,000		S
31101	मुल्यनिधारिष			





Officer Appointed U/s 21(4A)

Draft Revised Development Plan of Mirá Bhayandar

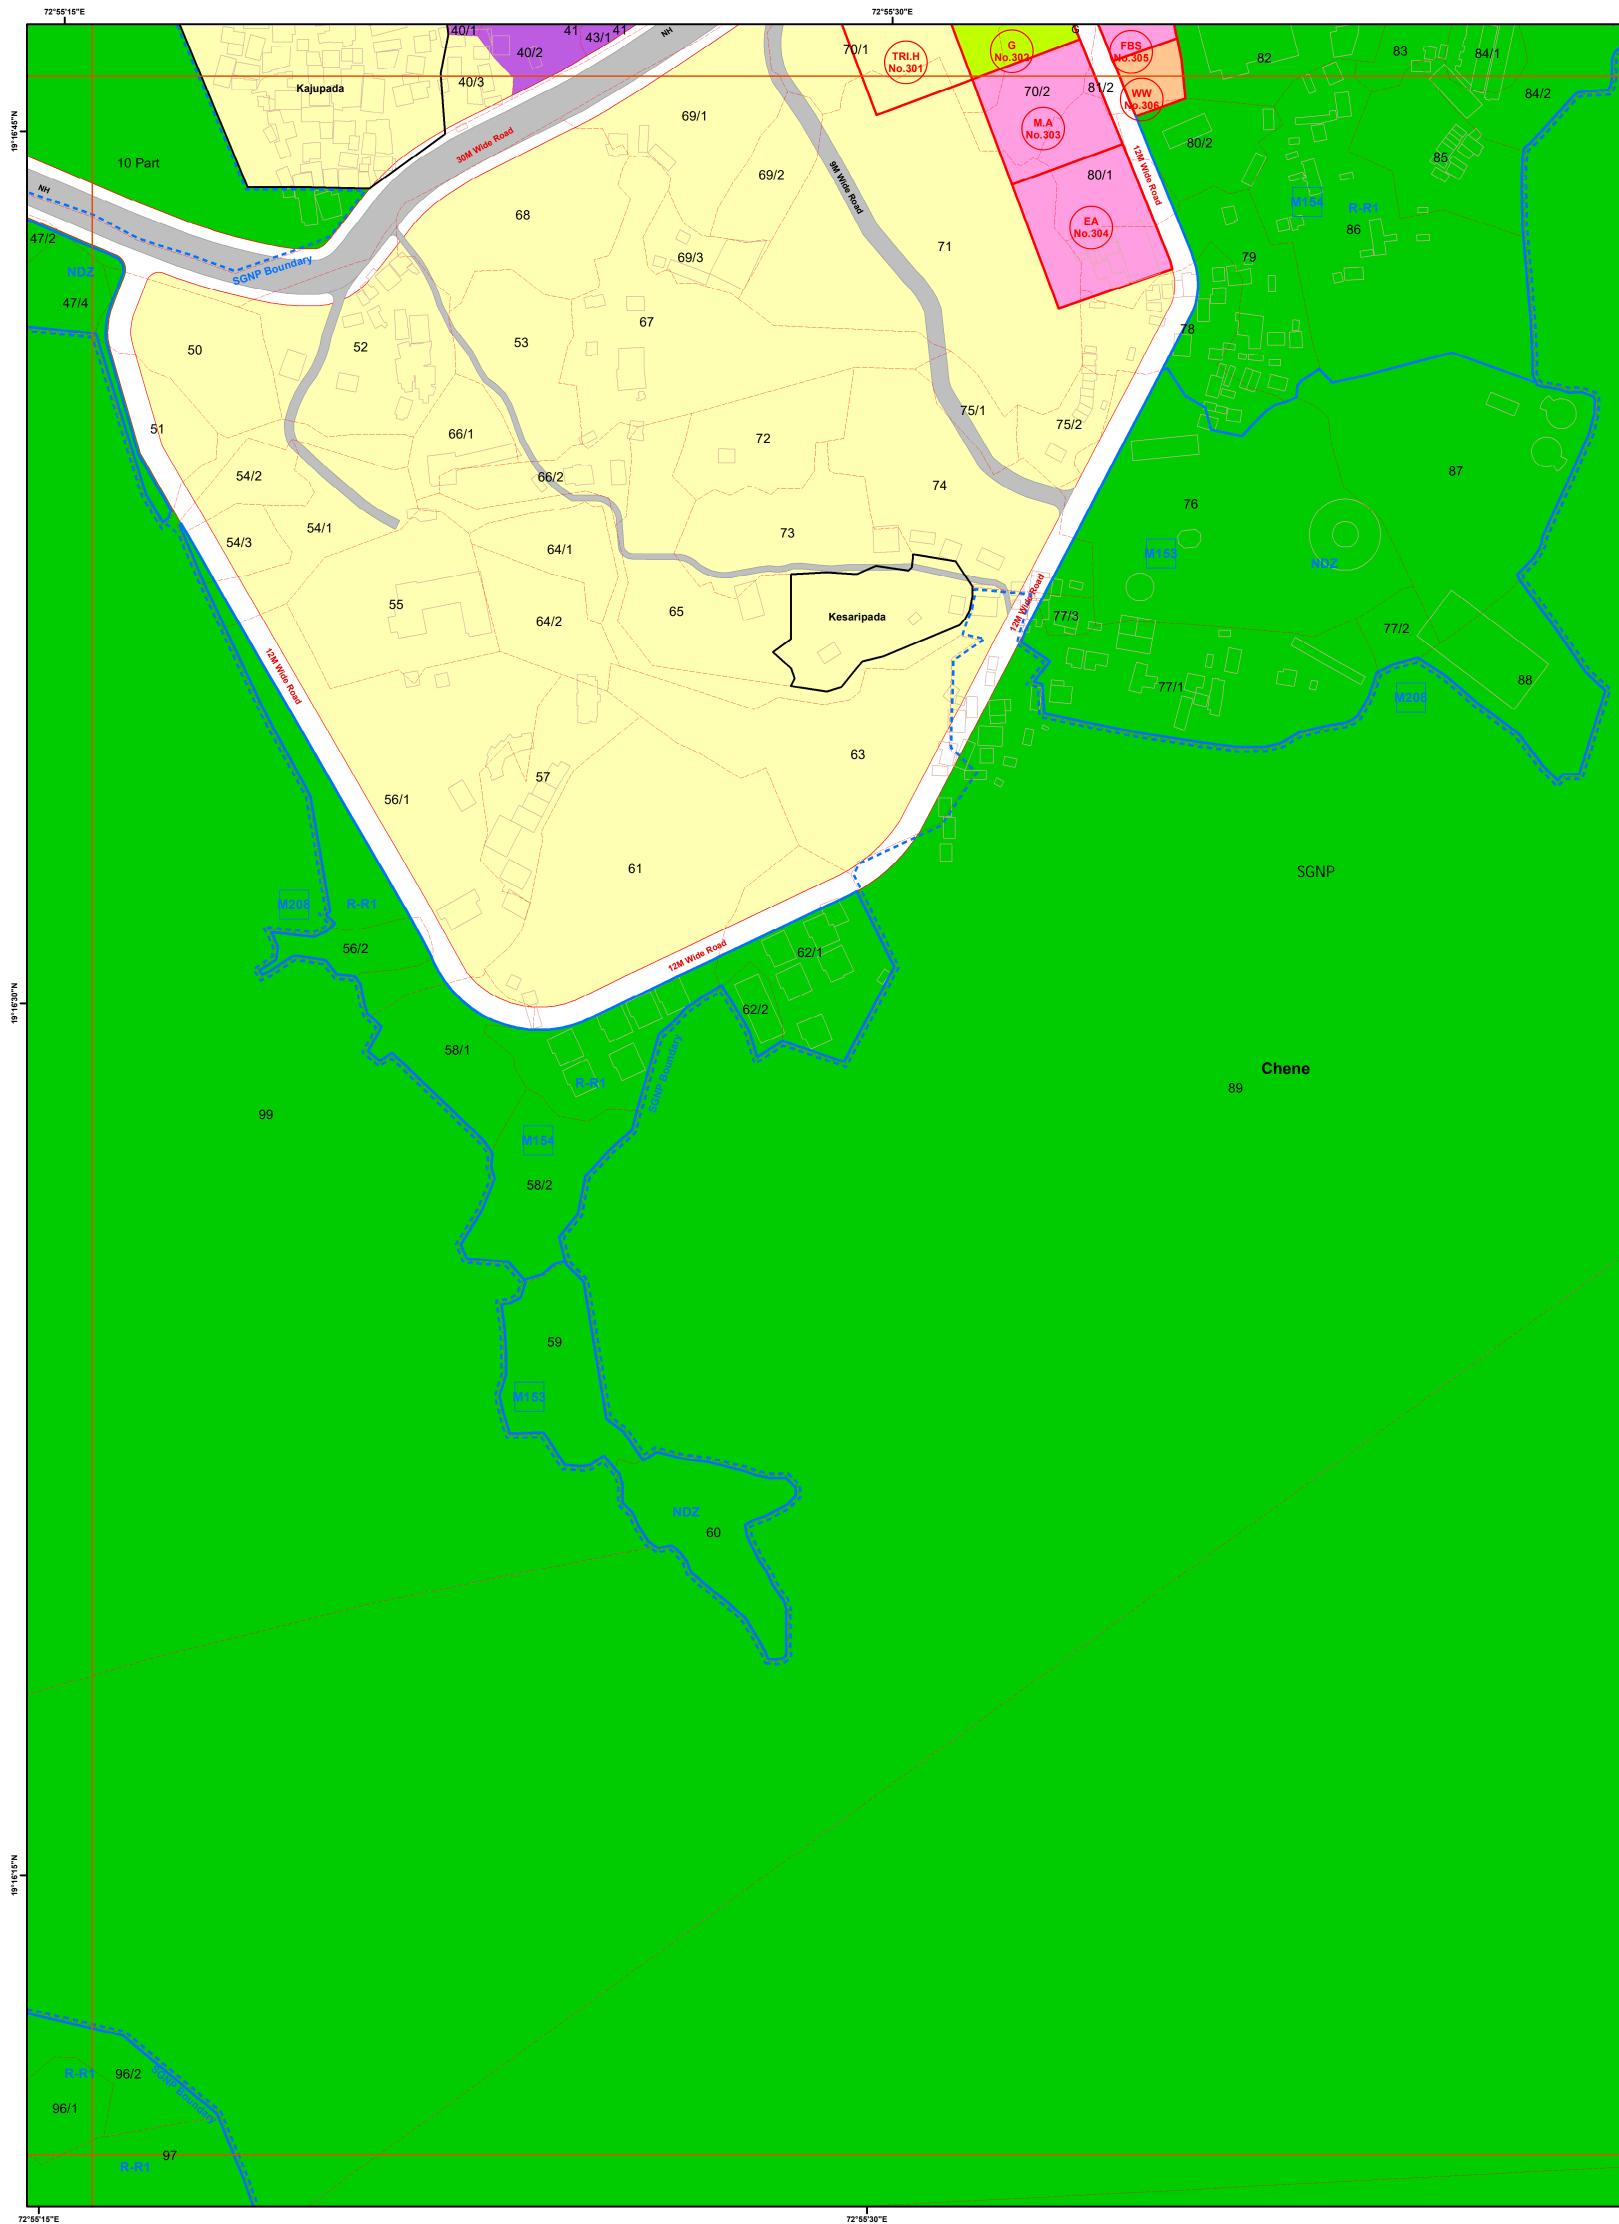

89 Part

72°55'45"E

89 Part

72°55'45"E

### DRAFT REVISED DEVELOPMENT PLAN Mira Bhayandar Municipal Corporation (Published U/s.28(4) of M.R.&T.P. Act 1966)



notification issued by Government from time to time.

6. The alignment of nallah / river / creek is indicative and as per the feature extracted from Drone Imagery and data collected. 7. The boundaries of all the designated sites, Government property are shown as per the image captured by superimposition on cadastral map. This may be subject to change as per the actual acquisition in future.

8. This plan is to be read with UDCPR-2022 and Draft DP Report.

9. Existing road shall have status of the road according to width of road even though not shown in development plan. 10.R-R(Restricted-Residential) Residential Zone subject to handing over area to corporation as per permission/Government


11.R-R1 (Restricted- Residential1) All provision of Residential Zone in UDCPR-2020 will be applicable for this zone subject to 10% of area under Development should be kept for Amenity Space as per direction of Municipal Commissioner with prior permission from Eco-Sensitive Zone Commitee.


12.If the location of Metro Carshed and Metro Line is shifted by MMRDA or Elevated Road is shifted in future, the land released by such shifting shall stands included in adjoining Zone shown on Development Plan.

S	cale			North N
0	0.05	0.1	0.2 km	WEE
		1:2,000		S
	असित मुल्यनिभूमिव		62041	·




Officer Appointed U/s 21(4A) Draft Revised Development Plan of Mira Bhayandar

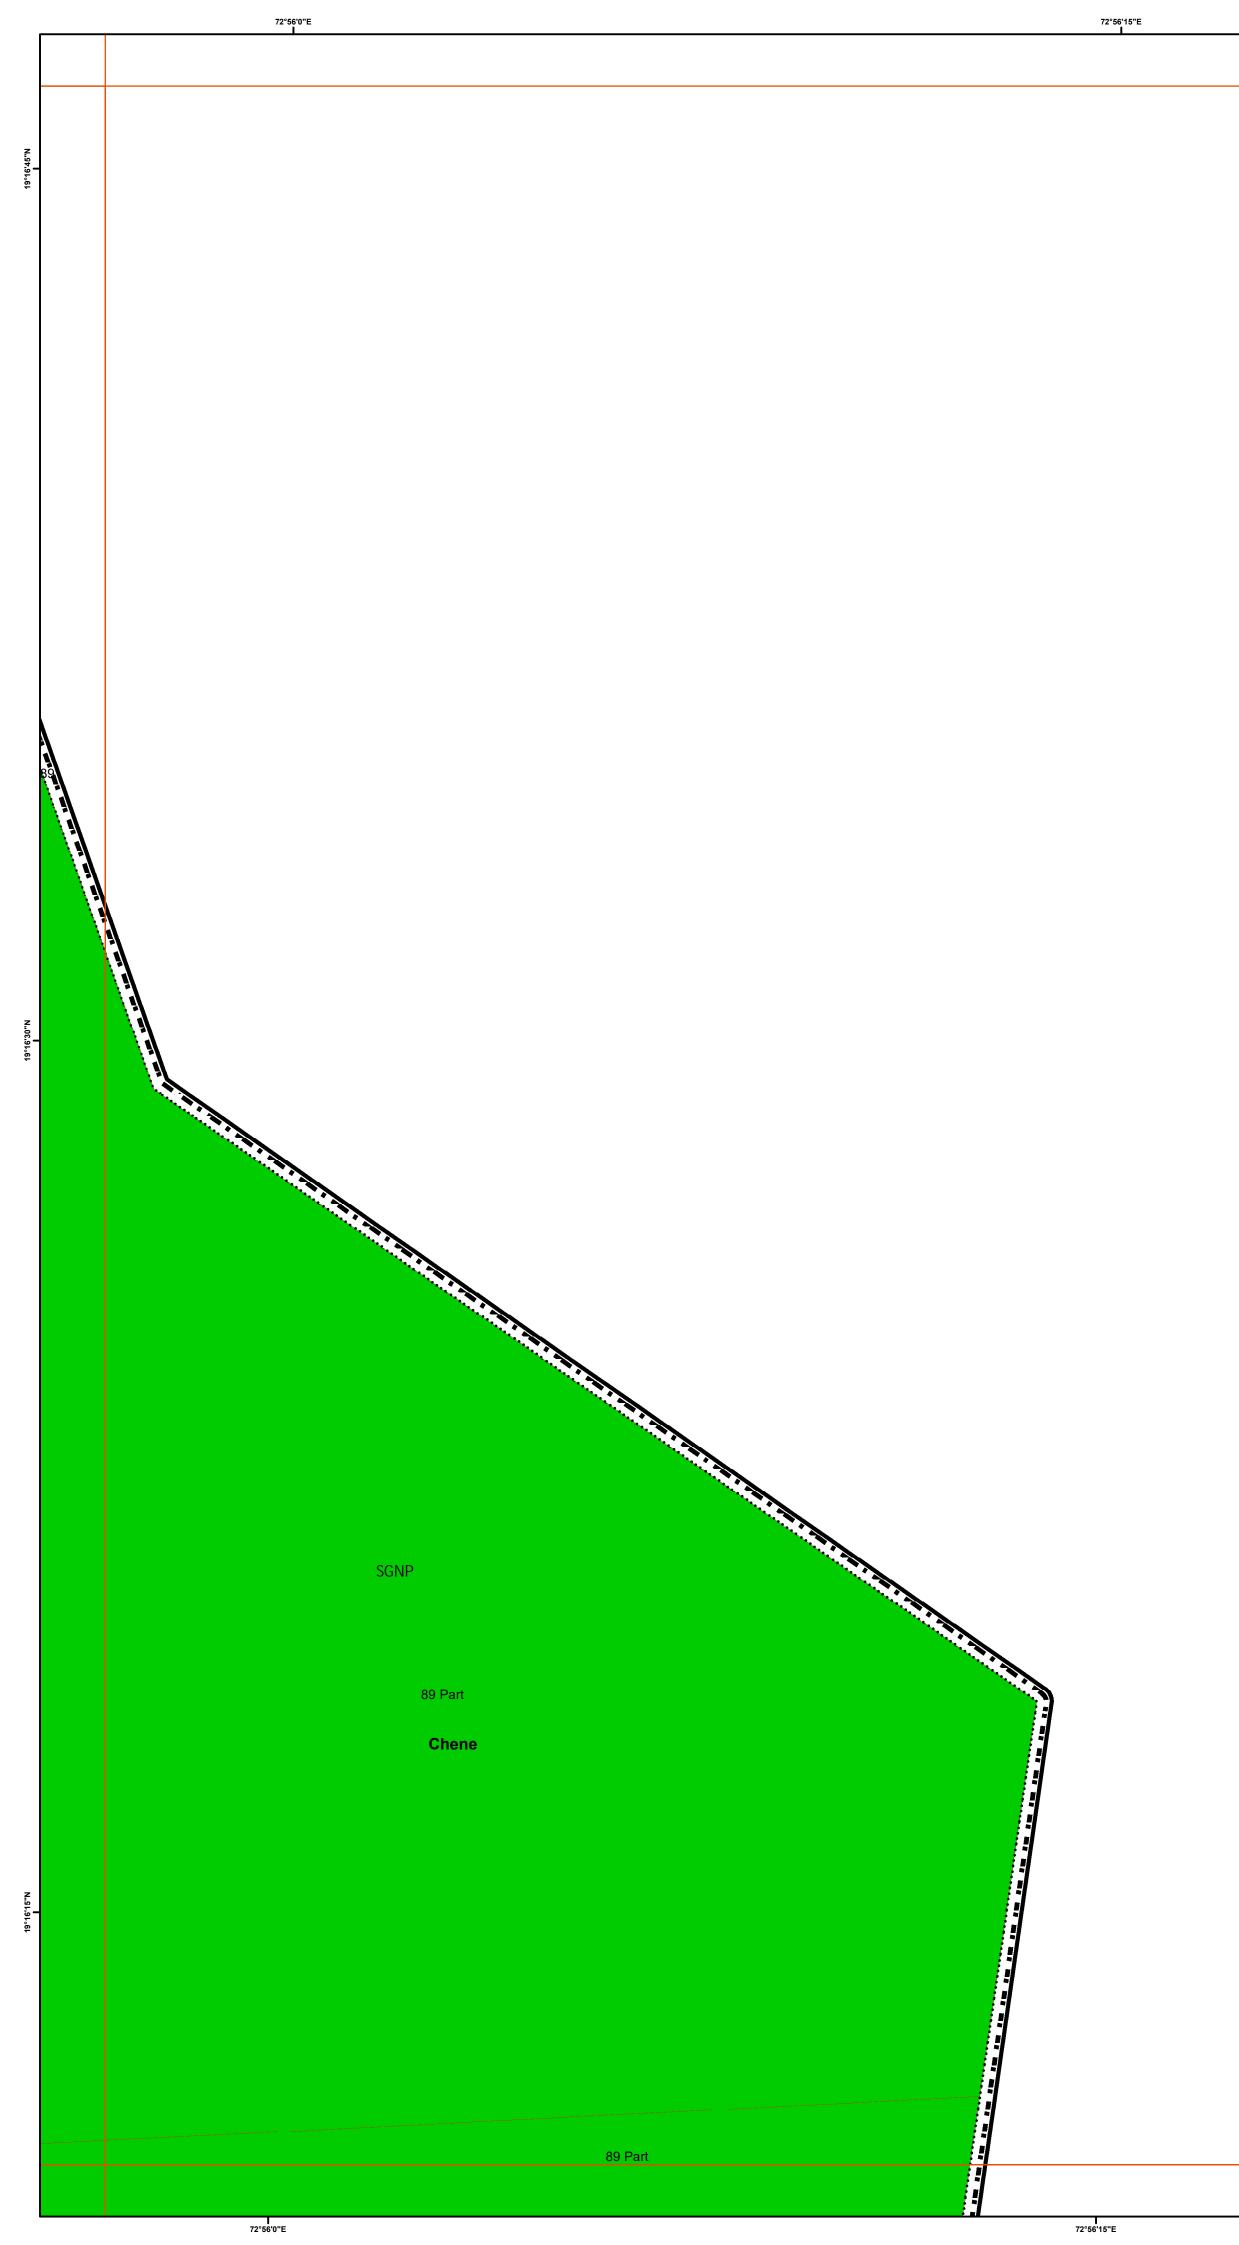

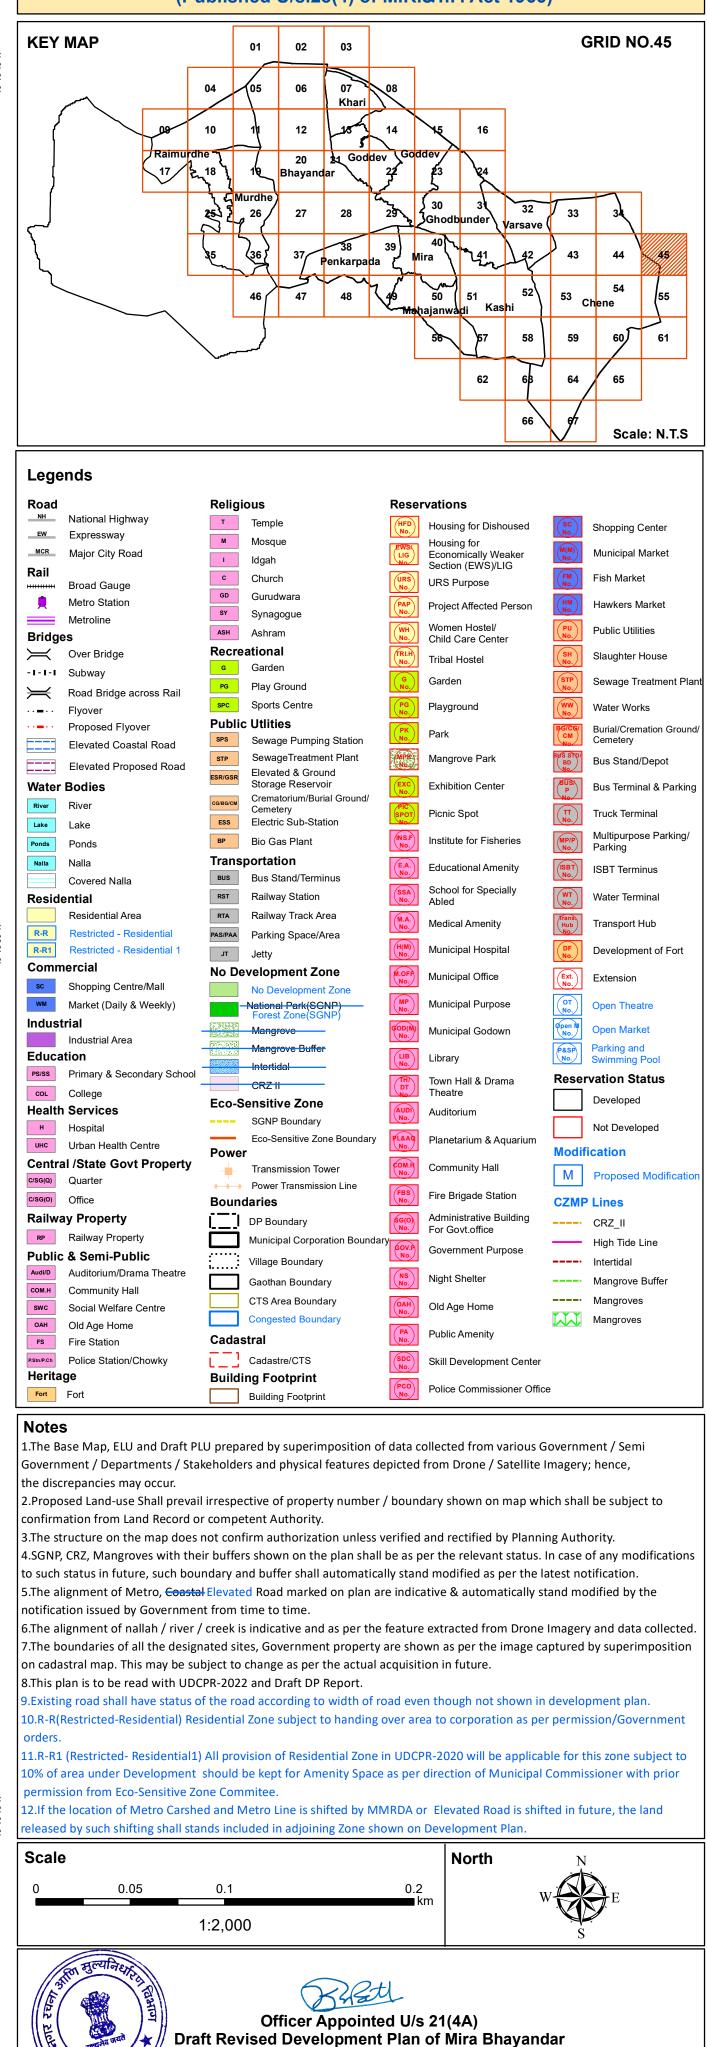

	 72°50'0"E
	V V V V
N0.	
19°16'0"N I	
19°15'45"N I	
19°15	
19°15'30"N 1	
-6	 <mark>і</mark> 72°50'0"Е

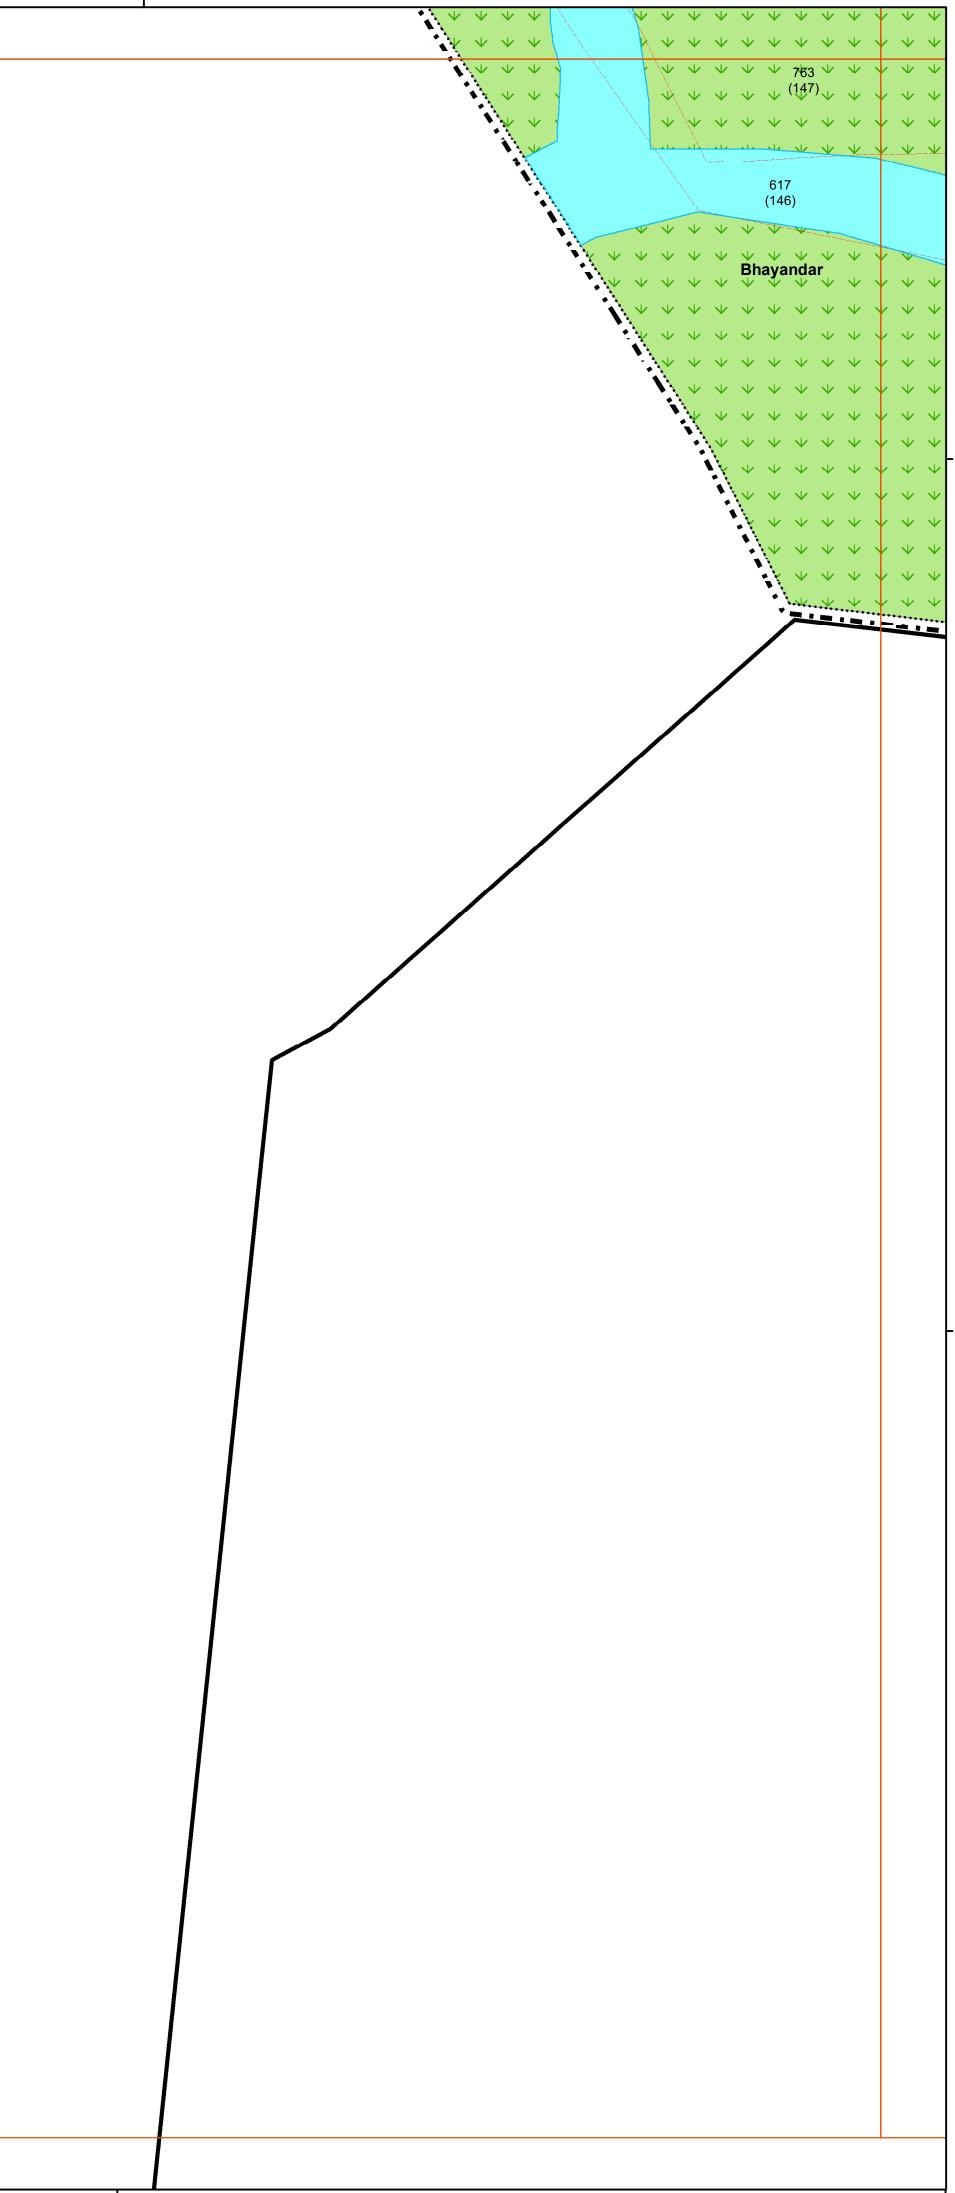



TO	मुल्यनि	The second	
्तु ।		Farmer	
	सार्यमेव जया	- 1 H	D
		TEAT	




1:2,000

Draft Revised Development Plan of Mira Bhayandar

19°15/35"N	N0,91-61



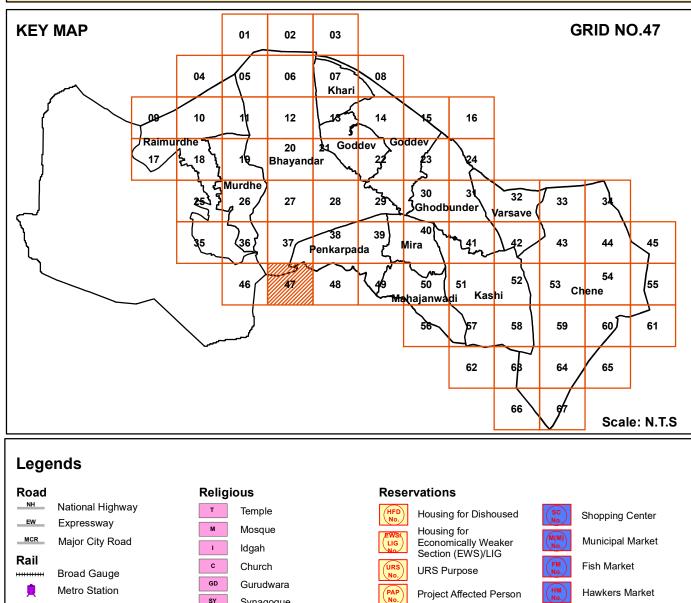

19°16'0"

Road	Religious	Rese	rvations		
National Highway	Temple	HFD No.	Housing for Dishoused	SC No.	Shopping Center
,	Mosque	EWSX	Housing for	(M(M)) No.	Municipal Market
Major City Road	Idgah		Economically Weaker Section (EWS)/LIG		
Hall Hinner Broad Gauge	Church	URS No.	URS Purpose	(FM No.	Fish Market
🚊 Metro Station	GD Gurudwara	(PAP No.)	Project Affected Person	HM No.	Hawkers Market
Metroline	sy Synagogue	WH	Women Hostel/		Public Utilities
Bridges	ASH Ashram	No.	Child Care Center		
─────────────────────────────────────	Garden	TRI.H No.	Tribal Hostel	SH No.	Slaughter House
-I-I-I Subway	PG Play Ground	G No.	Garden	STP No.	Sewage Treatment Pla
Road Bridge across Rail	spc Sports Centre		Playground	ww	Water Works
Flyover     Proposed Elvover	Public Utlities	PG No.	riayground	No.	
Proposed Flyover     Elevated Coastal Road	Sewage Pumping Station	(PK No.)	Park	BG/CG/ CM	Burial/Cremation Groun Cemetery
	SewageTreatment Plant	MPR	Mangrove Park	BUS STD/ BD No	Bus Stand/Depot
Elevated Proposed Road	Elevated & Ground Storage Reservoir				
Water Bodies	Crematorium/Burial Ground/	EXC No.	Exhibition Center	BUS/ P	Bus Terminal & Parking
River River	Cemetery	SPOT	Picnic Spot	TT No.	Truck Terminal
Lake		(INS.F)	Institute for Fisheries		Multipurpose Parking/
Ponds Ponds	Bio Gao Fiant	No.	Institute for Fishenes	MP/P No.	Parking
Nalla Nalla	Transportation Bus Stand/Terminus	E.A. No.	Educational Amenity	ISBT No.	ISBT Terminus
Covered Nalla	RST Railway Station	SSA	School for Specially	WT	Water Terminal
Residential Residential Area	RTA Railway Track Area	No.	Abled	WT No.	
R-R Restricted - Residential	PAS/PAA Parking Space/Area	(M.A. No.	Medical Amenity	Hub No	Transport Hub
R-R1 Restricted - Residential 1	JT Jetty	(H(M)) No.	Municipal Hospital	DF No.	Development of Fort
Commercial	No Development Zone	M.OFF			
sc Shopping Centre/Mall	No Development Zone	No.	Municipal Office	(Ext. No.	Extension
Market (Daily & Weekly)	National Park(SCNP)	MP No.	Municipal Purpose	OT No.	Open Theatre
Industrial	Forest Zone(SGNP)	GOD(M)	Municipal Godown	Øpen M No.	Open Market
Industrial Area	Mangrove Buffer	No.		P&SP	Parking and
Education	Intertidal		Library	No.	Swimming Pool
Ps/ss Primary & Secondary School	CRZII	(TH) DT	Town Hall & Drama	Rese	rvation Status
College	Eco-Sensitive Zone	AUDI	Theatre		Developed
Hospital	SGNP Boundary	No.	Auditorium		Not Developed
Urban Health Centre	Eco-Sensitive Zone Boundary	PL&AQ	Planetarium & Aquarium		
Central /State Govt Property	Power		Community Hall	Modif	ication
c/sq(q) Quarter	Transmission Tower      Power Transmission Line	COM.H No.		М	Proposed Modification
C/SG(0) Office	Boundaries	(FBS No.	Fire Brigade Station	CZMF	P Lines
Railway Property	DP Boundary	SG(O) No.	Administrative Building		
RP Railway Property	Municipal Corporation Bounda	arv	For Govt.office		High Tide Line
Public & Semi-Public	Village Boundary	GOV.P No.	Government Purpose		Intertidal
Auditorium/Drama Theatre		NS No.	Night Shelter		Mangrove Buffer
сом.н Community Hall	Gaothan Boundary		rught onotor		0
swc Social Welfare Centre	CTS Area Boundary	(OAH No.	Old Age Home	YYY	Mangroves
Old Age Home	Congested Boundary	PA No.	Public Amenity		Mangroves
FS Fire Station	Cadastral				
Police Station/Chowky	Cadastre/CTS		Skill Development Center		
Heritage	Building Footprint				

#### Notes

1.The Base Map, ELU and Draft PLU prepared by superimposition of data collected from various Government / Semi Government / Departments / Stakeholders and physical features depicted from Drone / Satellite Imagery; hence, the discrepancies may occur.

2.Proposed Land-use Shall prevail irrespective of property number / boundary shown on map which shall be subject to confirmation from Land Record or competent Authority.

3.The structure on the map does not confirm authorization unless verified and rectified by Planning Authority.
4.SGNP, CRZ, Mangroves with their buffers shown on the plan shall be as per the relevant status. In case of any modifications to such status in future, such boundary and buffer shall automatically stand modified as per the latest notification.
5.The alignment of Metro, Coastal Elevated Road marked on plan are indicative & automatically stand modified by the notification issued by Government from time to time.
6.The alignment of nallah / river / creek is indicative and as per the feature extracted from Drone Imagery and data collected.

7.The boundaries of all the designated sites, Government property are shown as per the image captured by superimposition on cadastral map. This may be subject to change as per the actual acquisition in future.
8.This plan is to be read with UDCPR-2022 and Draft DP Report.

9.Existing road shall have status of the road according to width of road even though not shown in development plan.
10.R-R(Restricted-Residential) Residential Zone subject to handing over area to corporation as per permission/Government orders.

11.R-R1 (Restricted- Residential1) All provision of Residential Zone in UDCPR-2020 will be applicable for this zone subject to 10% of area under Development should be kept for Amenity Space as per direction of Municipal Commissioner with prior permission from Eco-Sensitive Zone Commitee.

12.If the location of Metro Carshed and Metro Line is shifted by MMRDA or Elevated Road is shifted in future, the land released by such shifting shall stands included in adjoining Zone shown on Development Plan.


Scale				North N
0	0.05	0.1	0.2 km	WEE
		1:2,000		S
3510	मुल्यनिधारम		DRt.	





&



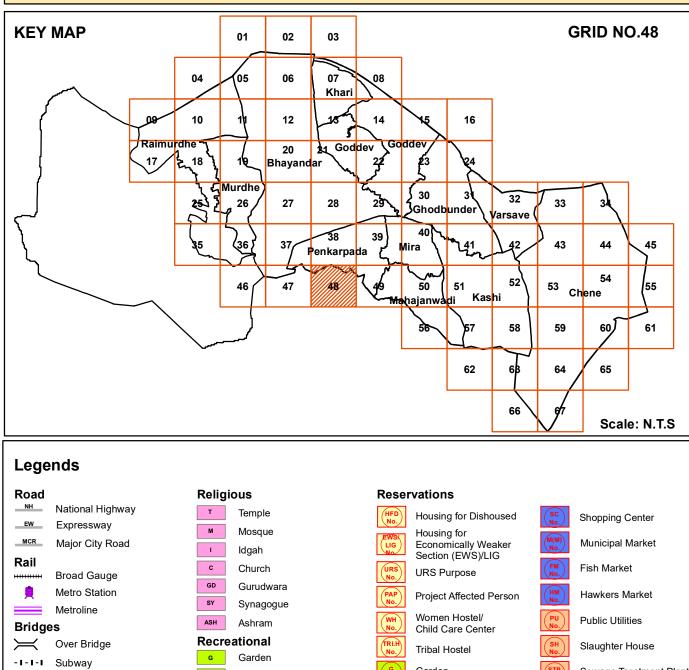

9°16'0"N

Sewage Treatment Pla Garden Play Ground Road Bridge across Rail SPC Sports Centre Water Works Playground ··•· Flyover **Public Utlities** ··· Proposed Flyover Burial/Cremation Grou BG/CG/ (CM) Park Sewage Pumping Station Cemetery Elevated Coastal Road MPR SewageTreatment Plant STP Bus Stand/Depot Mangrove Park Elevated Proposed Road Elevated & Ground SR/GSR Storage Reservoir (BUS) P Water Bodies Exhibition Center Bus Terminal & Parking Crematorium/Burial Ground/ CG/BG/CM River River Truck Terminal Cemetery Picnic Spot Electric Sub-Station Lake Lake Multipurpose Parking Parking BP Bio Gas Plant Institute for Fisheries Ponds Ponds Parking Nalla Nalla Transportation Educational Amenity ISBT Terminus Bus Stand/Terminus Covered Nalla School for Specially Abled WT RST Railway Station Water Terminal Residential RTA Railway Track Area **Residential Area** (M.A.) Hub Medical Amenity Transport Hub R-R Pas/Paa Parking Space/Area Restricted - Residential (H(M)) Municipal Hospital R-R1 Restricted - Residential Jт Jetty Development of Fort Commercial Municipal Office No Development Zone Extension sc Shopping Centre/Mall No Development Zon Municipal Purpose Market (Daily & Weekly) -National Park(SCNP) Open Theatre Industrial Mangrove Municipal Godown Open Market Industrial Area Parking and Swimming Pool Mangrove Buffer LIB No. Library Education Intertidal Ps/ss Primary & Sec Town Hall & Drama Reservation Status CRZ II College Theatre Developed Eco-Sensitive Zone AUDI No. Health Services Auditorium SGNP Boundary Not Developed H Hospital Eco-Sensitive Zone Boundary Planetarium & Aquarium Urban Health Centre Modification Power Central /State Govt Property Community Hall ----- Transmission Tower M Proposed Modificati c/sg(Q) Quarter ← → Power Transmission Line Fire Brigade Station c/sg(0) Office CZMP Lines Boundaries Administrative Building For Govt.office DP Boundary Railway Property ---- CRZ\_II Municipal Corporation Boundary RP Railway Property High Tide Line Public & Semi-Public ---- Intertidal Auditorium/Drama Theatre Night Shelter Gaothan Boundary ---- Mangrove Buffer сом.н Community Hall CTS Area Boundary OAH No. Old Age Home ---- Mangroves swc Social Welfare Centre Mangroves Congested Boundary Old Age Home PA Public Amenity FS Fire Station Cadastral Skill Development Center Cadastre/CTS Police Station/Chowky Heritage **Building Footprint** Police Commissioner Office Fort Fort Building Footprint

#### Notes

1.The Base Map, ELU and Draft PLU prepared by superimposition of data collected from various Government / Semi Government / Departments / Stakeholders and physical features depicted from Drone / Satellite Imagery; hence, the discrepancies may occur.

2.Proposed Land-use Shall prevail irrespective of property number / boundary shown on map which shall be subject to confirmation from Land Record or competent Authority.

3.The structure on the map does not confirm authorization unless verified and rectified by Planning Authority.
4.SGNP, CRZ, Mangroves with their buffers shown on the plan shall be as per the relevant status. In case of any modifications to such status in future, such boundary and buffer shall automatically stand modified as per the latest notification.
5.The alignment of Metro, <del>Coastal Elevated</del> Road marked on plan are indicative & automatically stand modified by the notification issued by Government from time to time.
6.The alignment of nallah / river / creek is indicative and as per the feature extracted from Drone Imagery and data collected.
7.The boundaries of all the designated sites, Government property are shown as per the image captured by superimposition

on cadastral map. This may be subject to change as per the actual acquisition in future.

8.This plan is to be read with UDCPR-2022 and Draft DP Report.

9.Existing road shall have status of the road according to width of road even though not shown in development plan.
10.R-R(Restricted-Residential) Residential Zone subject to handing over area to corporation as per permission/Government orders.


11.R-R1 (Restricted- Residential1) All provision of Residential Zone in UDCPR-2020 will be applicable for this zone subject to 10% of area under Development should be kept for Amenity Space as per direction of Municipal Commissioner with prior permission from Eco-Sensitive Zone Commitee.

12.If the location of Metro Carshed and Metro Line is shifted by MMRDA or Elevated Road is shifted in future, the land released by such shifting shall stands included in adjoining Zone shown on Development Plan.

Scale				North N
0	0.05	0.1	0.2 km	WEE
		1:2,000		S
100 Martin	सुल्यनिः अत्य		Rifett	·


Officer Appointed U/s 21(4A) ★ Draft Revised Development Plan of Mira Bhayandar



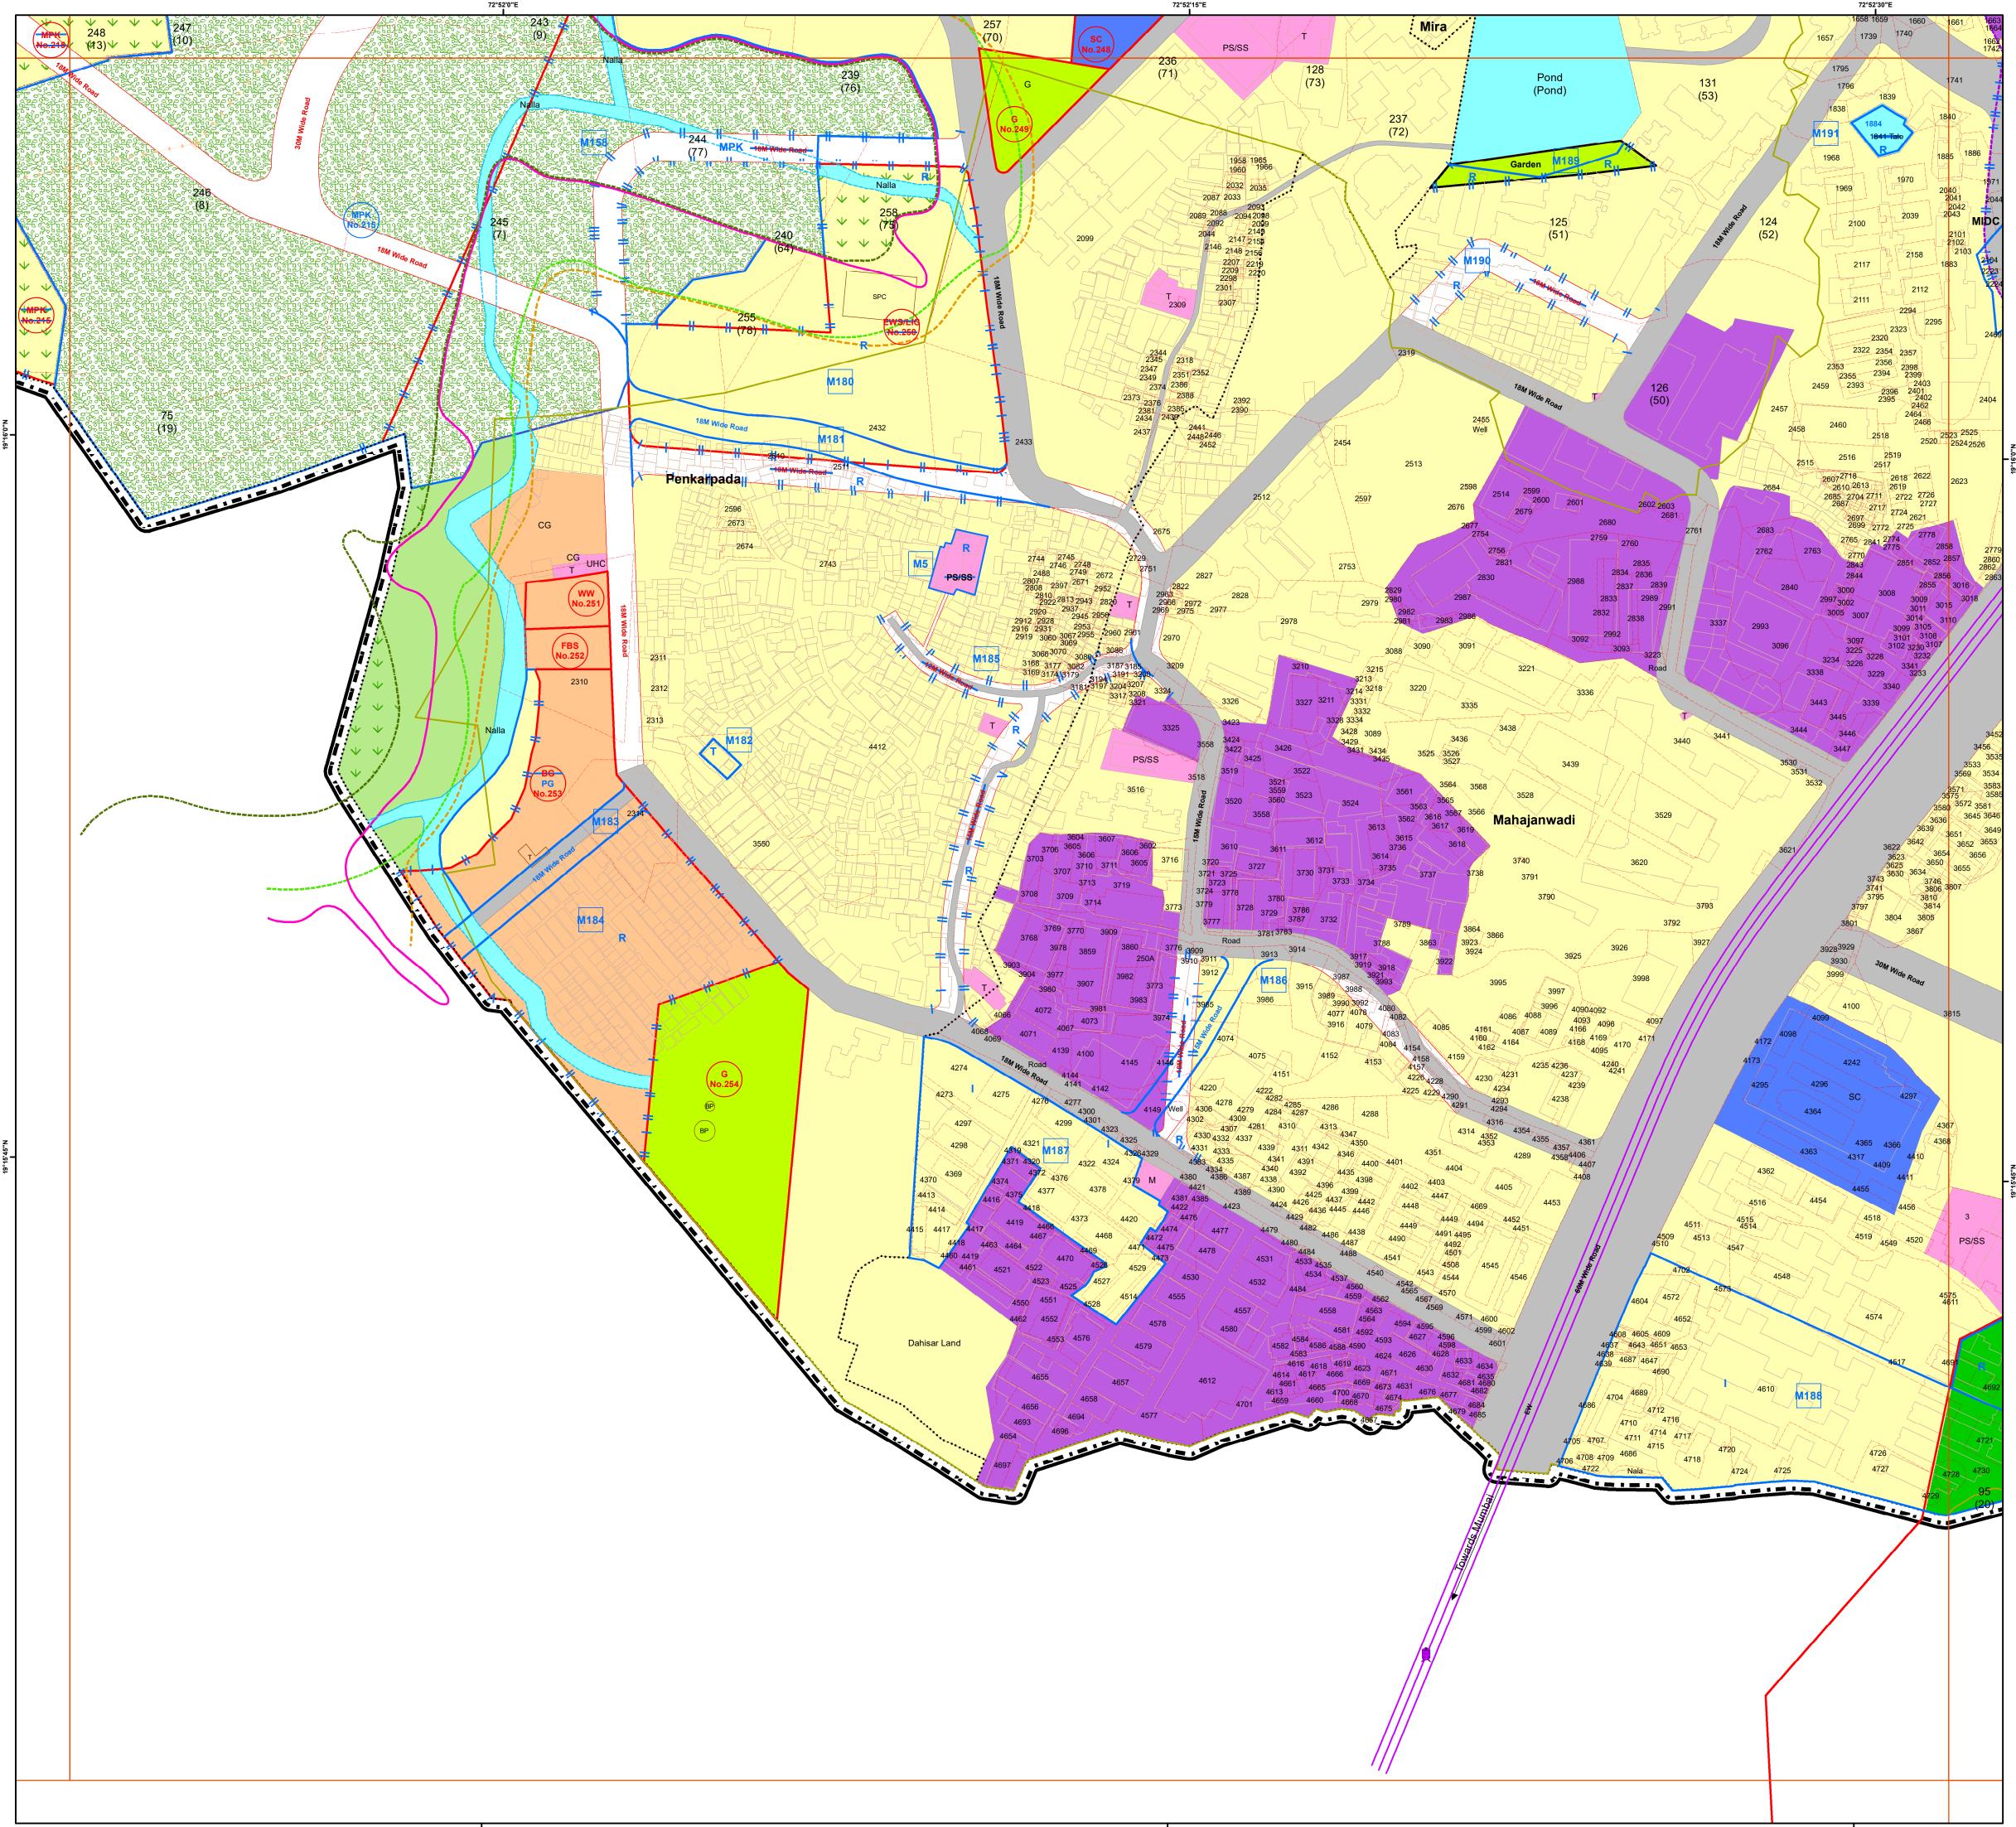

мрс

3583

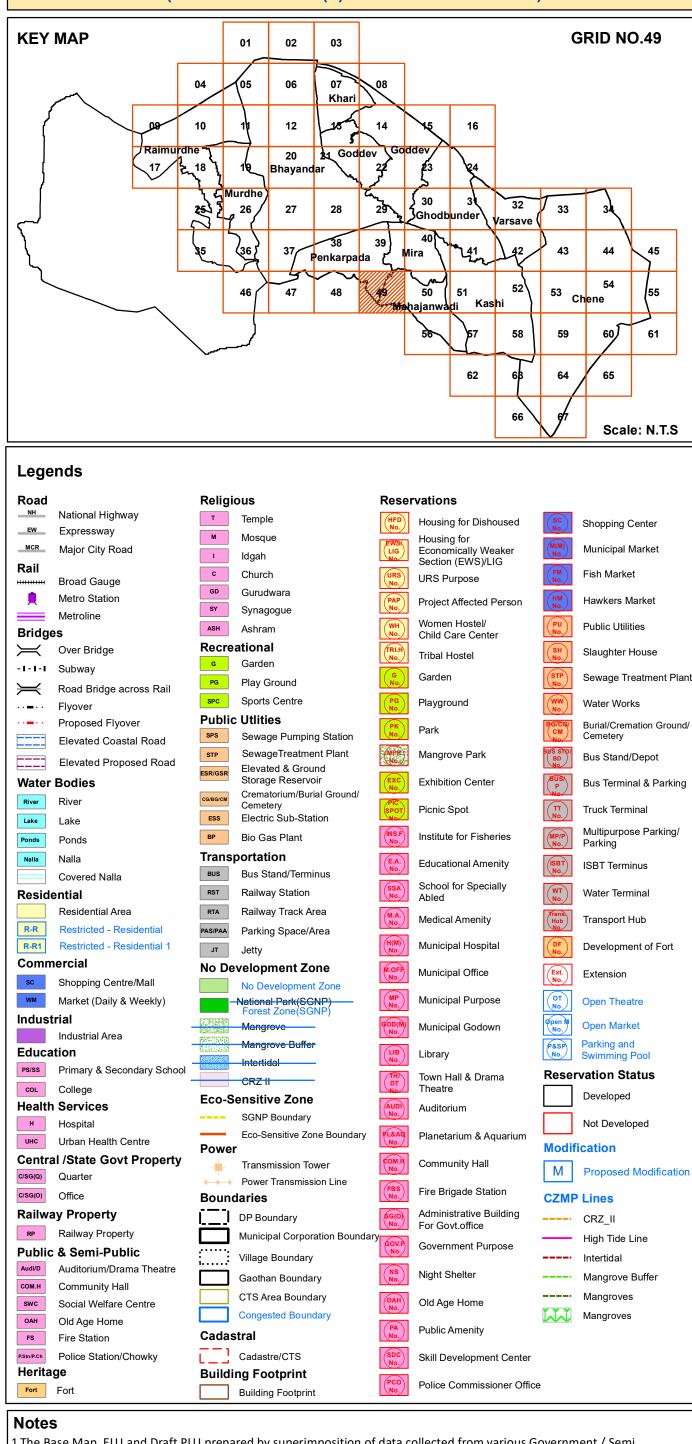

1. The Base Map, ELU and Draft PLU prepared by superimposition of data collected from various Government / Semi Government / Departments / Stakeholders and physical features depicted from Drone / Satellite Imagery; hence, the discrepancies may occur.

2. Proposed Land-use Shall prevail irrespective of property number / boundary shown on map which shall be subject to confirmation from Land Record or competent Authority.

3. The structure on the map does not confirm authorization unless verified and rectified by Planning Authority. 4.SGNP, CRZ, Mangroves with their buffers shown on the plan shall be as per the relevant status. In case of any modifications to such status in future, such boundary and buffer shall automatically stand modified as per the latest notification. 5. The alignment of Metro, <del>Coastal Elevated</del> Road marked on plan are indicative & automatically stand modified by the notification issued by Government from time to time. 6. The alignment of nallah / river / creek is indicative and as per the feature extracted from Drone Imagery and data collected.

7. The boundaries of all the designated sites, Government property are shown as per the image captured by superimposition on cadastral map. This may be subject to change as per the actual acquisition in future. 8.This plan is to be read with UDCPR-2022 and Draft DP Report.

P.Existing road shall have status of the road according to width of road even though not shown in development plan. 10.R-R(Restricted-Residential) Residential Zone subject to handing over area to corporation as per permission/Government

11.R-R1 (Restricted- Residential1) All provision of Residential Zone in UDCPR-2020 will be applicable for this zone subject to 10% of area under Development should be kept for Amenity Space as per direction of Municipal Commissioner with prior permission from Eco-Sensitive Zone Commitee.

12.If the location of Metro Carshed and Metro Line is shifted by MMRDA or Elevated Road is shifted in future, the land leased by such shifting shall stands included in adjoining Zone shown on Development Plan.


Scale				North N
0	0.05	0.1	0.2 km	WEE
		1:2,000		S
351001	मुल्यनिधरिष		600+1	·






Officer Appointed U/s 21(4A)

Draft Revised Development Plan of Mira Bhayandar

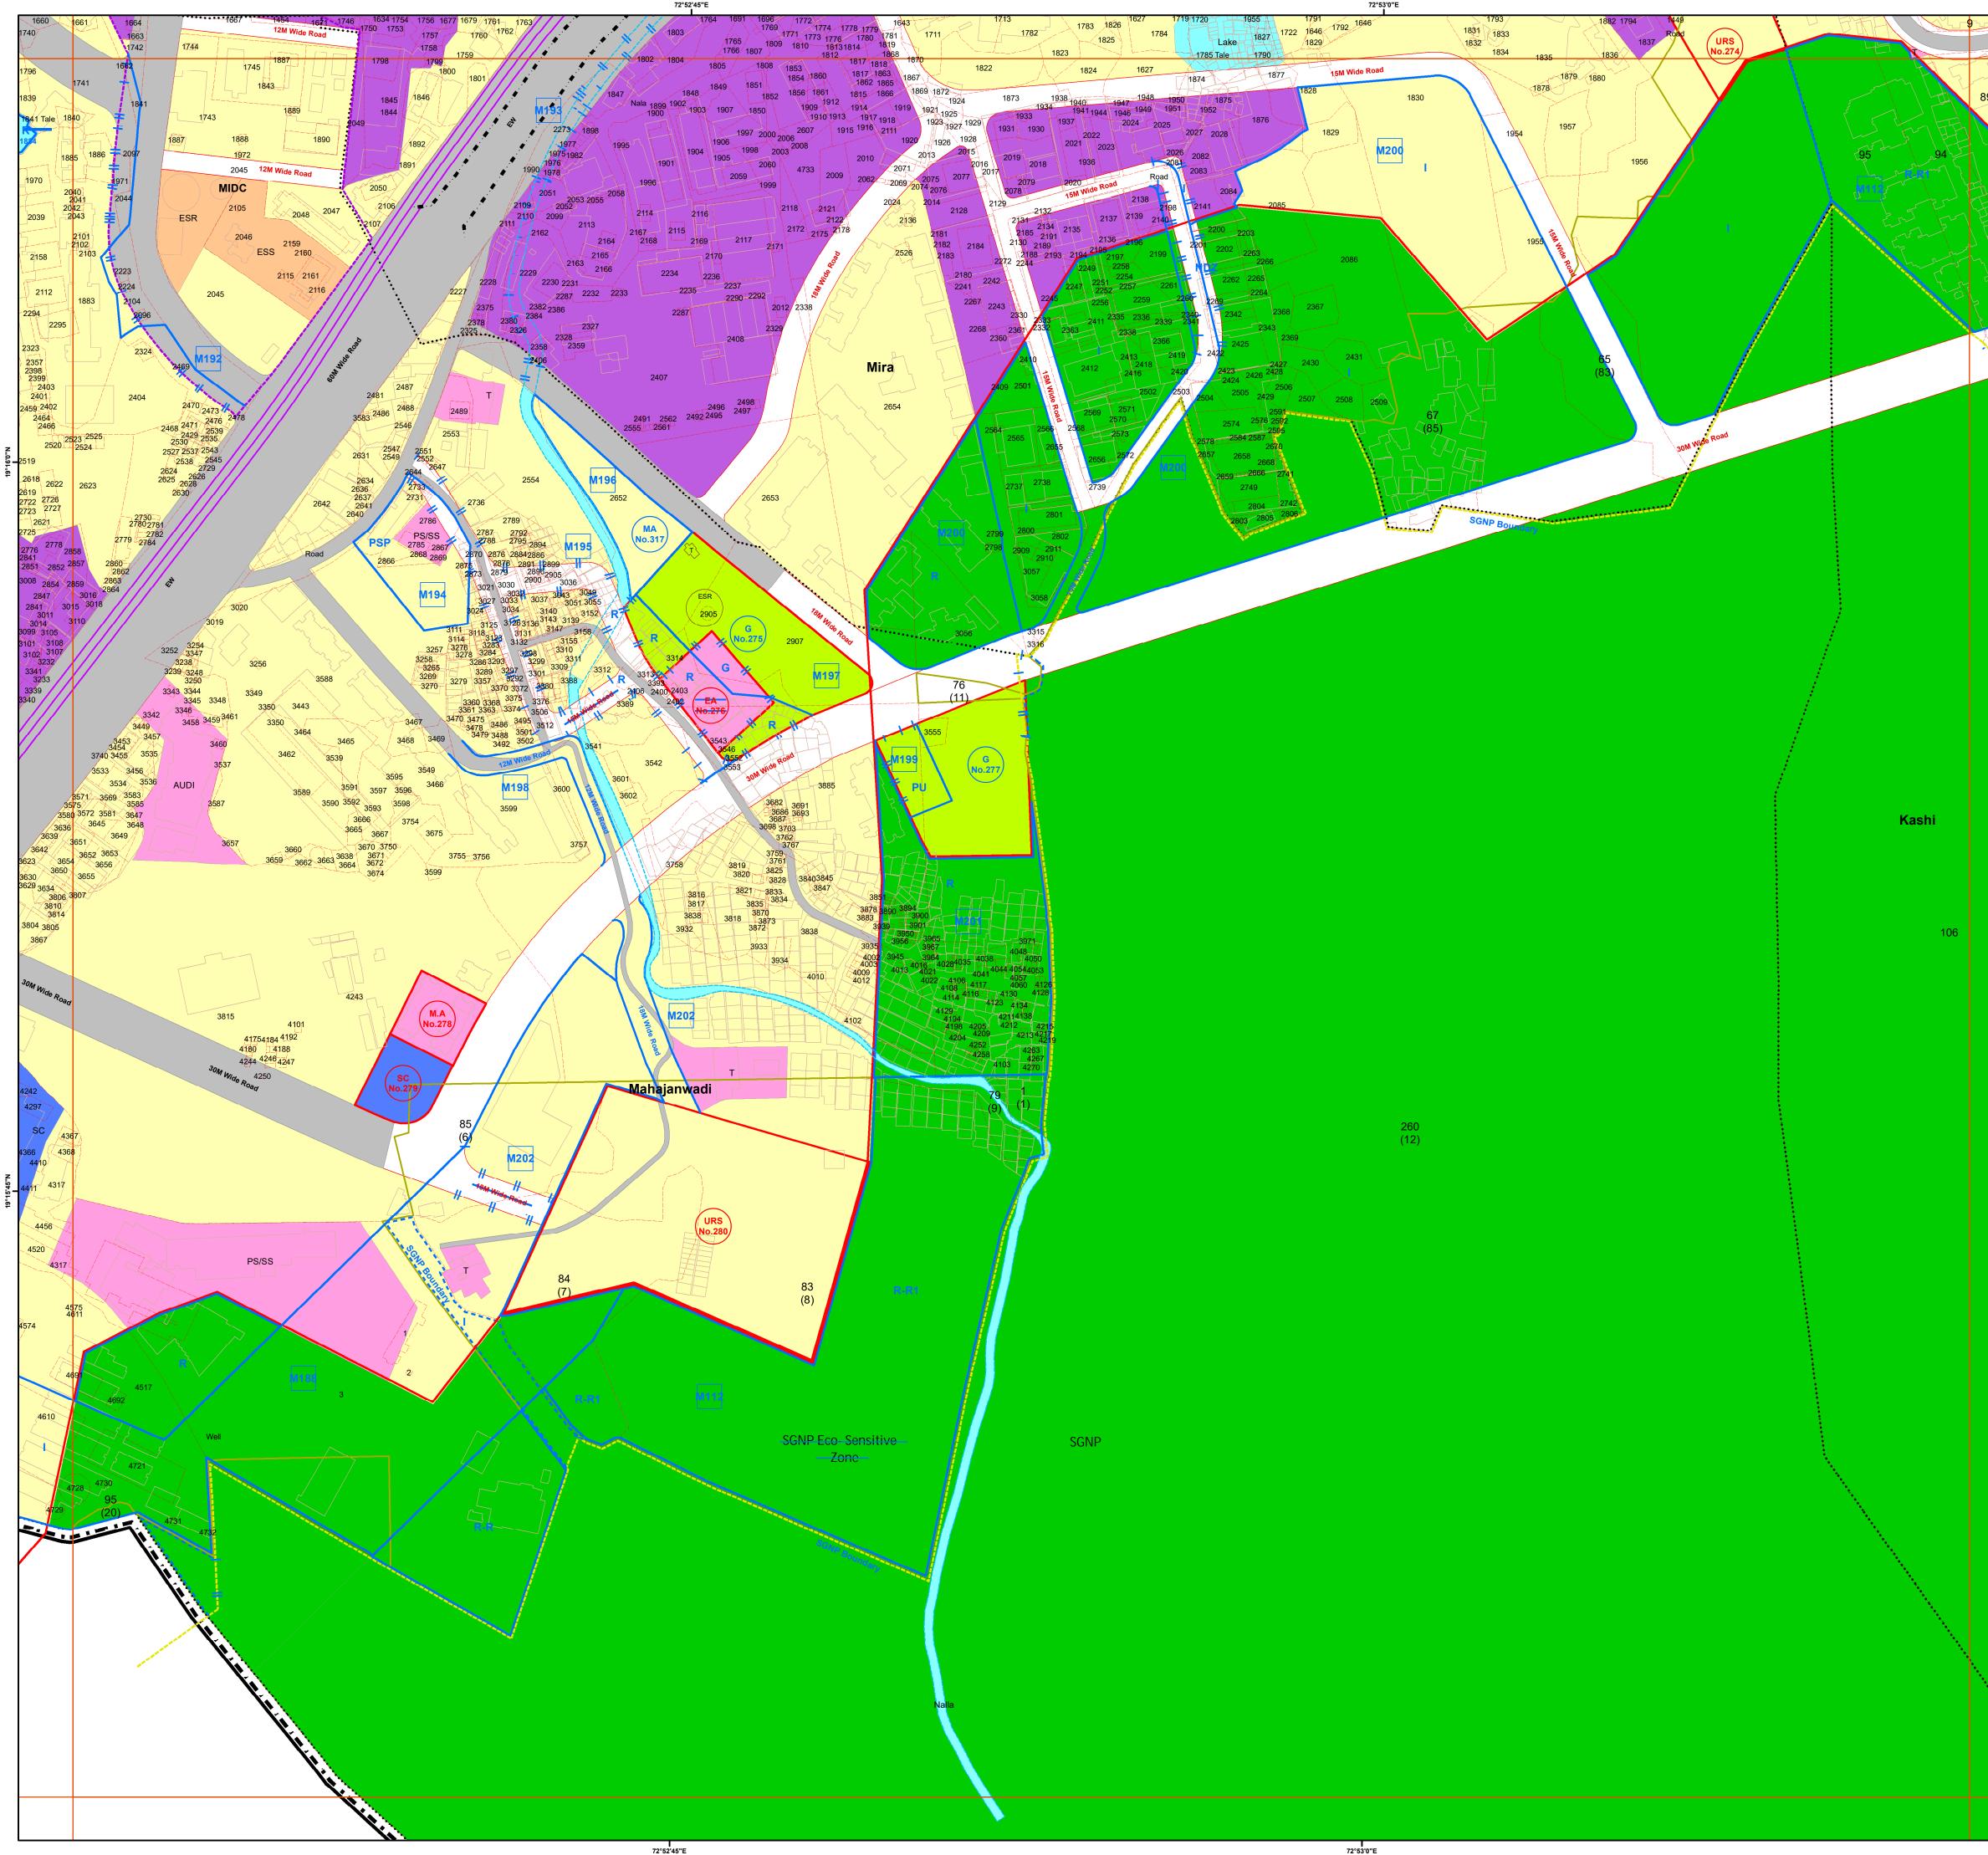

72°53'0"E

## DRAFT REVISED DEVELOPMENT PLAN Mira Bhayandar Municipal Corporation (Published U/s.28(4) of M.R.&T.P. Act 1966)

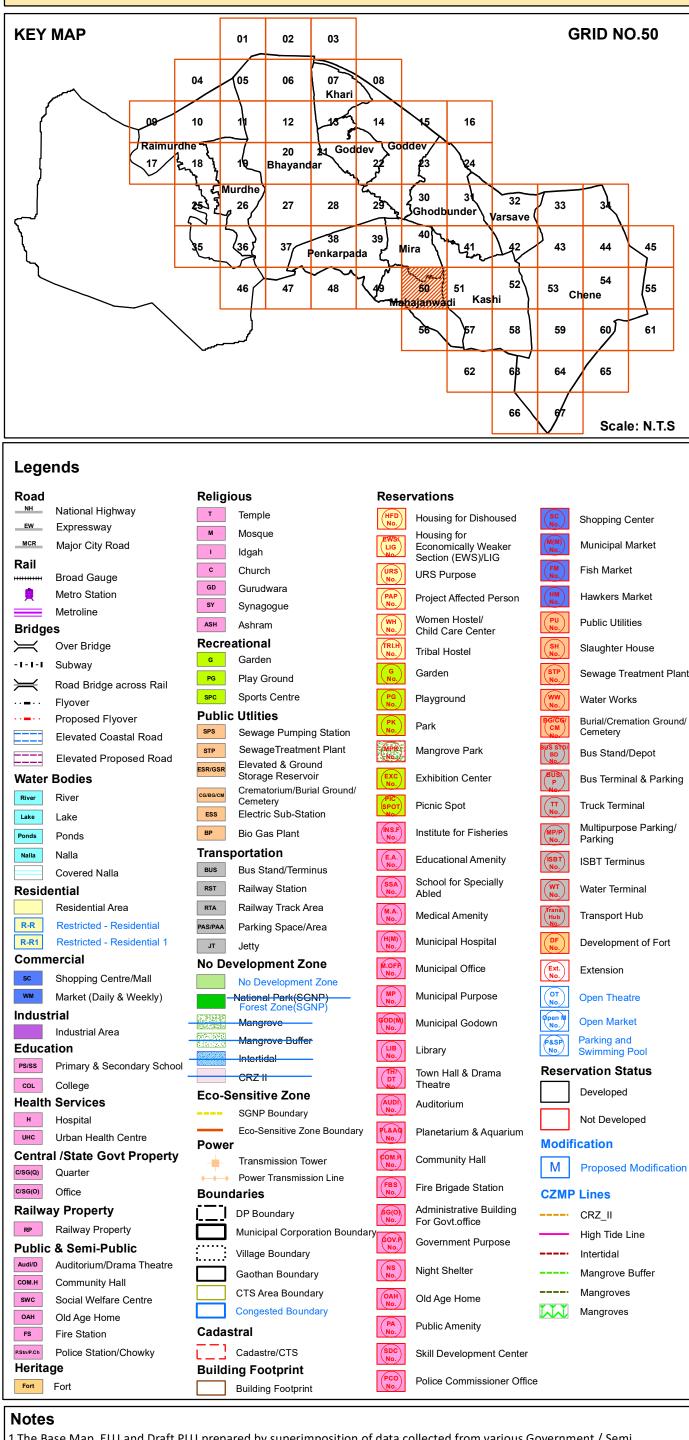

1. The Base Map, ELU and Draft PLU prepared by superimposition of data collected from various Government / Semi Government / Departments / Stakeholders and physical features depicted from Drone / Satellite Imagery; hence, the discrepancies may occur.

2. Proposed Land-use Shall prevail irrespective of property number / boundary shown on map which shall be subject to confirmation from Land Record or competent Authority.

3.The structure on the map does not confirm authorization unless verified and rectified by Planning Authority. 4.SGNP, CRZ, Mangroves with their buffers shown on the plan shall be as per the relevant status. In case of any modifications to such status in future, such boundary and buffer shall automatically stand modified as per the latest notification. 5.The alignment of Metro, <del>Coastal</del> Elevated Road marked on plan are indicative & automatically stand modified by the notification issued by Government from time to time.

6. The alignment of nallah / river / creek is indicative and as per the feature extracted from Drone Imagery and data collected. 7. The boundaries of all the designated sites, Government property are shown as per the image captured by superimposition on cadastral map. This may be subject to change as per the actual acquisition in future. 8.This plan is to be read with UDCPR-2022 and Draft DP Report.

9.Existing road shall have status of the road according to width of road even though not shown in development plan. 10.R-R(Restricted-Residential) Residential Zone subject to handing over area to corporation as per permission/Government orders.

11.R-R1 (Restricted- Residential1) All provision of Residential Zone in UDCPR-2020 will be applicable for this zone subject to 10% of area under Development should be kept for Amenity Space as per direction of Municipal Commissioner with prior permission from Eco-Sensitive Zone Commitee.


12.If the location of Metro Carshed and Metro Line is shifted by MMRDA or Elevated Road is shifted in future, the land released by such shifting shall stands included in adjoining Zone shown on Development Plan.


Scale					North N
0	0.05	0.1	0.2 k	m	WEE
		1:2,000			S
31101	मुल्यनिधरिष				





☐ Officer Appointed U/s 21(4A) ► Draft Revised Development Plan of Mira Bhayandar

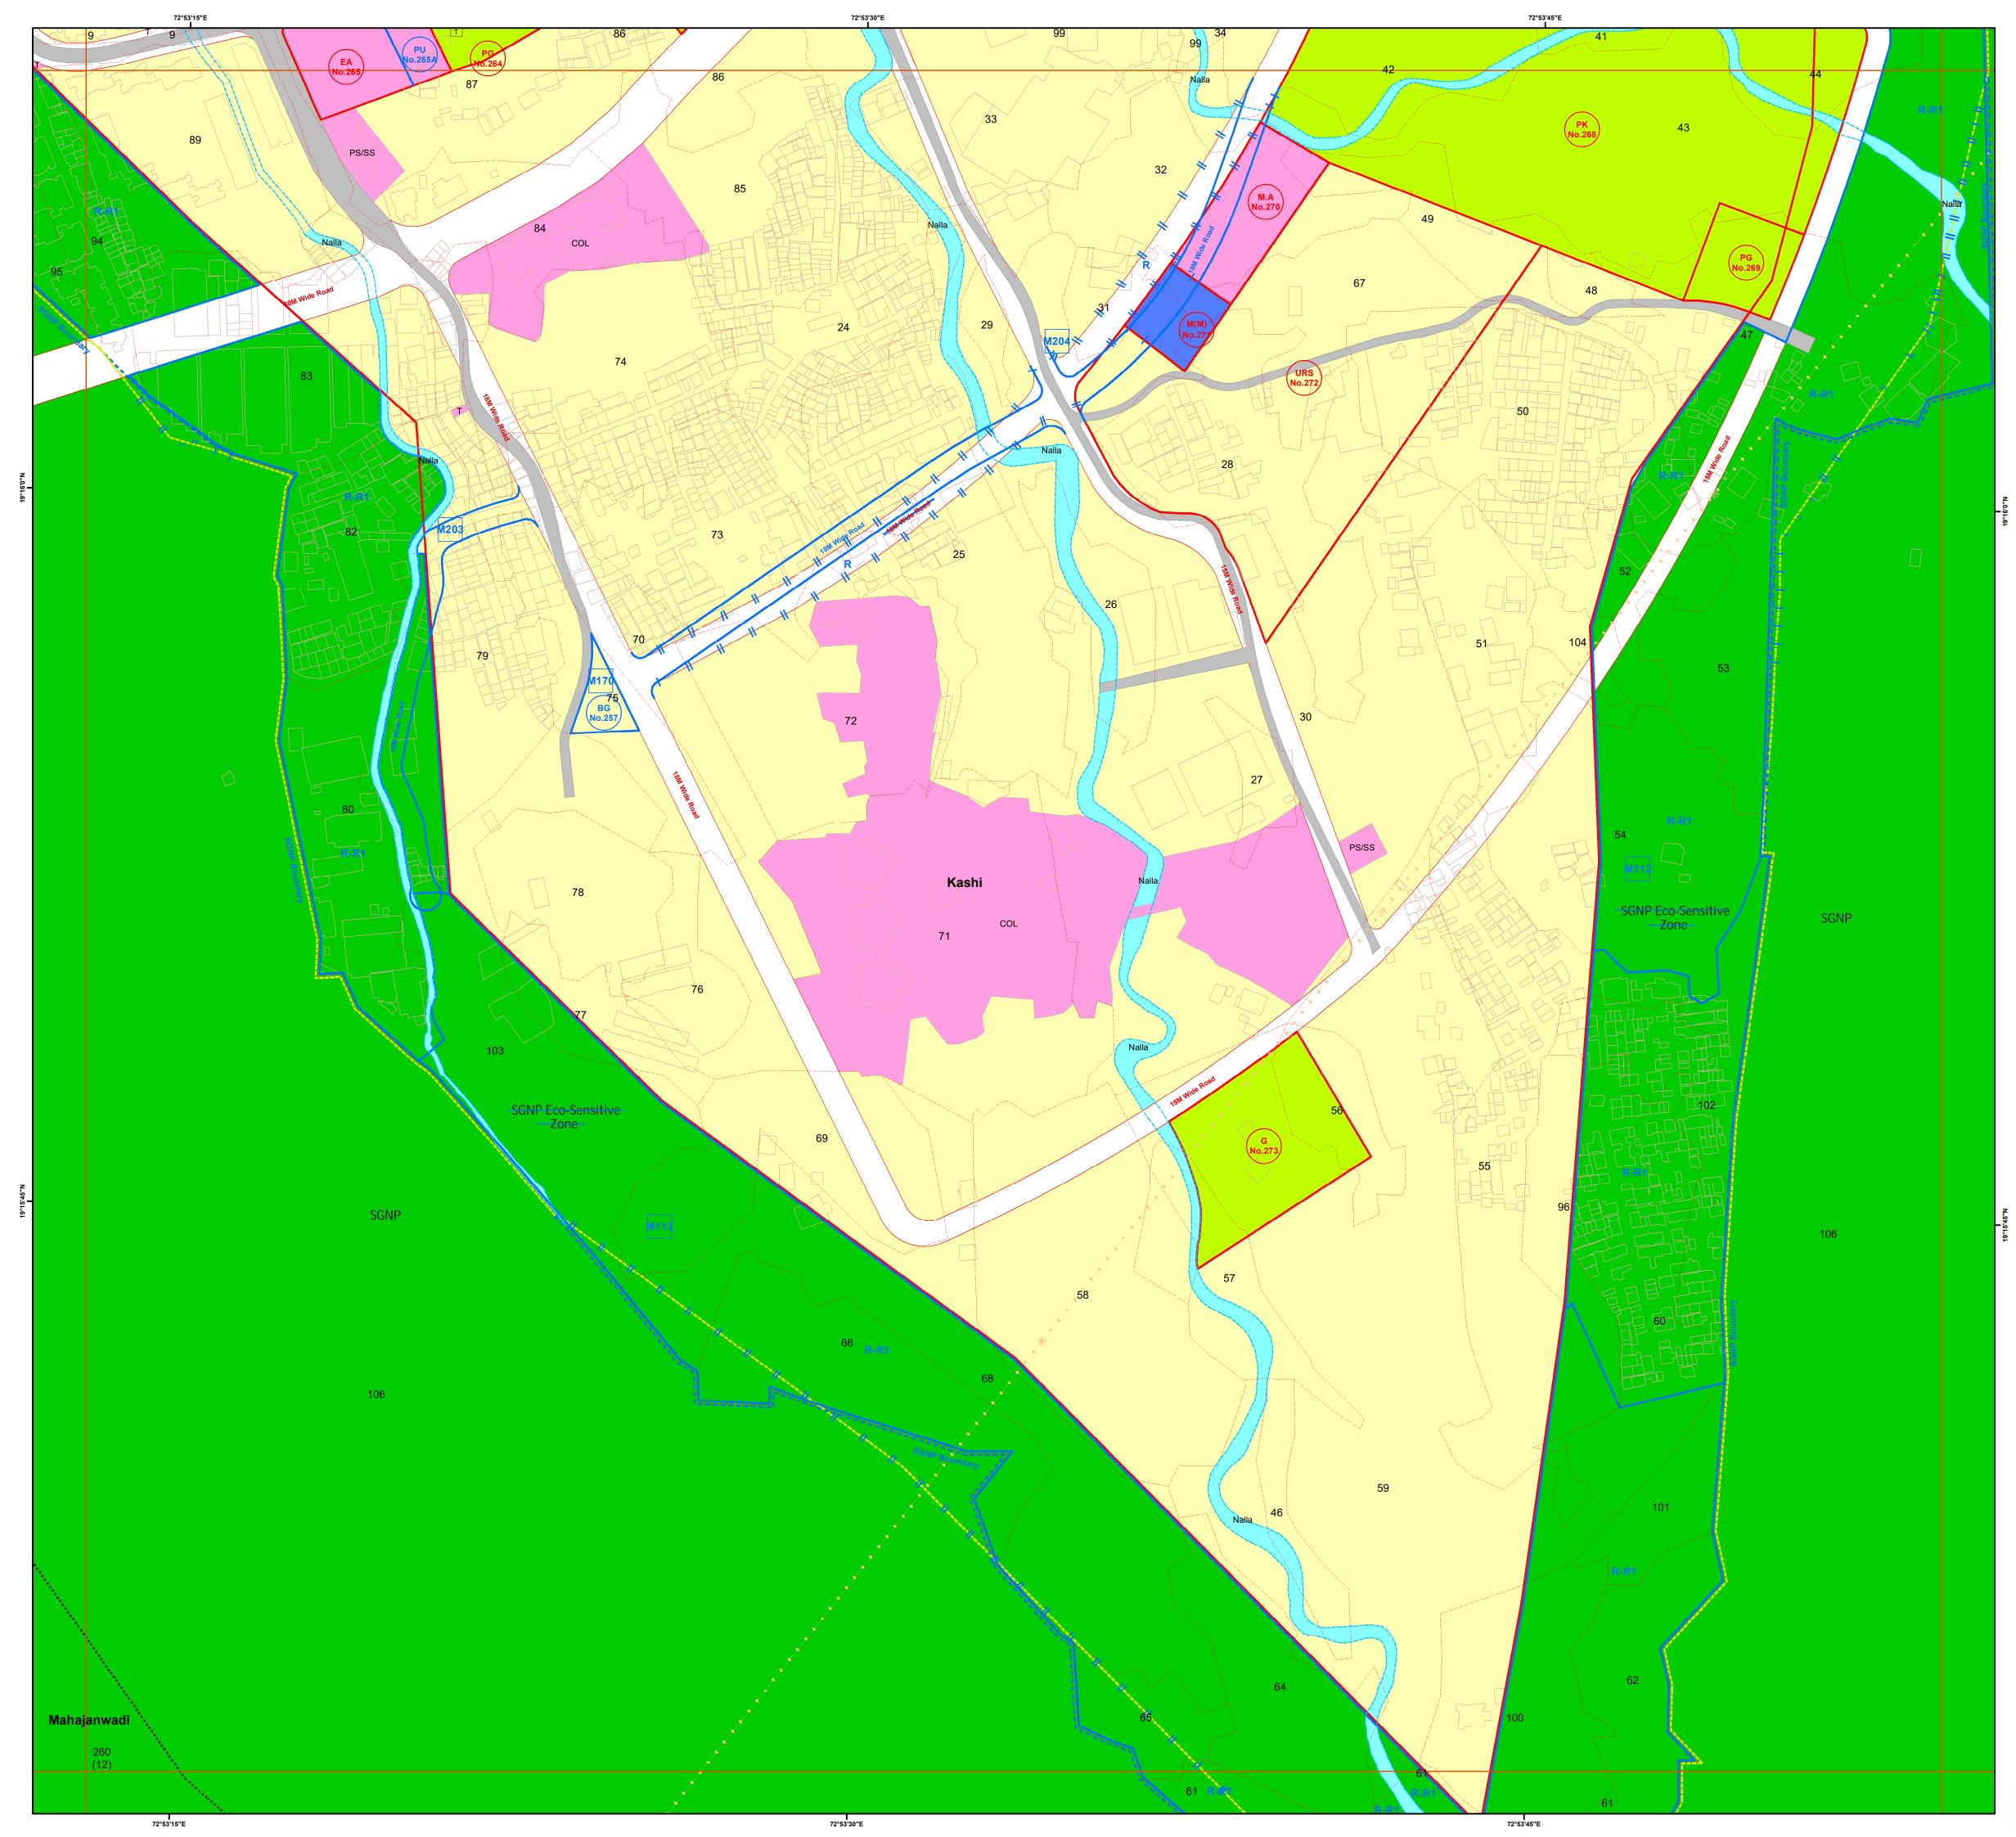

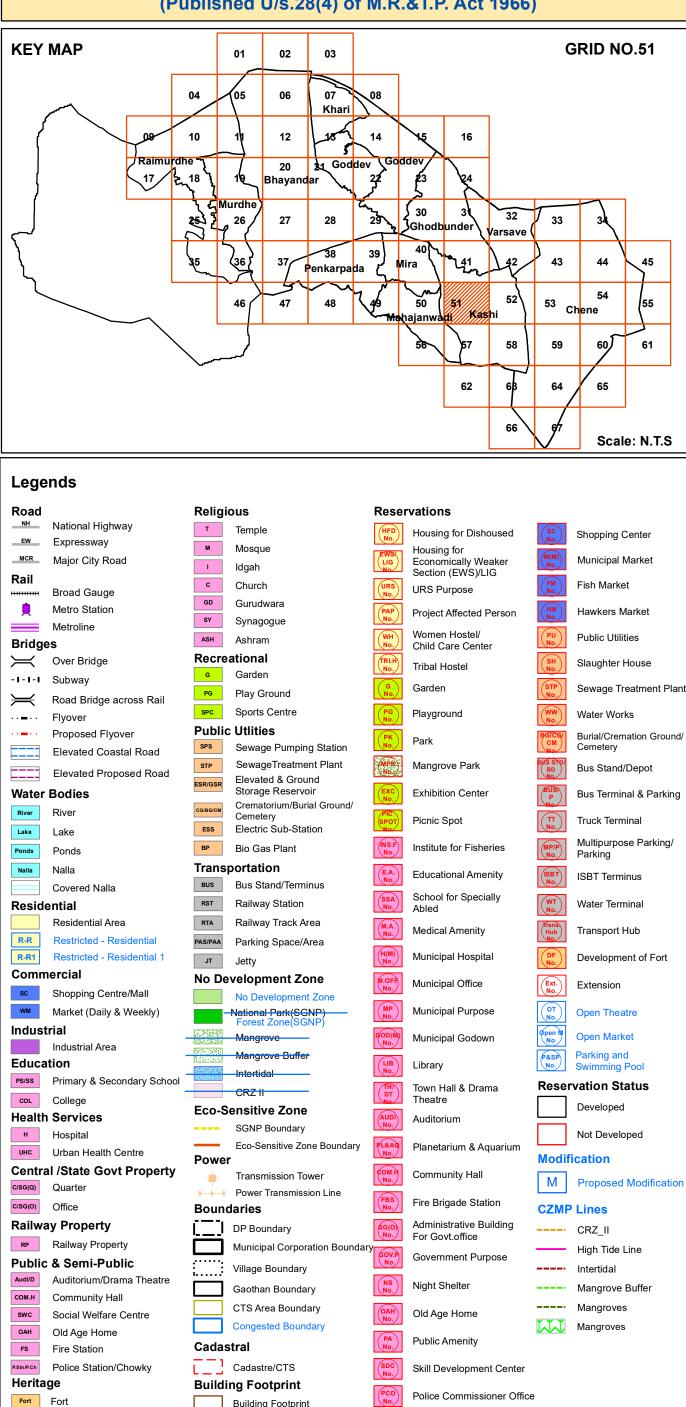

# Notes

Fort Fort

1. The Base Map, ELU and Draft PLU prepared by superimposition of data collected from various Government / Semi Government / Departments / Stakeholders and physical features depicted from Drone / Satellite Imagery; hence, the discrepancies may occur.

Building Footprint

2. Proposed Land-use Shall prevail irrespective of property number / boundary shown on map which shall be subject to confirmation from Land Record or competent Authority.

3.The structure on the map does not confirm authorization unless verified and rectified by Planning Authority. 4.SGNP, CRZ, Mangroves with their buffers shown on the plan shall be as per the relevant status. In case of any modifications to such status in future, such boundary and buffer shall automatically stand modified as per the latest notification. 5. The alignment of Metro, Coastal Elevated Road marked on plan are indicative & automatically stand modified by the notification issued by Government from time to time.

6. The alignment of nallah / river / creek is indicative and as per the feature extracted from Drone Imagery and data collected. 7. The boundaries of all the designated sites, Government property are shown as per the image captured by superimposition on cadastral map. This may be subject to change as per the actual acquisition in future. 8.This plan is to be read with UDCPR-2022 and Draft DP Report.

9.Existing road shall have status of the road according to width of road even though not shown in development plan. 10.R-R(Restricted-Residential) Residential Zone subject to handing over area to corporation as per permission/Government orders.

11.R-R1 (Restricted- Residential1) All provision of Residential Zone in UDCPR-2020 will be applicable for this zone subject to 10% of area under Development should be kept for Amenity Space as per direction of Municipal Commissioner with prior permission from Eco-Sensitive Zone Commitee.

12.If the location of Metro Carshed and Metro Line is shifted by MMRDA or Elevated Road is shifted in future, the land eleased by such shifting shall stands included in adjoining Zone shown on Development Plan.

Scale				North	N
0	0.05	0.1	0.2 km		WEE
		1:2,000			S
31101	मुल्यनिधार्म्		600H		





☐ Officer Appointed U/s 21(4A) ▶ Draft Revised Development Plan of Mira Bhayandar

72°54'0"E

19°16'0"N **I** 

72°54'0"E



SGNP

106


Kashi

101 Chene

72°54'30"E

72°54'15"E

### DRAFT REVISED DEVELOPMENT PLAN Mira Bhayandar Municipal Corporation (Published U/s.28(4) of M.R.&T.P. Act 1966)

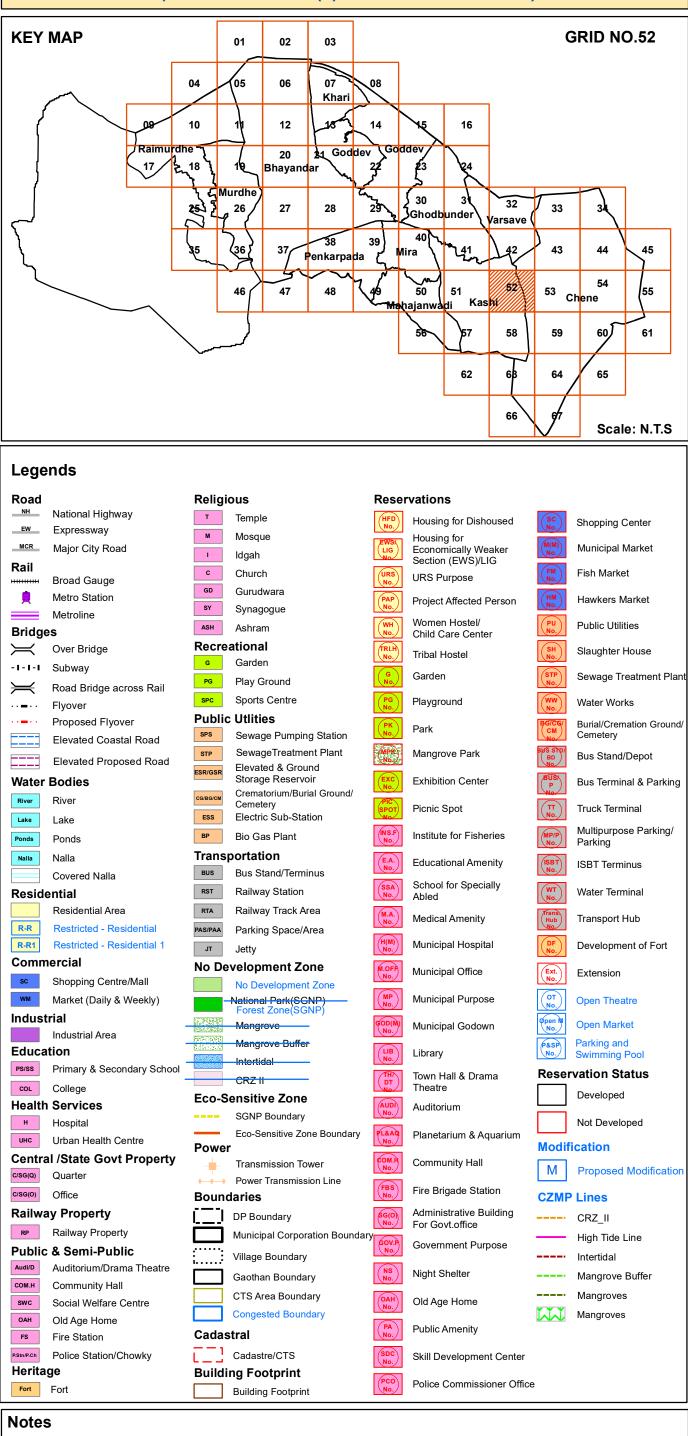

1. The Base Map, ELU and Draft PLU prepared by superimposition of data collected from various Government / Semi Government / Departments / Stakeholders and physical features depicted from Drone / Satellite Imagery; hence, the discrepancies may occur.

2.Proposed Land-use Shall prevail irrespective of property number / boundary shown on map which shall be subject to confirmation from Land Record or competent Authority.

3.The structure on the map does not confirm authorization unless verified and rectified by Planning Authority. 4.SGNP, CRZ, Mangroves with their buffers shown on the plan shall be as per the relevant status. In case of any modifications to such status in future, such boundary and buffer shall automatically stand modified as per the latest notification. 5.The alignment of Metro, <del>Coastal</del> Elevated Road marked on plan are indicative & automatically stand modified by the notification issued by Government from time to time.

6. The alignment of nallah / river / creek is indicative and as per the feature extracted from Drone Imagery and data collected. 7. The boundaries of all the designated sites, Government property are shown as per the image captured by superimposition on cadastral map. This may be subject to change as per the actual acquisition in future. 8.This plan is to be read with UDCPR-2022 and Draft DP Report.

9. Existing road shall have status of the road according to width of road even though not shown in development plan. 10.R-R(Restricted-Residential) Residential Zone subject to handing over area to corporation as per permission/Government orders.

11.R-R1 (Restricted- Residential1) All provision of Residential Zone in UDCPR-2020 will be applicable for this zone subject to 10% of area under Development should be kept for Amenity Space as per direction of Municipal Commissioner with prior permission from Eco-Sensitive Zone Commitee.

12.If the location of Metro Carshed and Metro Line is shifted by MMRDA or Elevated Road is shifted in future, the land released by such shifting shall stands included in adjoining Zone shown on Development Plan.

Scale				North N
0	0.05	0.1	0.2 km	WEE
		1:2,000		S
1 and	सुल्यनिधरिक्ष विभ		Rifett	

Officer Appointed U/s 21(4A)

Assistant Director of Town Planning, Thane

★// Draft Revised Development Plan of Mira Bhayandar



105/2 105/3 M154 106 105/105/6 106 Part Pada 104

112

107/1


105

105/6


# SGNP

72°54'45"E

# 101

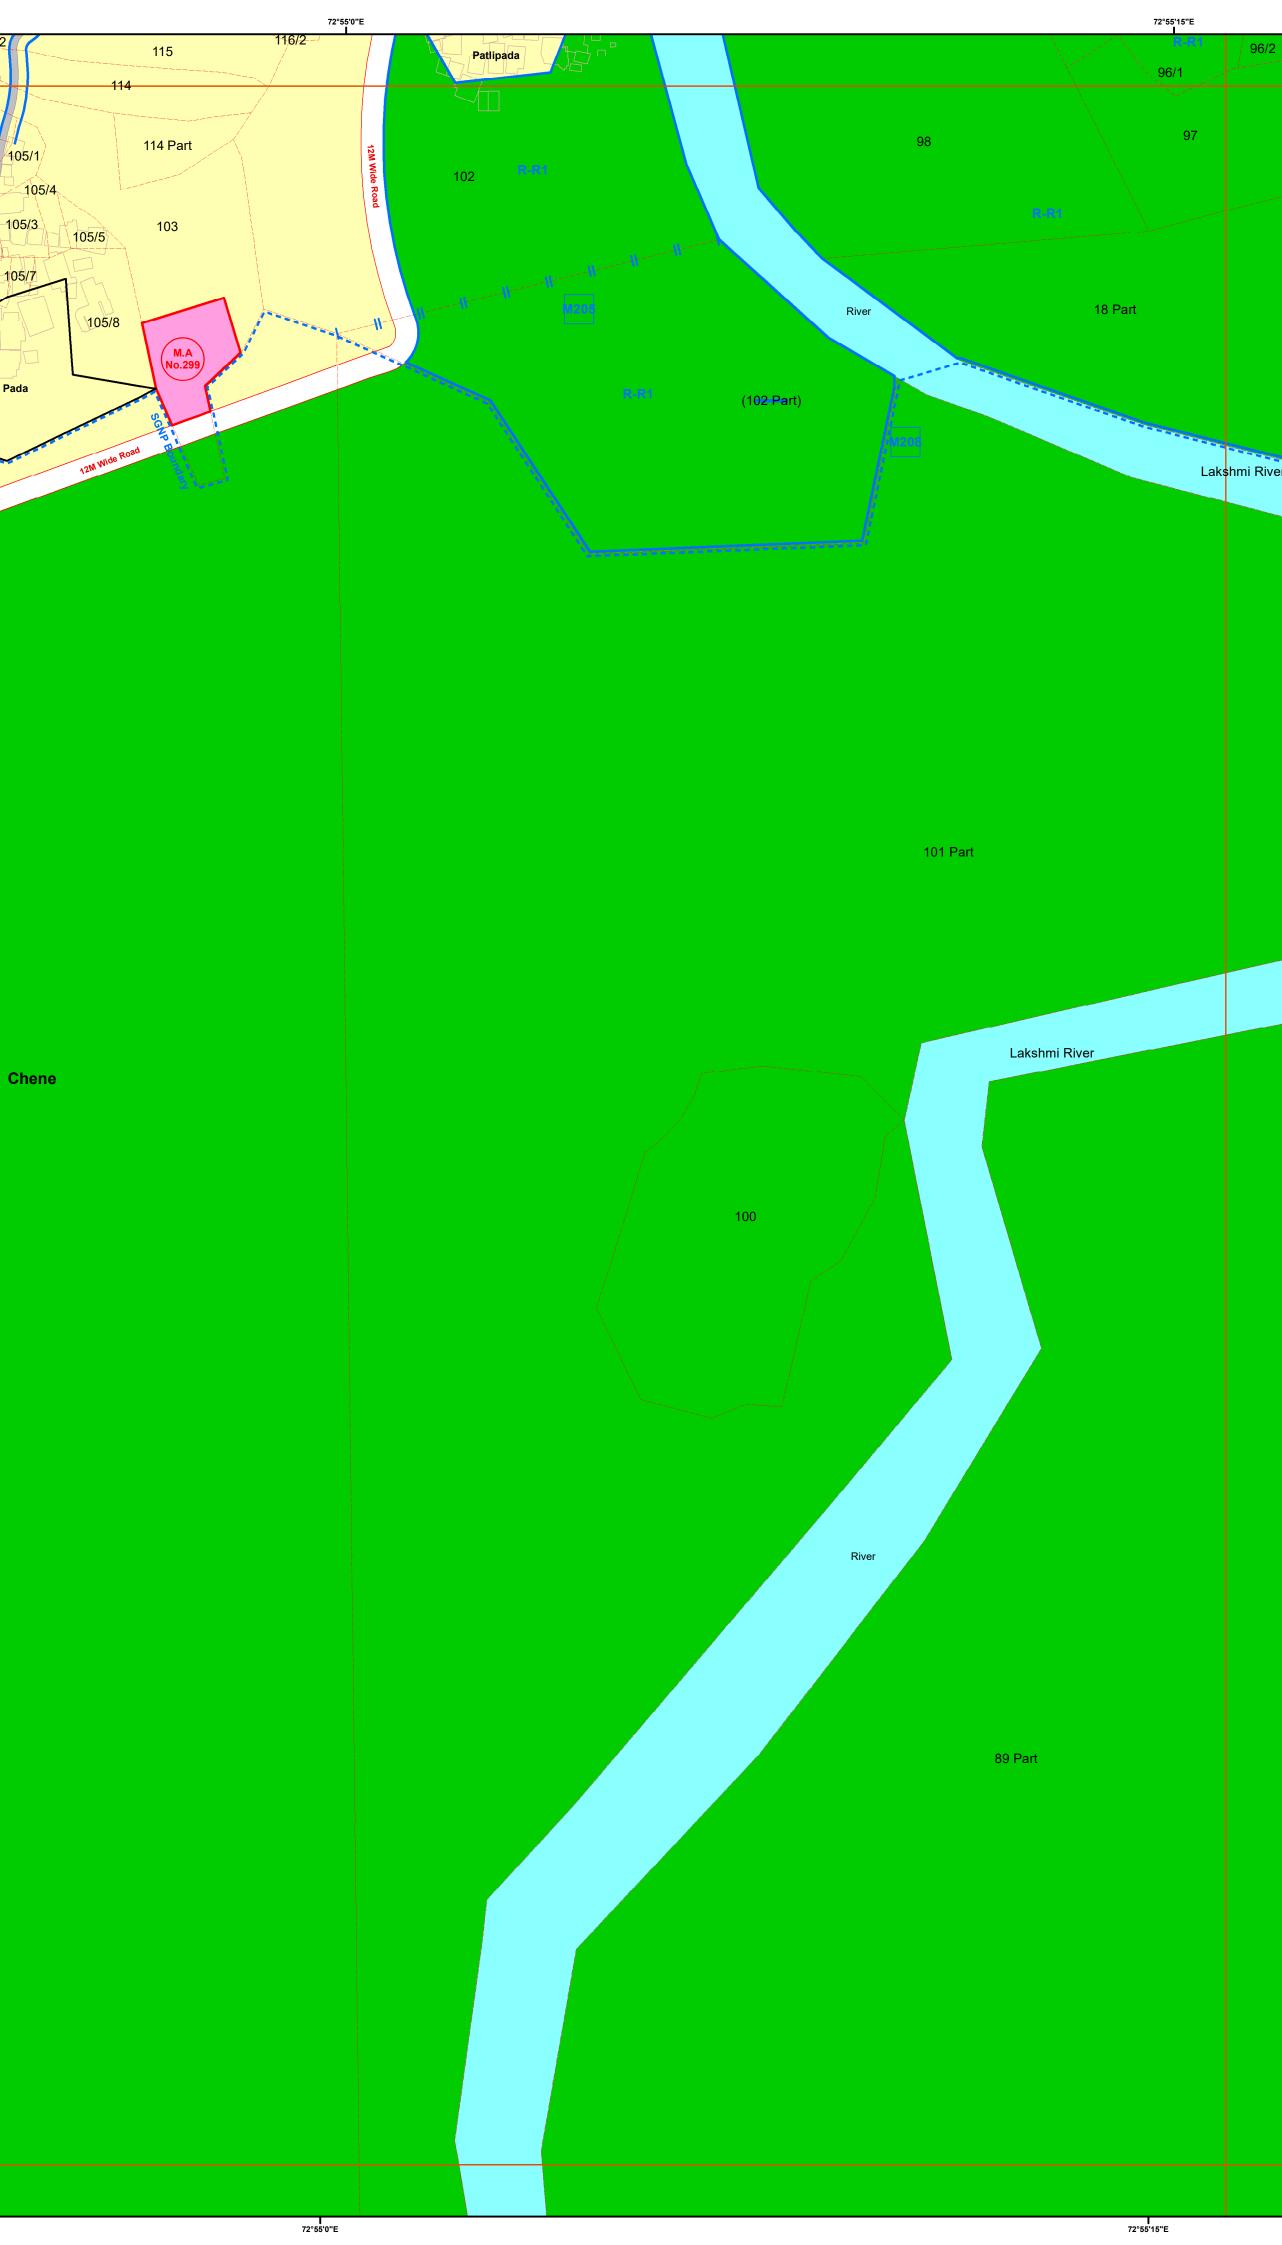

## DRAFT REVISED DEVELOPMENT PLAN Mira Bhayandar Municipal Corporation (Published U/s.28(4) of M.R.&T.P. Act 1966)

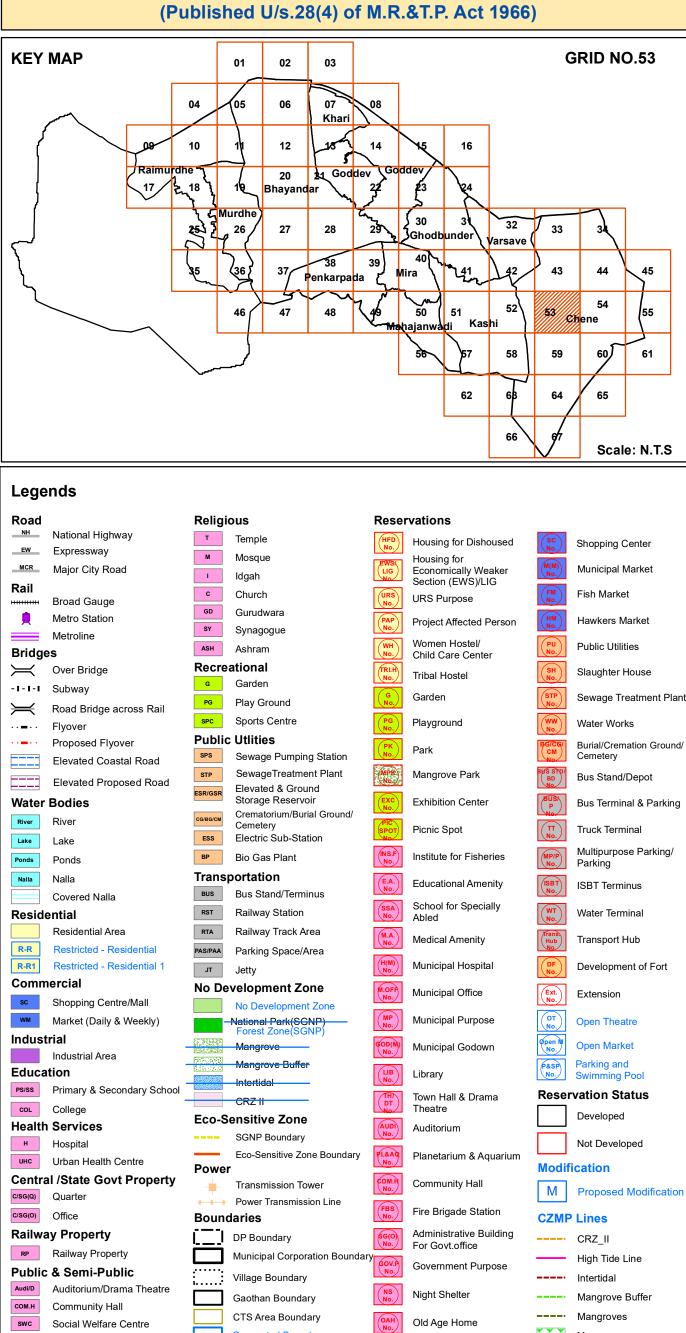

~		
s.		
4		
ò		
÷.		

Notes

Heritage

Fort Fort

swc Social Welfare Centre

Police Station/Chowky

Old Age Home

FS Fire Station

1.The Base Map, ELU and Draft PLU prepared by superimposition of data collected from various Government / Semi Government / Departments / Stakeholders and physical features depicted from Drone / Satellite Imagery; hence, the discrepancies may occur.

PA Public Amenity

Skill Development Center

Police Commissioner Office

Congested Boundary

Cadastral

Cadastre/CTS

**Building Footprint** 

Building Footprint

Mangroves

2. Proposed Land-use Shall prevail irrespective of property number / boundary shown on map which shall be subject to confirmation from Land Record or competent Authority.

3.The structure on the map does not confirm authorization unless verified and rectified by Planning Authority. 4.SGNP, CRZ, Mangroves with their buffers shown on the plan shall be as per the relevant status. In case of any modifications to such status in future, such boundary and buffer shall automatically stand modified as per the latest notification. 5. The alignment of Metro, <del>Coastal</del> Elevated Road marked on plan are indicative & automatically stand modified by the notification issued by Government from time to time.

6. The alignment of nallah / river / creek is indicative and as per the feature extracted from Drone Imagery and data collected. 7. The boundaries of all the designated sites, Government property are shown as per the image captured by superimposition on cadastral map. This may be subject to change as per the actual acquisition in future. 8.This plan is to be read with UDCPR-2022 and Draft DP Report.

9.Existing road shall have status of the road according to width of road even though not shown in development plan. 10.R-R(Restricted-Residential) Residential Zone subject to handing over area to corporation as per permission/Government orders.

11.R-R1 (Restricted- Residential1) All provision of Residential Zone in UDCPR-2020 will be applicable for this zone subject to 10% of area under Development should be kept for Amenity Space as per direction of Municipal Commissioner with prior permission from Eco-Sensitive Zone Commitee.

12.If the location of Metro Carshed and Metro Line is shifted by MMRDA or Elevated Road is shifted in future, the land eleased by such shifting shall stands included in adjoining Zone shown on Development Plan.

Scale				North N
0	0.05	0.1	0.2 km	WEE
		1:2,000		S
31101	मुल्यनिधरिष		6004	·






☐ Officer Appointed U/s 21(4A) ★ Draft Revised Development Plan of Mira Bhayandar



SGNP

Chene

### DRAFT REVISED DEVELOPMENT PLAN Mira Bhayandar Municipal Corporation (Published U/s.28(4) of M.R.&T.P. Act 1966)

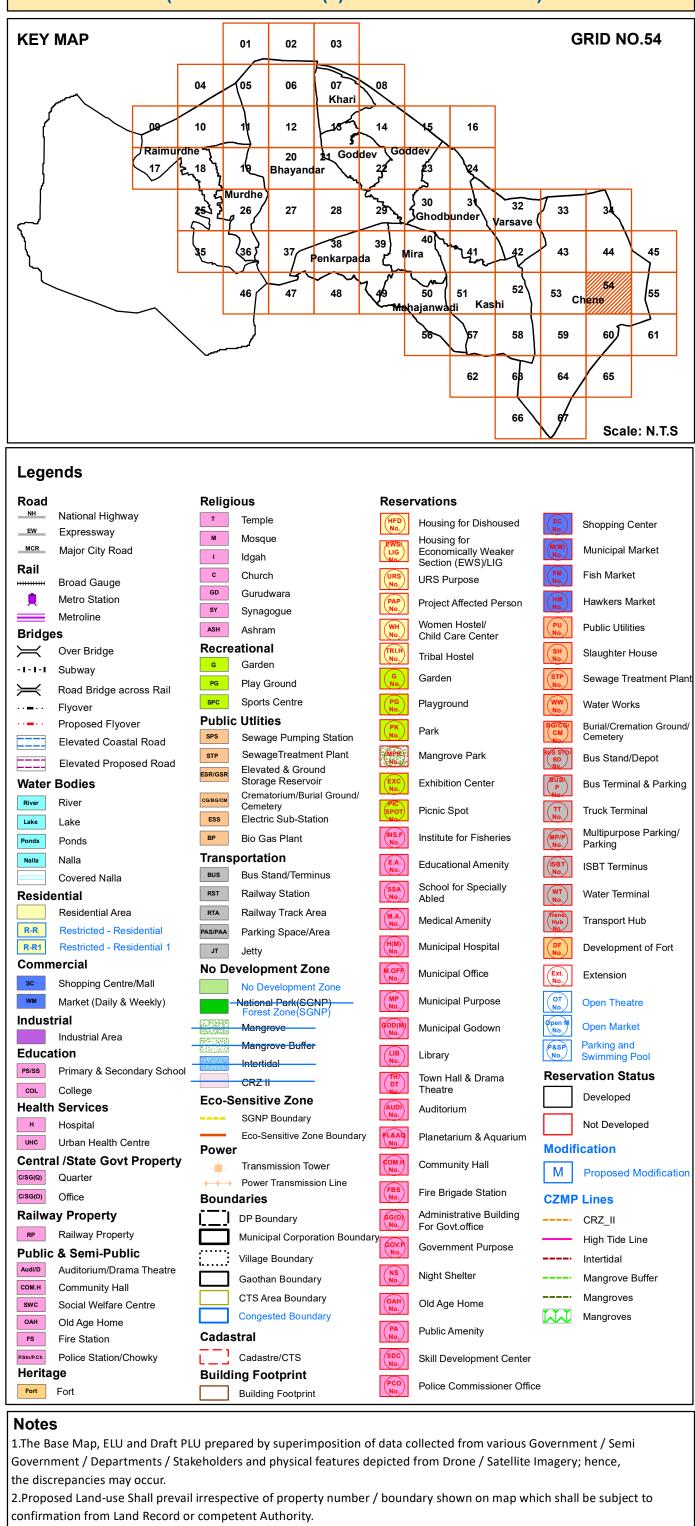

3.The structure on the map does not confirm authorization unless verified and rectified by Planning Authority.
4.SGNP, CRZ, Mangroves with their buffers shown on the plan shall be as per the relevant status. In case of any modifications to such status in future, such boundary and buffer shall automatically stand modified as per the latest notification.
5.The alignment of Metro, Coastal Elevated Road marked on plan are indicative & automatically stand modified by the notification issued by Government from time to time.
6.The alignment of nallah / river / creek is indicative and as per the feature extracted from Drone Imagery and data collected.

6.The alignment of nallah / river / creek is indicative and as per the feature extracted from Drone Imagery and data collected.
7.The boundaries of all the designated sites, Government property are shown as per the image captured by superimposition on cadastral map. This may be subject to change as per the actual acquisition in future.
8.This plan is to be read with UDCPR-2022 and Draft DP Report.

9.Existing road shall have status of the road according to width of road even though not shown in development plan. 10.R-R(Restricted-Residential) Residential Zone subject to handing over area to corporation as per permission/Government orders.

11.R-R1 (Restricted- Residential1) All provision of Residential Zone in UDCPR-2020 will be applicable for this zone subject to 10% of area under Development should be kept for Amenity Space as per direction of Municipal Commissioner with prior permission from Eco-Sensitive Zone Commitee.

12.If the location of Metro Carshed and Metro Line is shifted by MMRDA or Elevated Road is shifted in future, the land released by such shifting shall stands included in adjoining Zone shown on Development Plan.

Scale				North N
0	0.05	0.1	0.2 km	WEE
		1:2,000		S
31101	मुल्यनिधारेष		620+1	





Officer Appointed U/s 21(4A)


# SGNP

72°56'0"E

89 Part

19°16'0"N |

19°15'45"N **I** 

Chene


# 89 Part


### DRAFT REVISED DEVELOPMENT PLAN Mira Bhayandar Municipal Corporation (Published U/s.28(4) of M.R.&T.P. Act 1966)



	ला मुल्यनिधर्म	AT
0.00		311
Offi Draft Revised D	and the seal	
Assistant D	राणे शाखा	



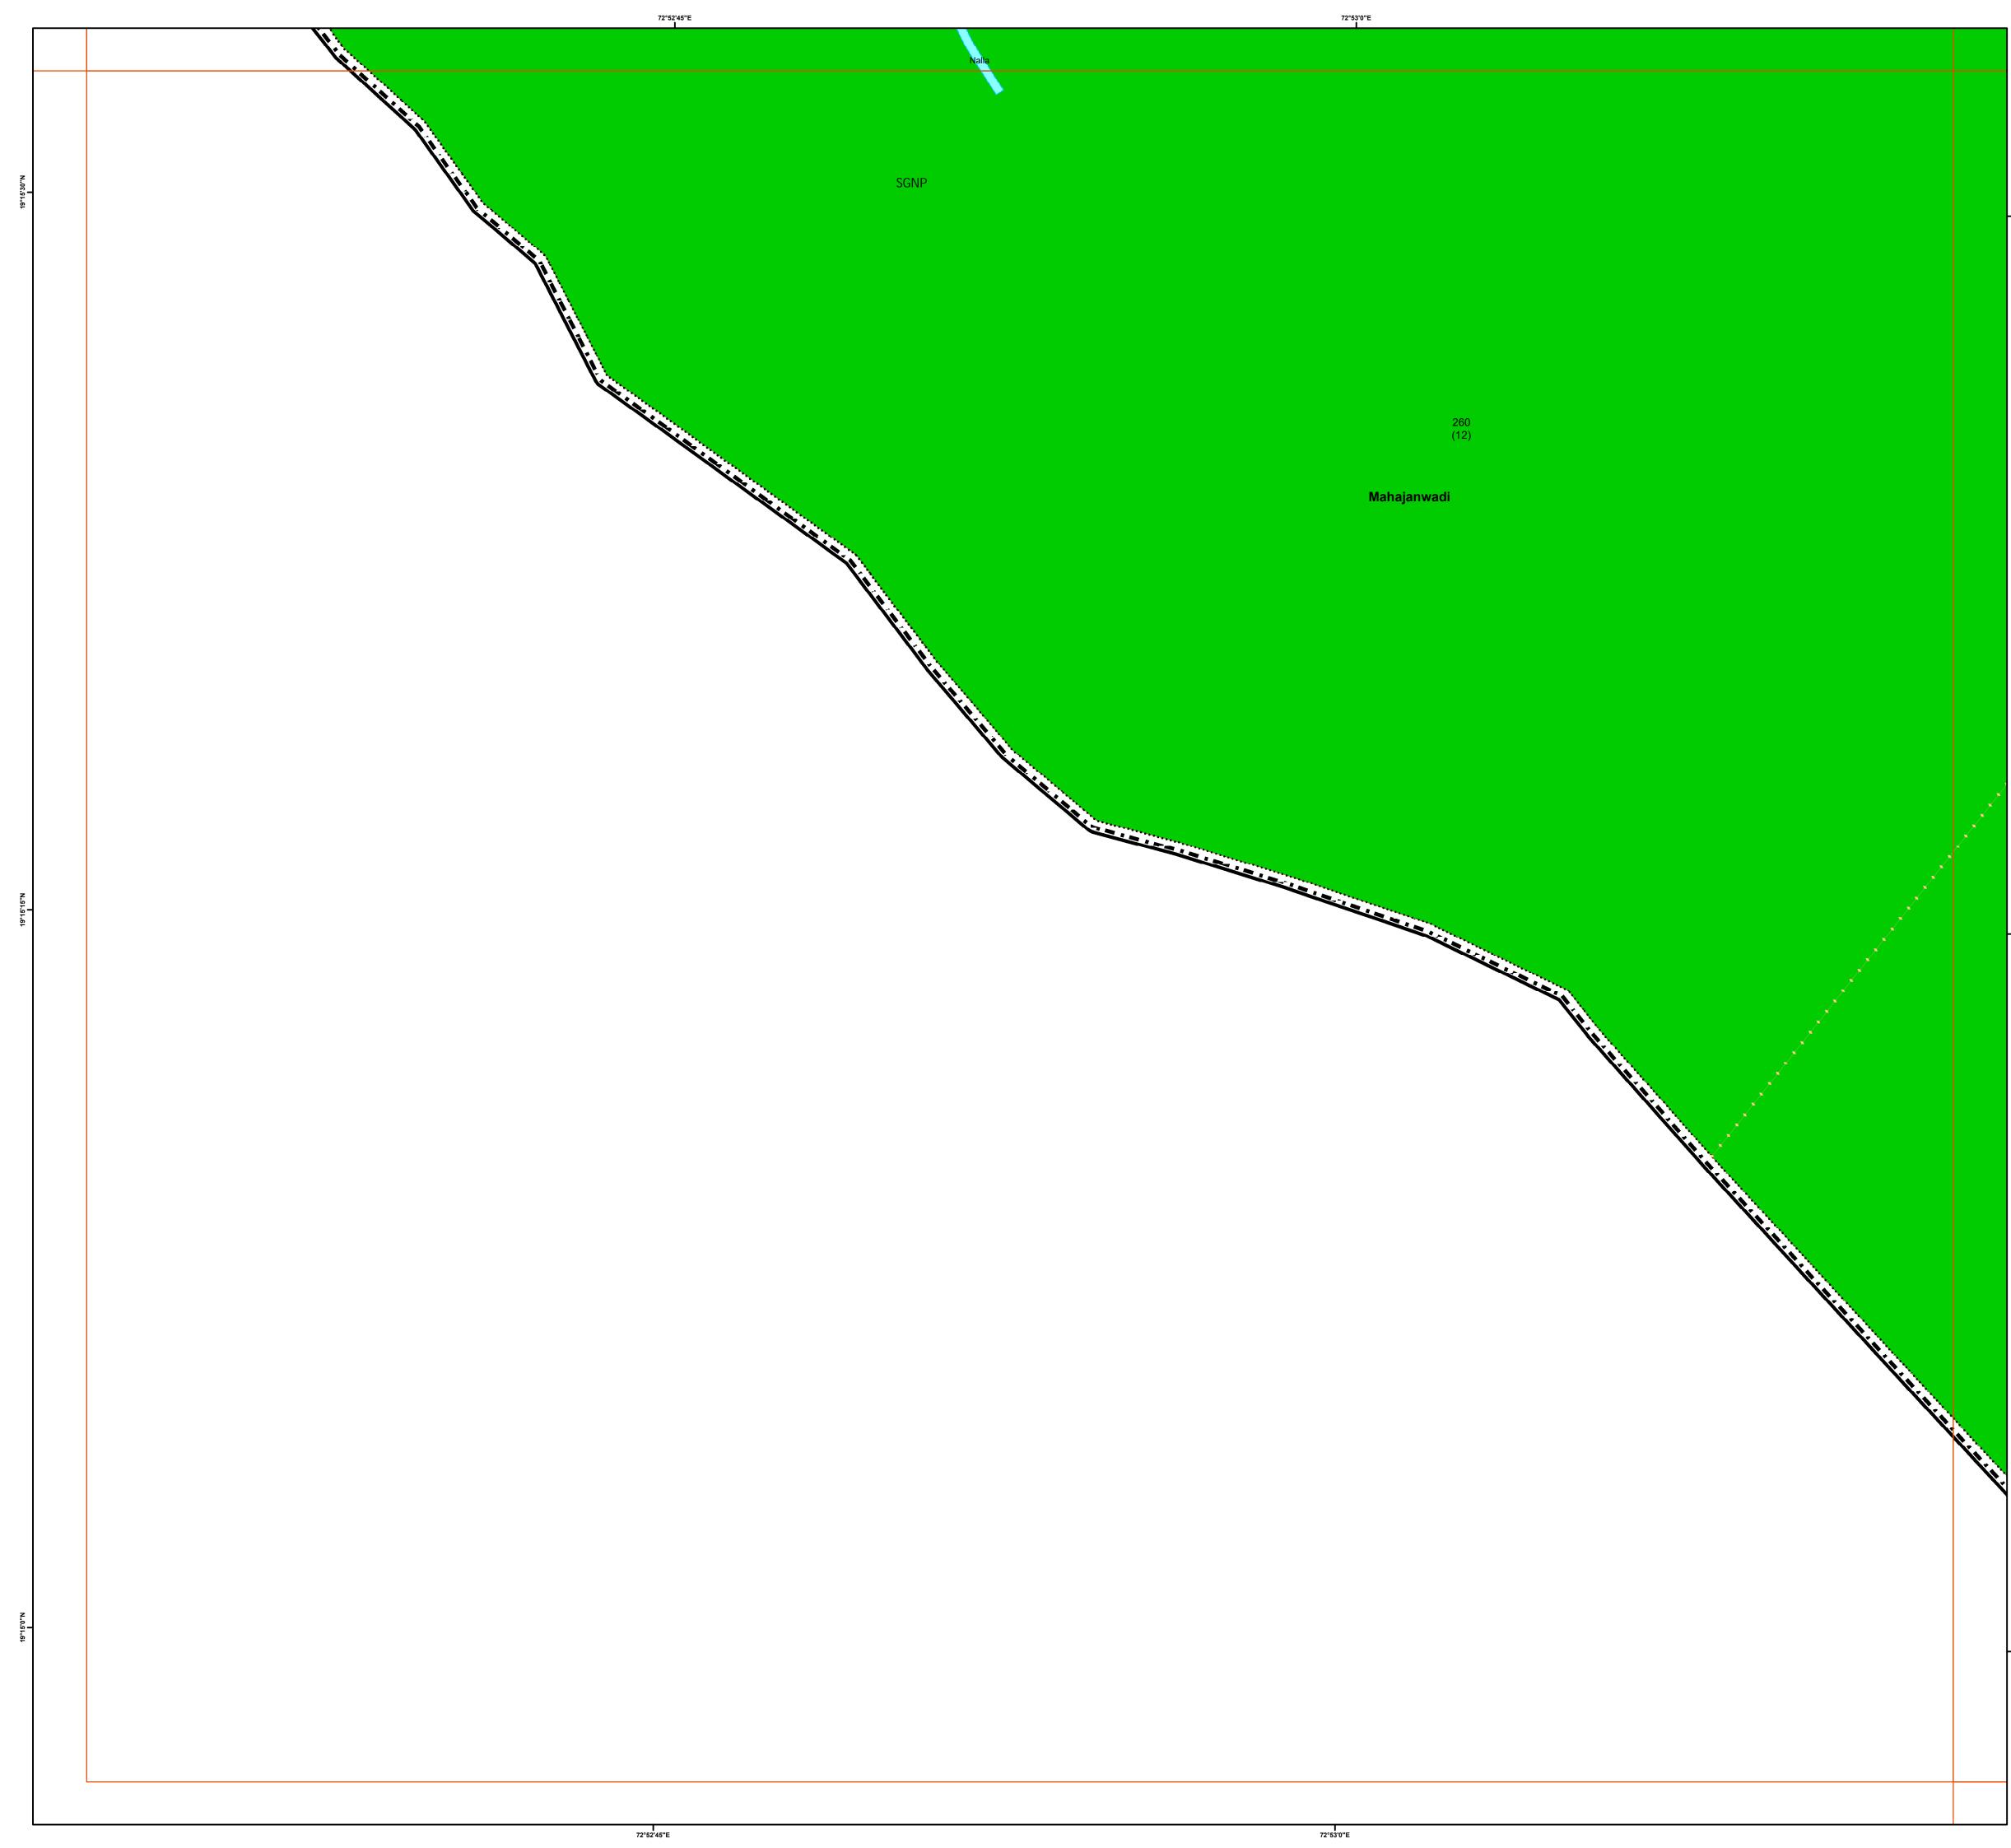

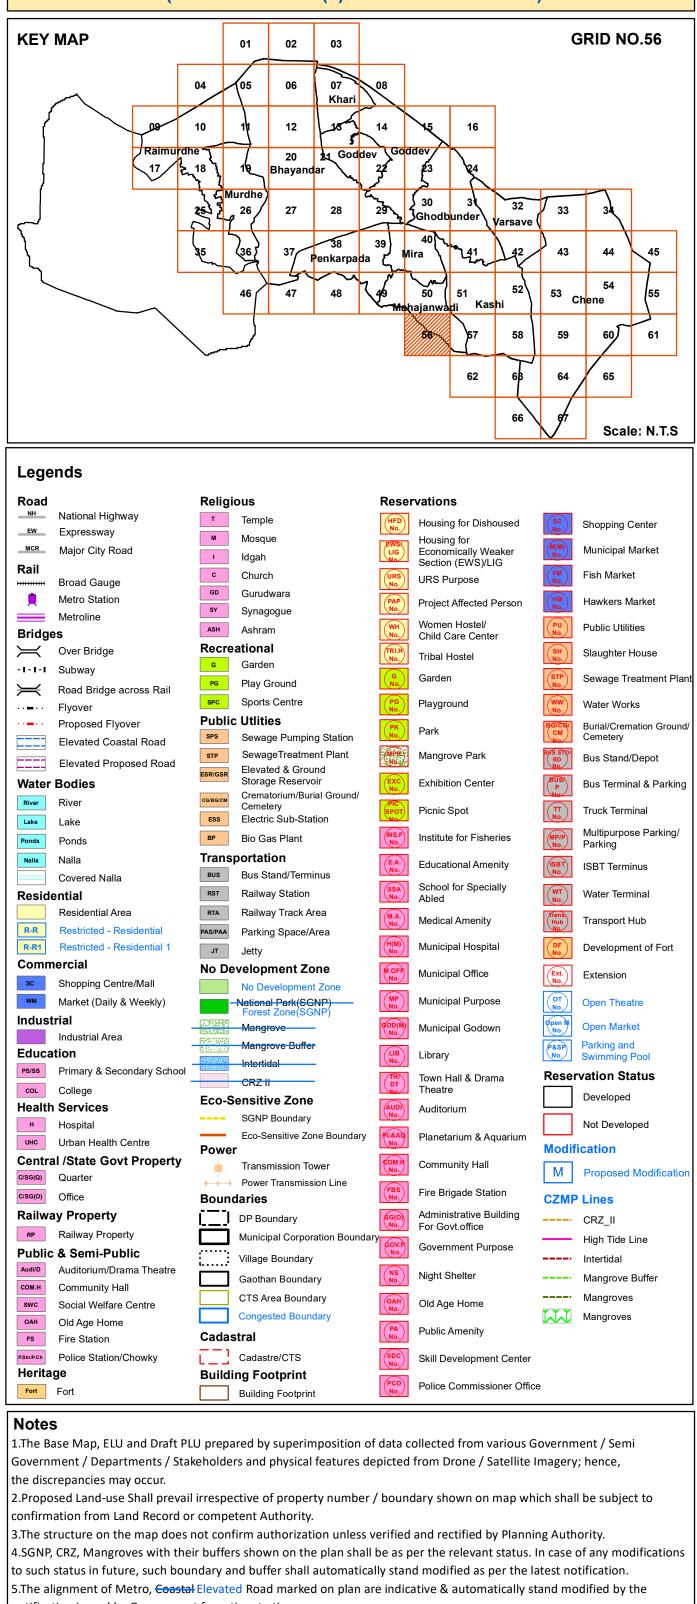

notification issued by Government from time to time. 6.The alignment of nallah / river / creek is indicative and as per the feature extracted from Drone Imagery and data collected. 7. The boundaries of all the designated sites, Government property are shown as per the image captured by superimposition on cadastral map. This may be subject to change as per the actual acquisition in future.

8.This plan is to be read with UDCPR-2022 and Draft DP Report.

9.Existing road shall have status of the road according to width of road even though not shown in development plan. 10.R-R(Restricted-Residential) Residential Zone subject to handing over area to corporation as per permission/Government orders.

11.R-R1 (Restricted- Residential1) All provision of Residential Zone in UDCPR-2020 will be applicable for this zone subject to 10% of area under Development should be kept for Amenity Space as per direction of Municipal Commissioner with prior permission from Eco-Sensitive Zone Commitee.

12.If the location of Metro Carshed and Metro Line is shifted by MMRDA or Elevated Road is shifted in future, the land leased by such shifting shall stands included in adjoining Zone shown on Development Plan.


Scale				North N
0	0.05	0.1	0.2 km	WEE
		1:2,000		S
351101	मुल्यनिधार्रिक		OPt	



Officer Appointed U/s 21(4A)

Sugar

/ Draft Revised Development Plan of Mira Bhayandar

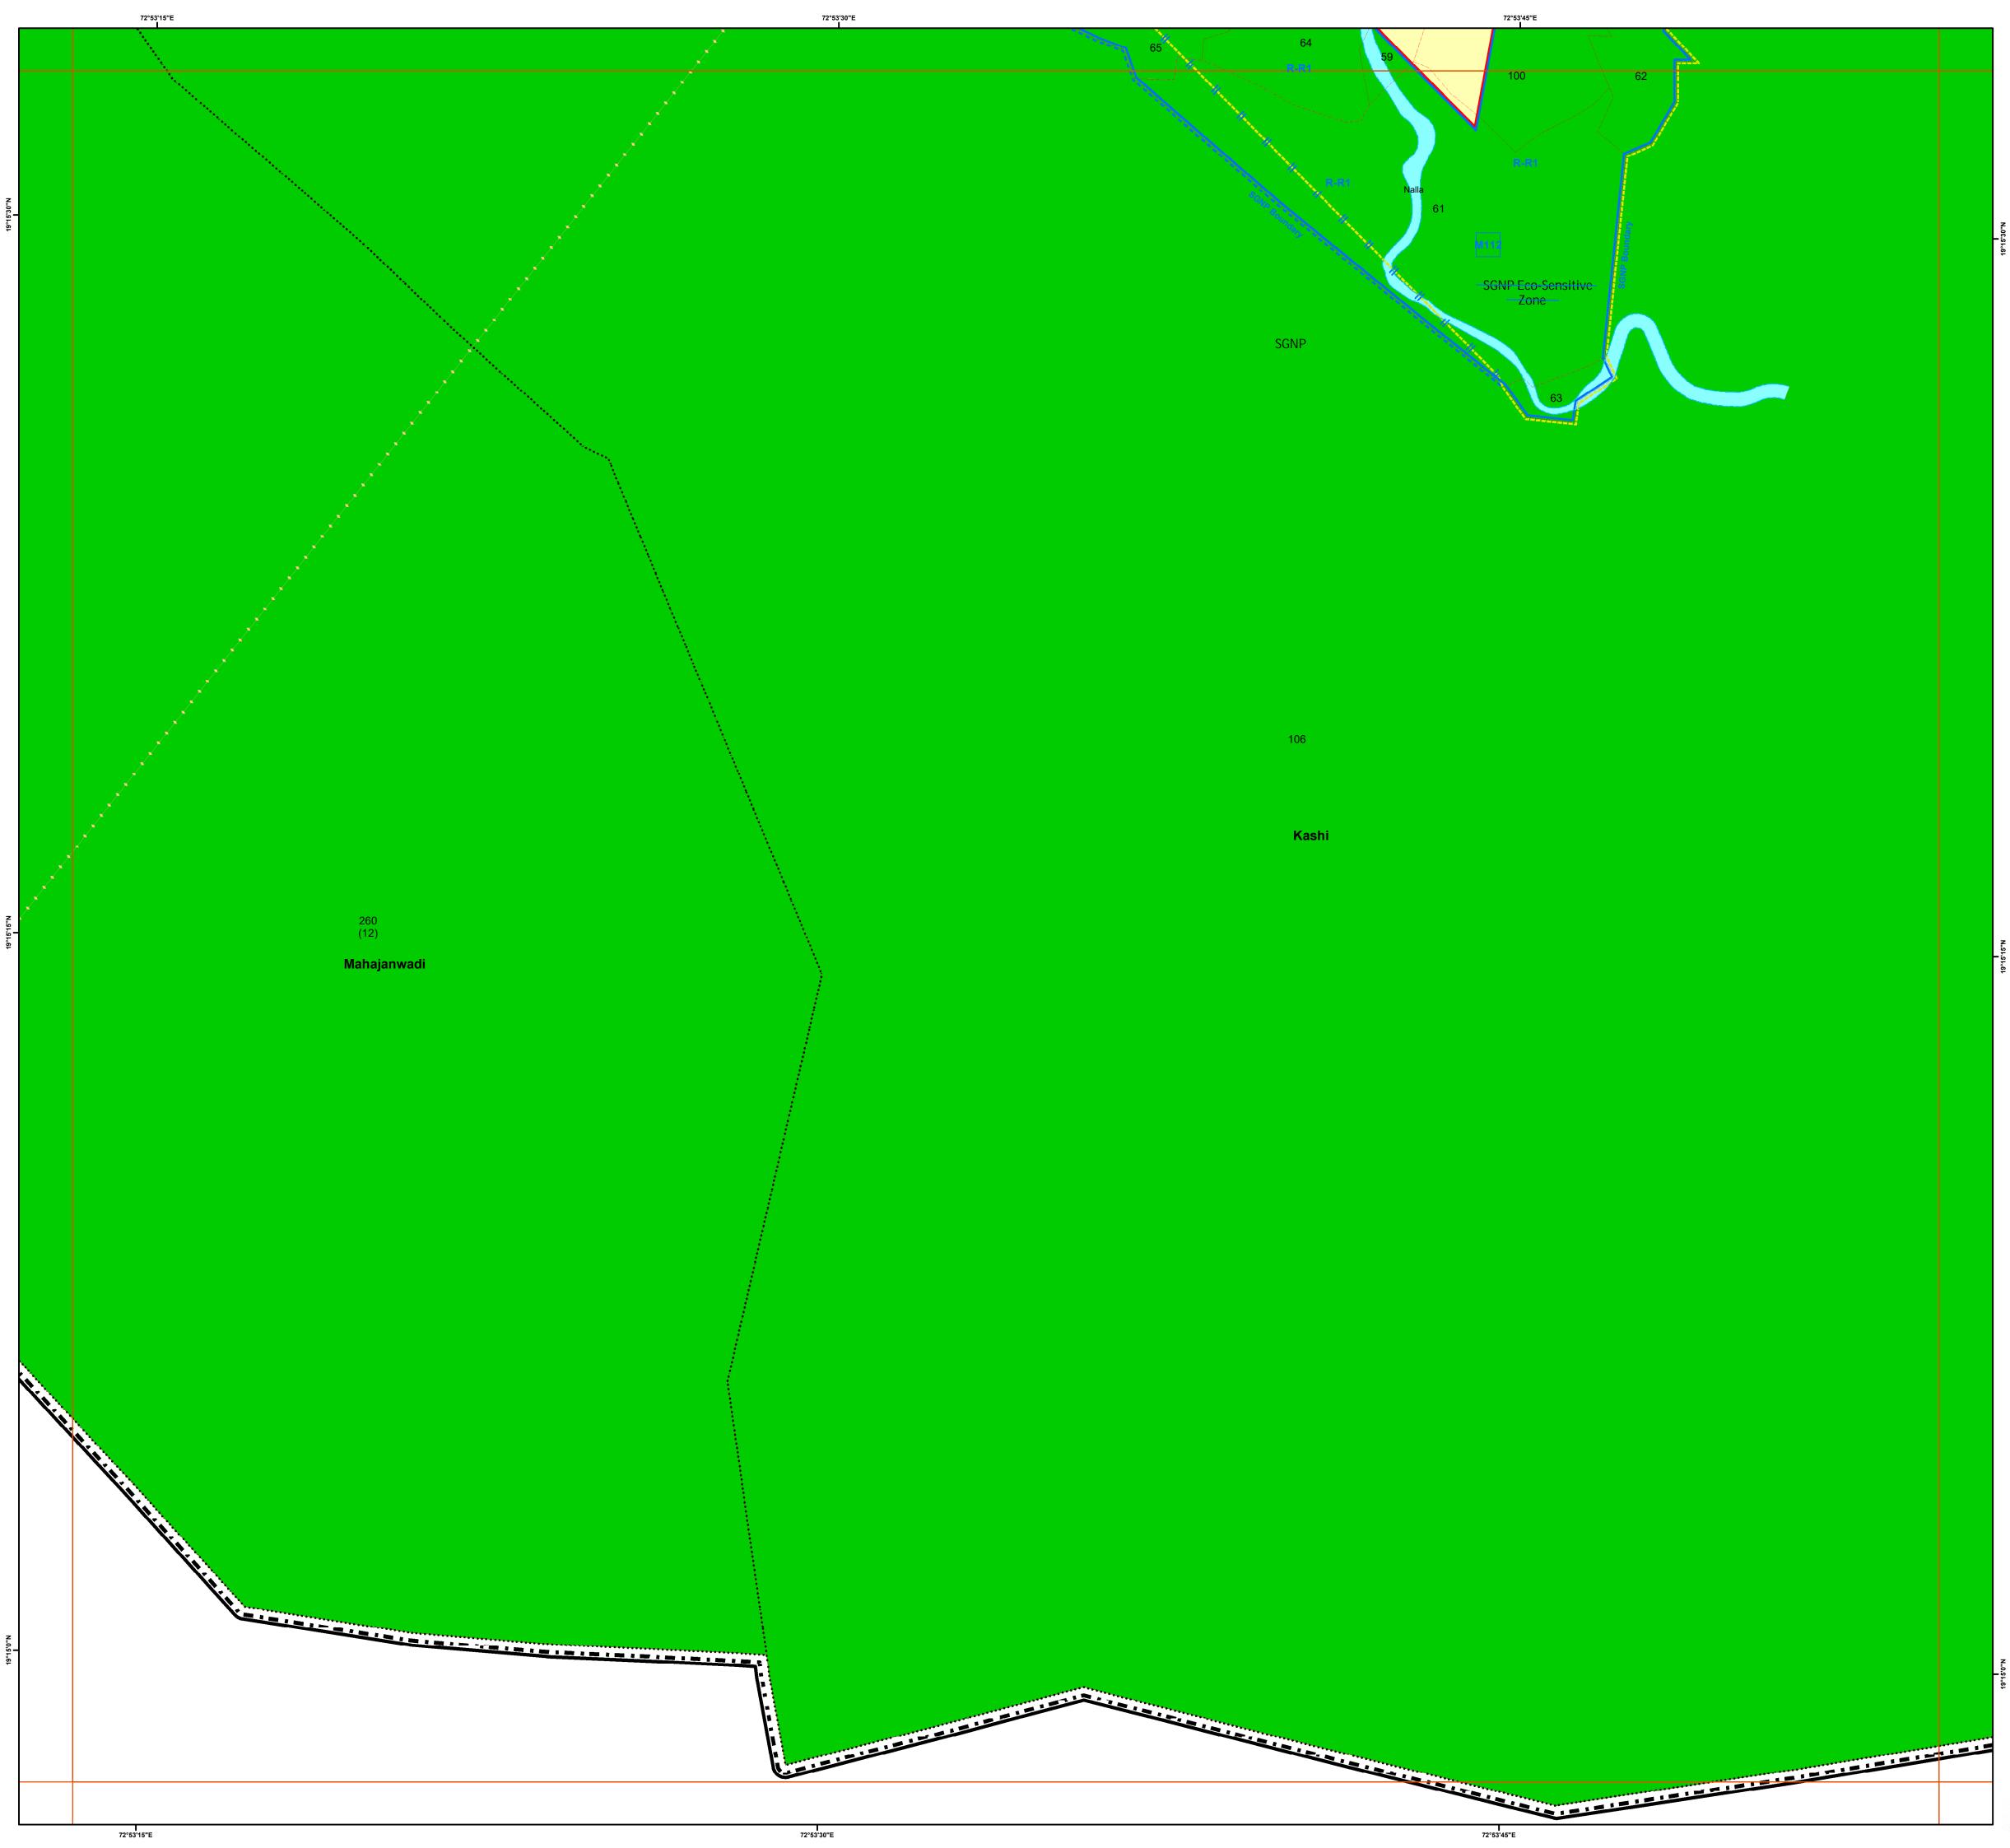



11.R-R1 (Restricted- Residential1) All provision of Residential Zone in UDCPR-2020 will be applicable for this zone subject to 10% of area under Development should be kept for Amenity Space as per direction of Municipal Commissioner with prior permission from Eco-Sensitive Zone Commitee.

12.If the location of Metro Carshed and Metro Line is shifted by MMRDA or Elevated Road is shifted in future, the land eleased by such shifting shall stands included in adjoining Zone shown on Development Plan.

Scale				North N
0	0.05	0.1	0.2 km	WEE
		1:2,000		S
351801 2	मुल्यनिधर्मम्		6204	·





Officer Appointed U/s 21(4A)

Traft Revised Development Plan of Mira Bhayandar

72°54'0"E

72°54'0"E

SGNP

Kashi

106

19°15'0"N

19°15'30"N **1** 


19°15'15"N **I** 

#### Chene

101

72°54'30"E

### DRAFT REVISED DEVELOPMENT PLAN Mira Bhayandar Municipal Corporation (Published U/s.28(4) of M.R.&T.P. Act 1966)

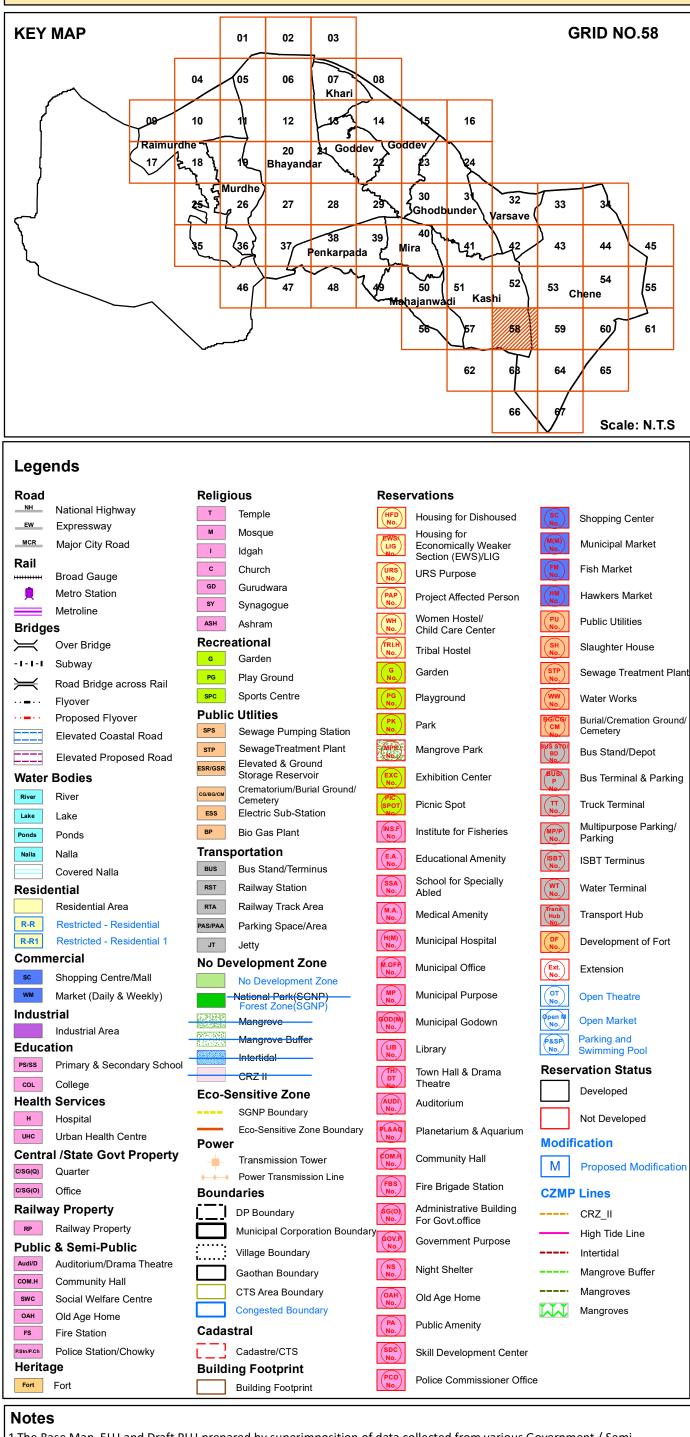

1.The Base Map, ELU and Draft PLU prepared by superimposition of data collected from various Government / Semi Government / Departments / Stakeholders and physical features depicted from Drone / Satellite Imagery; hence, the discrepancies may occur.

2.Proposed Land-use Shall prevail irrespective of property number / boundary shown on map which shall be subject to confirmation from Land Record or competent Authority.

3.The structure on the map does not confirm authorization unless verified and rectified by Planning Authority.
4.SGNP, CRZ, Mangroves with their buffers shown on the plan shall be as per the relevant status. In case of any modifications to such status in future, such boundary and buffer shall automatically stand modified as per the latest notification.
5.The alignment of Metro, Coastal Elevated Road marked on plan are indicative & automatically stand modified by the notification issued by Government from time to time.

6.The alignment of nallah / river / creek is indicative and as per the feature extracted from Drone Imagery and data collected.
7.The boundaries of all the designated sites, Government property are shown as per the image captured by superimposition on cadastral map. This may be subject to change as per the actual acquisition in future.
8.This plan is to be read with UDCPR-2022 and Draft DP Report.

9.Existing road shall have status of the road according to width of road even though not shown in development plan. 10.R-R(Restricted-Residential) Residential Zone subject to handing over area to corporation as per permission/Government orders.

11.R-R1 (Restricted- Residential1) All provision of Residential Zone in UDCPR-2020 will be applicable for this zone subject to 10% of area under Development should be kept for Amenity Space as per direction of Municipal Commissioner with prior permission from Eco-Sensitive Zone Commitee.

12.If the location of Metro Carshed and Metro Line is shifted by MMRDA or Elevated Road is shifted in future, the land released by such shifting shall stands included in adjoining Zone shown on Development Plan.

Scale				North N
0	0.05	0.1	0.2 km	W
		1:2,000		S
311	मुल्यनिधर्महत			





Officer Appointed U/s 21(4A)

Draft Revised Development Plan of Mirá Bhayandar

Assistant Director of Town Planning, Thane

19°15'15"N

19°15'30"N 1

72°54'45"E


SGNP

72°54'45"E

101


101

19°15'0"N **I** 

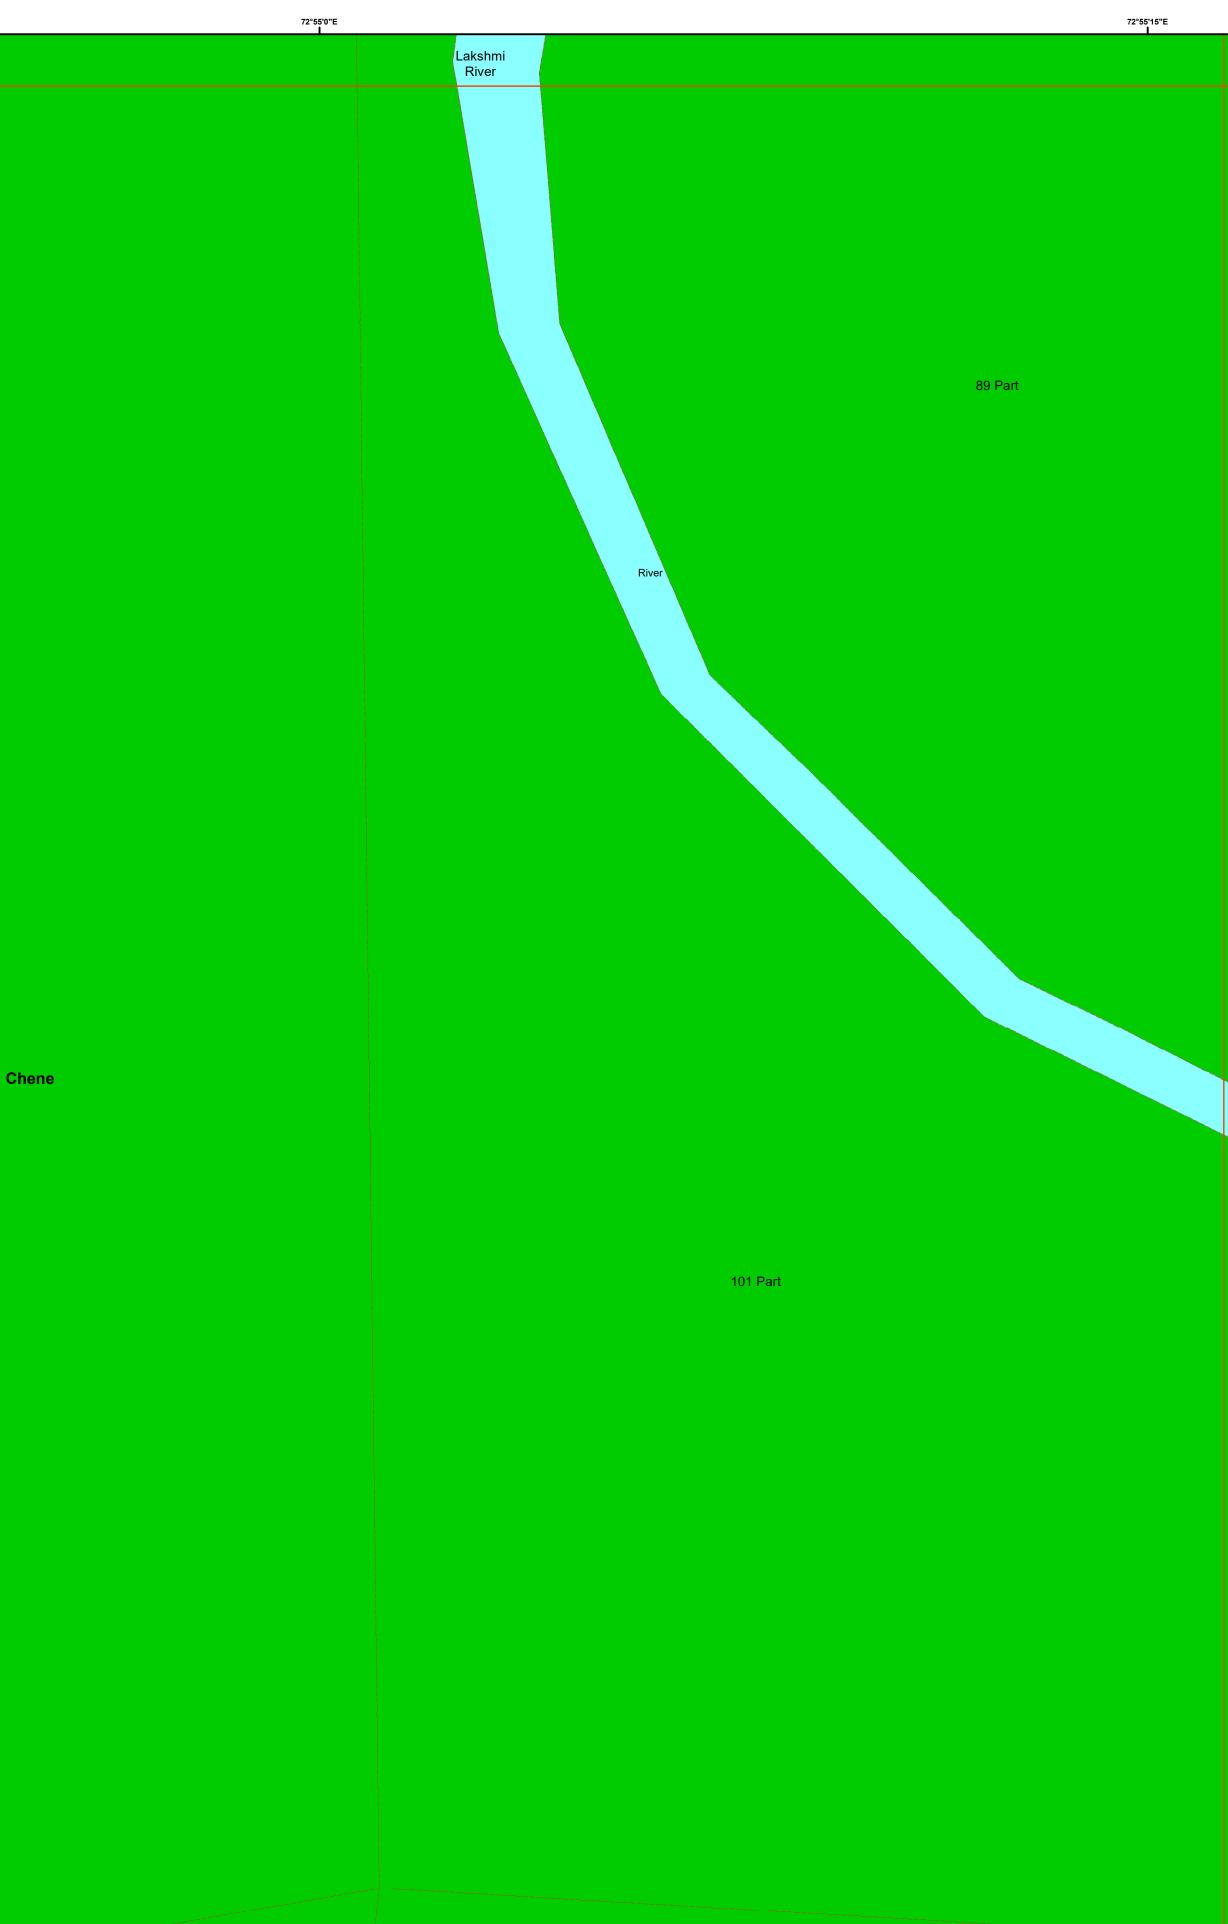

102

### DRAFT REVISED DEVELOPMENT PLAN Mira Bhayandar Municipal Corporation (Published U/s.28(4) of M.R.&T.P. Act 1966)

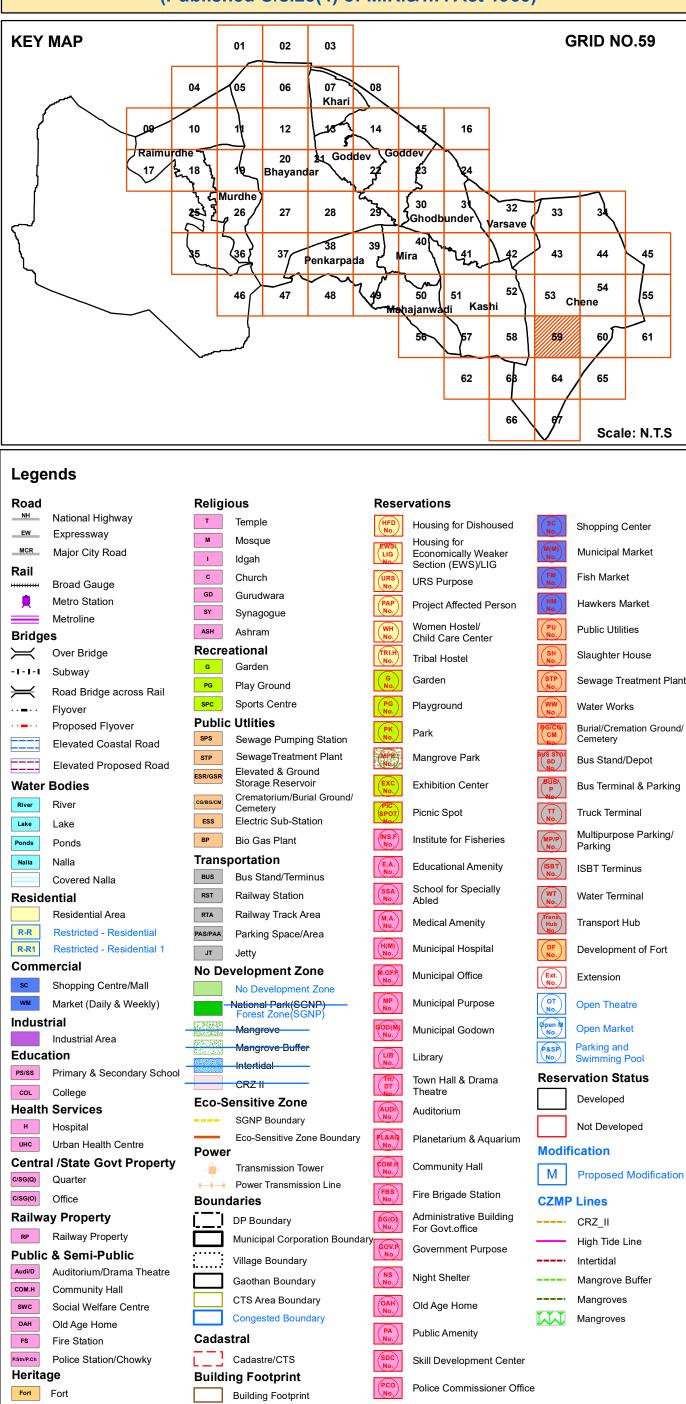

#### Notes

1. The Base Map, ELU and Draft PLU prepared by superimposition of data collected from various Government / Semi Government / Departments / Stakeholders and physical features depicted from Drone / Satellite Imagery; hence, the discrepancies may occur.

2. Proposed Land-use Shall prevail irrespective of property number / boundary shown on map which shall be subject to confirmation from Land Record or competent Authority.

3.The structure on the map does not confirm authorization unless verified and rectified by Planning Authority. 4.SGNP, CRZ, Mangroves with their buffers shown on the plan shall be as per the relevant status. In case of any modifications to such status in future, such boundary and buffer shall automatically stand modified as per the latest notification. 5. The alignment of Metro, <del>Coastal</del> Elevated Road marked on plan are indicative & automatically stand modified by the notification issued by Government from time to time.

6. The alignment of nallah / river / creek is indicative and as per the feature extracted from Drone Imagery and data collected. 7. The boundaries of all the designated sites, Government property are shown as per the image captured by superimposition on cadastral map. This may be subject to change as per the actual acquisition in future. 8.This plan is to be read with UDCPR-2022 and Draft DP Report.

9. Existing road shall have status of the road according to width of road even though not shown in development plan. 10.R-R(Restricted-Residential) Residential Zone subject to handing over area to corporation as per permission/Government

11.R-R1 (Restricted- Residential1) All provision of Residential Zone in UDCPR-2020 will be applicable for this zone subject to 10% of area under Development should be kept for Amenity Space as per direction of Municipal Commissioner with prior permission from Eco-Sensitive Zone Commitee.

12.If the location of Metro Carshed and Metro Line is shifted by MMRDA or Elevated Road is shifted in future, the land leased by such shifting shall stands included in adjoining Zone shown on Development Plan.

Scale				North N
0	0.05	0.1	0.2 km	WEE
		1:2,000		S
25100	मुल्यनिधारिष			



River

Lakshmi River

101 Part

19°15'0"N I


72°55'30"E

89 Part


Chene

SGNP

72°55'30"E

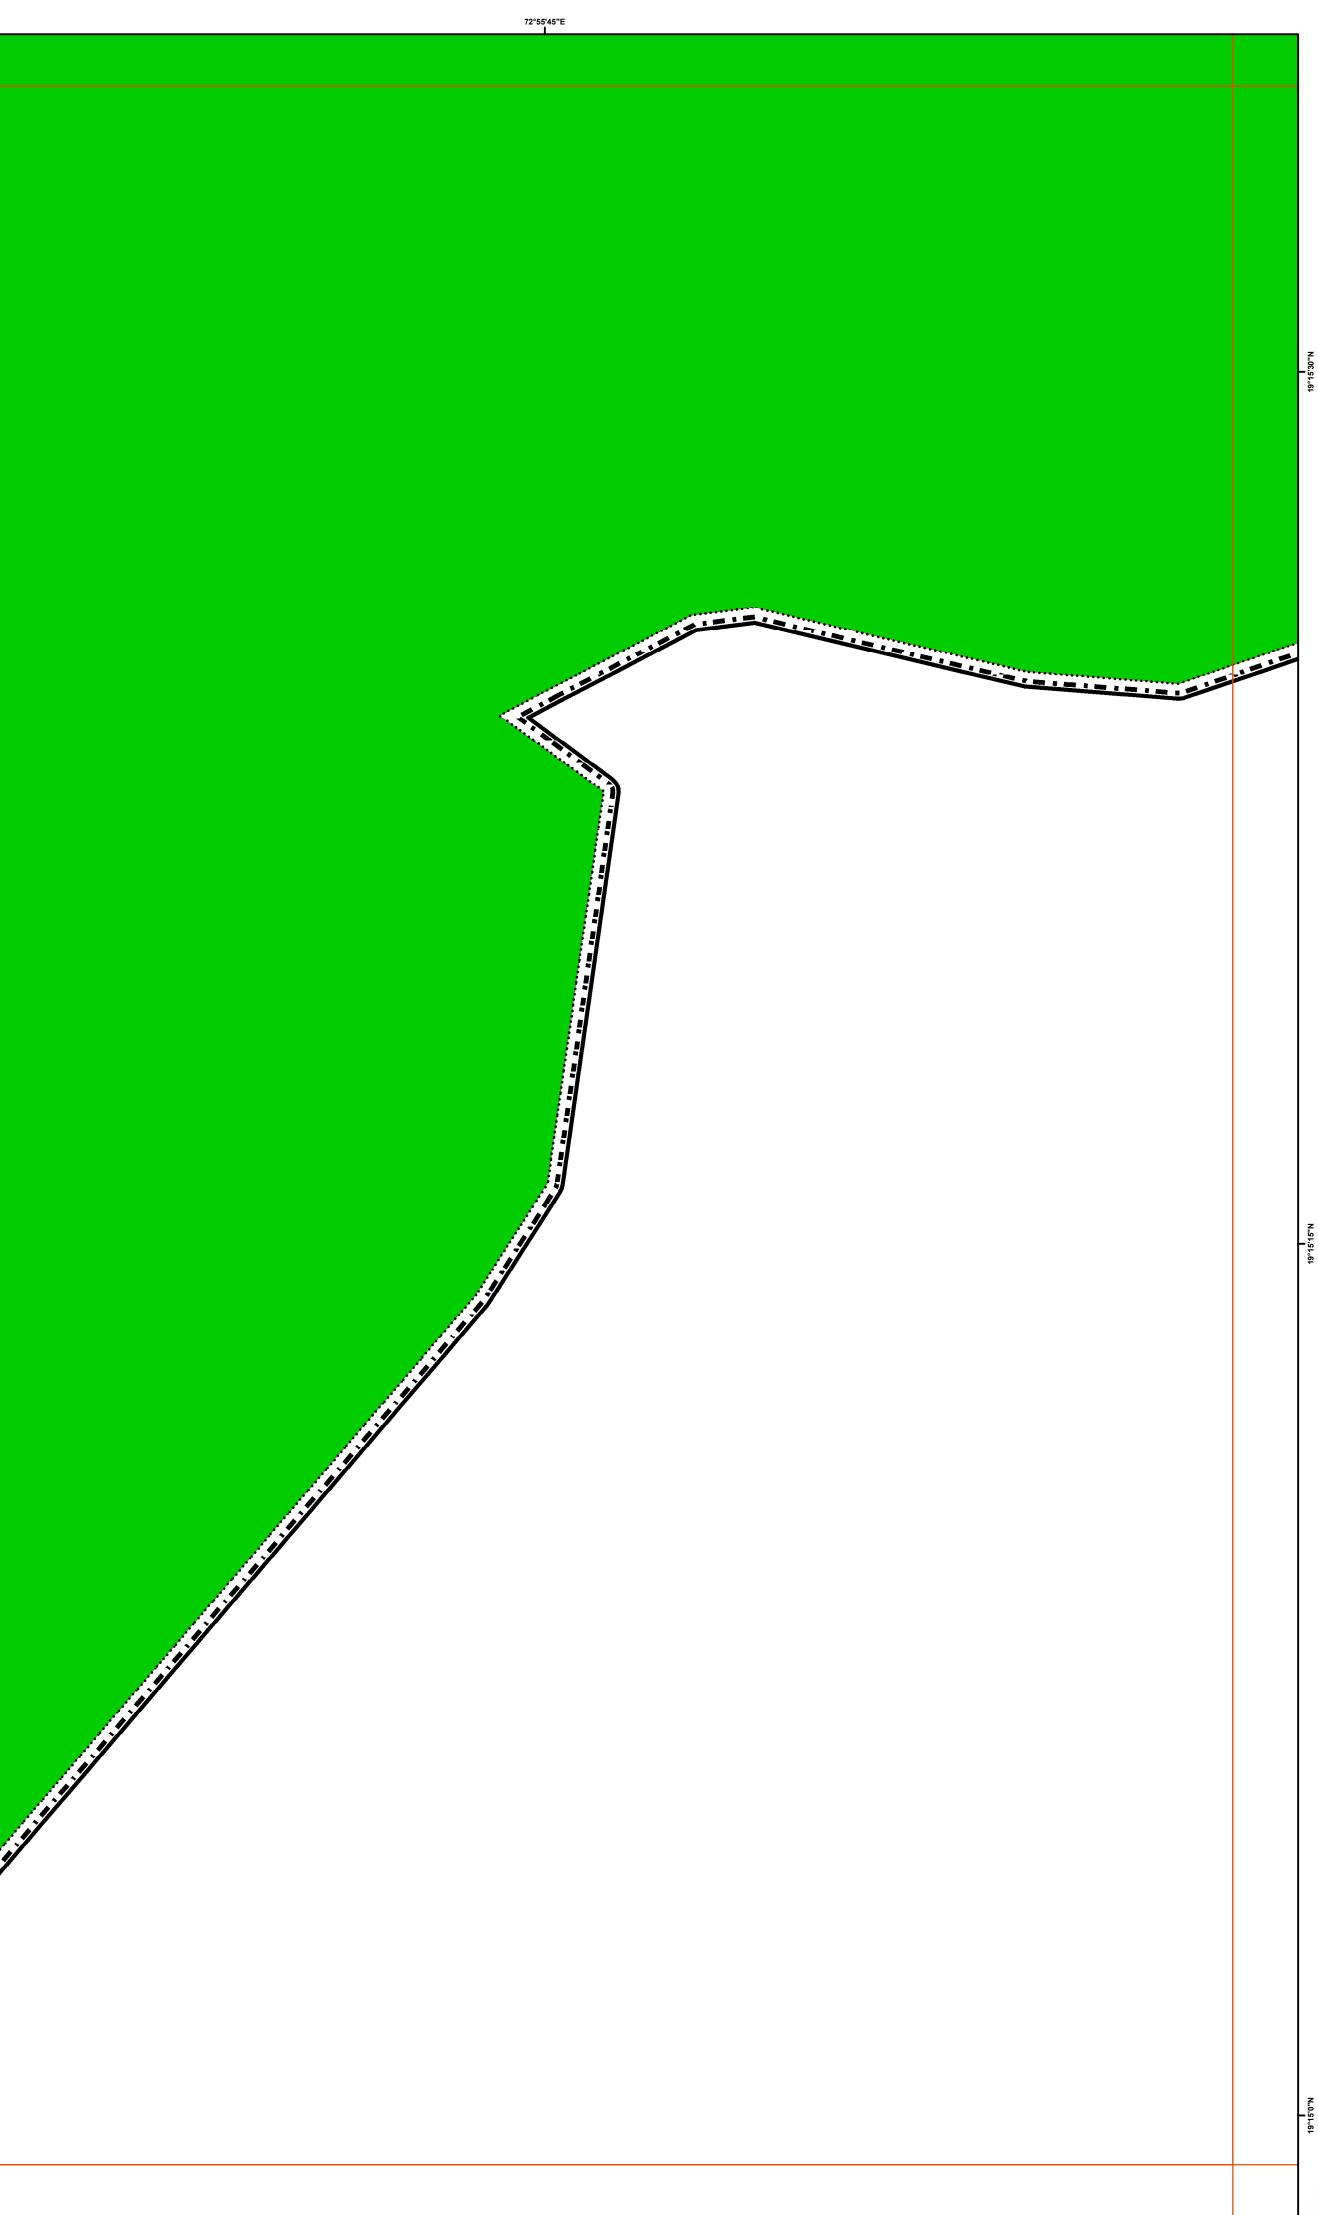

### DRAFT REVISED DEVELOPMENT PLAN Mira Bhayandar Municipal Corporation (Published U/s.28(4) of M.R.&T.P. Act 1966)

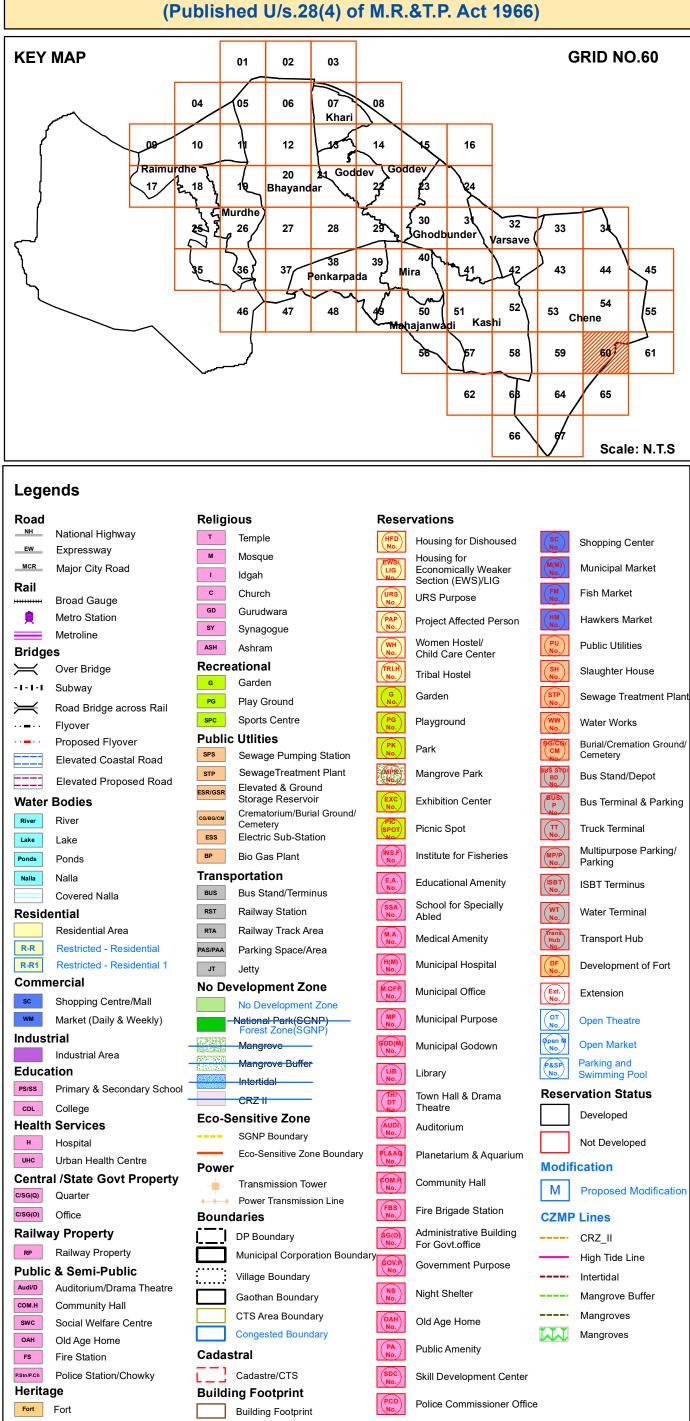

#### Notes

1. The Base Map, ELU and Draft PLU prepared by superimposition of data collected from various Government / Semi Government / Departments / Stakeholders and physical features depicted from Drone / Satellite Imagery; hence, the discrepancies may occur.

2. Proposed Land-use Shall prevail irrespective of property number / boundary shown on map which shall be subject to confirmation from Land Record or competent Authority.

3.The structure on the map does not confirm authorization unless verified and rectified by Planning Authority. 4.SGNP, CRZ, Mangroves with their buffers shown on the plan shall be as per the relevant status. In case of any modifications to such status in future, such boundary and buffer shall automatically stand modified as per the latest notification. 5. The alignment of Metro, <del>Coastal</del> Elevated Road marked on plan are indicative & automatically stand modified by the notification issued by Government from time to time. 6. The alignment of nallah / river / creek is indicative and as per the feature extracted from Drone Imagery and data collected.

7. The boundaries of all the designated sites, Government property are shown as per the image captured by superimposition on cadastral map. This may be subject to change as per the actual acquisition in future. 8.This plan is to be read with UDCPR-2022 and Draft DP Report.

9. Existing road shall have status of the road according to width of road even though not shown in development plan. 10.R-R(Restricted-Residential) Residential Zone subject to handing over area to corporation as per permission/Government 11.R-R1 (Restricted- Residential1) All provision of Residential Zone in UDCPR-2020 will be applicable for this zone subject to

10% of area under Development should be kept for Amenity Space as per direction of Municipal Commissioner with prior permission from Eco-Sensitive Zone Commitee.


12.If the location of Metro Carshed and Metro Line is shifted by MMRDA or Elevated Road is shifted in future, the land leased by such shifting shall stands included in adjoining Zone shown on Development Plan.

Scale				North N
0	0.05	0.1	0.2 km	WEE
		1:2,000		S
31101 3	यनिस्तर ह		6204	·





Officer Appointed U/s 21(4A) ★ Draft Revised Development Plan of Mira Bhayandar

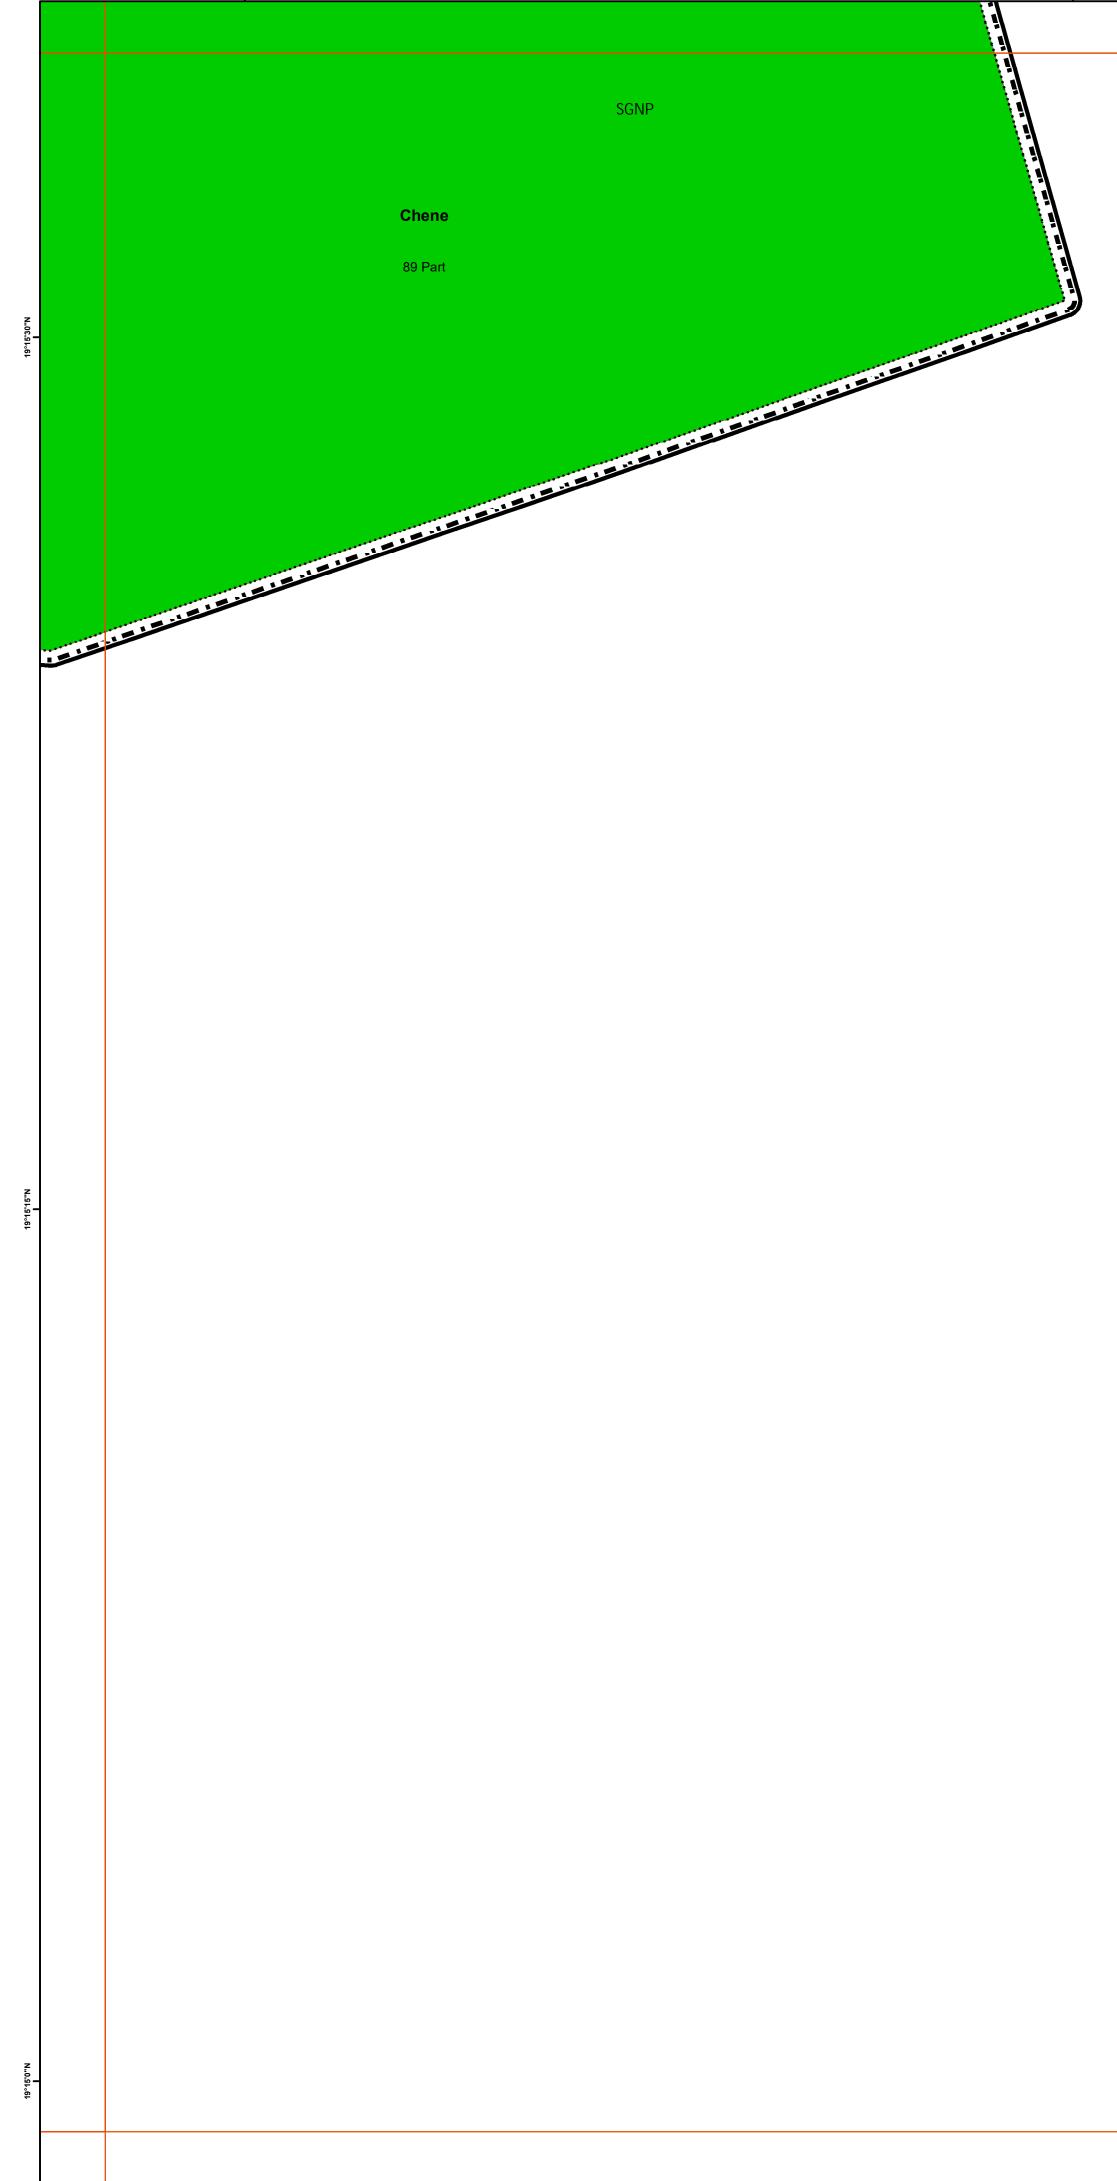


72°56'0"E

72°56'15"E


72°56'30"E

### DRAFT REVISED DEVELOPMENT PLAN Mira Bhayandar Municipal Corporation (Published U/s.28(4) of M.R.&T.P. Act 1966)

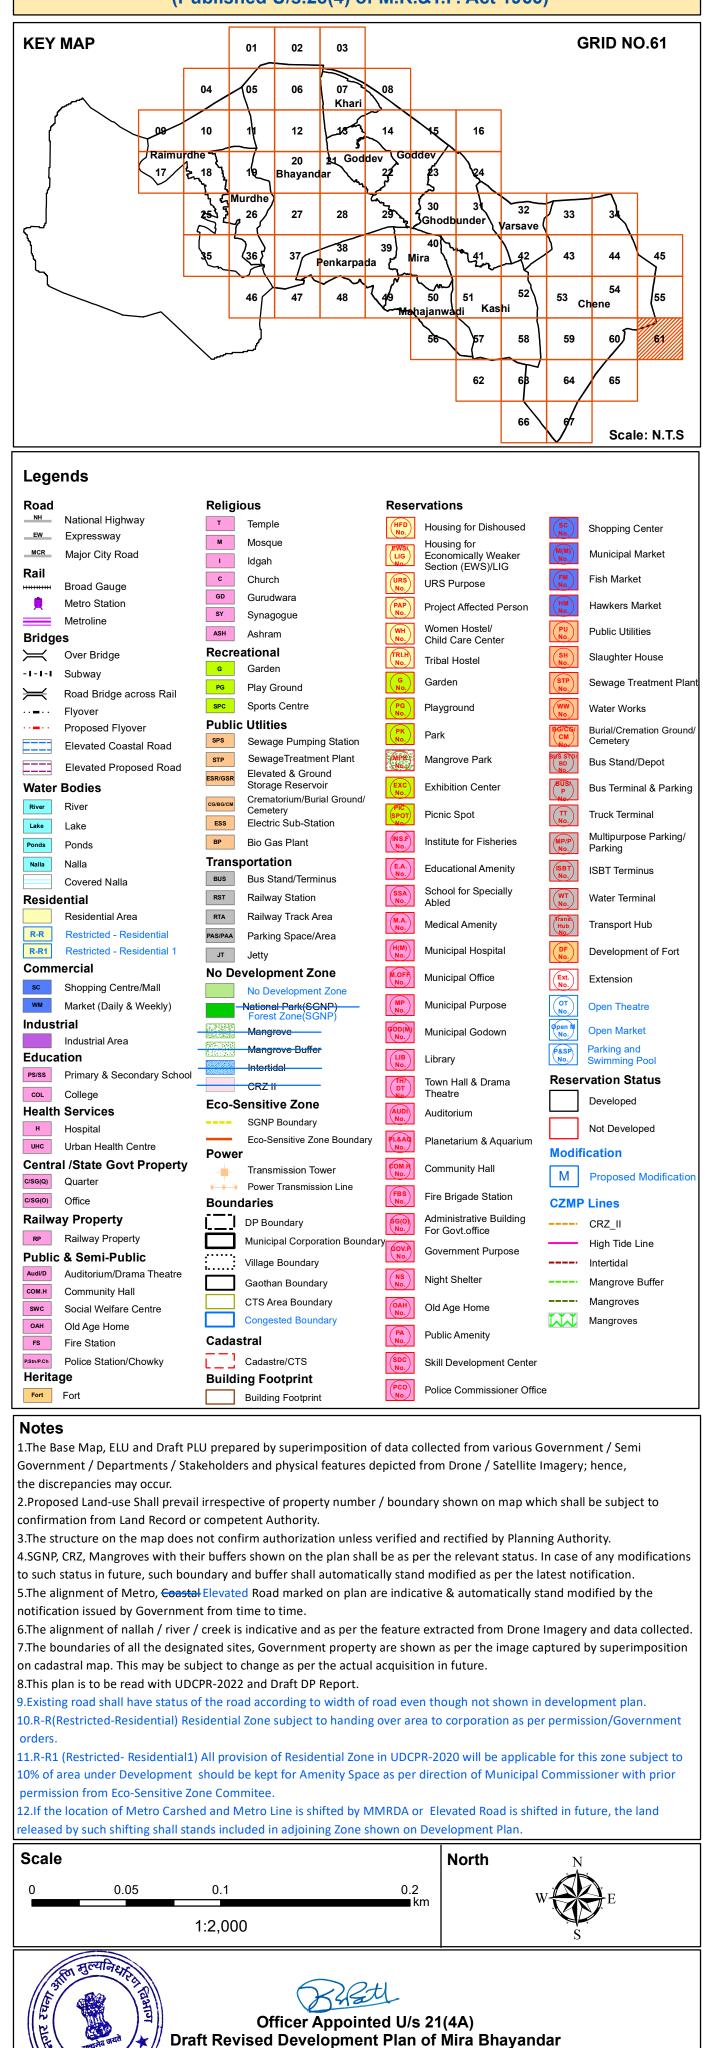


ठाणे १

72°53'15"E	
12 53 15 E	

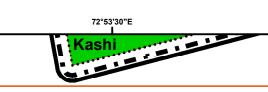

°53'45"E	
Kashi <sup>106</sup>	
Kashi 106	

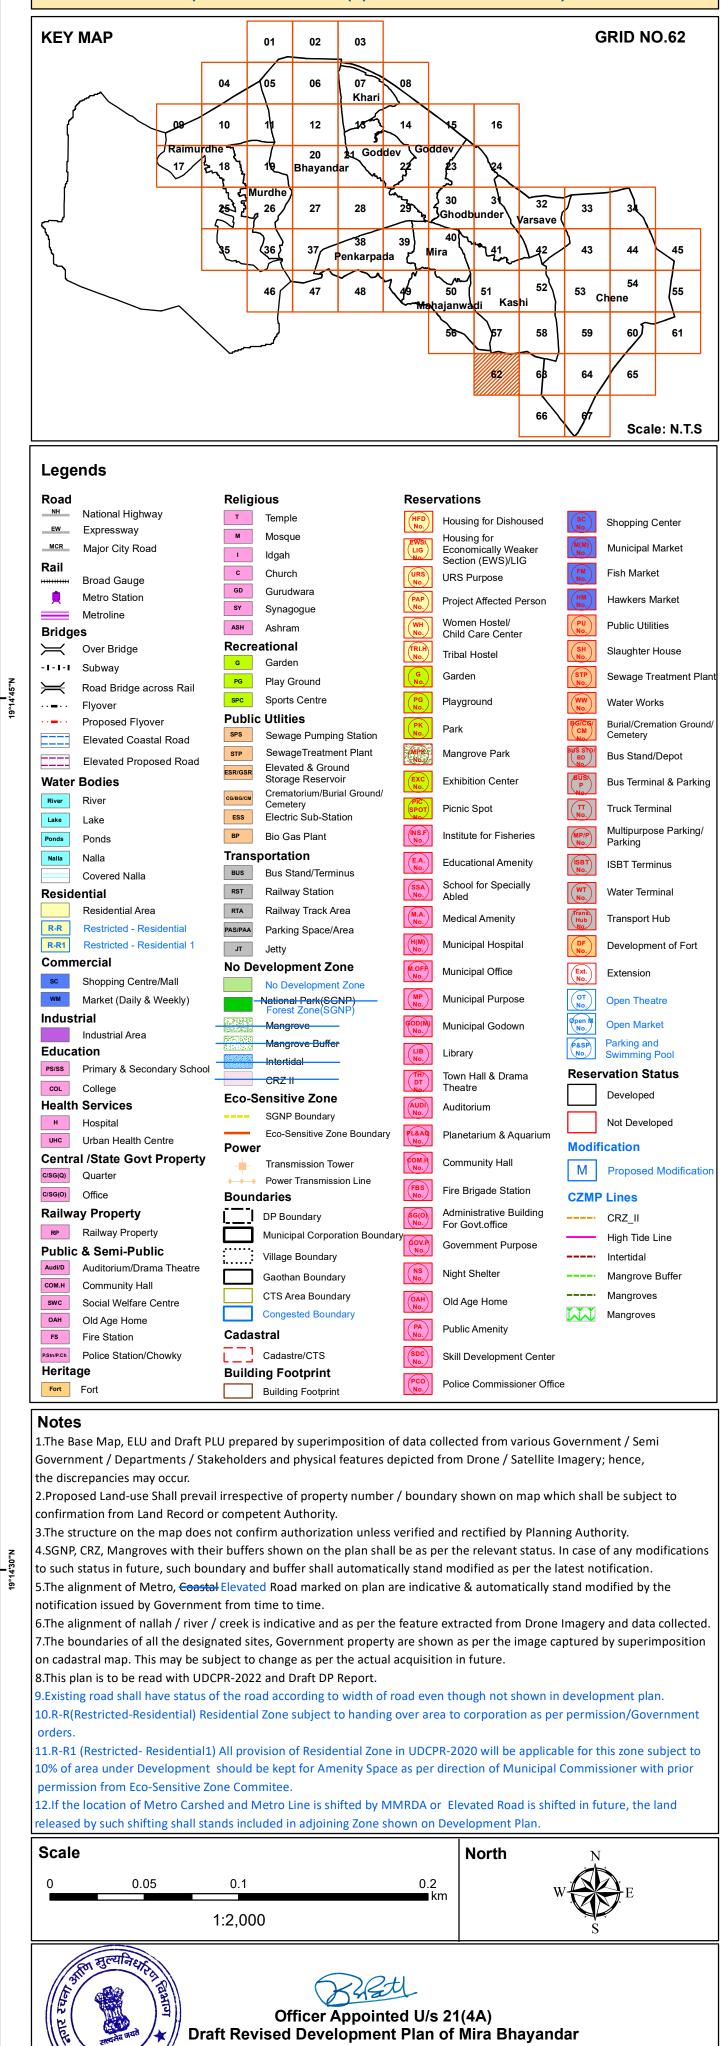

Assistant Director of Town Planning, Thane

ठाणे शार

Kashi-106

101

72°54'30"E


Kashi

106

# SGNP

#### 101 Chene

### DRAFT REVISED DEVELOPMENT PLAN Mira Bhayandar Municipal Corporation (Published U/s.28(4) of M.R.&T.P. Act 1966)

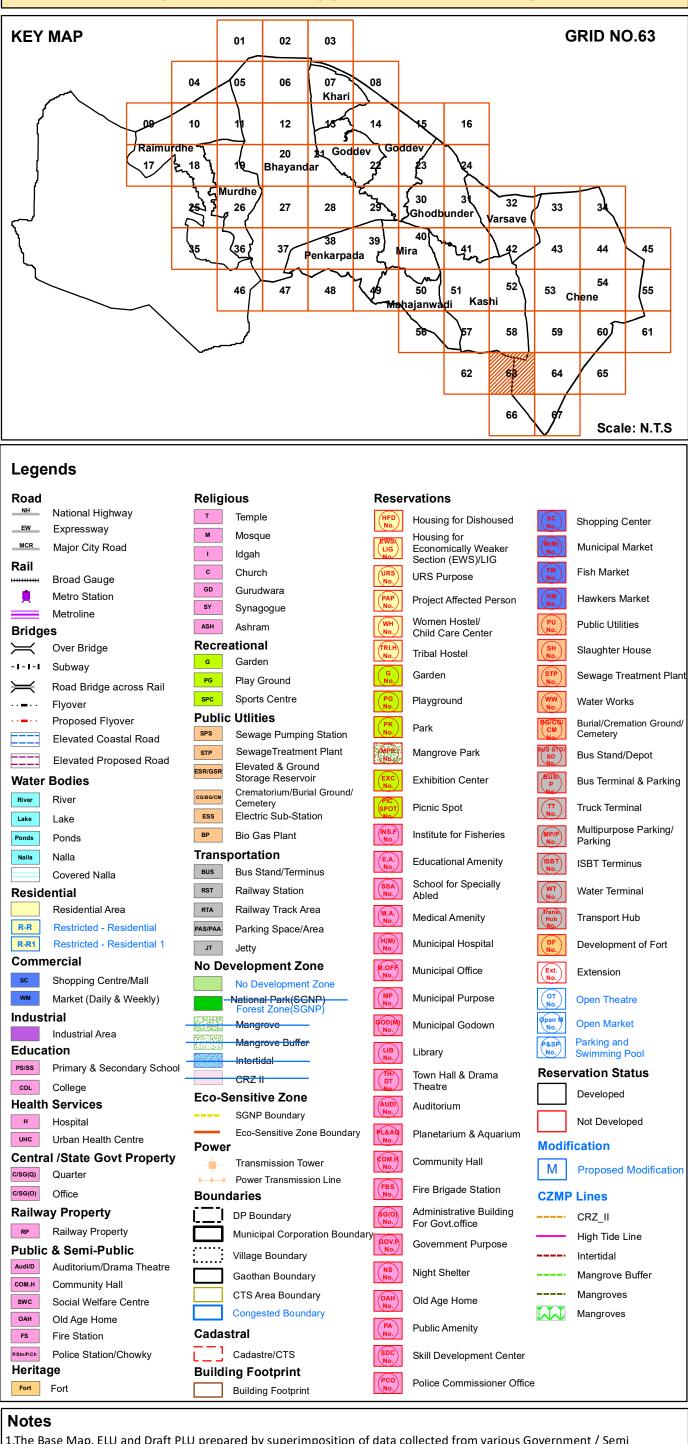

1. The Base Map, ELU and Draft PLU prepared by superimposition of data collected from various Government / Semi Government / Departments / Stakeholders and physical features depicted from Drone / Satellite Imagery; hence, the discrepancies may occur.

2. Proposed Land-use Shall prevail irrespective of property number / boundary shown on map which shall be subject to confirmation from Land Record or competent Authority.

3.The structure on the map does not confirm authorization unless verified and rectified by Planning Authority. 4.SGNP, CRZ, Mangroves with their buffers shown on the plan shall be as per the relevant status. In case of any modifications to such status in future, such boundary and buffer shall automatically stand modified as per the latest notification. 5. The alignment of Metro, Coastal Elevated Road marked on plan are indicative & automatically stand modified by the notification issued by Government from time to time.

6. The alignment of nallah / river / creek is indicative and as per the feature extracted from Drone Imagery and data collected. 7. The boundaries of all the designated sites, Government property are shown as per the image captured by superimposition on cadastral map. This may be subject to change as per the actual acquisition in future. 8.This plan is to be read with UDCPR-2022 and Draft DP Report.

9. Existing road shall have status of the road according to width of road even though not shown in development plan. 10.R-R(Restricted-Residential) Residential Zone subject to handing over area to corporation as per permission/Government

11.R-R1 (Restricted- Residential1) All provision of Residential Zone in UDCPR-2020 will be applicable for this zone subject to 10% of area under Development should be kept for Amenity Space as per direction of Municipal Commissioner with prior permission from Eco-Sensitive Zone Commitee.

12.If the location of Metro Carshed and Metro Line is shifted by MMRDA or Elevated Road is shifted in future, the land leased by such shifting shall stands included in adjoining Zone shown on Development Plan.

Scale				North N
0	0.05	0.1	0.2 km	WEE
		1:2,000		S
351100	मुल्यनिधारिक		62PH	·





Officer Appointed U/s 21(4A)


/ Draft Revised Development Plan of Mira Bhayandar

72°54'45"E

101

Chene

SGNP

 

72°55'0"E

102


72°55'15"E

### DRAFT REVISED DEVELOPMENT PLAN Mira Bhayandar Municipal Corporation (Published U/s.28(4) of M.R.&T.P. Act 1966)



Assistant Director of Town Planning, Thane


ठाणे 🕯

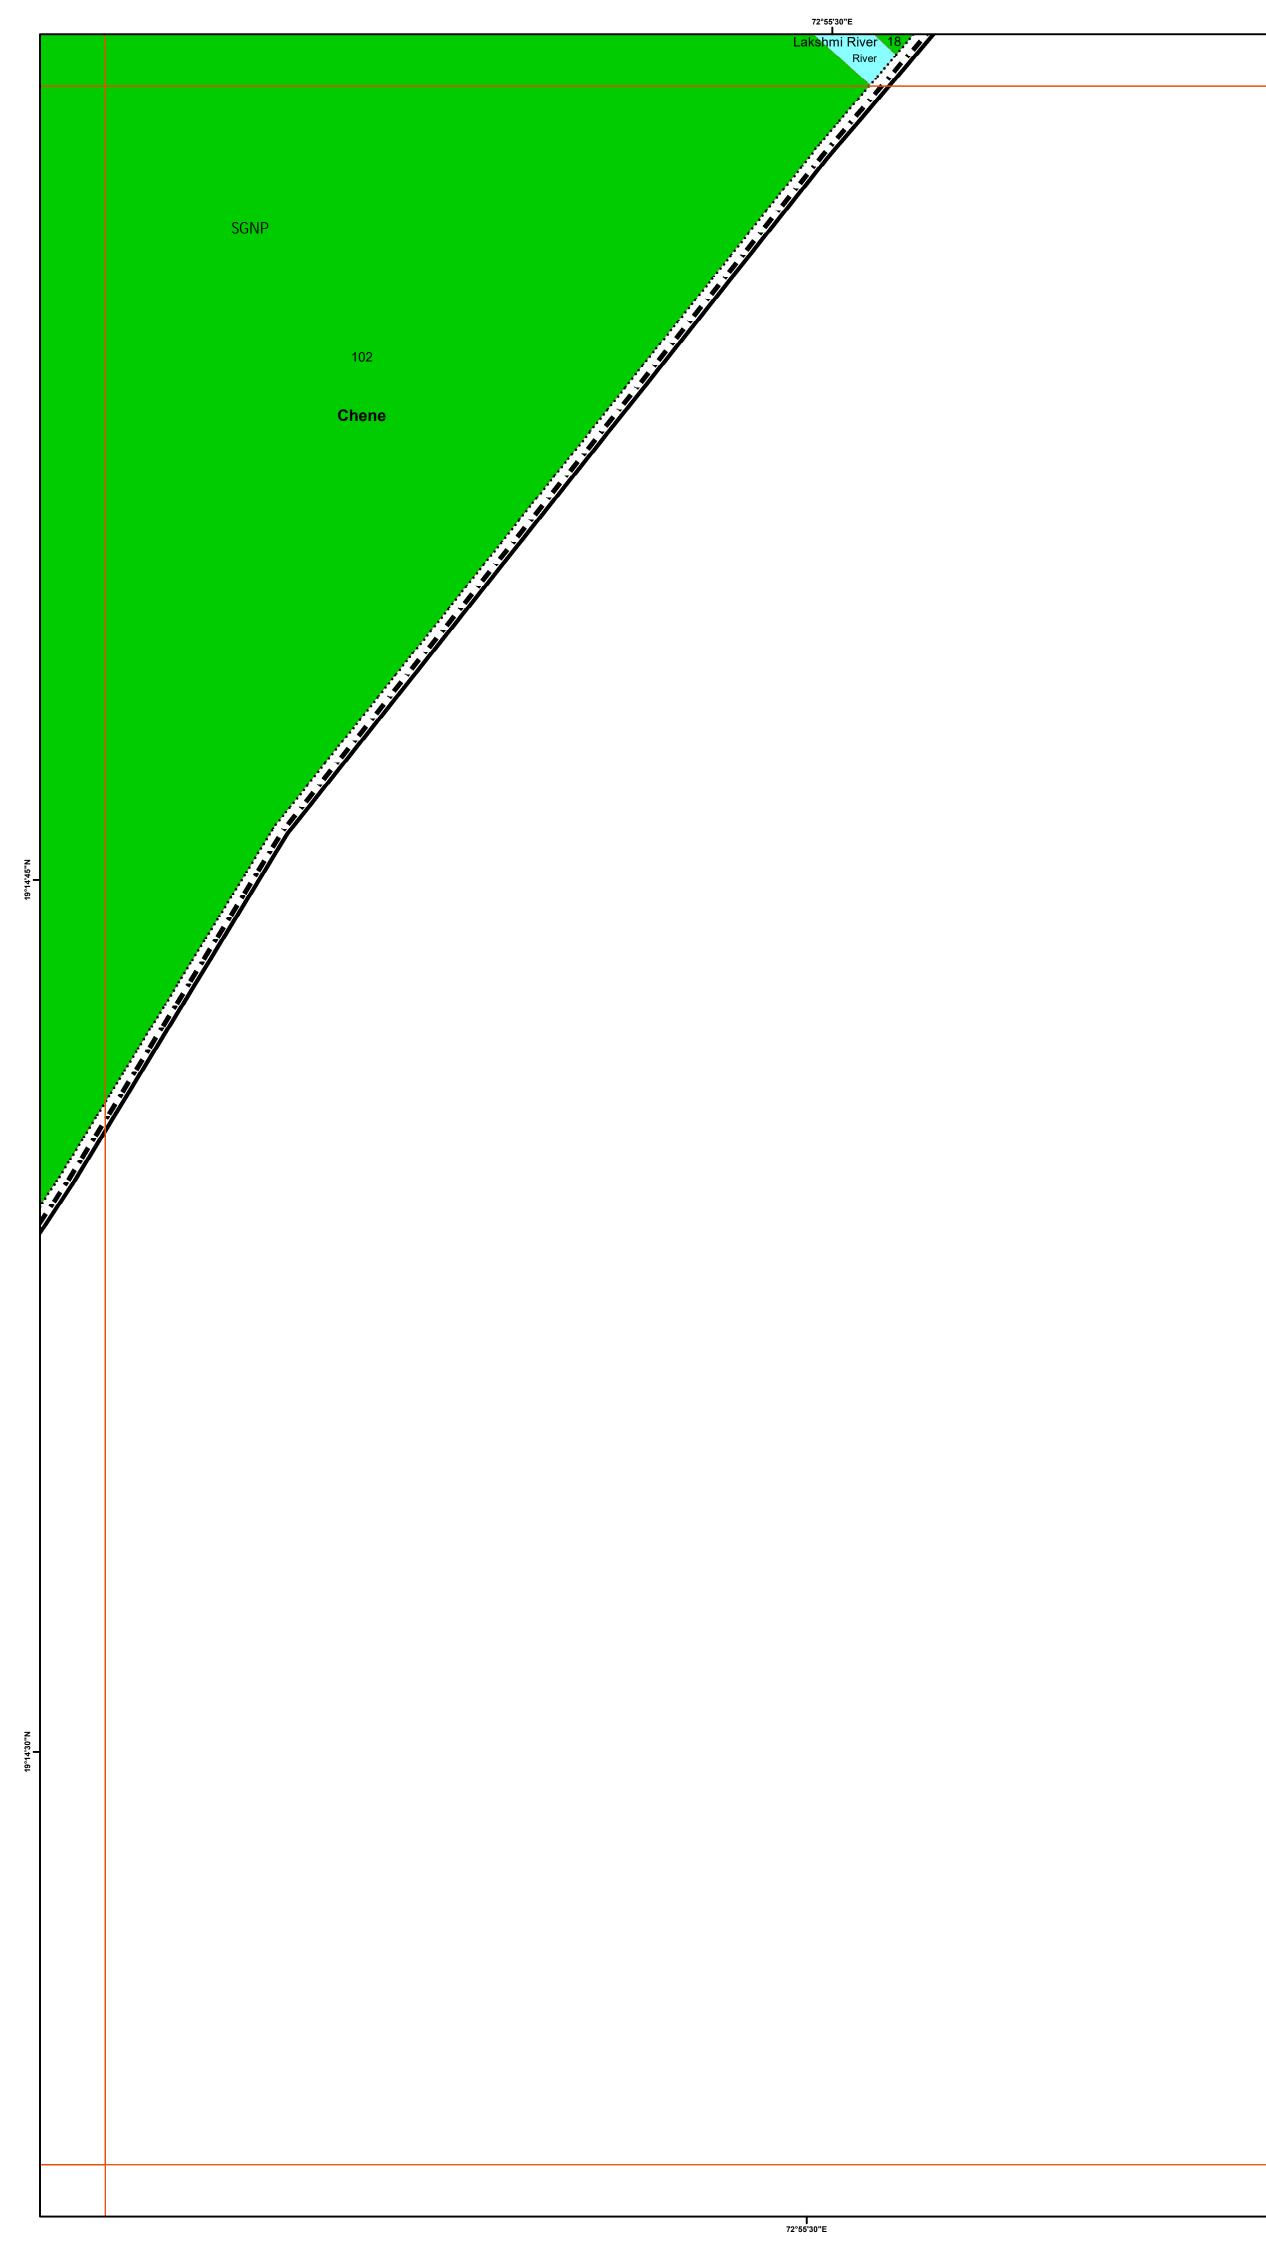




Assistant Director of Town Planning, Thane

ठाणे १

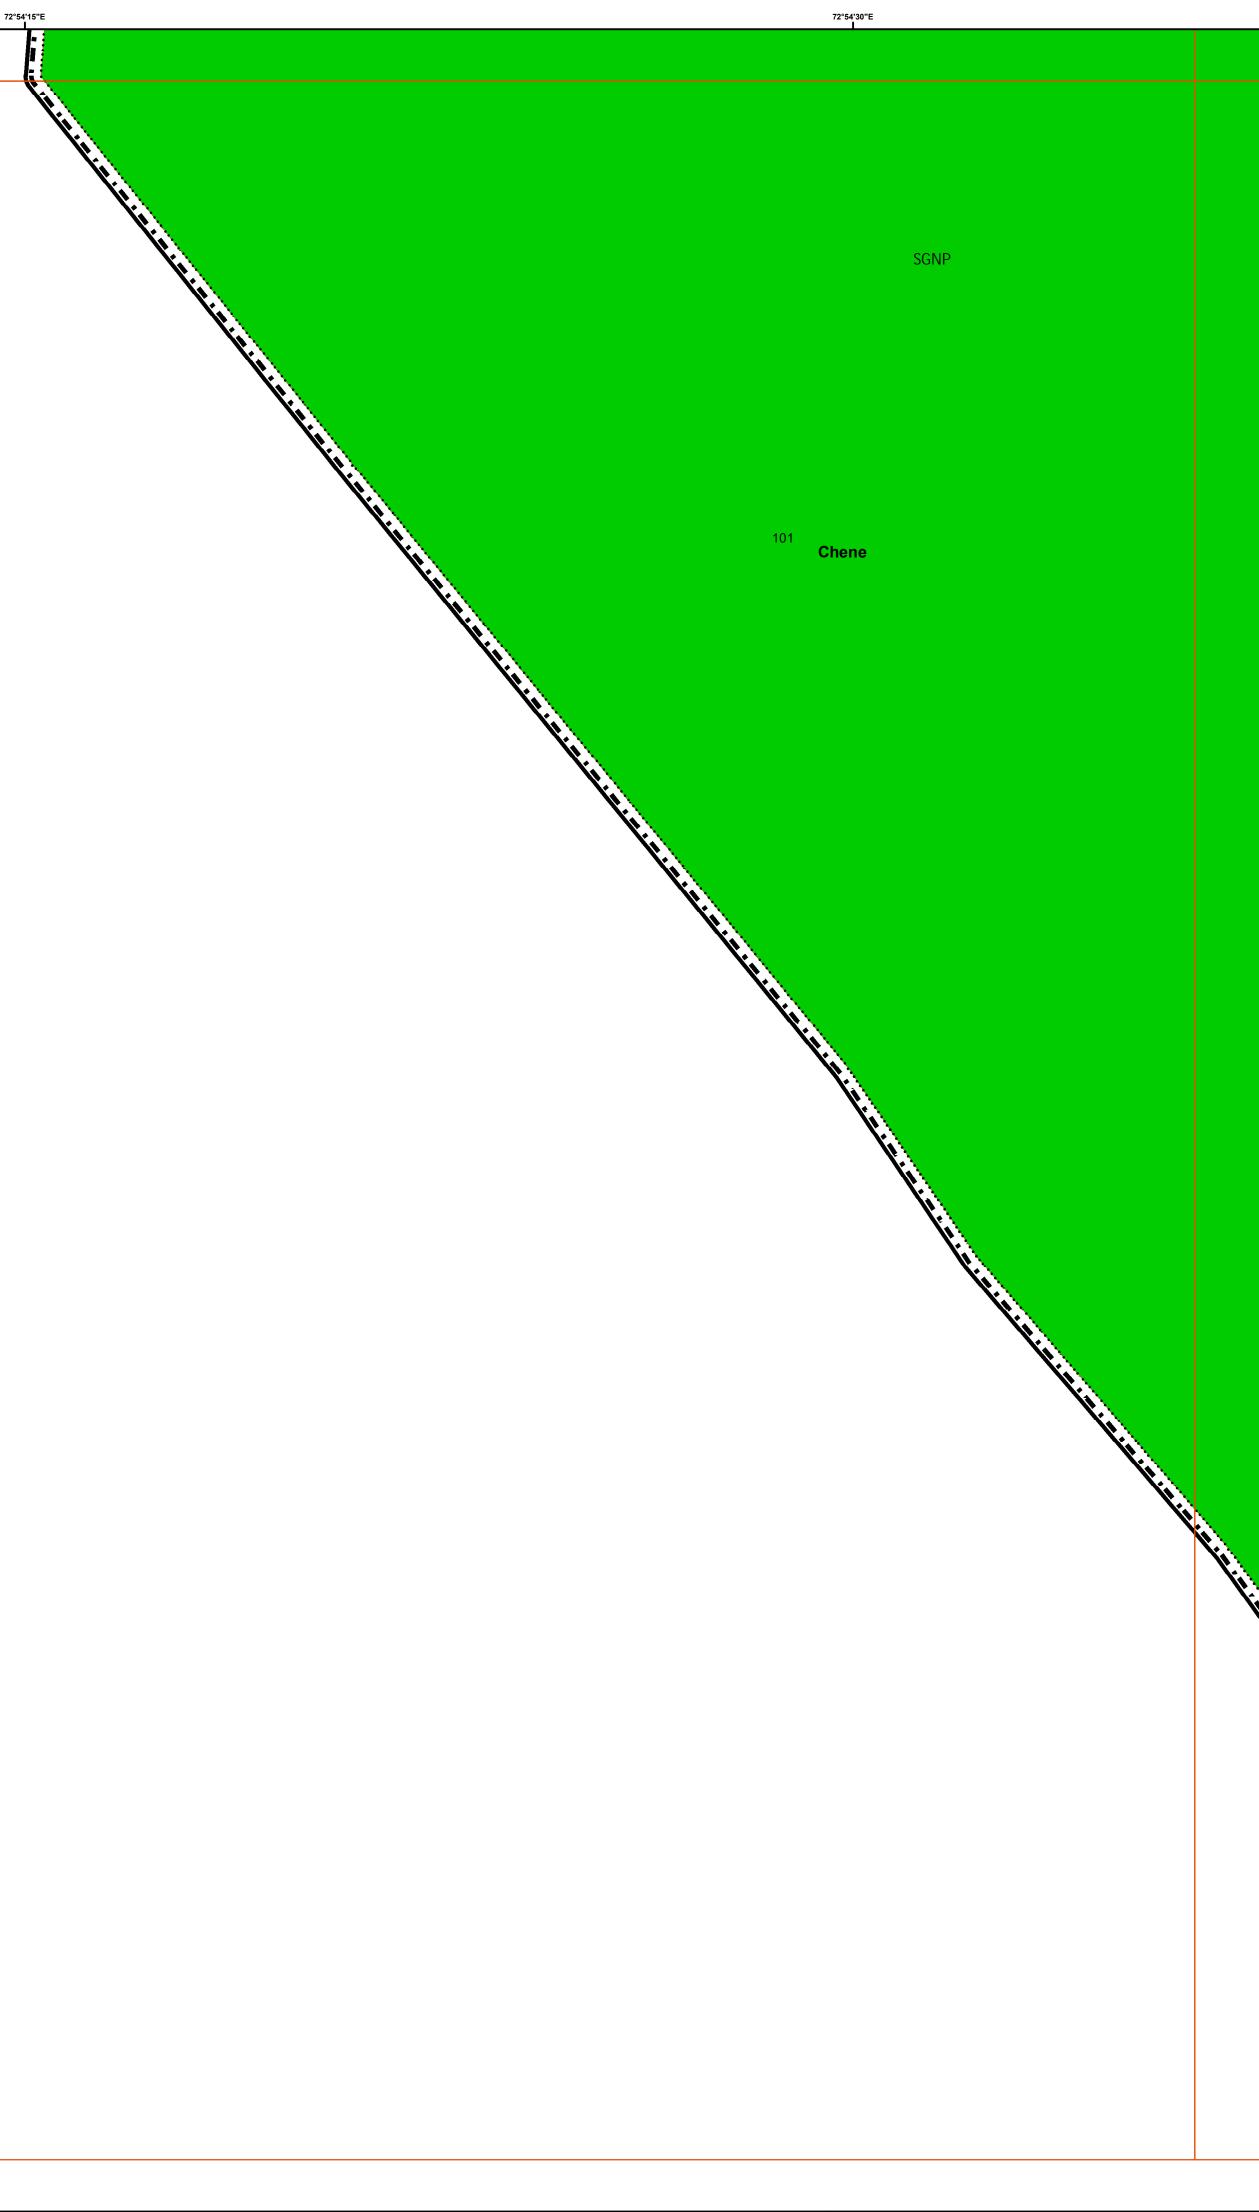

72°54'30"E

# DRAFT REVISED DEVELOPMENT PLAN Mira Bhayandar Municipal Corporation (Published U/s.28(4) of M.R.&T.P. Act 1966)

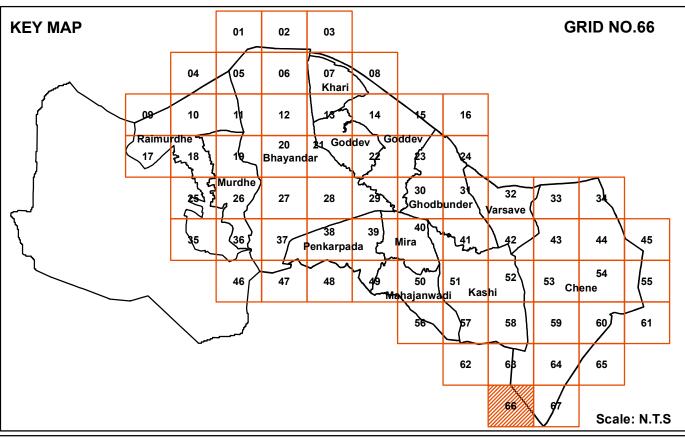

Lege	nds					
Road		Religious	Rese	rvations		
NH	National Highway	T Temple	HFD	Housing for Dishoused	SC	Ohanning Oantan
EW	Expressway	Mosque	No.	0	(SC No.	Shopping Center
MCR	Major City Road			Housing for Economically Weaker	(M(M)) No.	Municipal Market
Rail		ldgah		Section (EWS)/LIG		Fish Market
	Broad Gauge	GD Gurudwara	URS No.	URS Purpose	(FM No.	
良	Metro Station	Galadwald	(PAP No.)	Project Affected Person	(HM No.)	Hawkers Market
Bridge	Metroline	Synagogue	WH	Women Hostel/	PU No.	Public Utilities
	over Bridge	Recreational	No.	Child Care Center		Claurebtan Llausa
-1-1-1	Subway	Garden	No.	Tribal Hostel	SH No.	Slaughter House
	2	PG Play Ground	G No.	Garden	STP No.	Sewage Treatment Plant
)	Road Bridge across Rail	Sports Centre	(PG No.)	Playground	ww	Water Works
•••	Flyover Proposed Flyover	Public Utlities		. ajgioana	No.	
<b></b>	Elevated Coastal Road	Sewage Pumping Station	(PK No.)	Park	BG/CG/ CM	Burial/Cremation Ground/ Cemetery
	Elevated Proposed Road	SewageTreatment Plant	MPR No	Mangrove Park	BUS STD/ BD No	Bus Stand/Depot
Water	Bodies	Elevated & Ground Storage Reservoir	EXC No.	Exhibition Center	PNO	Bus Terminal & Parking
River	River	Crematorium/Burial Ground/ Cemetery	PIC	Picnic Spot		Truck Terminal
Lake	Lake	Electric Sub-Station	SPOT	·		Multipurpose Parking/
Ponds	Ponds	Bio Gas Plant	(IN S.F No.	Institute for Fisheries	MP/P No.	Parking
Nalla	Nalla	Transportation Bus Stand/Terminus	E.A. No.	Educational Amenity	ISBT No.	ISBT Terminus
Desid	Covered Nalla	RST Railway Station	SSA No.	School for Specially	WT	Water Terminal
Resid				Abled	No.	
	Residential Area	RTA Railway Track Area	M.A. No.	Medical Amenity	Trans. Hub No	Transport Hub
R-R R-R1	Restricted - Residential Restricted - Residential 1	Pas/PAA Parking Space/Area	(H(M) No.	Municipal Hospital		Development of Fort
Comm		JT Jetty	No.	Manicipal hospital	DF No.	Development of Fort
sc	Shopping Centre/Mall	No Development Zone	M.OFF No.	Municipal Office	Ext. No.	Extension
WM	Market (Daily & Weekly)	National Park(SCNP)     Forest Zone(SGNP)	MP No.	Municipal Purpose	OT No.	Open Theatre
Indust	rial	Forest Zone(SGNP)	GOD(M)	Municipal Codown	Øpen M	Open Market
	Industrial Area	Mangrove	No.	Municipal Godown	No.	
Educa	tion	Mangrove Buffer	LIB No.	Library	P&SP No.	Parking and Swimming Pool
PS/SS	Primary & Secondary School			Town Hall & Drama	Rese	vation Status
COL	College	Eco-Sensitive Zone		Theatre		Developed
	Services	SGNP Boundary	AUDI No.	Auditorium		
н	Hospital	Eco-Sensitive Zone Boundary	PL&AQ	Planetarium & Aquarium		Not Developed
UHC	Urban Health Centre	Power	No.		Modif	ication
	al /State Govt Property Quarter	Transmission Tower	COM.H No.	Community Hall	Μ	Proposed Modification
C/SG(Q)	Office	← → Power Transmission Line Boundaries	FBS No.	Fire Brigade Station	CZMP	Lines
Railwa	ay Property	DP Boundary	SG(O) No.	Administrative Building	02.00	CRZ II
RP	Railway Property	Municipal Corporation Bounda	arv	For Govt.office		High Tide Line
Public	& Semi-Public	Village Boundary	GOV.P No.	Government Purpose		Intertidal
Audi/D	Auditorium/Drama Theatre		NS No.	Night Shelter		
СОМ.Н	Community Hall	Gaothan Boundary		. agric entoner	_	Mangrove Buffer
swc	Social Welfare Centre	CTS Area Boundary	OAH No.	Old Age Home	<b>· · · ·</b>	Mangroves
OAH	Old Age Home	Congested Boundary		Public Amonity	المأمأ	Mangroves
FS	Fire Station	Cadastral		Public Amenity		
P.Stn/P.Ch	Police Station/Chowky	Cadastre/CTS	SDC No.	Skill Development Center		
Herita	-	Building Footprint	PCO No.	Police Commissioner Offic	е	
Fort	Fort	Building Footprint	No.			

#### Notes

1. The Base Map, ELU and Draft PLU prepared by superimposition of data collected from various Government / Semi Government / Departments / Stakeholders and physical features depicted from Drone / Satellite Imagery; hence, the discrepancies may occur.

2. Proposed Land-use Shall prevail irrespective of property number / boundary shown on map which shall be subject to confirmation from Land Record or competent Authority.

3. The structure on the map does not confirm authorization unless verified and rectified by Planning Authority. 4.SGNP, CRZ, Mangroves with their buffers shown on the plan shall be as per the relevant status. In case of any modifications to such status in future, such boundary and buffer shall automatically stand modified as per the latest notification. 5.The alignment of Metro, Coastal Elevated Road marked on plan are indicative & automatically stand modified by the notification issued by Government from time to time. 6.The alignment of nallah / river / creek is indicative and as per the feature extracted from Drone Imagery and data collected.

7. The boundaries of all the designated sites, Government property are shown as per the image captured by superimposition on cadastral map. This may be subject to change as per the actual acquisition in future. 8.This plan is to be read with UDCPR-2022 and Draft DP Report.

9. Existing road shall have status of the road according to width of road even though not shown in development plan. 10.R-R(Restricted-Residential) Residential Zone subject to handing over area to corporation as per permission/Government orders. 11.R-R1 (Restricted- Residential1) All provision of Residential Zone in UDCPR-2020 will be applicable for this zone subject to

10% of area under Development should be kept for Amenity Space as per direction of Municipal Commissioner with prior permission from Eco-Sensitive Zone Commitee.

12.If the location of Metro Carshed and Metro Line is shifted by MMRDA or Elevated Road is shifted in future, the land leased by such shifting shall stands included in adjoining Zone shown on Development Plan.

Scale				North N
0	0.05	0.1	0.2 km	WEE
		1:2,000		s
35100	मुल्यनिधारिष		600+1	





Officer Appointed U/s 21(4A) ★ Draft Revised Development Plan of Mira Bhayandar

19°14'15"N **I** 

19°14'0"N **I** 

N.


101

72°54'45"E


SGNP

Chene

72°54'45"E

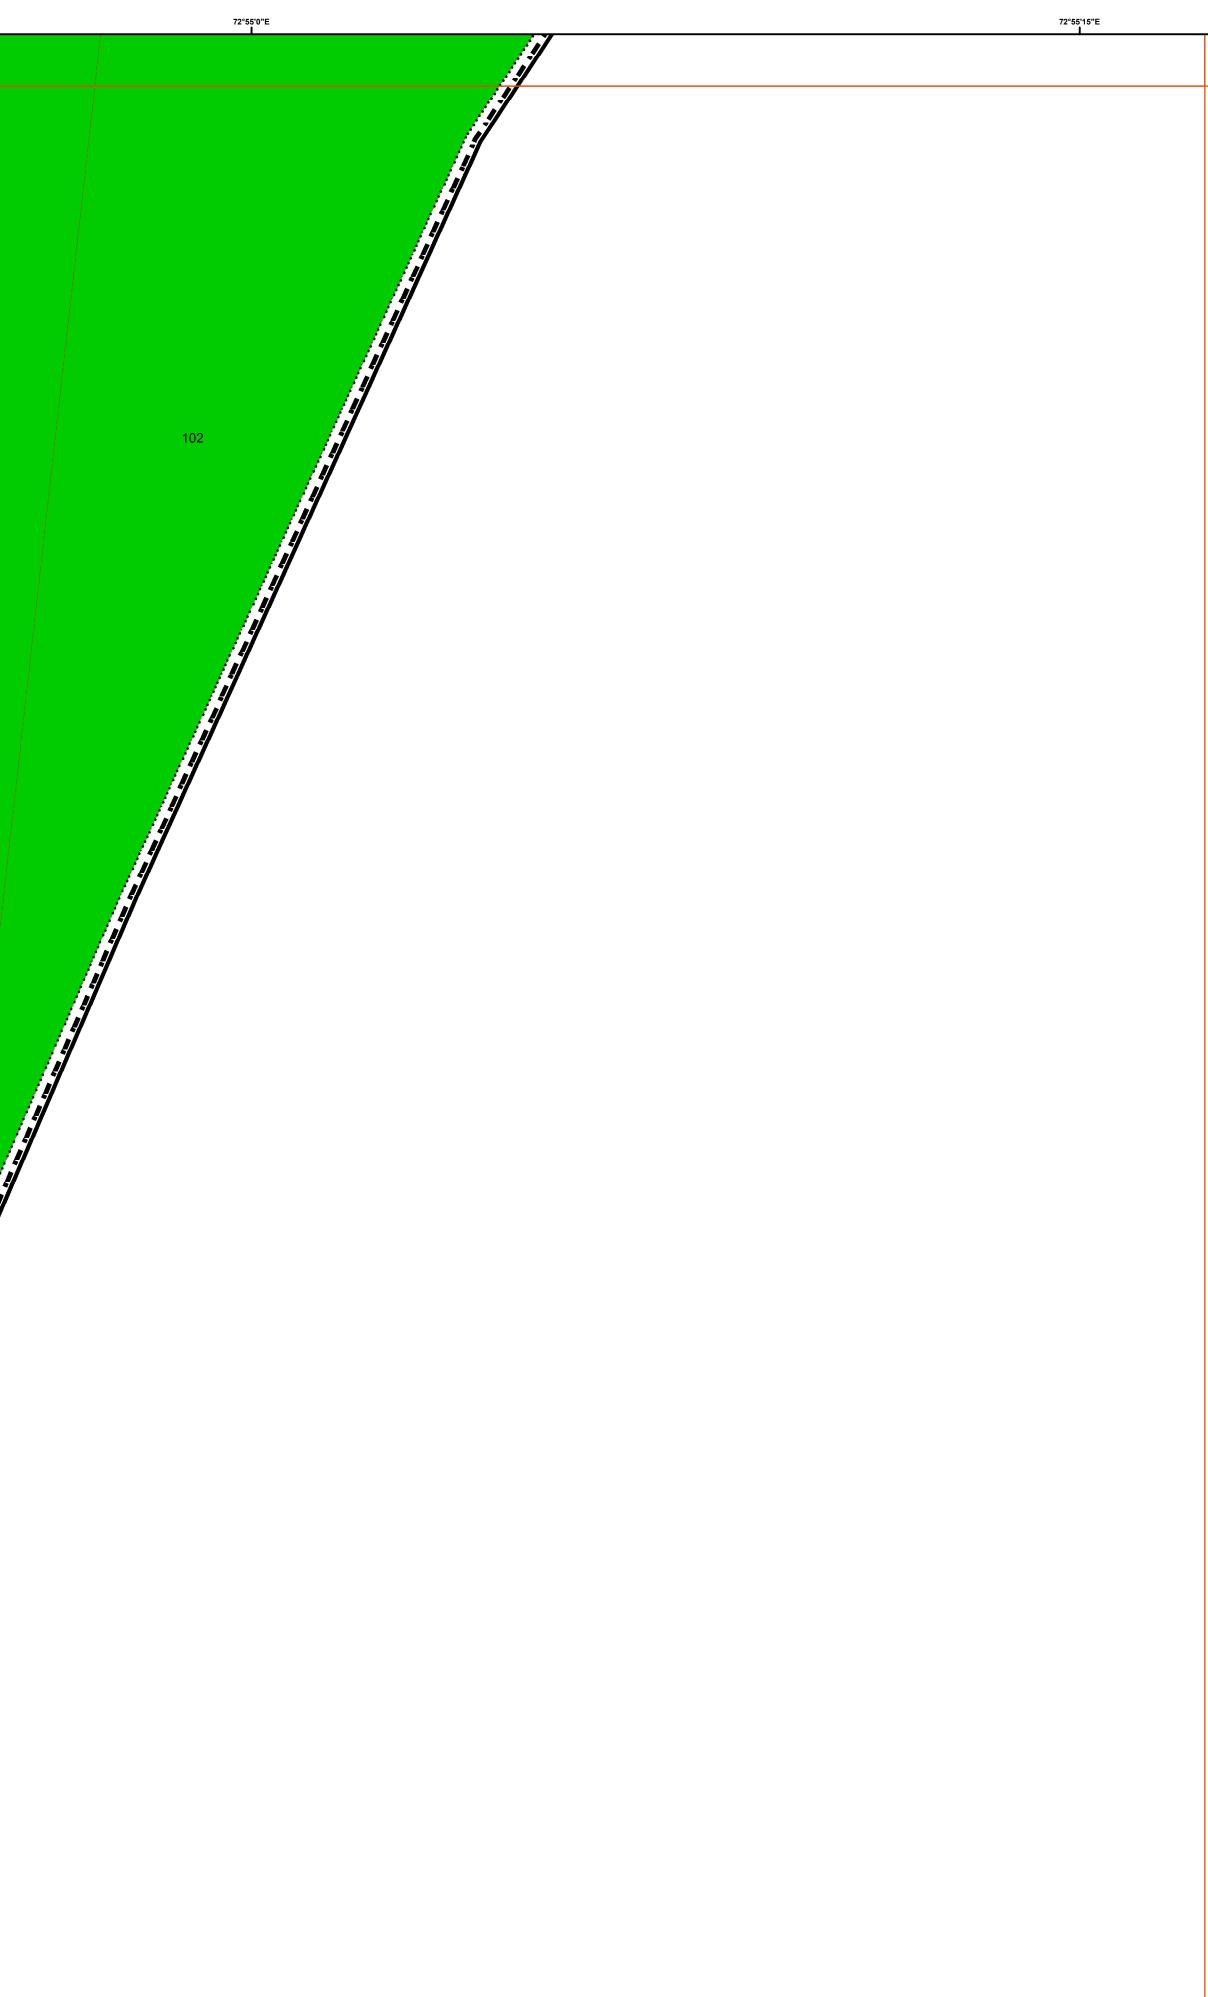

### DRAFT REVISED DEVELOPMENT PLAN Mira Bhayandar Municipal Corporation (Published U/s.28(4) of M.R.&T.P. Act 1966)

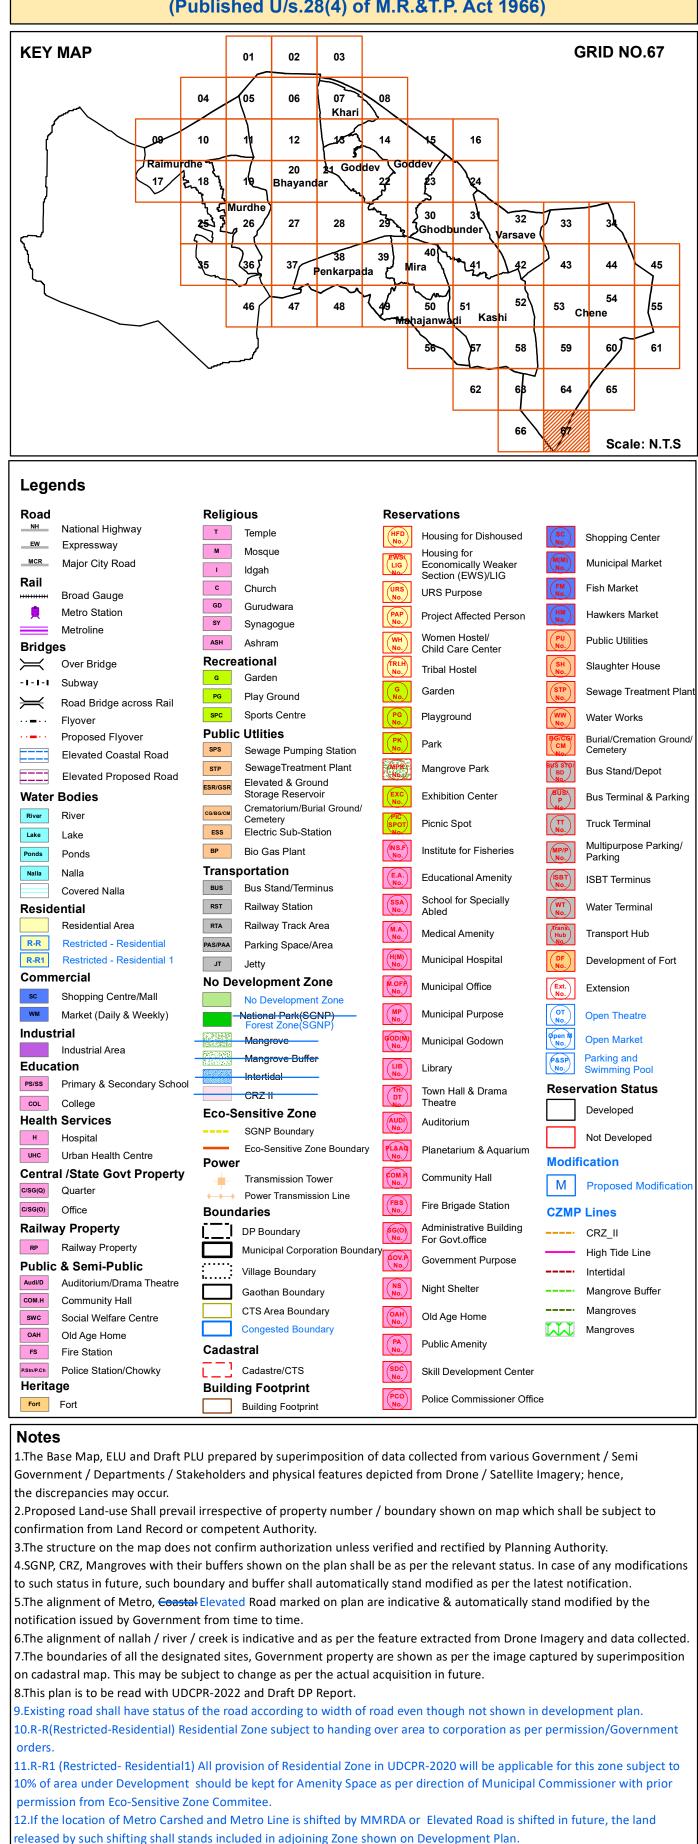

Scale					North	N
0	0.05	0.1		0.2 km		WEE
		1:2,000				S
310	मुल्यनिधानम		500	+1		

